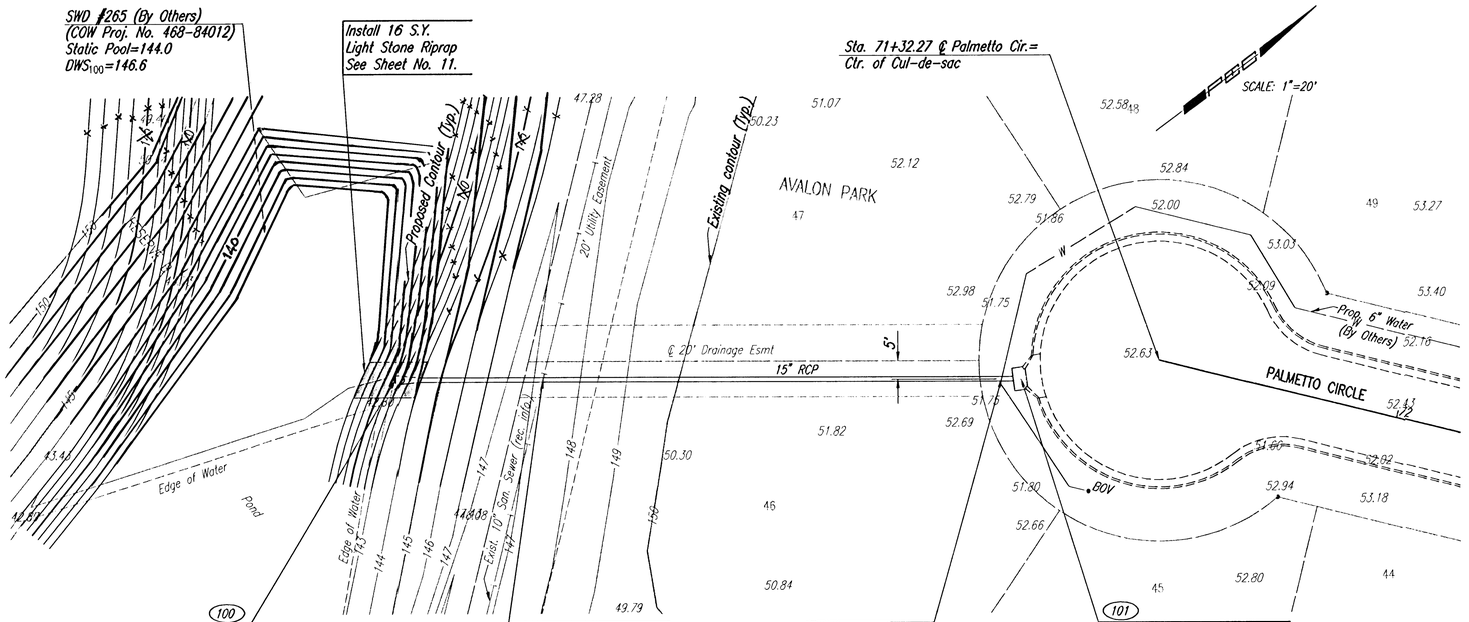


Ⓔ Excavate Only as Necessary for Installation of RCP and Riprap. At Contractor's option, timing of Riprap placement may be Coordinated with SWD #265 Contractor.

Ⓔ See Title Sheet for Construction Schedule/Sequence Note.

COORDINATE LIST		
POINT	NORTH	EAST
100	10,955.2641	11,074.6436
101	11,094.1245	11,178.4961

(100) = COORDINATE POINT NO.

SEE SHEET NO. 3 FOR PLAT COORDINATES

RECORD DRAWING


02OCT06

BRIAN L. BOUTWELL LICENSED 10889 PROFESSIONAL ENGINEER

10-15-05

PLAN | CHECKED | CHECKED | BY | DATE

PROFILE | CHECKED | CHECKED | BY | DATE

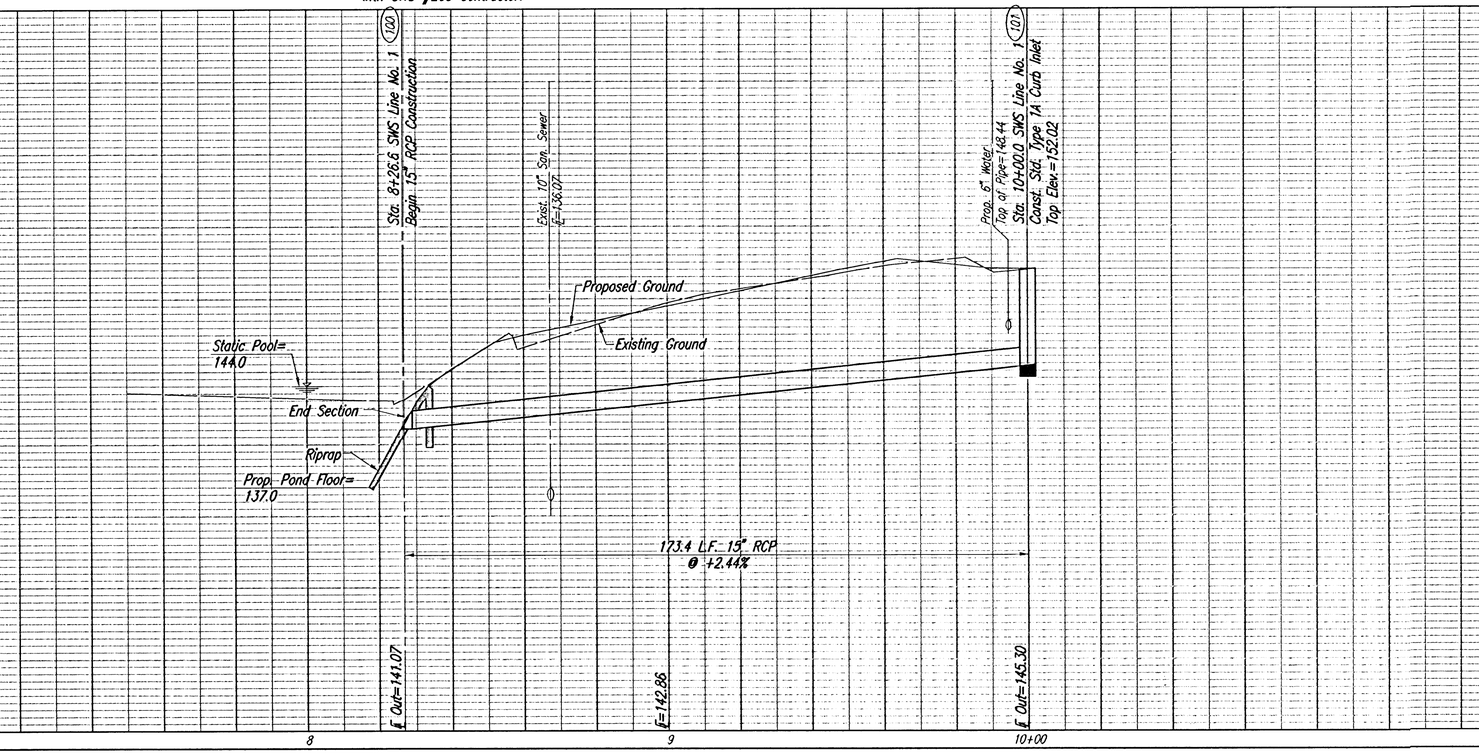

AVALON PARK-PHASE 3

SWS LINE NO. 1

JAMES L. ARMOUR, P.E.-CITY ENGINEER
CITY OF WICHITA PROJECT NO. 472-83837

Professional Engineering Consultants, P.A.
303 S. TOPEKA • WICHITA, KANSAS 67202
316-262-2691 • FAX 316-262-3003

Designed By	BDB, BLB	Job No.	35-05160-000
Drawn By	BJS	Date	February 2005

Sheet 8 of 19

DSNR: BLB OPER: BJS SCALE: 1=20.00
Q:\2005\05160\000\05160-000-C-SWSLINE 06-13-2005 09:48:47 cm