
usr/usin/dgn: 1998/95325/a101sec.dgn
Date Plotted: 7/28/95
deliver to: Gwaine Gunn

AS-BUILT	TS&L/ATE	
NO.	AREAS	
	AREAS CHECKED	

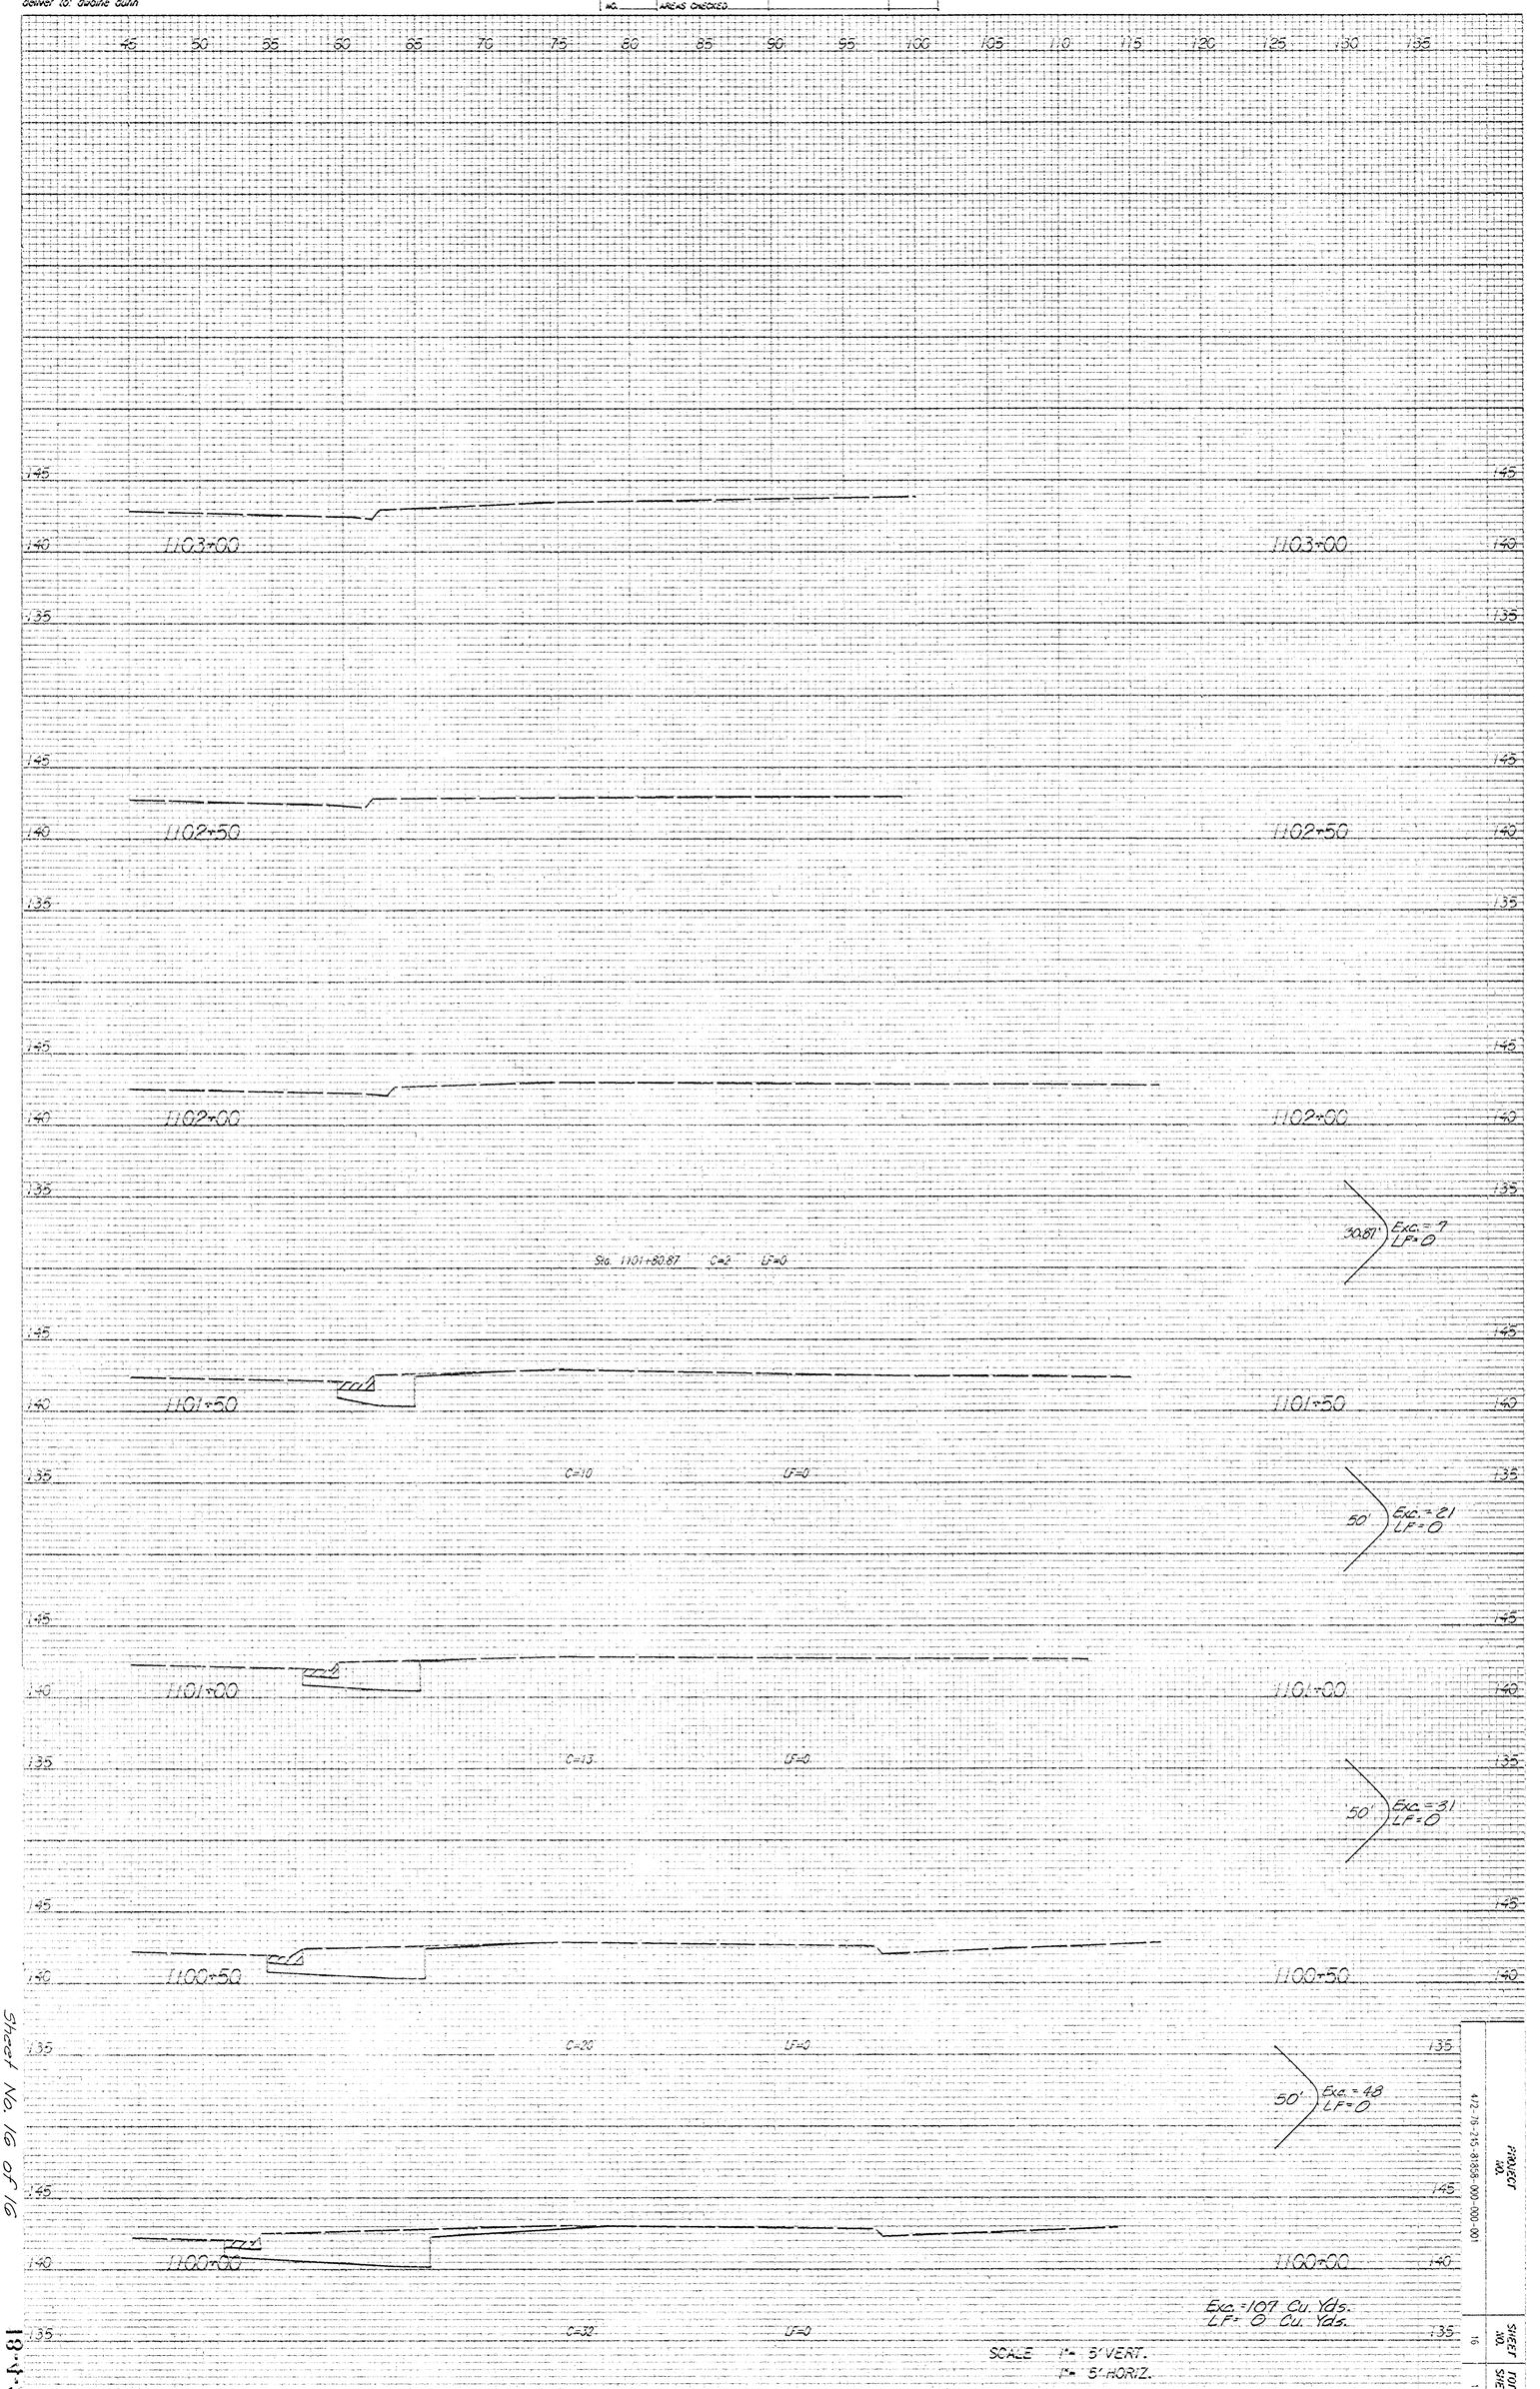

SCALE 1"= 5' VERT.
1"= 5' HORIZ.

PROJECT NO.	412-75-215-81858-000-000-001
SHEET NO.	16
TOTAL SHEETS	16

Sheet No 16 of 16

18.4.5.2