


HAWTHORNE THIRD ADDITION


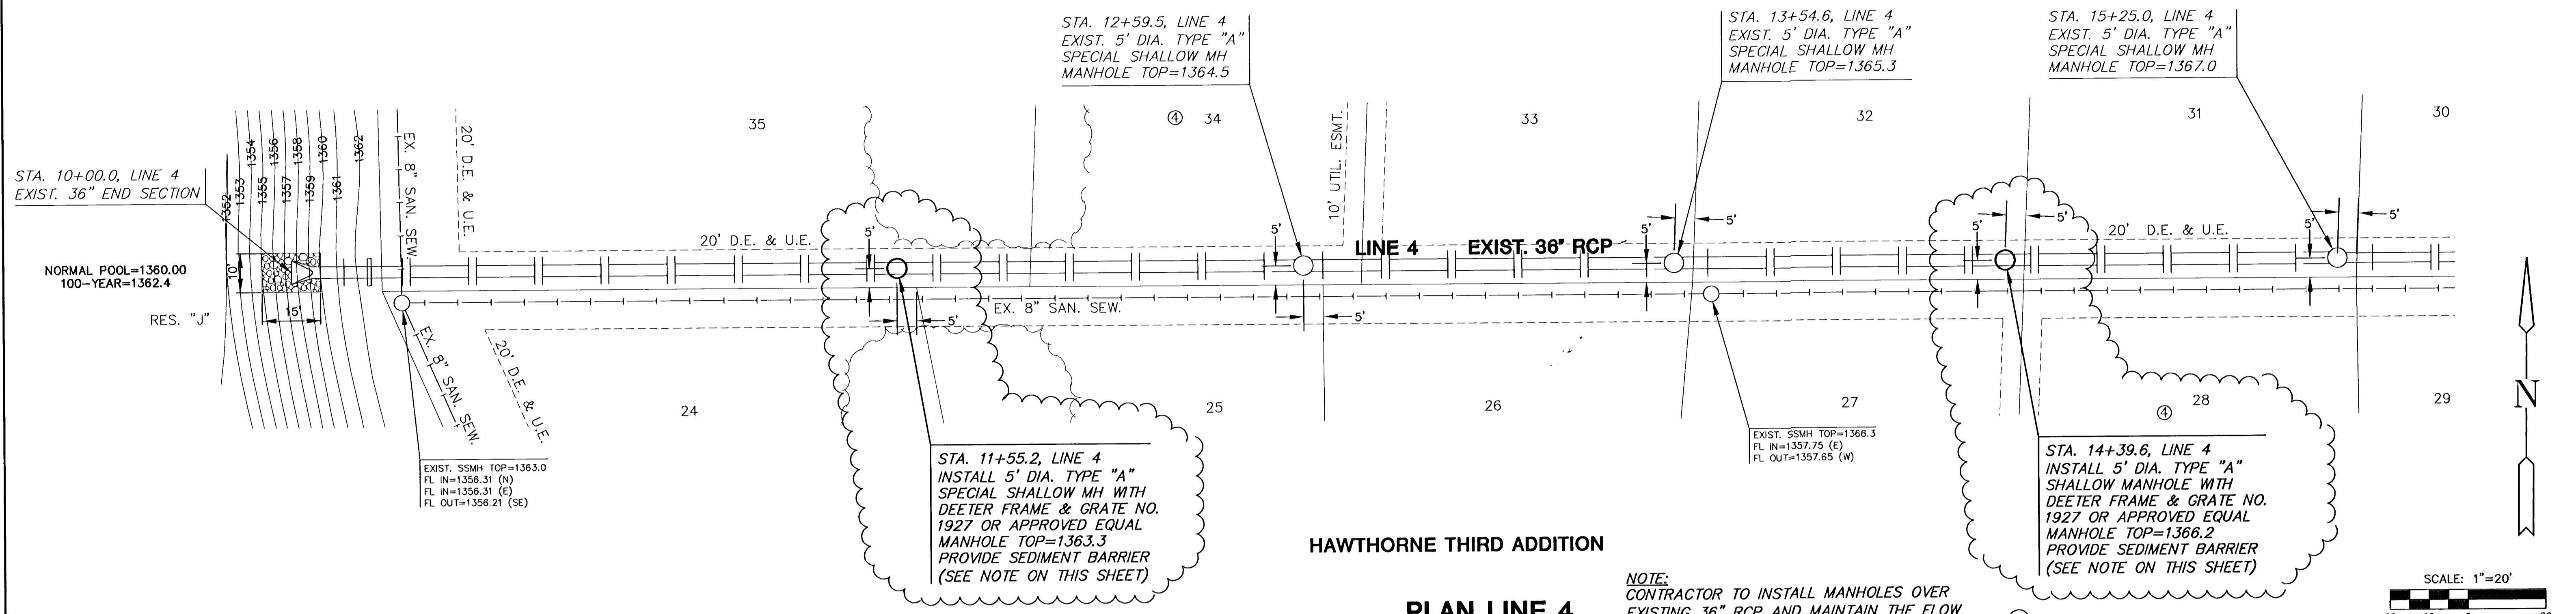


HAWTHORNE THIRD ADDITION

PLAN LINE 4

SCALE: 1"=20'

NOTE:
CONTRACTOR TO INSTALL MANHOLES OVER
EXISTING 36" RCP AND MAINTAIN THE FLOW

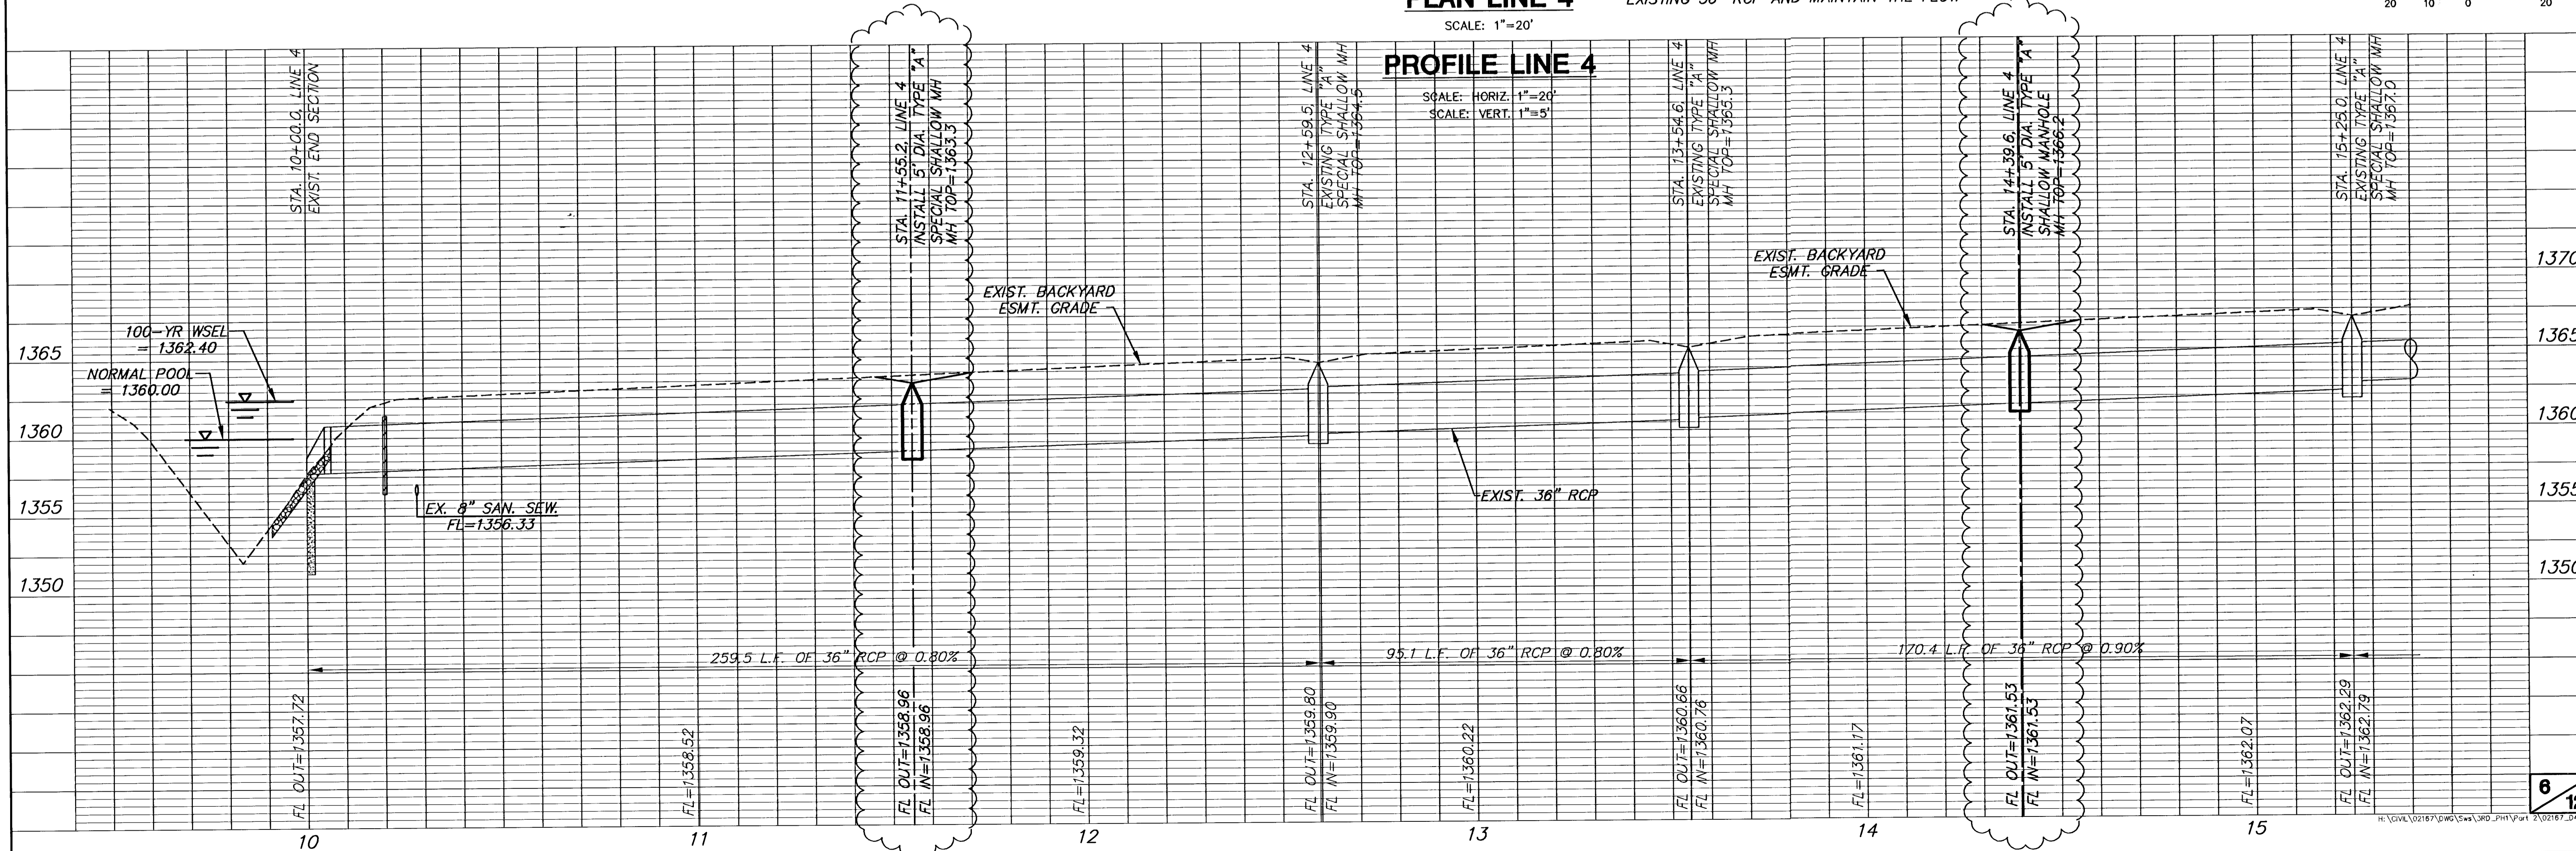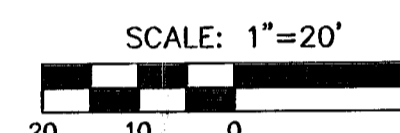

PROFILE LINE 4

SCALE: HORIZ. 1"=20'
SCALE: VERT. 1"=5'