


GREATER WICHITA YMCA
NORTHWEST BRANCH YMCA
SANITARY SEWER PLANS

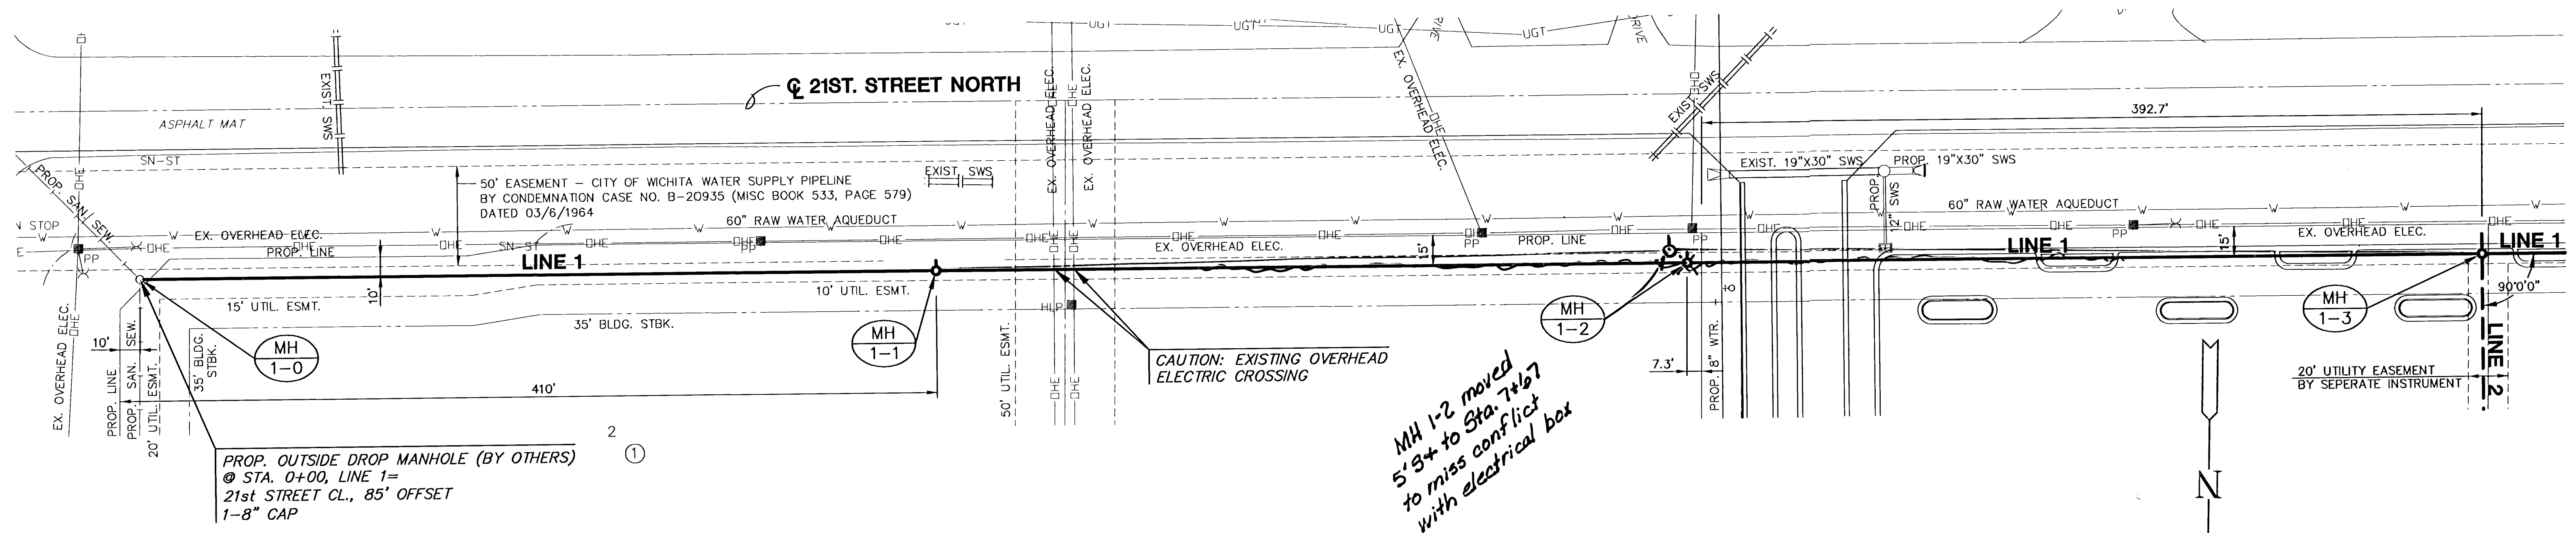

PLAN LINE 1

SCALE: 1"=40'

PROFILE LINE 1

SCALE: HORIZ. 1"=40'
SCALE: VERT. 1"=5'

