


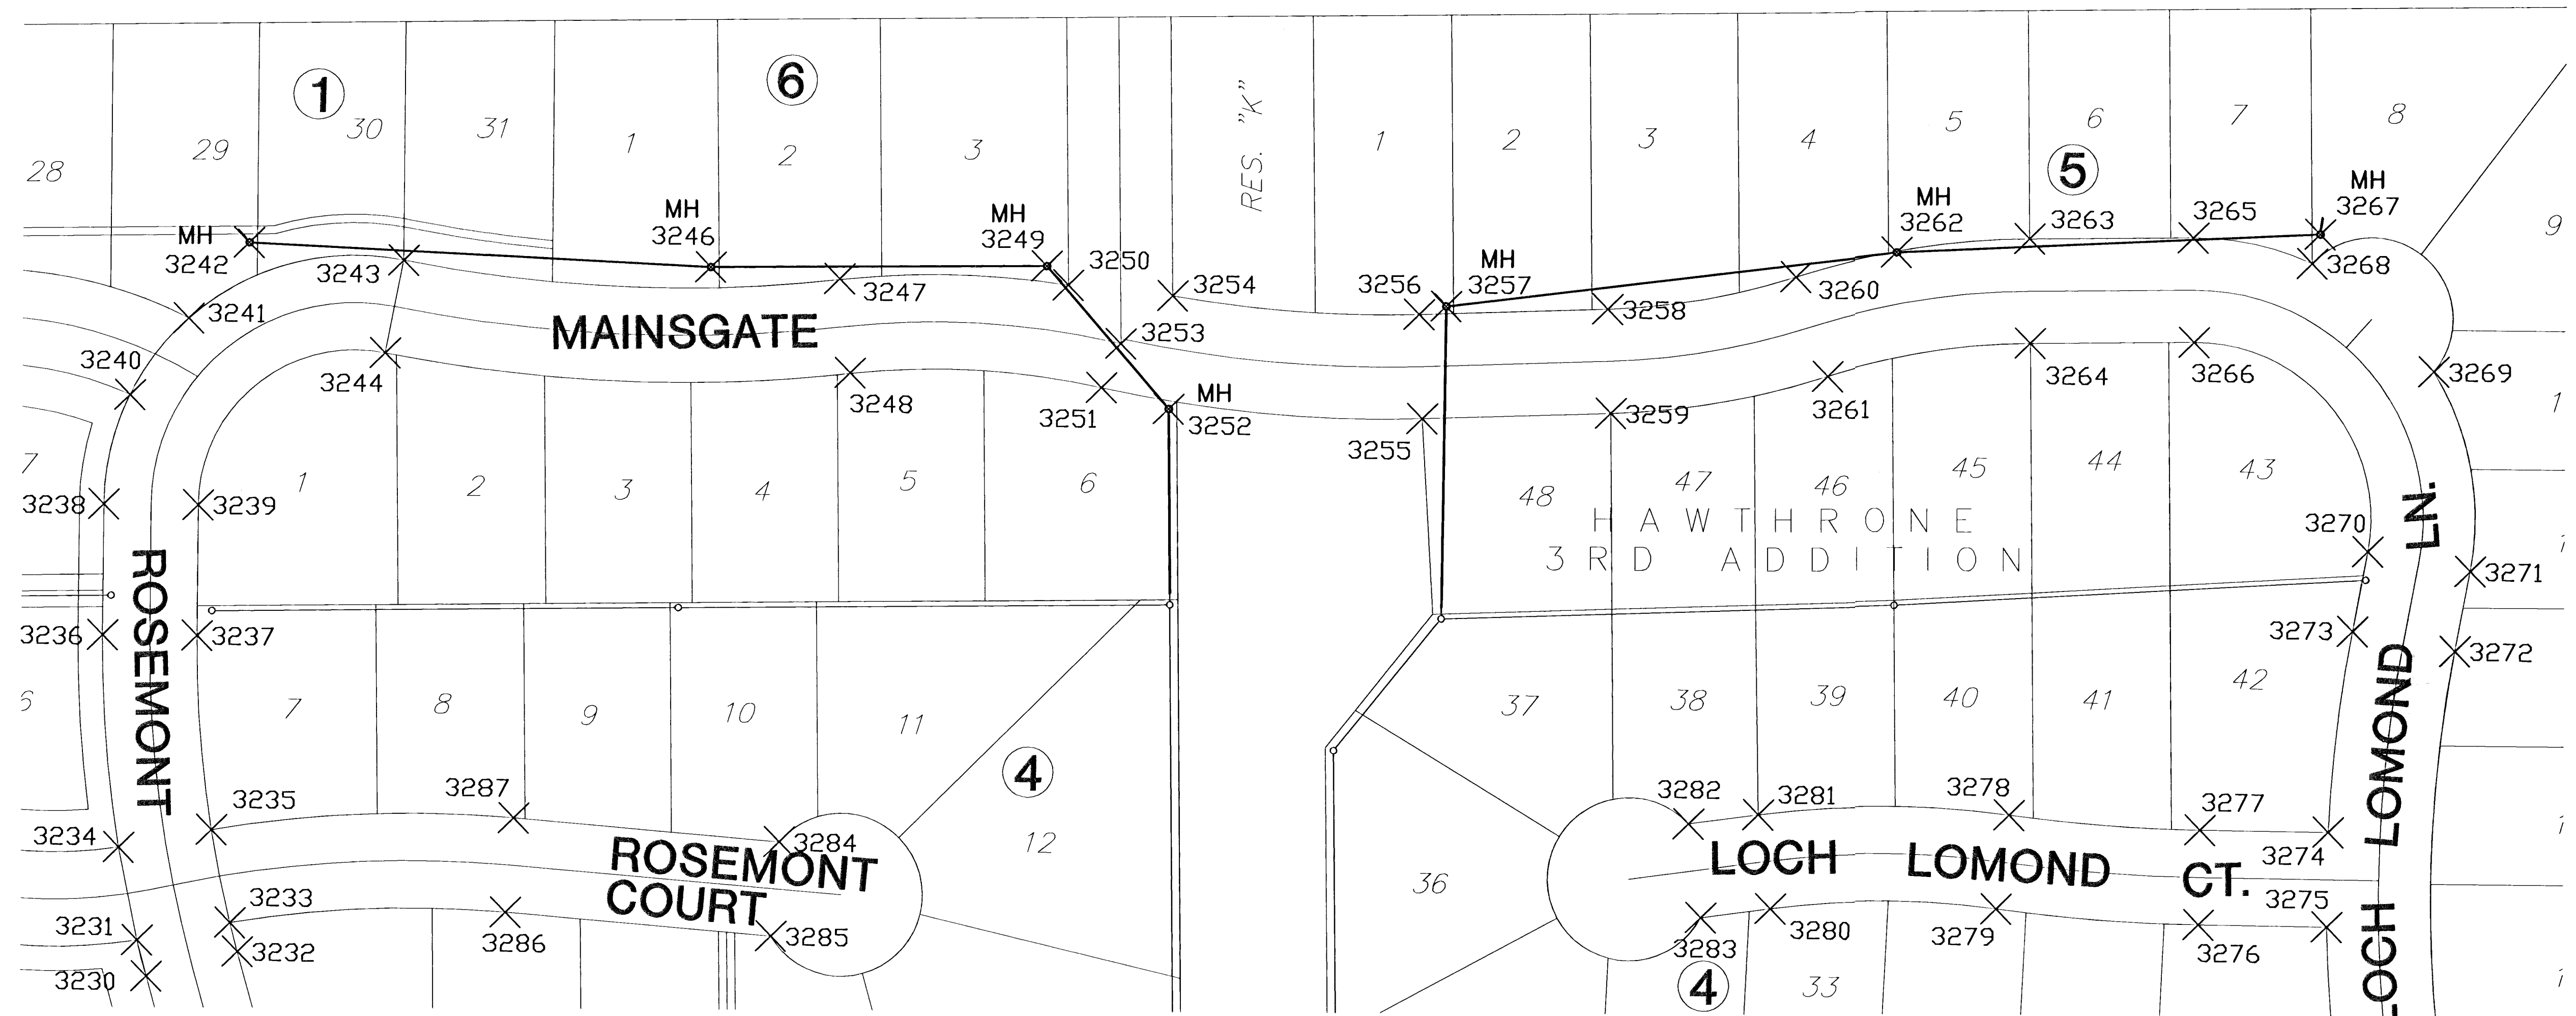

SCALE: 1" = 60'

Point No.	North	East	Point No.	North	East
3230	1693244	1701982	3261	1694270	1702369
3231	1693238	1702004	3262	1694310	1702446
3232	1693300	1701998	3263	1694392	1702456
3233	1693295	1702016	3264	1694394	1702392
3234	1693226	1702061	3265	1694493	1702458
3235	1693283	1702073	3266	1694494	1702394
3236	1693214	1702191	3267	1694571	1702462
3237	1693272	1702192	3268	1694566	1702444
3238	1693213	1702271	3269	1694642	1702379
3239	1693271	1702272	3270	1694604	1702268
3240	1693228	1702339	3271	1694667	1702257
3241	1693263	1702387	3272	1694658	1702208
3242	1693299	1702434	3273	1694595	1702219
3243	1693394	1702424	3274	1694582	1702095
3244	1693384	1702367	3275	1694582	1702037
3246	1693582	1702424	3276	1694504	1702037
3247	1693662	1702418	3277	1694504	1702095
3248	1693669	1702360	3278	1694386	1702102
3249	1693789	1702428	3279	1694379	1702044
3250	1693802	1702417	3280	1694240	1702042
3251	1693824	1702354	3281	1694232	1702100
3252	1693865	1702342	3282	1694189	1702093
3253	1693835	1702382	3283	1694198	1702036
3254	1693866	1702411	3284	1693631	1702072
3255	1694021	1702339	3285	1693627	1702014
3256	1694018	1702403	3286	1693463	1702025
3257	1694034	1702408	3287	1693467	1702083
3258	1694134	1702408			
3259	1694137	1702344			
3260	1694249	1702430			



HAWTHORNE 3RD ADDITION - PHASE 2		
PROJECT NAME		
BUBBLE MAP		
SHEET TITLE		
DFL	MKEC	CJA
DESIGN BY:	DRAWN BY:	CHECKED BY:
OCTOBER 2005	02167	8 / 9
DATE	JOB NO.	SHEET/OF

H:\LOWELL\02167.DWG Scan (P42) Main Gate 02167B.mxd 11/2/2005 3:58:07 PM CST