
BENCHMARK:

BM #1 : "□" Cut on back of walk at the South East corner of lot 1, Woodland Heights 2nd Addition.


Elev. = 1332.94


Scale: 1" = 40' Horizontal
1" = 5' Vertical
• = Iron

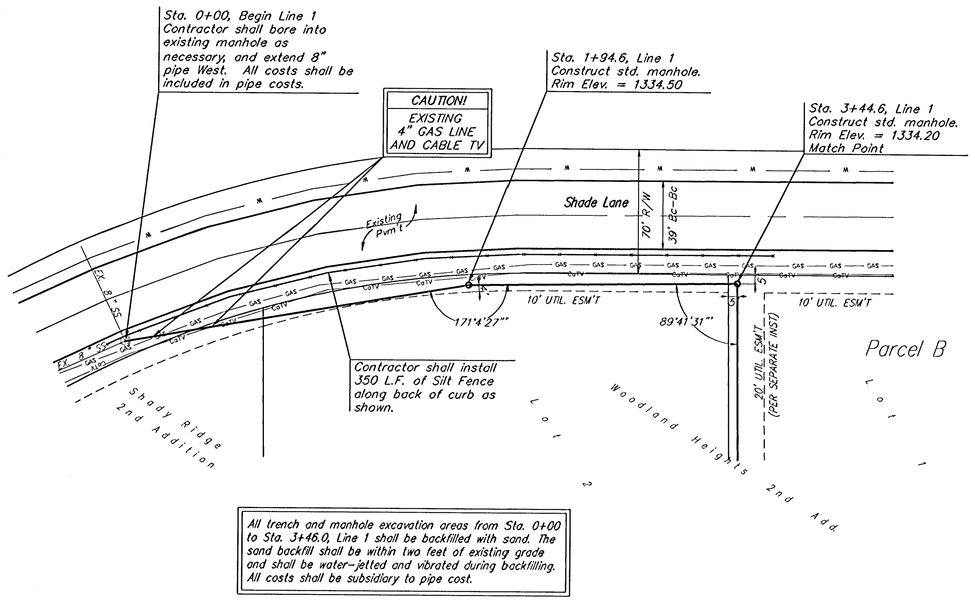

All trench and manhole excavation areas from Sta. 0+00 to Sta. 3+46.0, Line 1 shall be backfilled with sand. The sand backfill shall be within two feet of existing grade and shall be water-jetted and vibrated during backfilling. All costs shall be subsidiary to pipe cost.

Scale: 1" = 40' Horizontal
1" = 5' Vertical
• = Iron

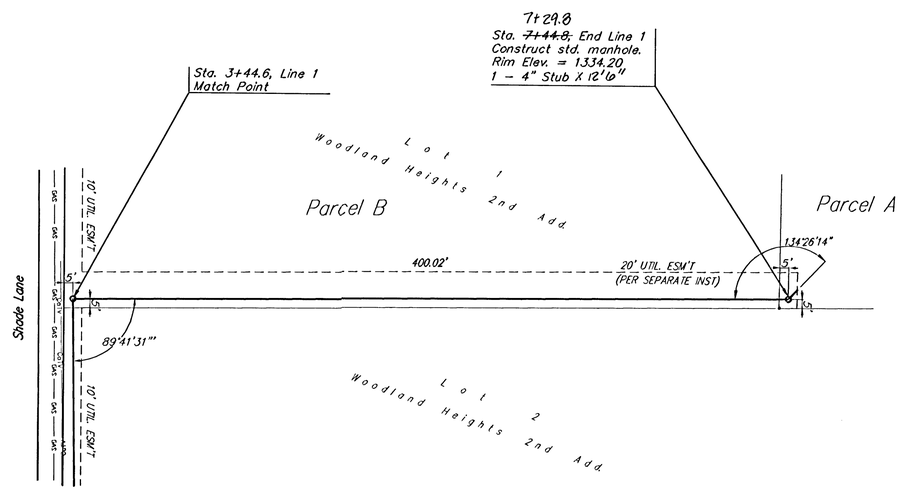

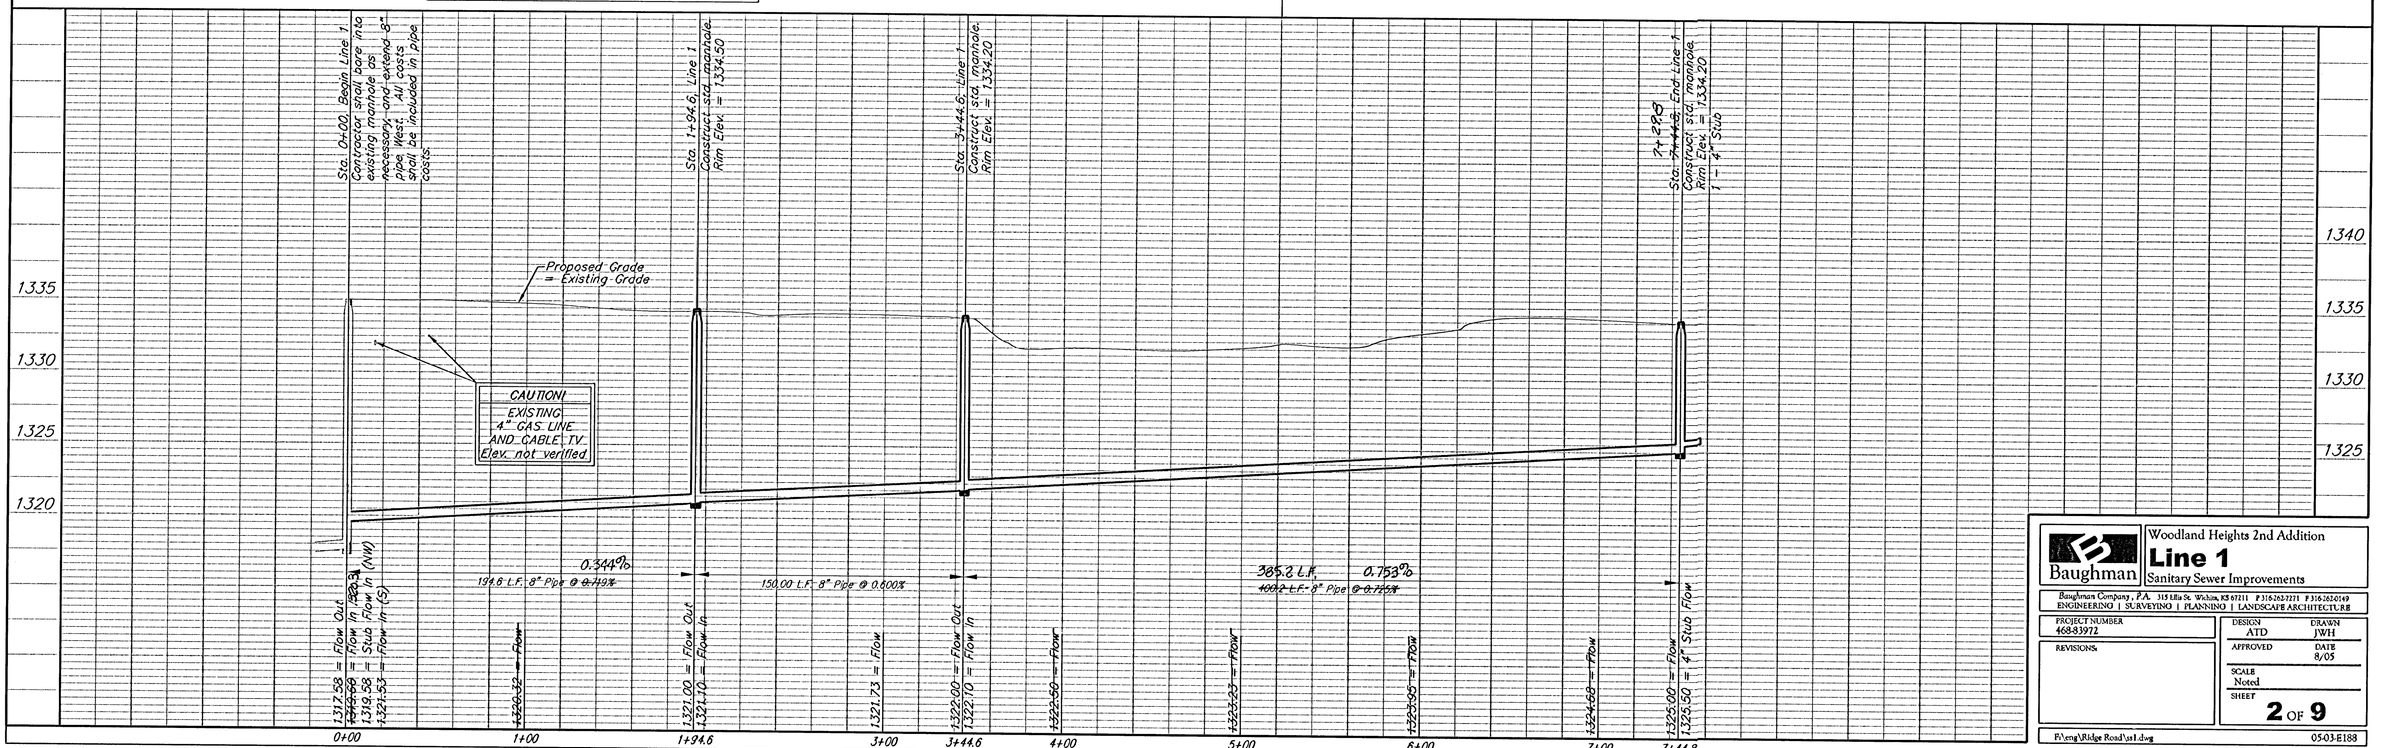

Baughman

Woodland Heights 2nd Addition
Line 1
Sanitary Sewer Improvements

Baughman Company, P.A. 315 Ellis St. Wichita, KS 67211 P 316.262.7271 F 316.262.0149
ENGINEERING | SURVEYING | PLANNING | LANDSCAPE ARCHITECTURE

PROJECT NUMBER	DESIGN	DRAWN
468-83972	ATD	JWH
REVISIONS	APPROVED	DATE
		8/05
	SCALE	
	Noted	
	SHEET	
	2 OF 9	

F:\eng\Ridge Road\st1.dwg 0503-E188