





SCALE 1" = 40'
IRON = •

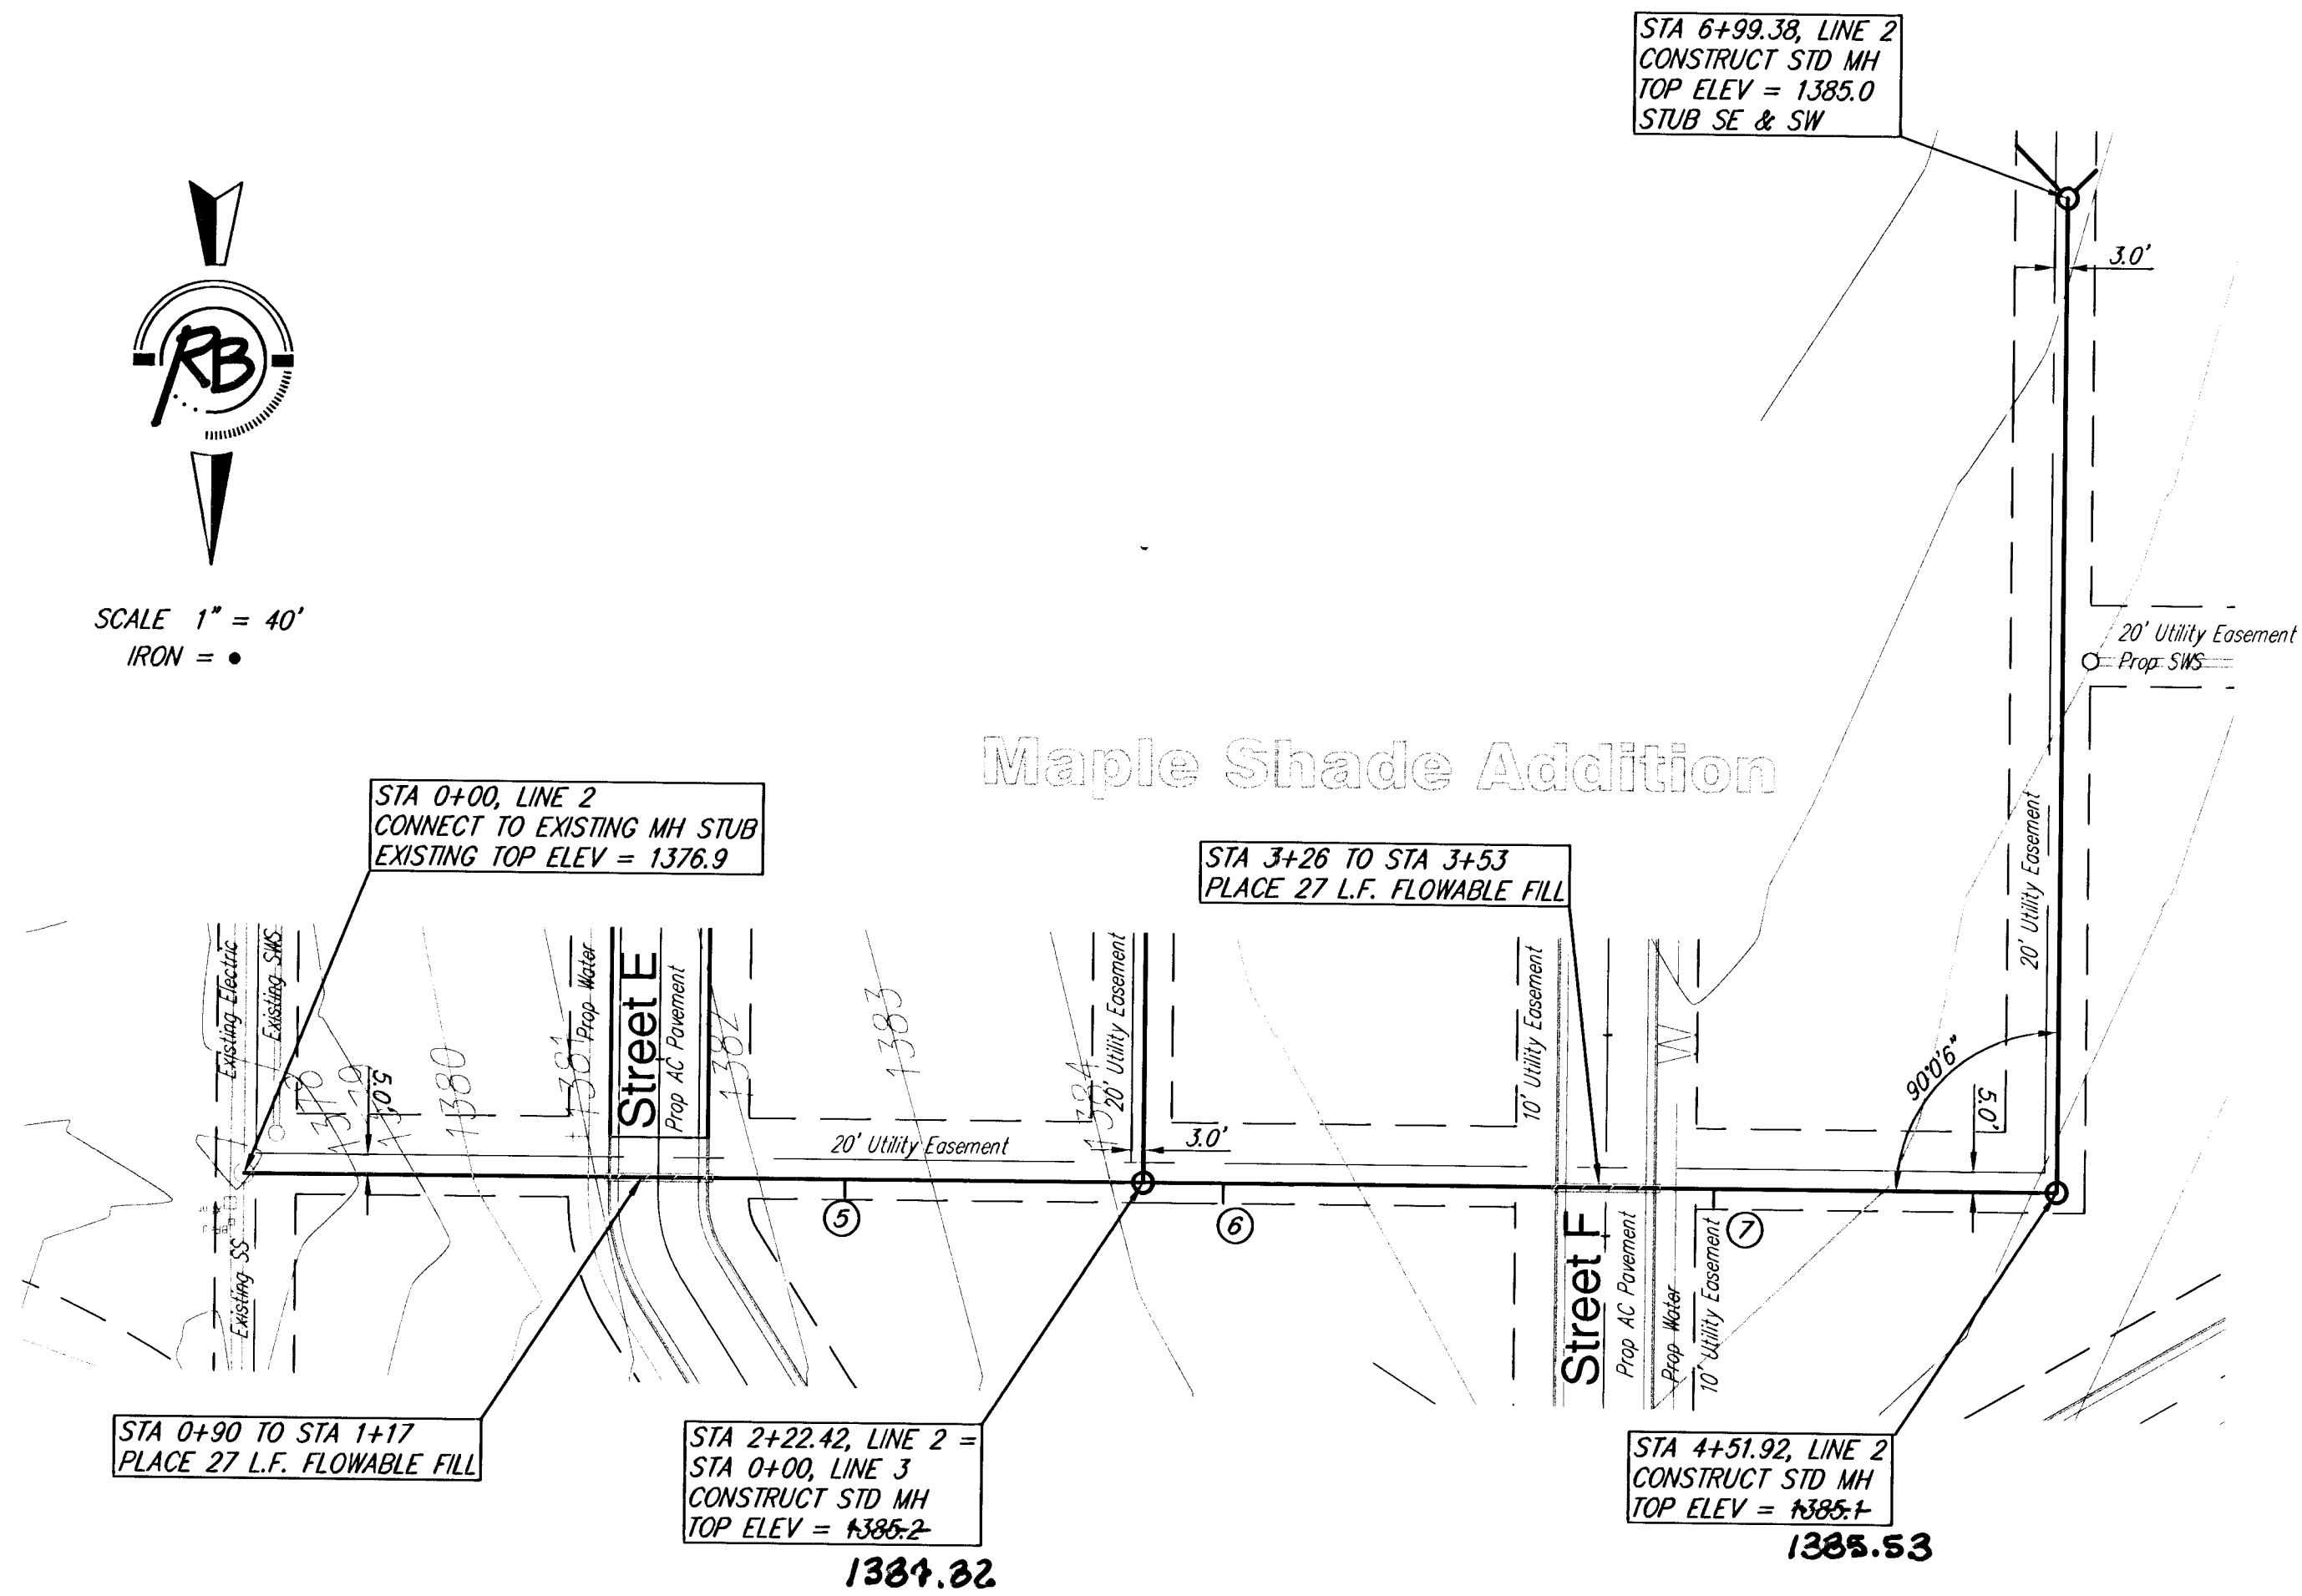

STA 2+22.42, LINE 2 =
STA 0+00, LINE 3
CONSTRUCT STD MH
SEE NOTE THIS SHEET

Maple Shade Addition

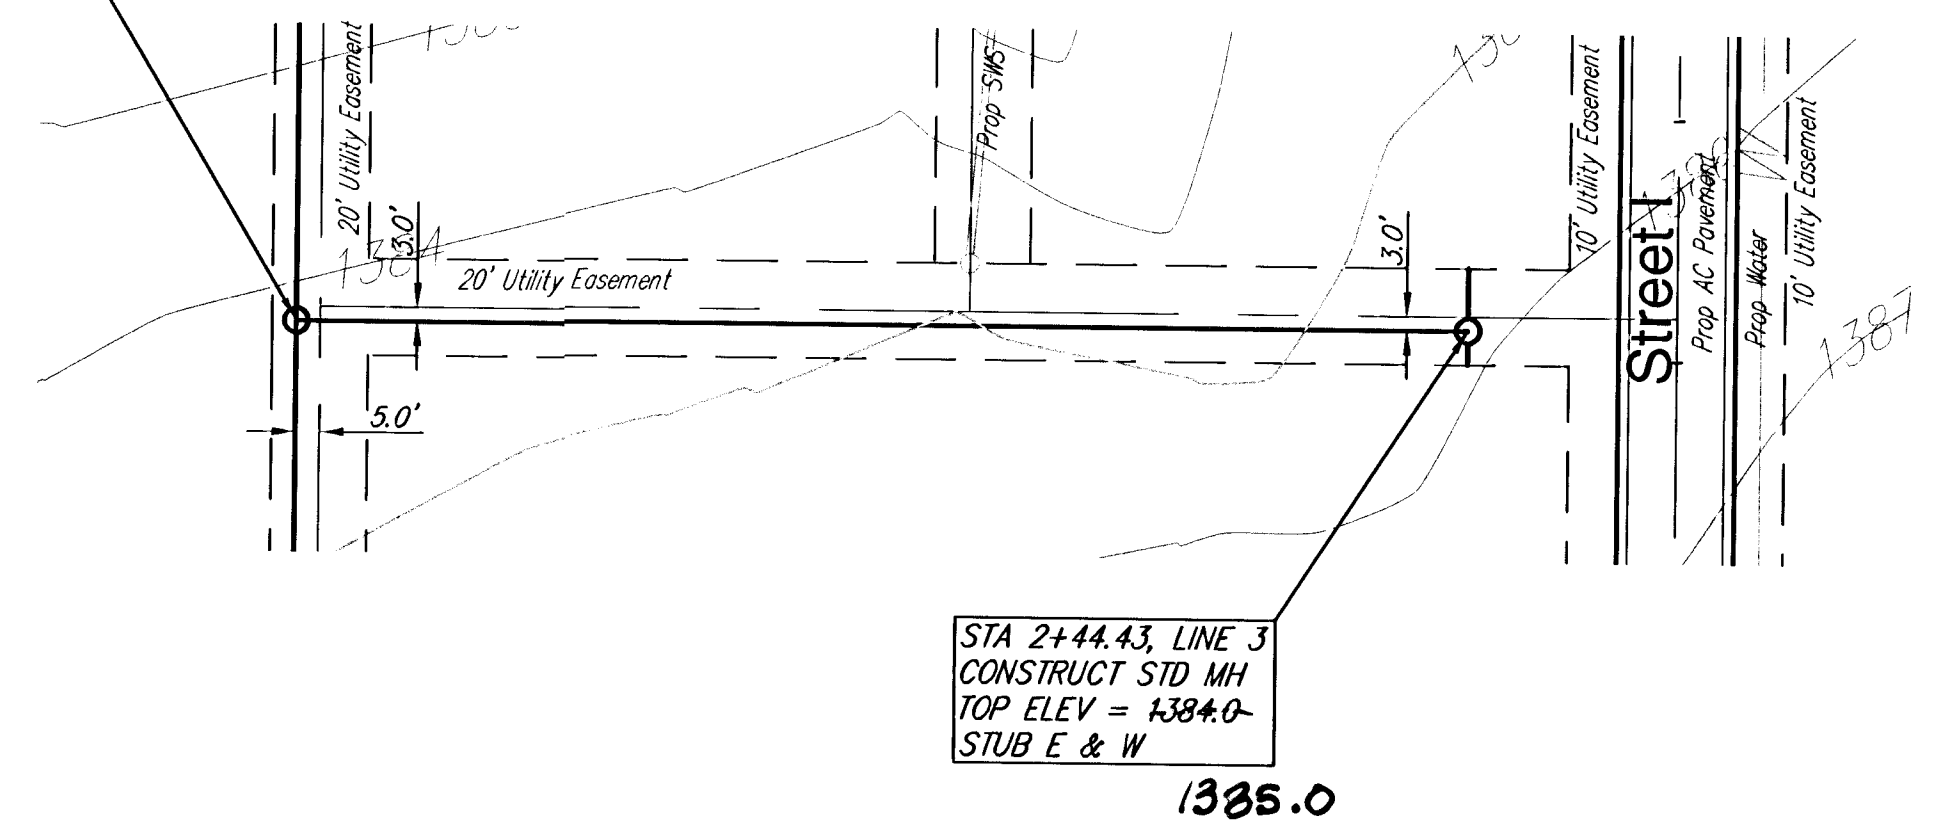



SEWER SERVICE TABLE

NUMBER	TYPE	LOCATION			FOR INFORMATION ONLY	
		HOUSE NO.	BLOCK NO.	LINE NO. STATION DIRECTION	APPROXIMATE LENGTH 4" PIPE	
5	8" X 4" Tee Saddle	251	2	1 1+50.0/Rt.	11.9'	84.7
6	8" X 4" Tee Saddle	252	2	1 2+45.0/Rt.	9.1'	77.0
7	8" X 4" Tee Saddle	261	2	1 3+66.0/Rt.	11.8'	5'

NOTE: Vertical Riser Pipe shall be extended to 2' minimum above ground water elevation and 4' maximum below proposed ground elevation.



SCALE 1" = 40'
IRON = •

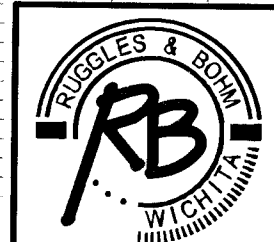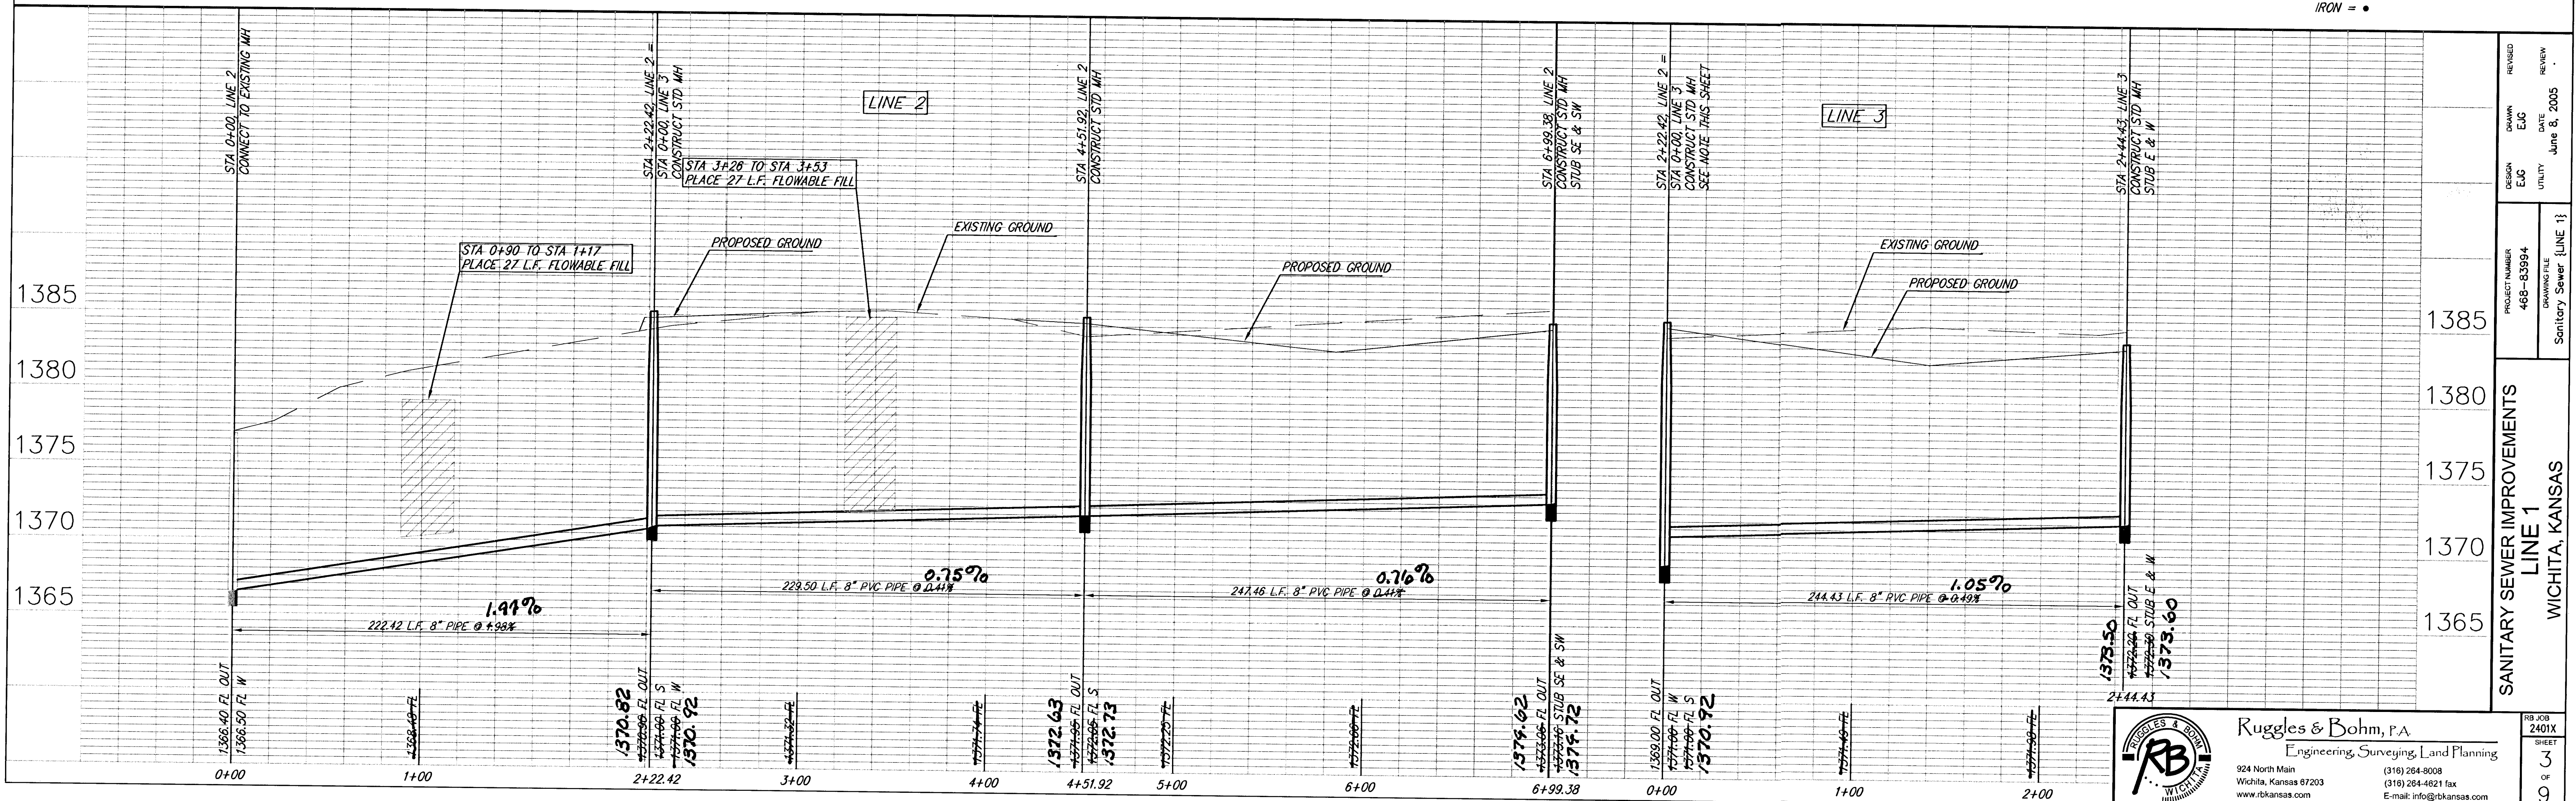

Ruggles & Bohm, P.A.
Engineering, Surveying, Land Planning
924 North Main
Wichita, Kansas 67203
(316) 264-8008
(316) 264-4621 fax
www.rbkansas.com
E-mail: info@rbkansas.com

PROJECT NUMBER
468-83994
DRAWING FILE
Sanitary Sewer (LINE 1)
SANITARY SEWER IMPROVEMENTS
LINE 1
WICHITA, KANSAS
REVISION
DATE
JUNE 8, 2005
REVIEW
EJC
JUN 8, 2005
REVIEW
JUN 8, 2005
RB JOB
2401X
SHEET
3
OF
9