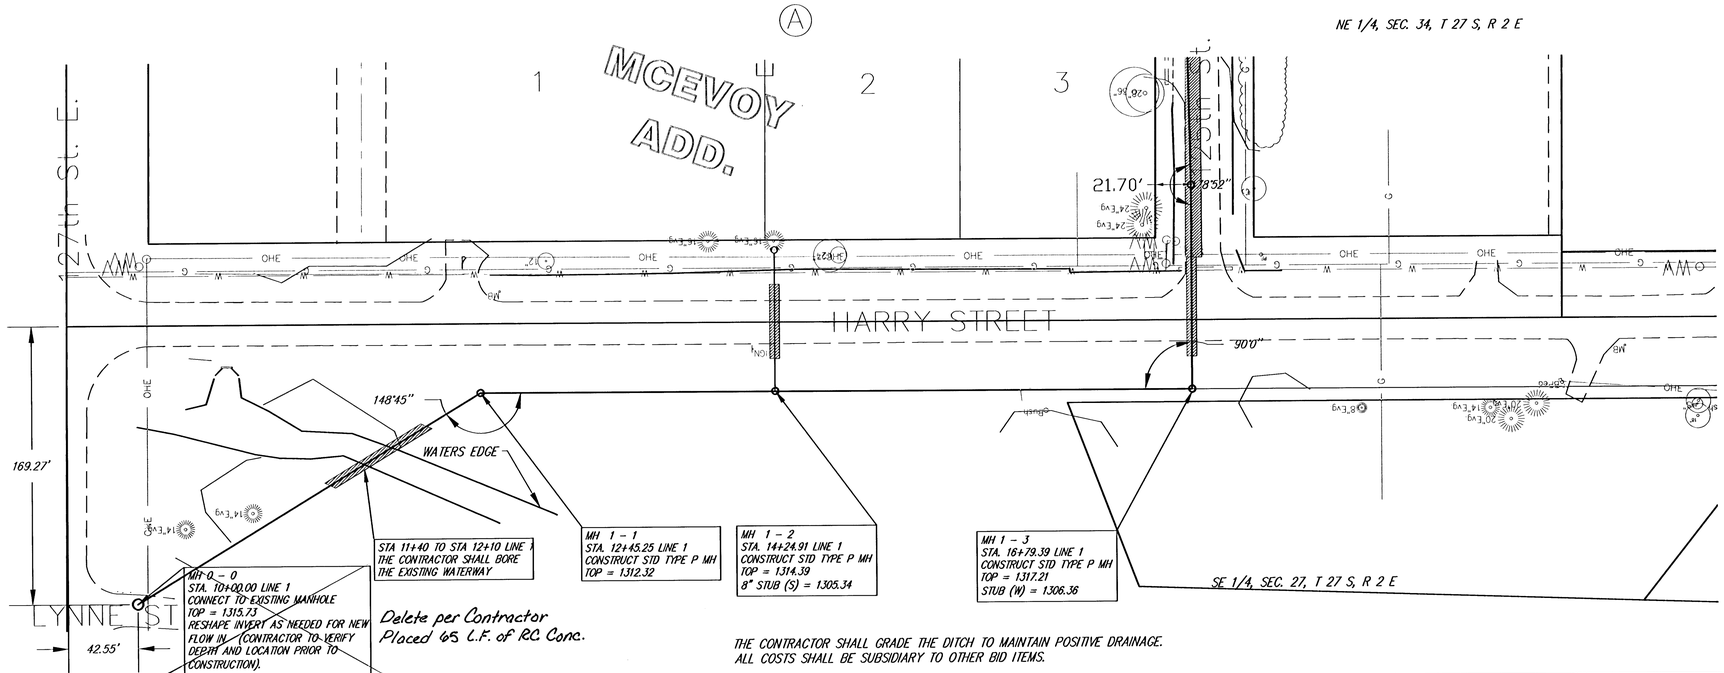

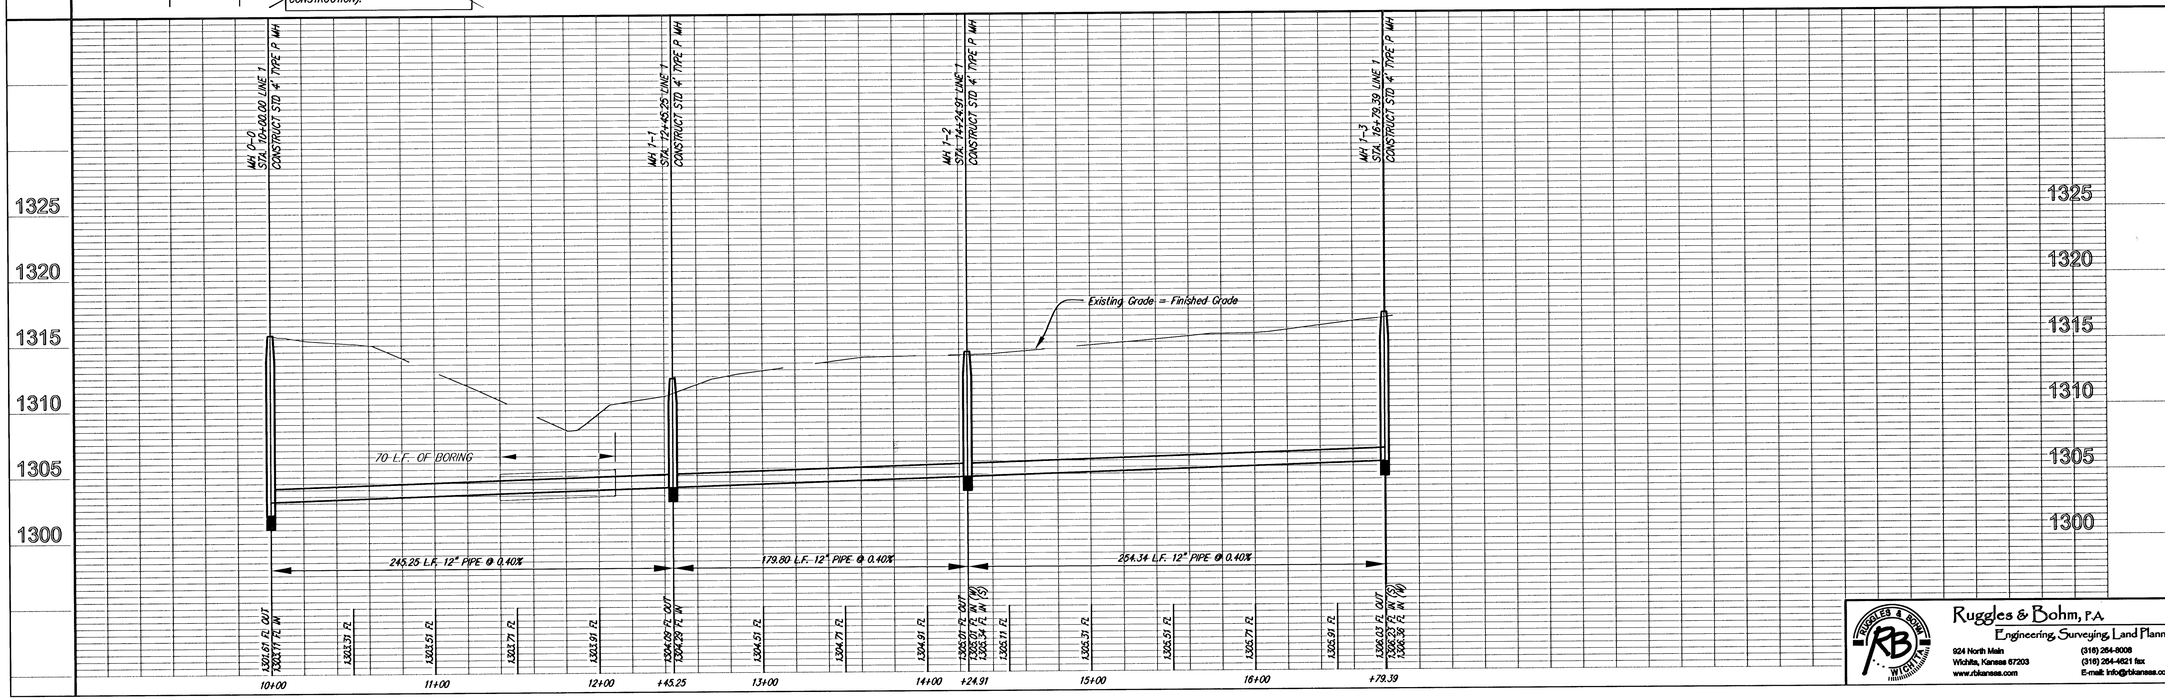

DESIGN PDC
DRAWN PDC
DATE 9/26/05
REVISED
REVIEW 11/17/05
UTILITY

PROJECT NUMBER 468-84026
DRAWING FILE 6705- base

SANITARY SEWER MAIN
LINE 1, MAIN 16, SS #23
WICHITA, KANSAS

Ruggles & Bohm, P.A.
Engineering, Surveying, Land Planning
924 North Main
Wichita, Kansas 67203
www.rbkansas.com
(316) 264-8008
(316) 264-4621 fax
E-mail: info@rbkansas.com

RB JOB 2612X
SHEET 3 of 17