



SE 1/4, SEC. 29, T 26 S, R 1 E

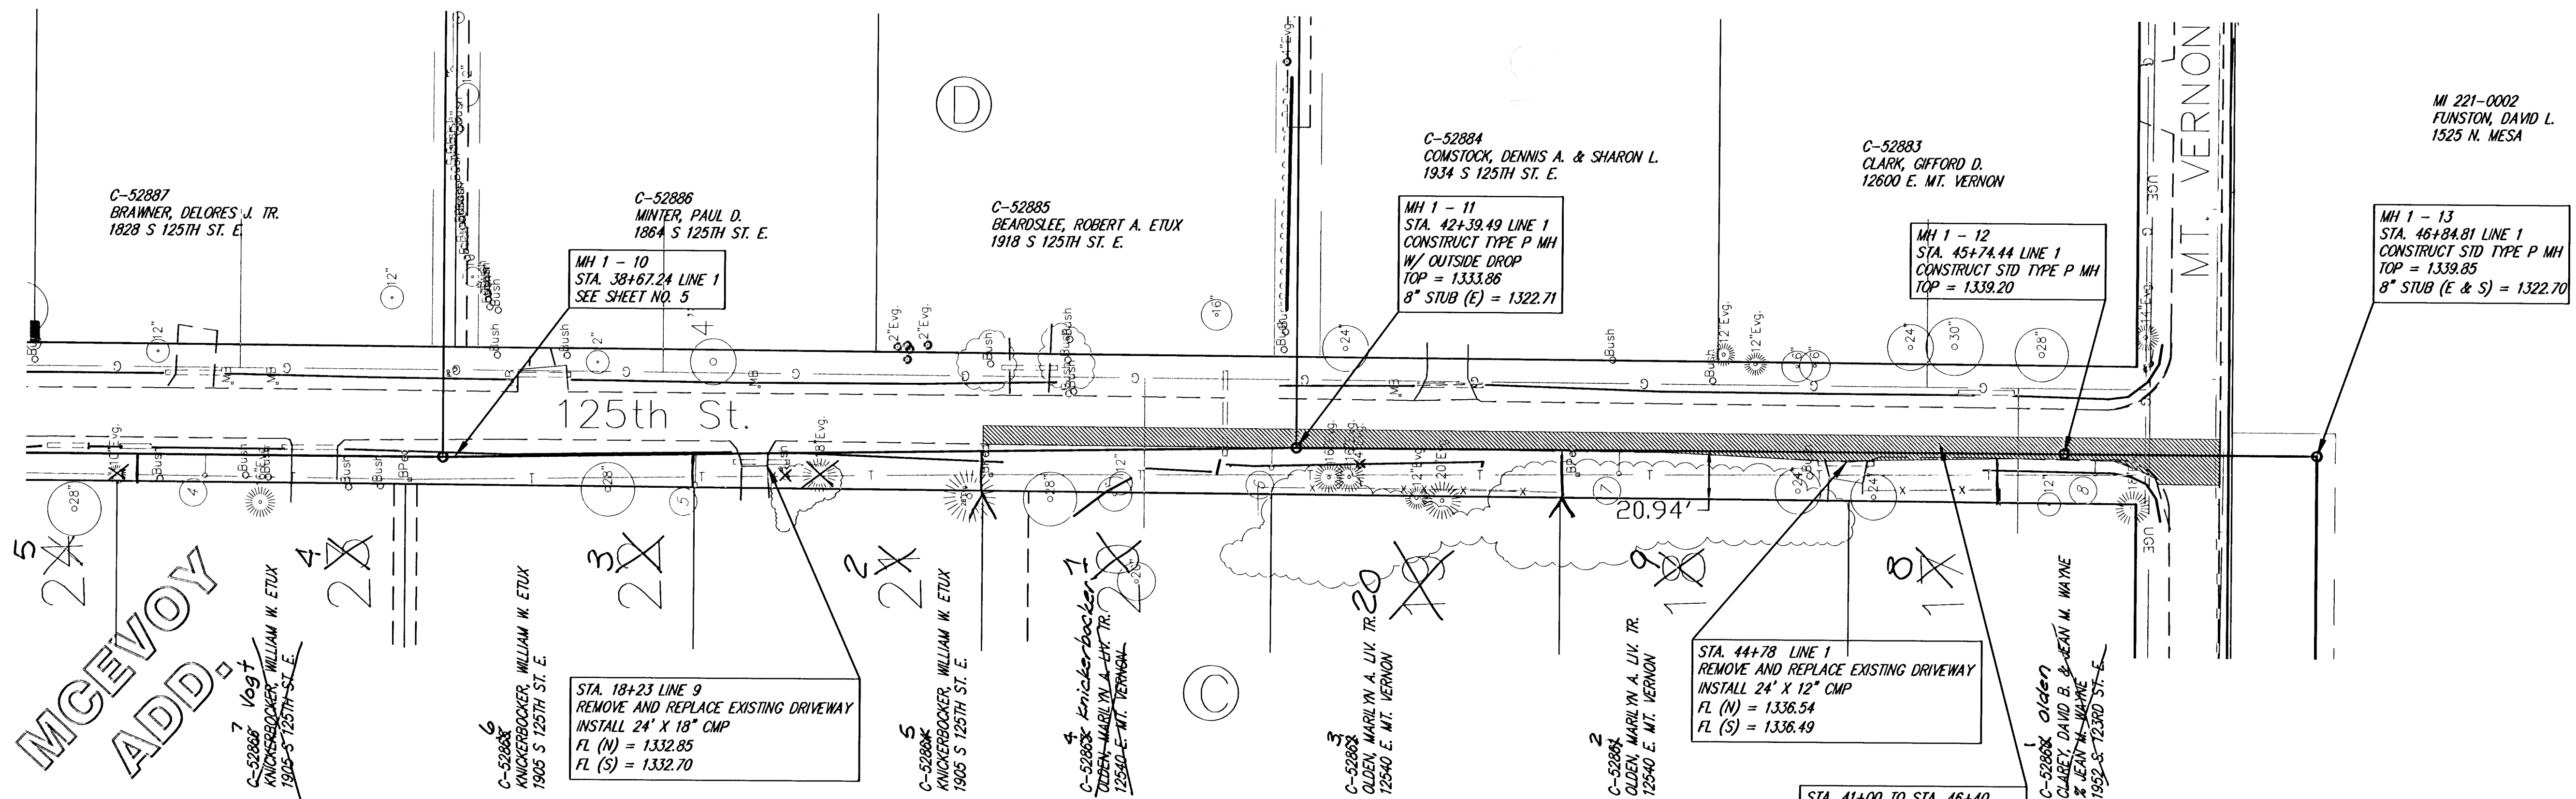

THE CONTRACTOR SHALL GRADE THE DITCH TO MAINTAIN POSITIVE DRAINAGE. ALL COSTS SHALL BE SUBSIDIARY TO OTHER BID ITEMS.

THE CONTRACTOR SHALL REMOVE AND REPLACE THE EXISTING ROADWAY TO CITY STANDARDS.

THE CONTRACTOR SHALL CONSTRUCT CLEANOUTS WITH RISERS AS SHOWN IN THE SEWER SERVICE TABLE (SHEET NO. 2) AND THE VERTICAL RISER DETAILS (SHEET NO. 11).

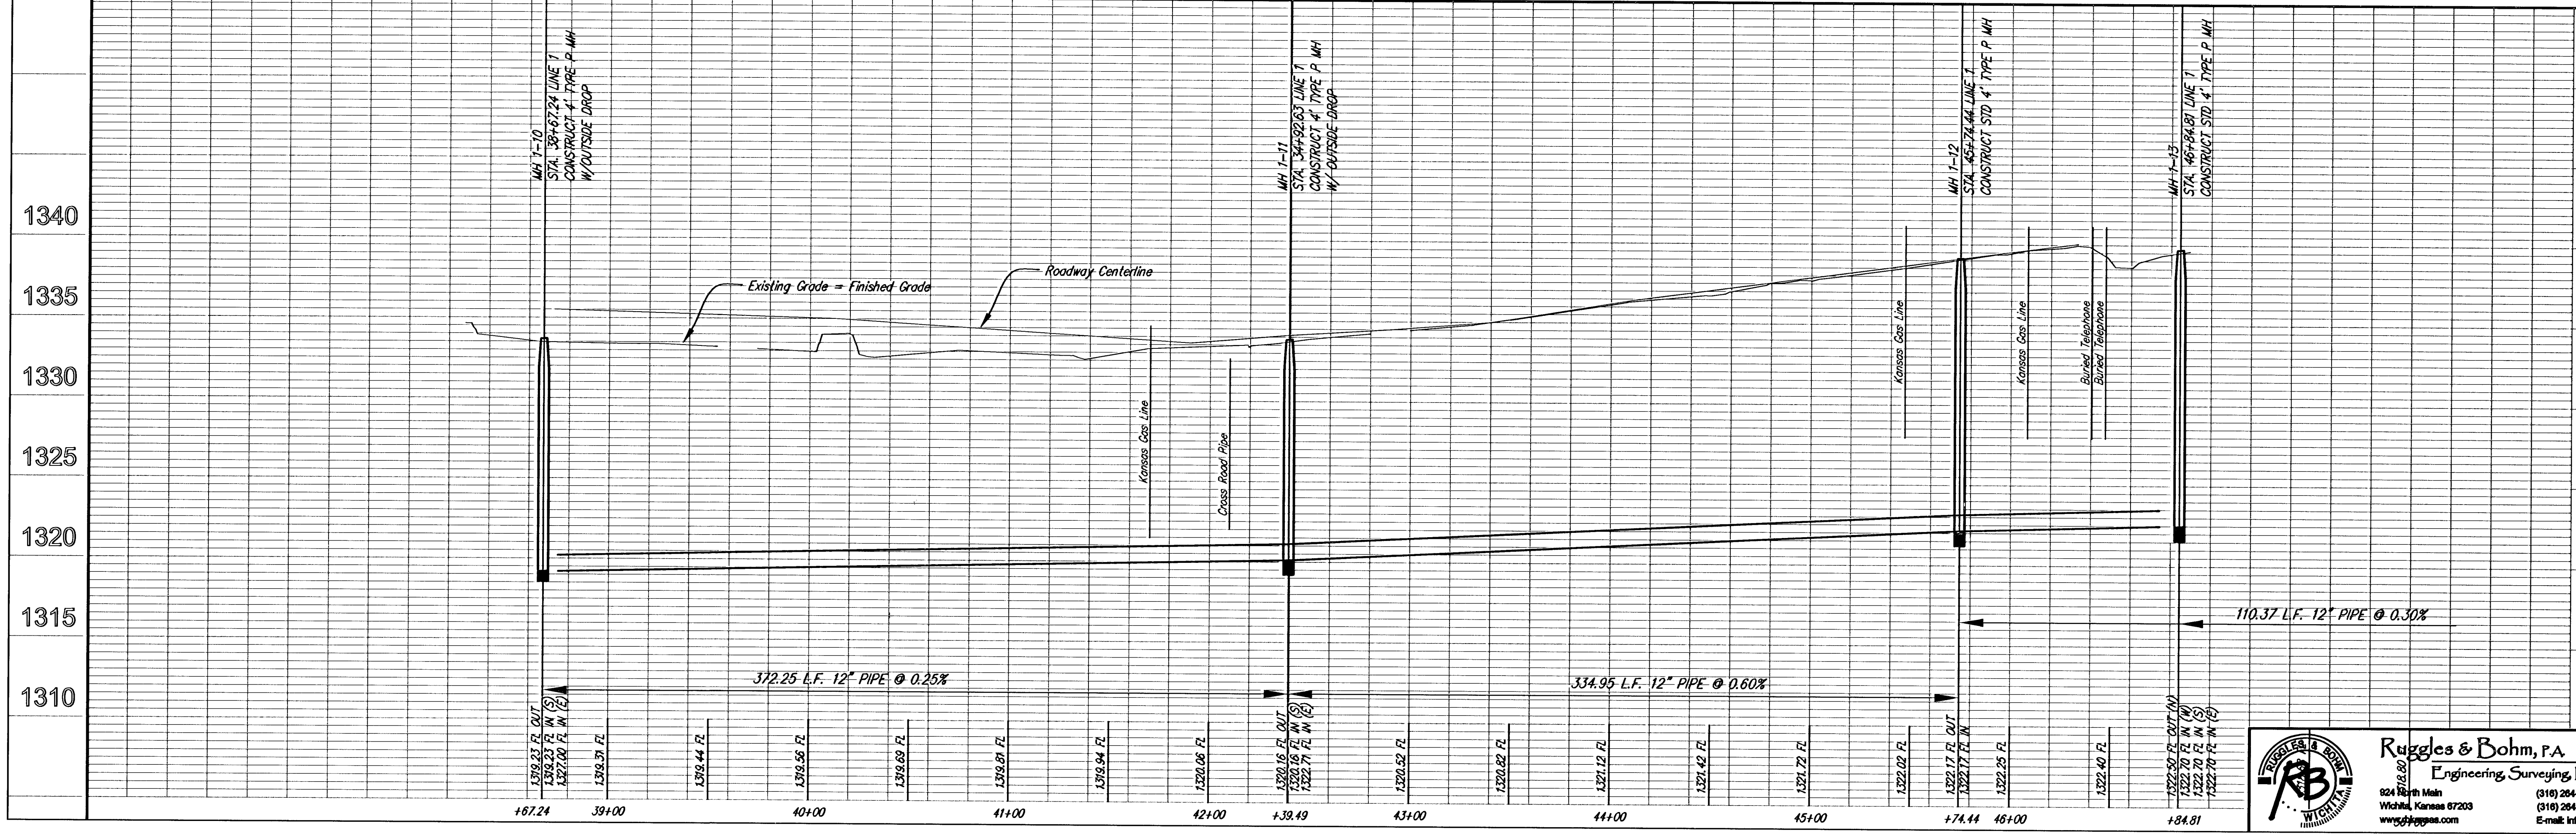

1340		DESIGN		DESIGN	REVIEW
		POC		POC	
1335		UTILITY		DATE	REVIEW
				9/26/05	11/17/05
1330		PROJECT NUMBER			
		468-84026			
1325		DRAWING FILE			
		eng: bbs			
1320					
1315					
SANITARY SEWER MAIN					
LINE 1, MCEVOY					
WICHITA, KANSAS					

Ruggles & Bohm, P.A.
Engineering, Surveying, Land Planning
824 North Main
Wichita, Kansas 67203
(316) 264-8008
(316) 264-4621 fax
www.rugglesandbohms.com

17