



SE 1/4, SEC. 29, T 26 S, R 1 E

MI 221-0002
FUNSTON, DAVID L.
1525 N. MESA

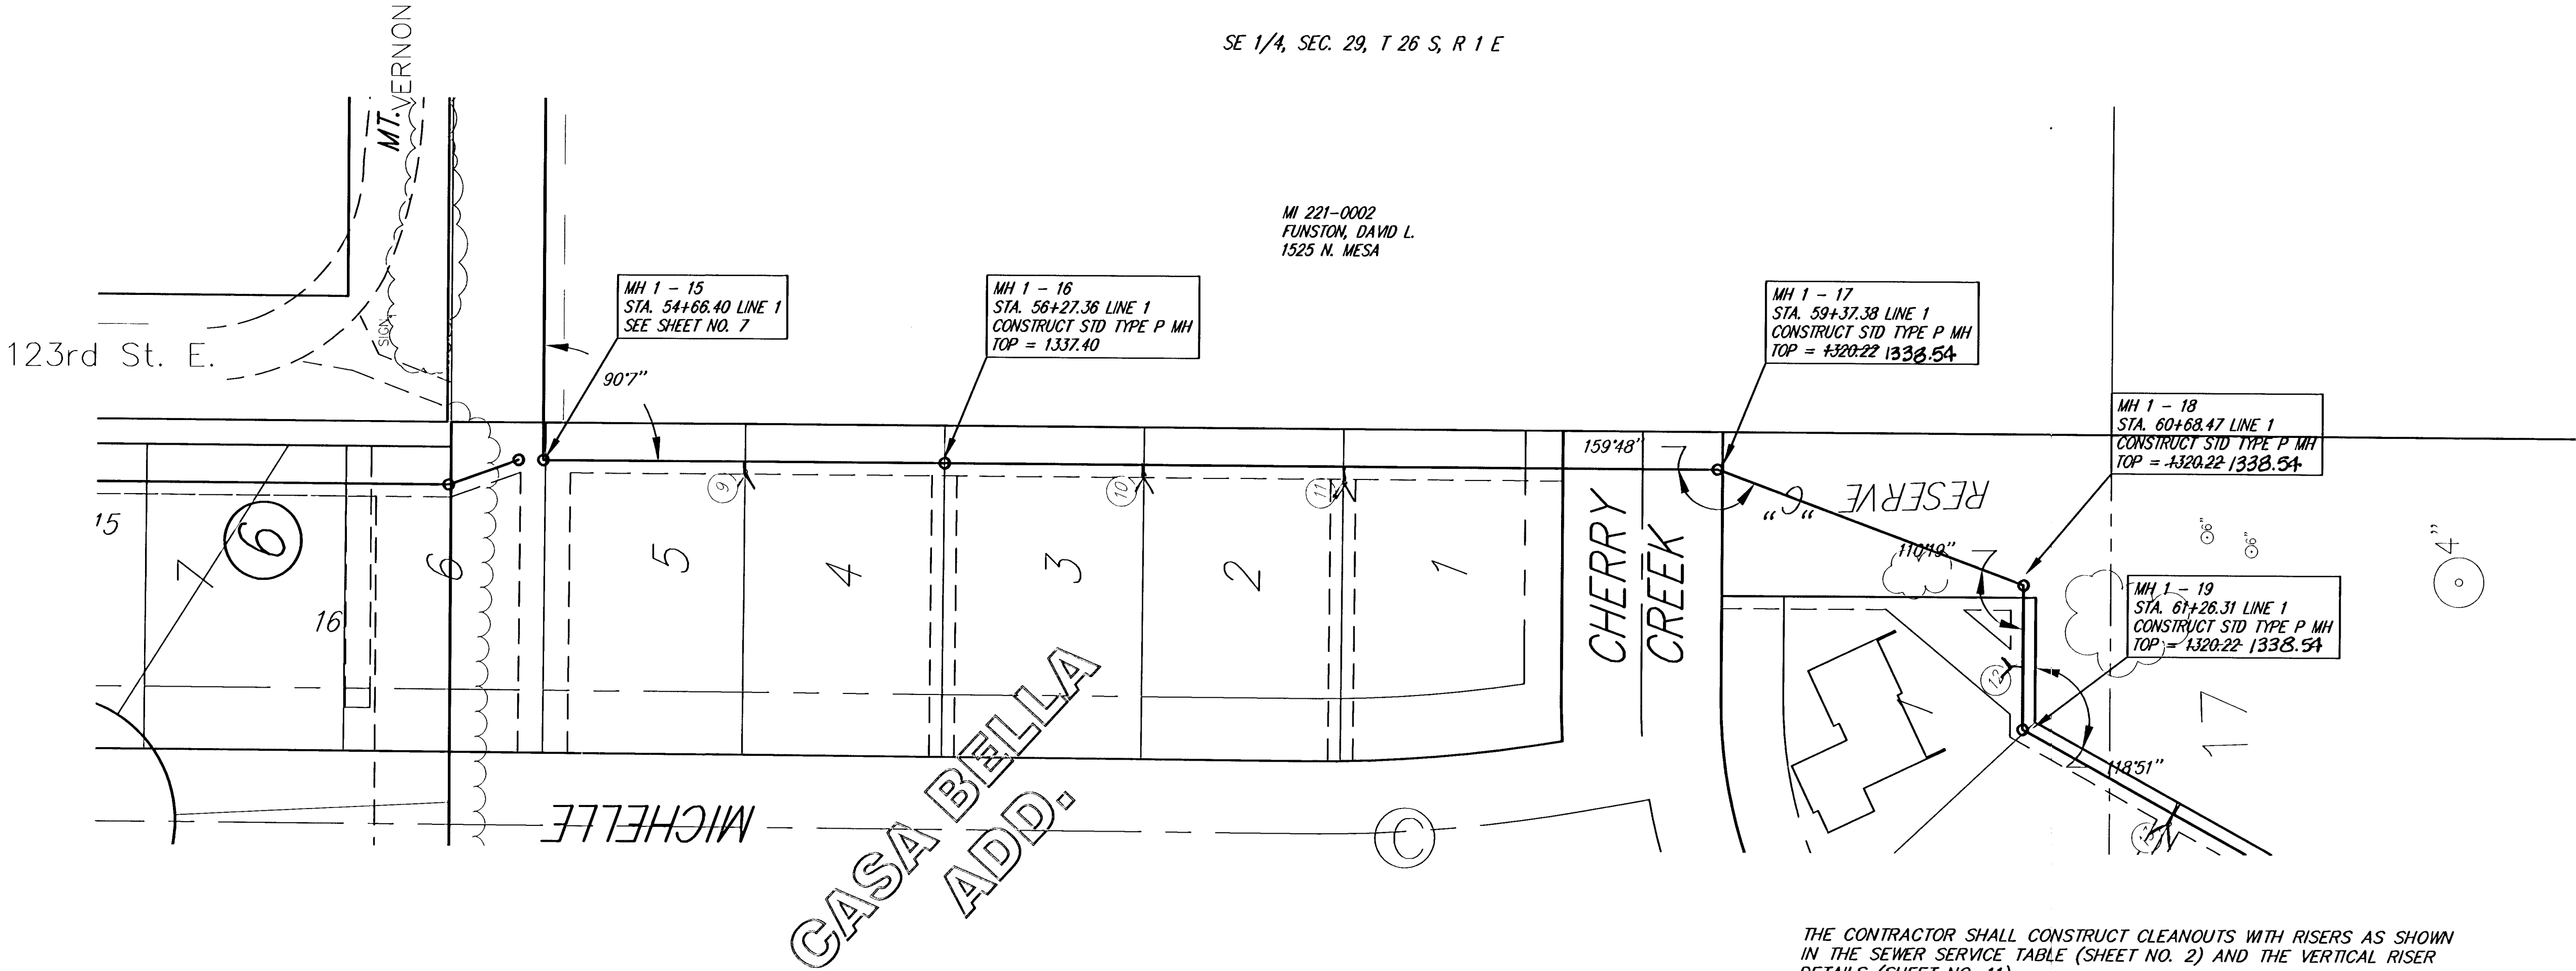

THE CONTRACTOR SHALL CONSTRUCT CLEANOUTS WITH RISERS AS SHOWN
IN THE SEWER SERVICE TABLE (SHEET NO. 2) AND THE VERTICAL RISER
DETAILS (SHEET NO. 11).

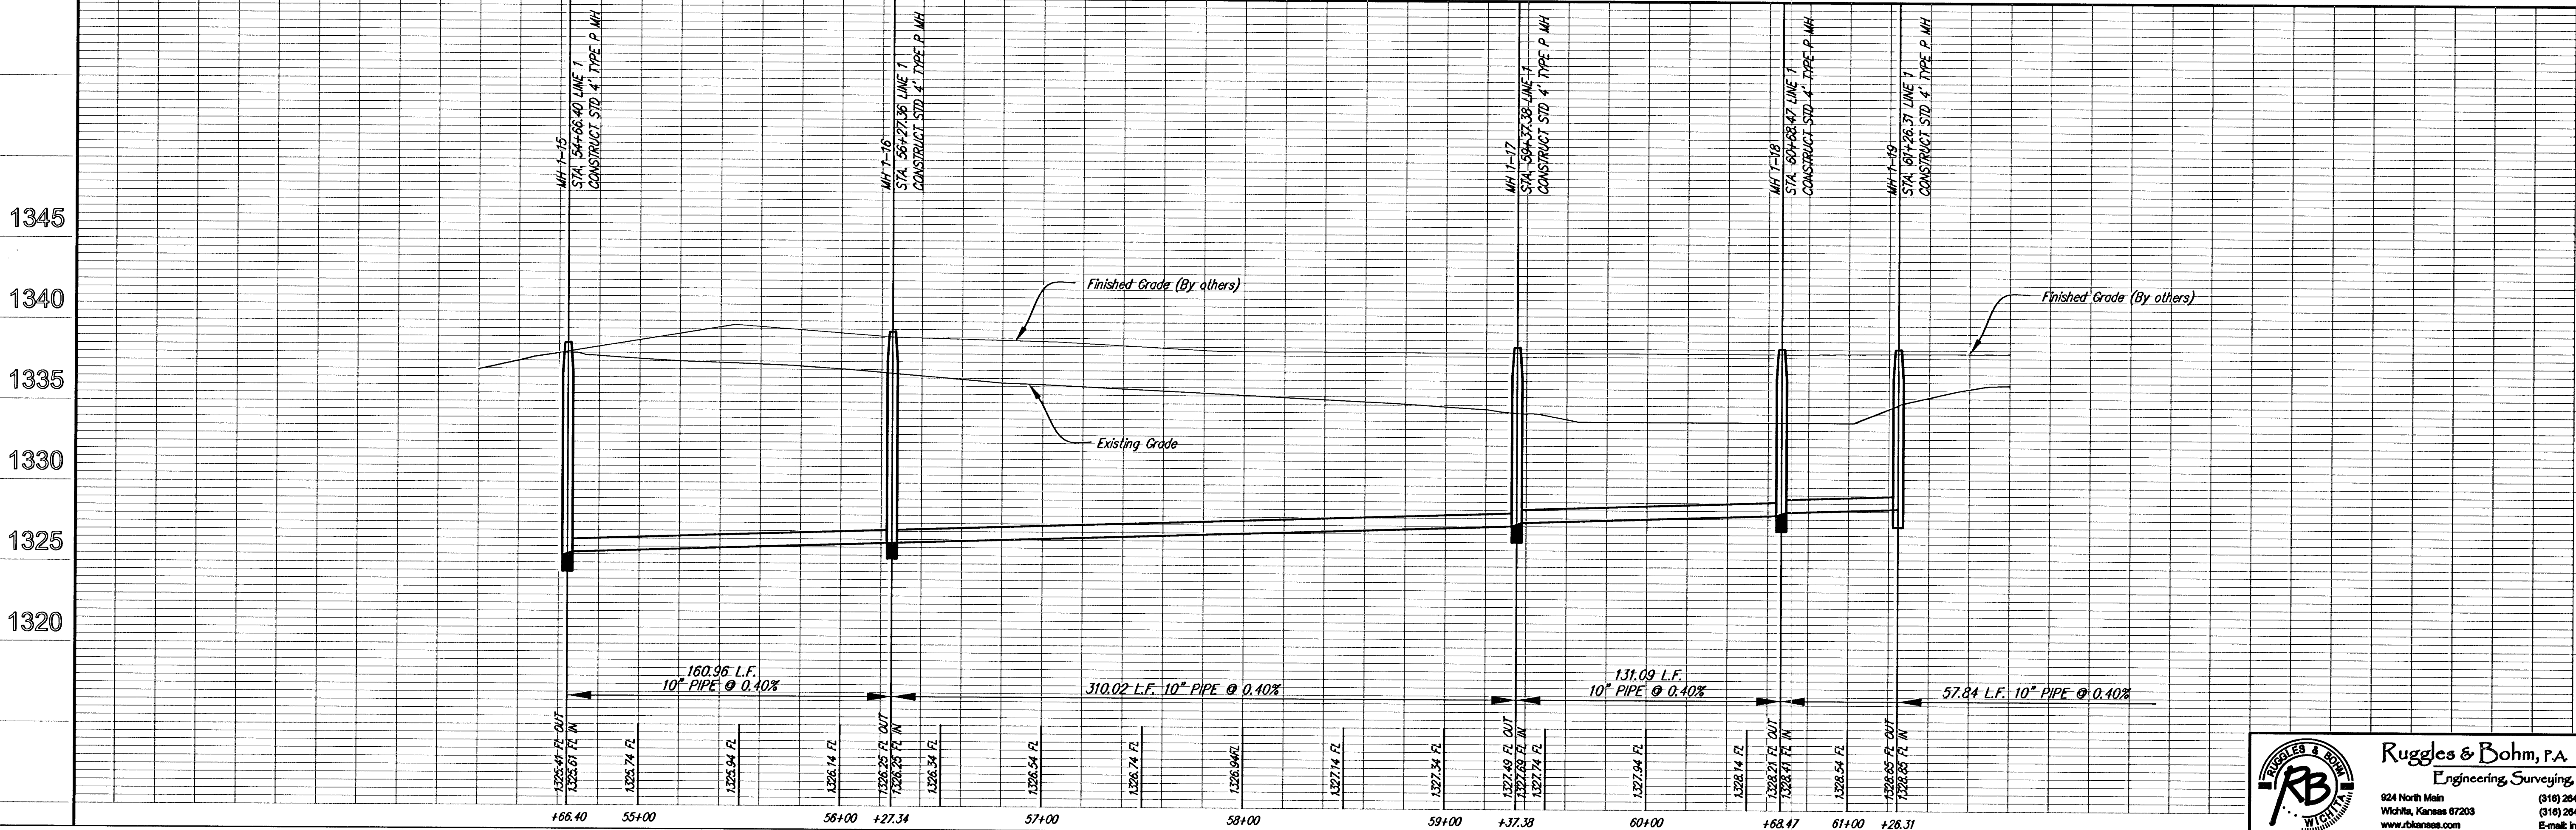

REVISION	DATE	BY	REASON
1	9/27/05	11/17/05	
2			
3			
Rugles & Bohm, P.A.
Engineering, Surveying, Land Planning
924 North Main
Wichita, Kansas 67203
www.rbkansas.com

PROJECT NUMBER
468-64026

DRAWING FILE
engs-base

REVISION
DATE
BY
REASON

9/27/05 11/17/05

SANITARY SEWER MAIN
LINE 1, MCEVOY
WICHITA, KANSAS

2612X
SHEET
8
17