

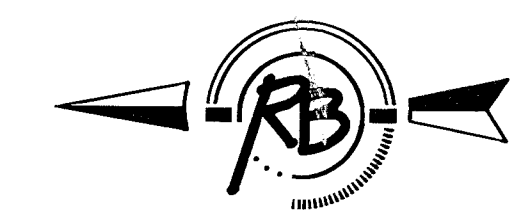



SE 1/4, SEC. 29, T 26 S, R 1 E

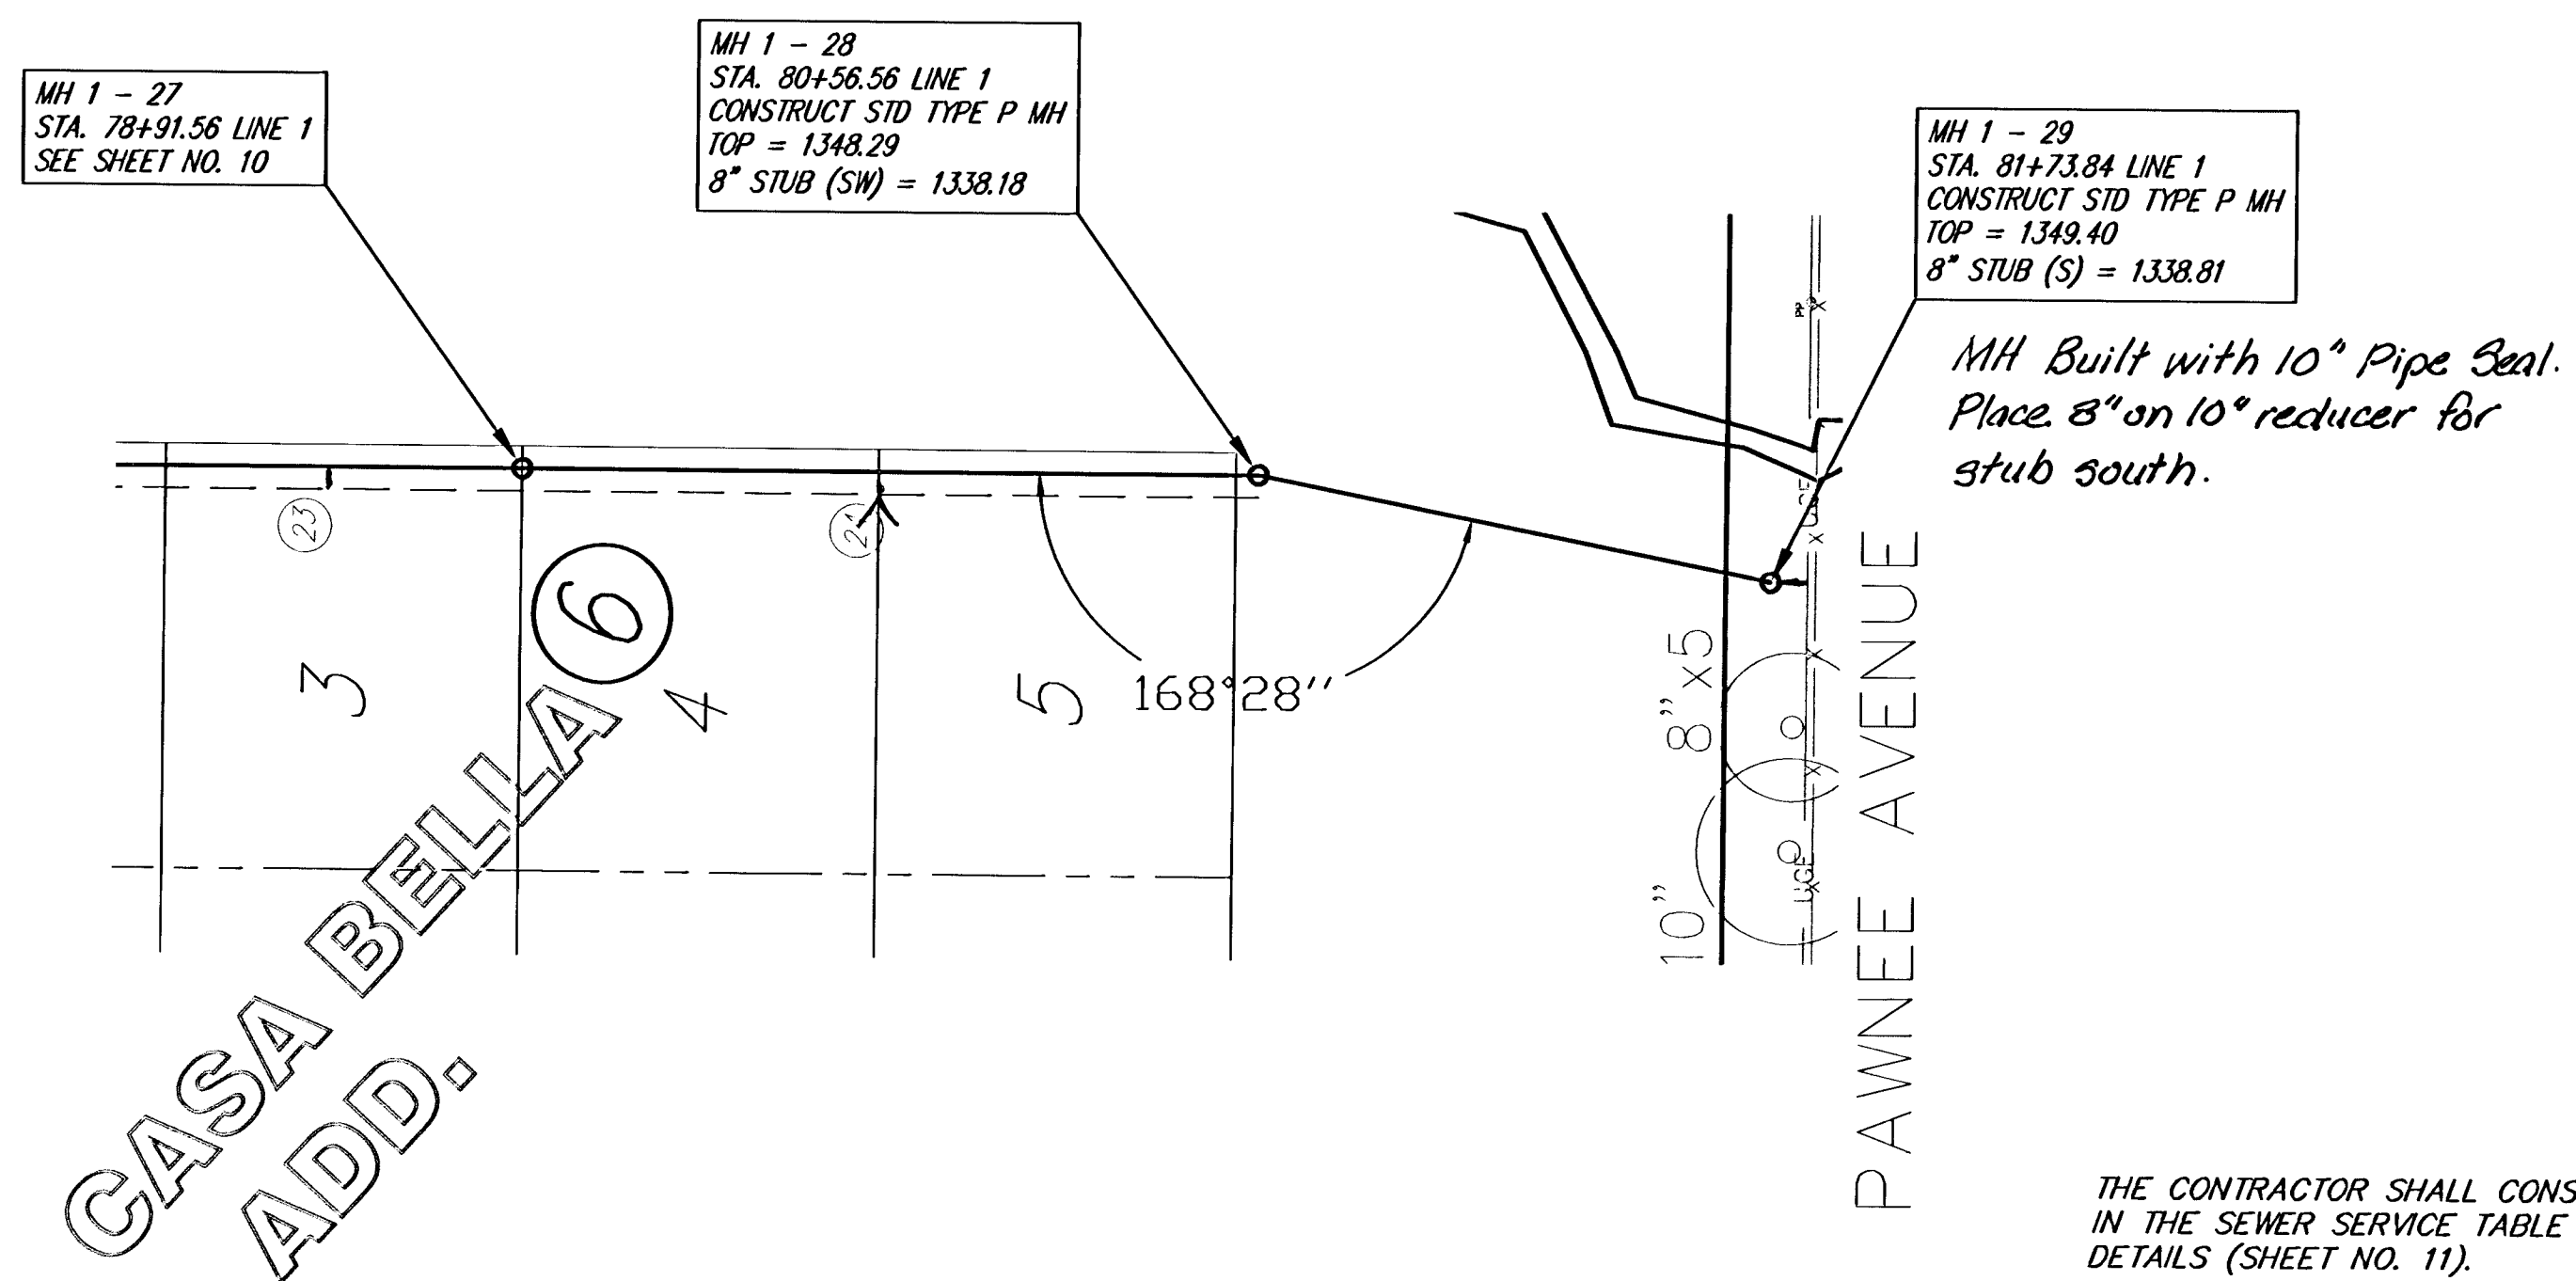

Scale 1" = 40' (Horiz.)
1" = 5' (Vert.)

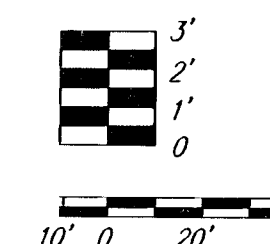

THE CONTRACTOR SHALL CONSTRUCT CLEANOUTS WITH RISERS AS SHOWN IN THE SEWER SERVICE TABLE (SHEET NO. 2) AND THE VERTICAL RISER DETAILS (SHEET NO. 11).

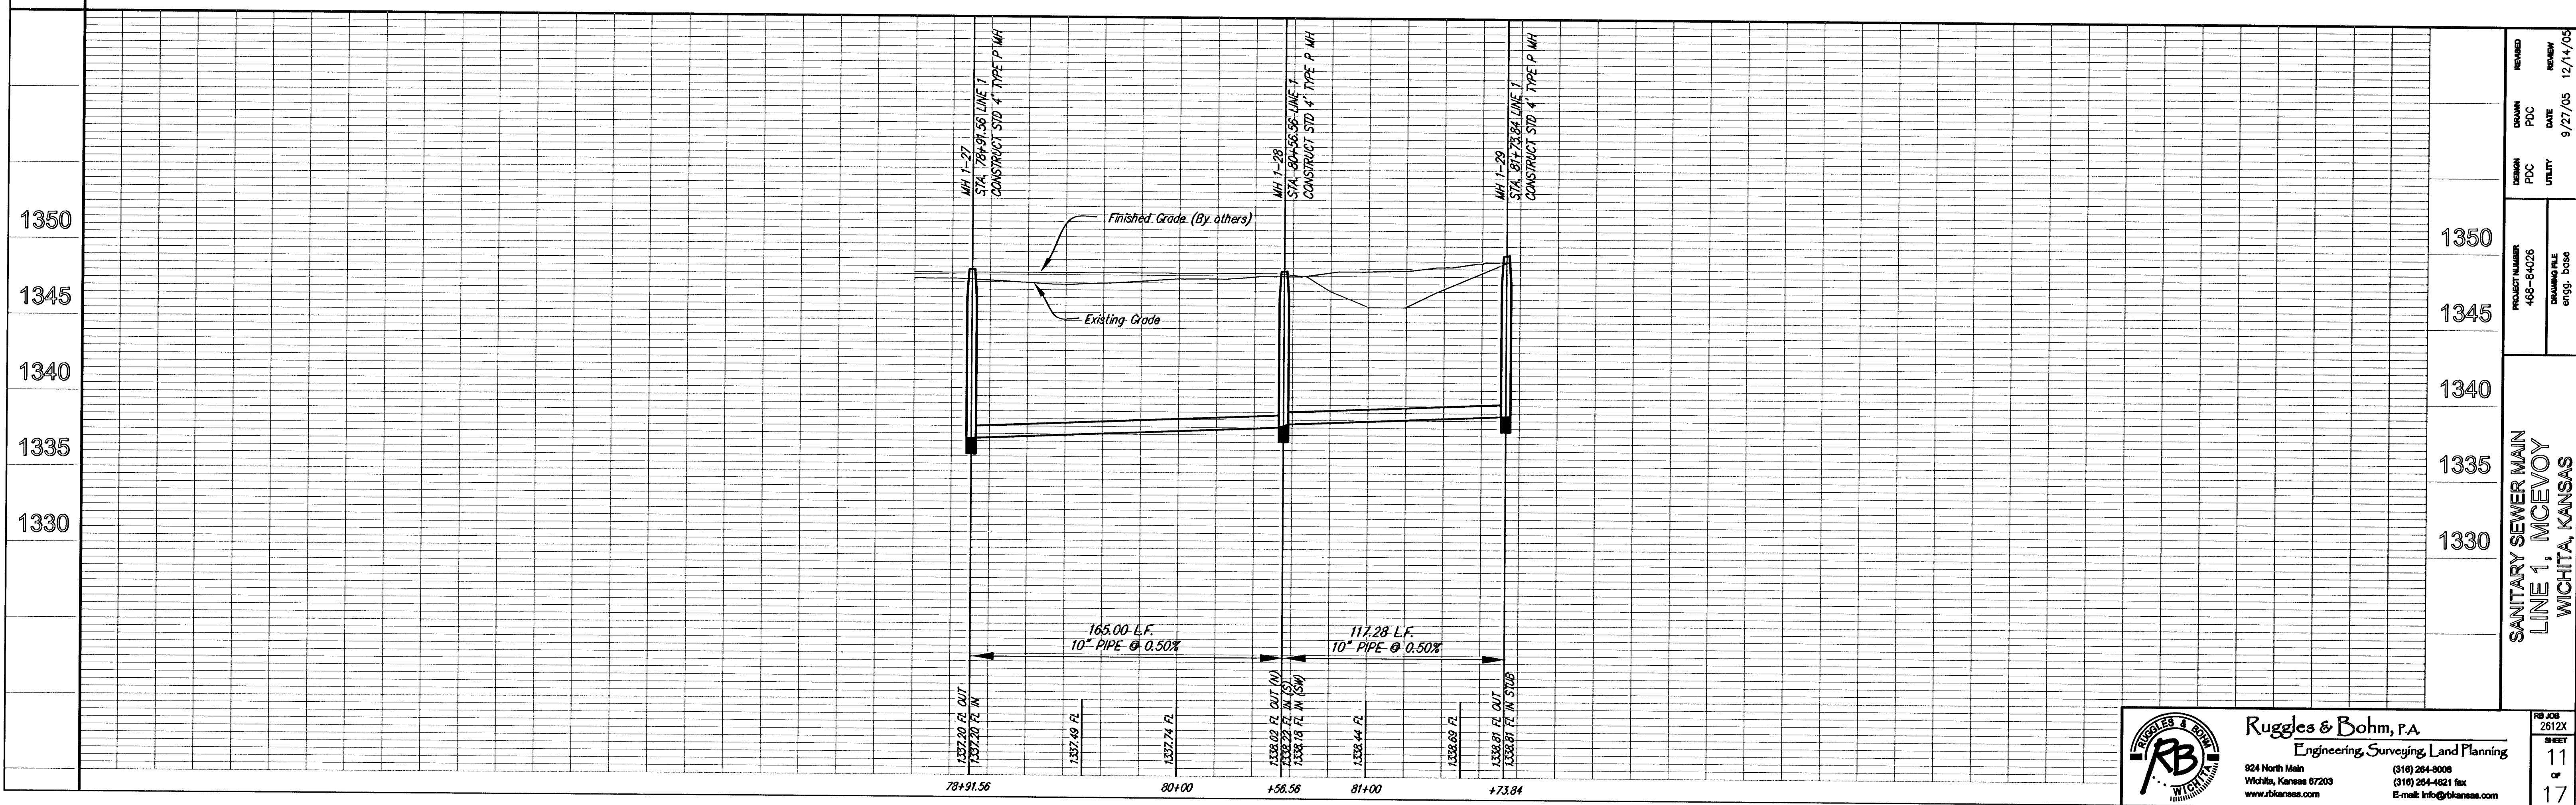

PROJECT NUMBER 468-84026	DESIGN PDC UTILITY	DRAWN PDC DATE 9/27/05	REVISION REVIEW DATE 12/14/05
PROJECT NAME engg. base			

SANITARY SEWER MAIN
LINE 1, MCEVOY
WICHITA, KANSAS

Ruggles & Bohm, P.A.
Engineering, Surveying, Land Planning

924 North Main
Wichita, Kansas 67203
www.rbkansas.com

(316) 264-8008
(316) 264-4821 fax
E-mail: info@rbkansas.com

RB JOB
2612X
SHEET
11
OF
17