
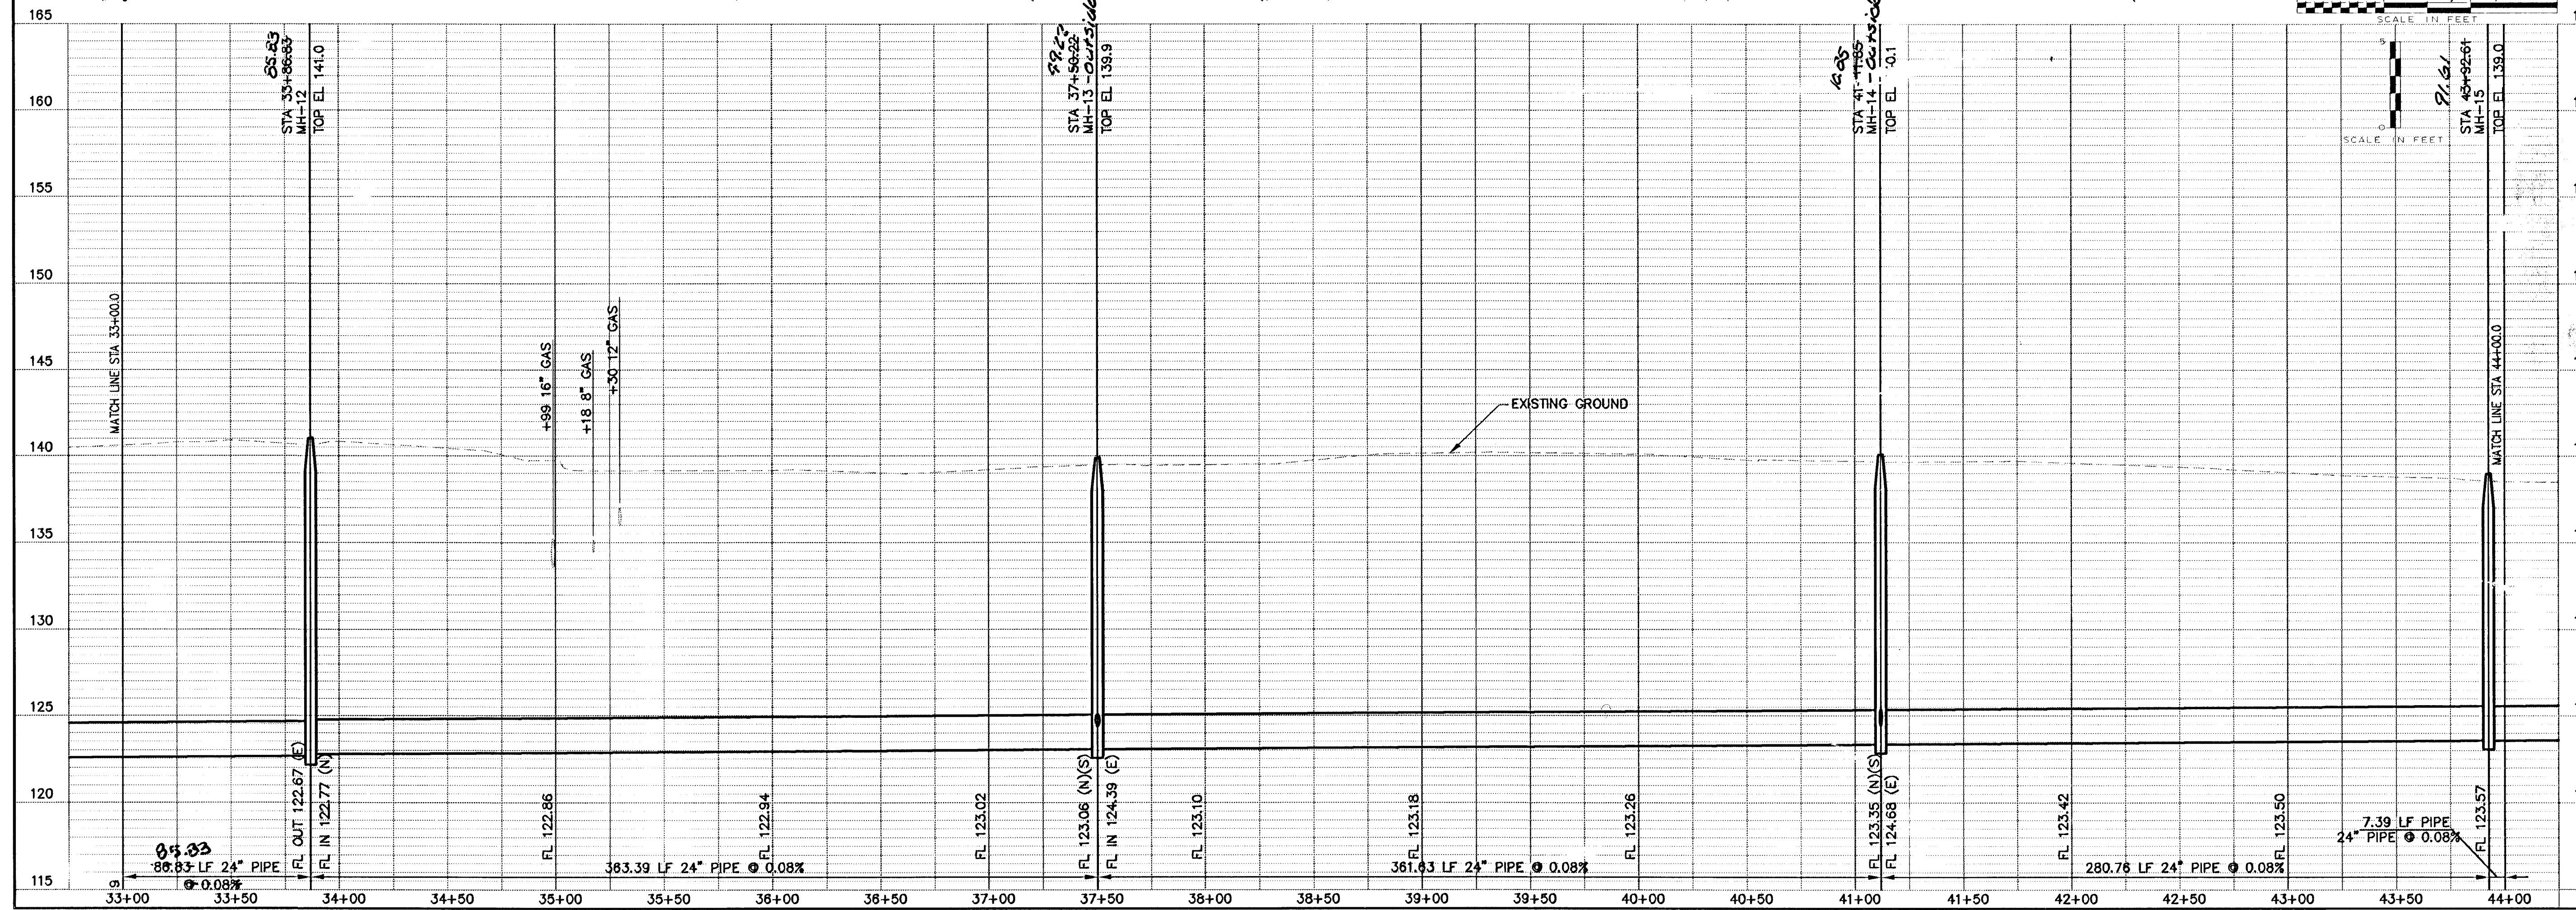


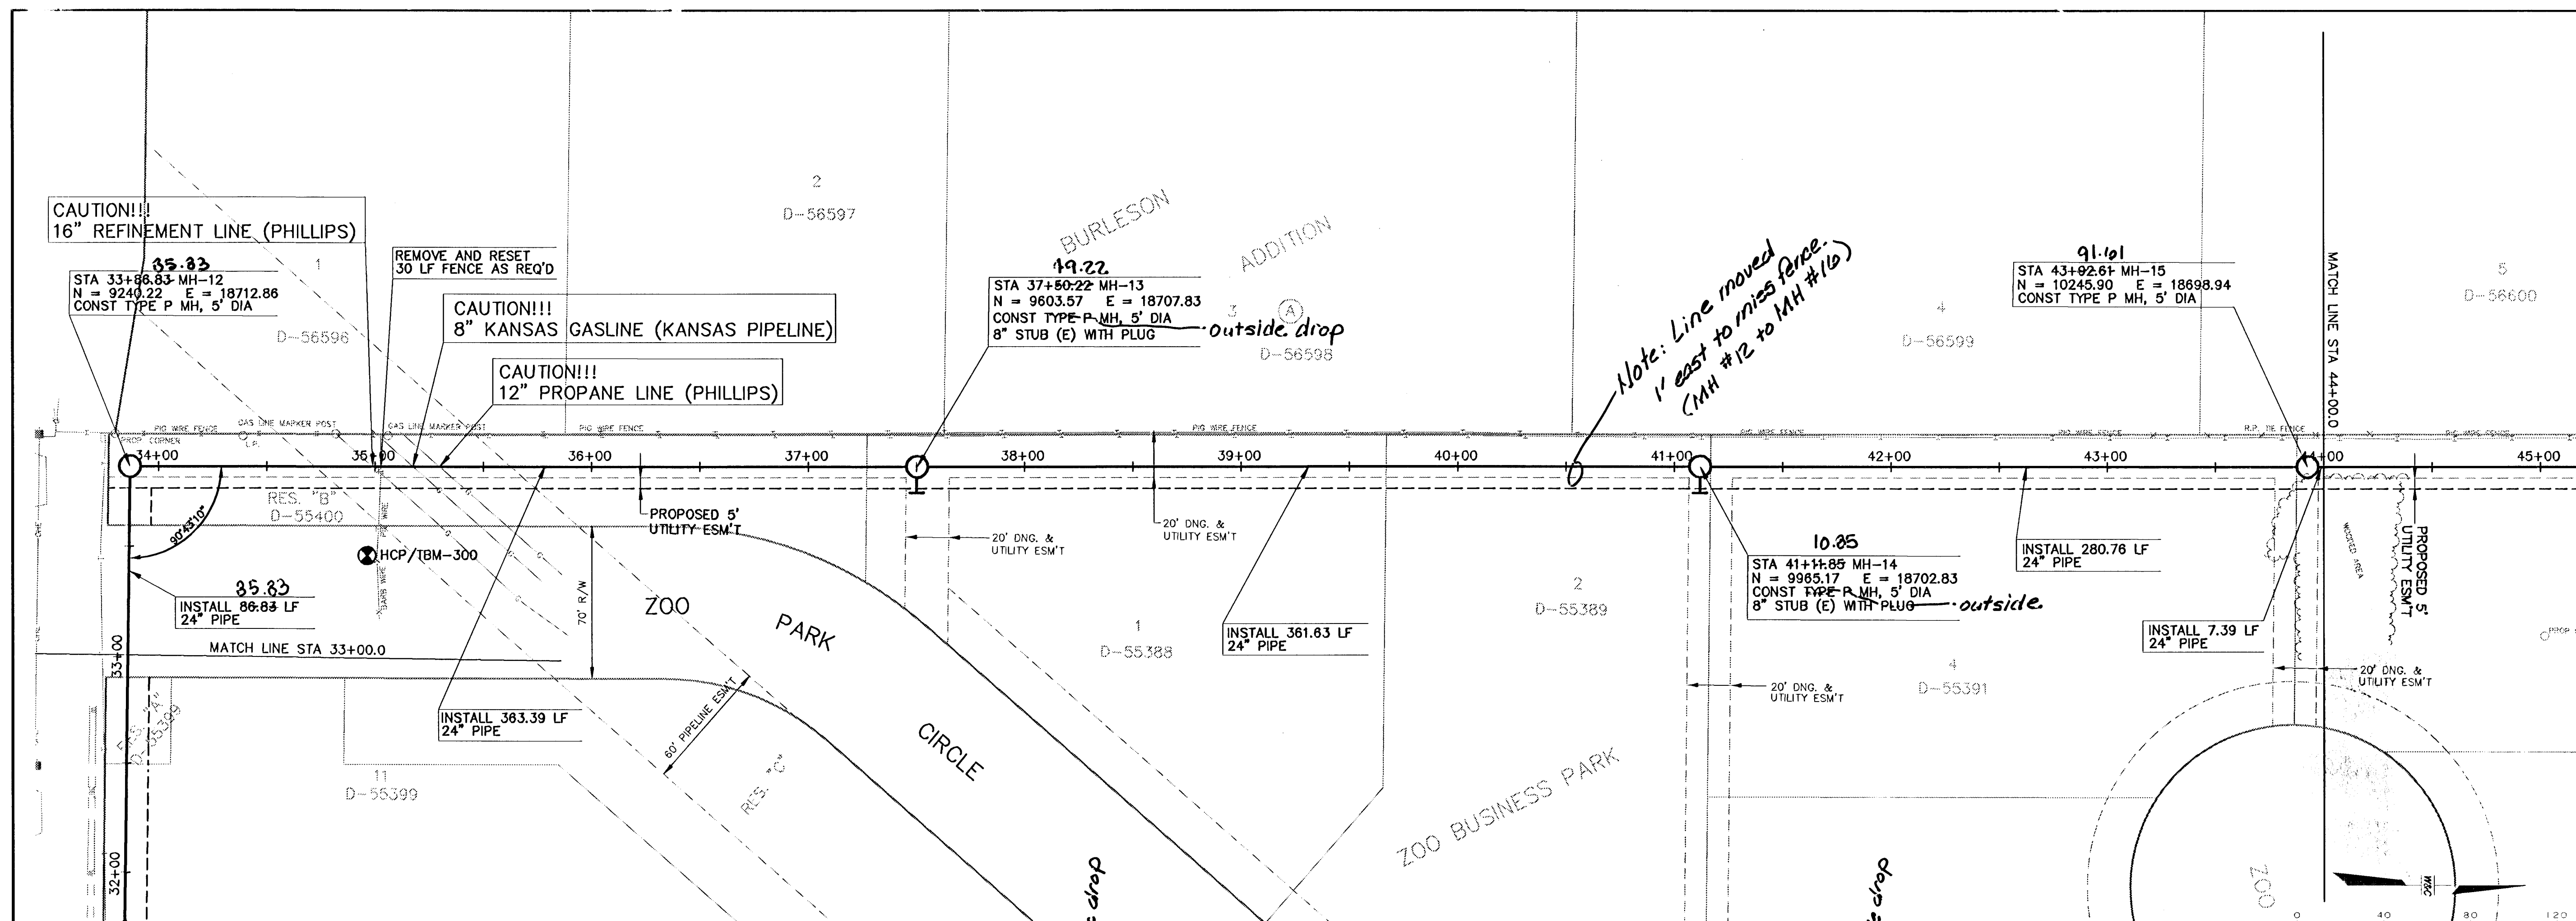

|   |                                                      |
|---|------------------------------------------------------|
|   |                                                      |
| <h1>WILSON &amp; COMPANY</h1>   |                                                      |
| <p>CITY OF WICHITA, KANSAS<br/>         MAIN 20 SOUTHWEST INTERCEPTOR SEWER<br/>         468-83185<br/>         PLAN 8 PROFILE<br/>         STA. 33+00.0 TO STA. 44+00.0</p> |                                                      |
| DESIGN<br>DWB<br>DRAWN<br>MEK/KMD<br>DATE<br>APRIL 2004<br>FILE NO.<br>X1460002<br>SHEET NO.<br>6                                                                            | CHECKED<br>JLM<br>JIM L. ARMOUR, P.E., C.T. ENGINEER |