
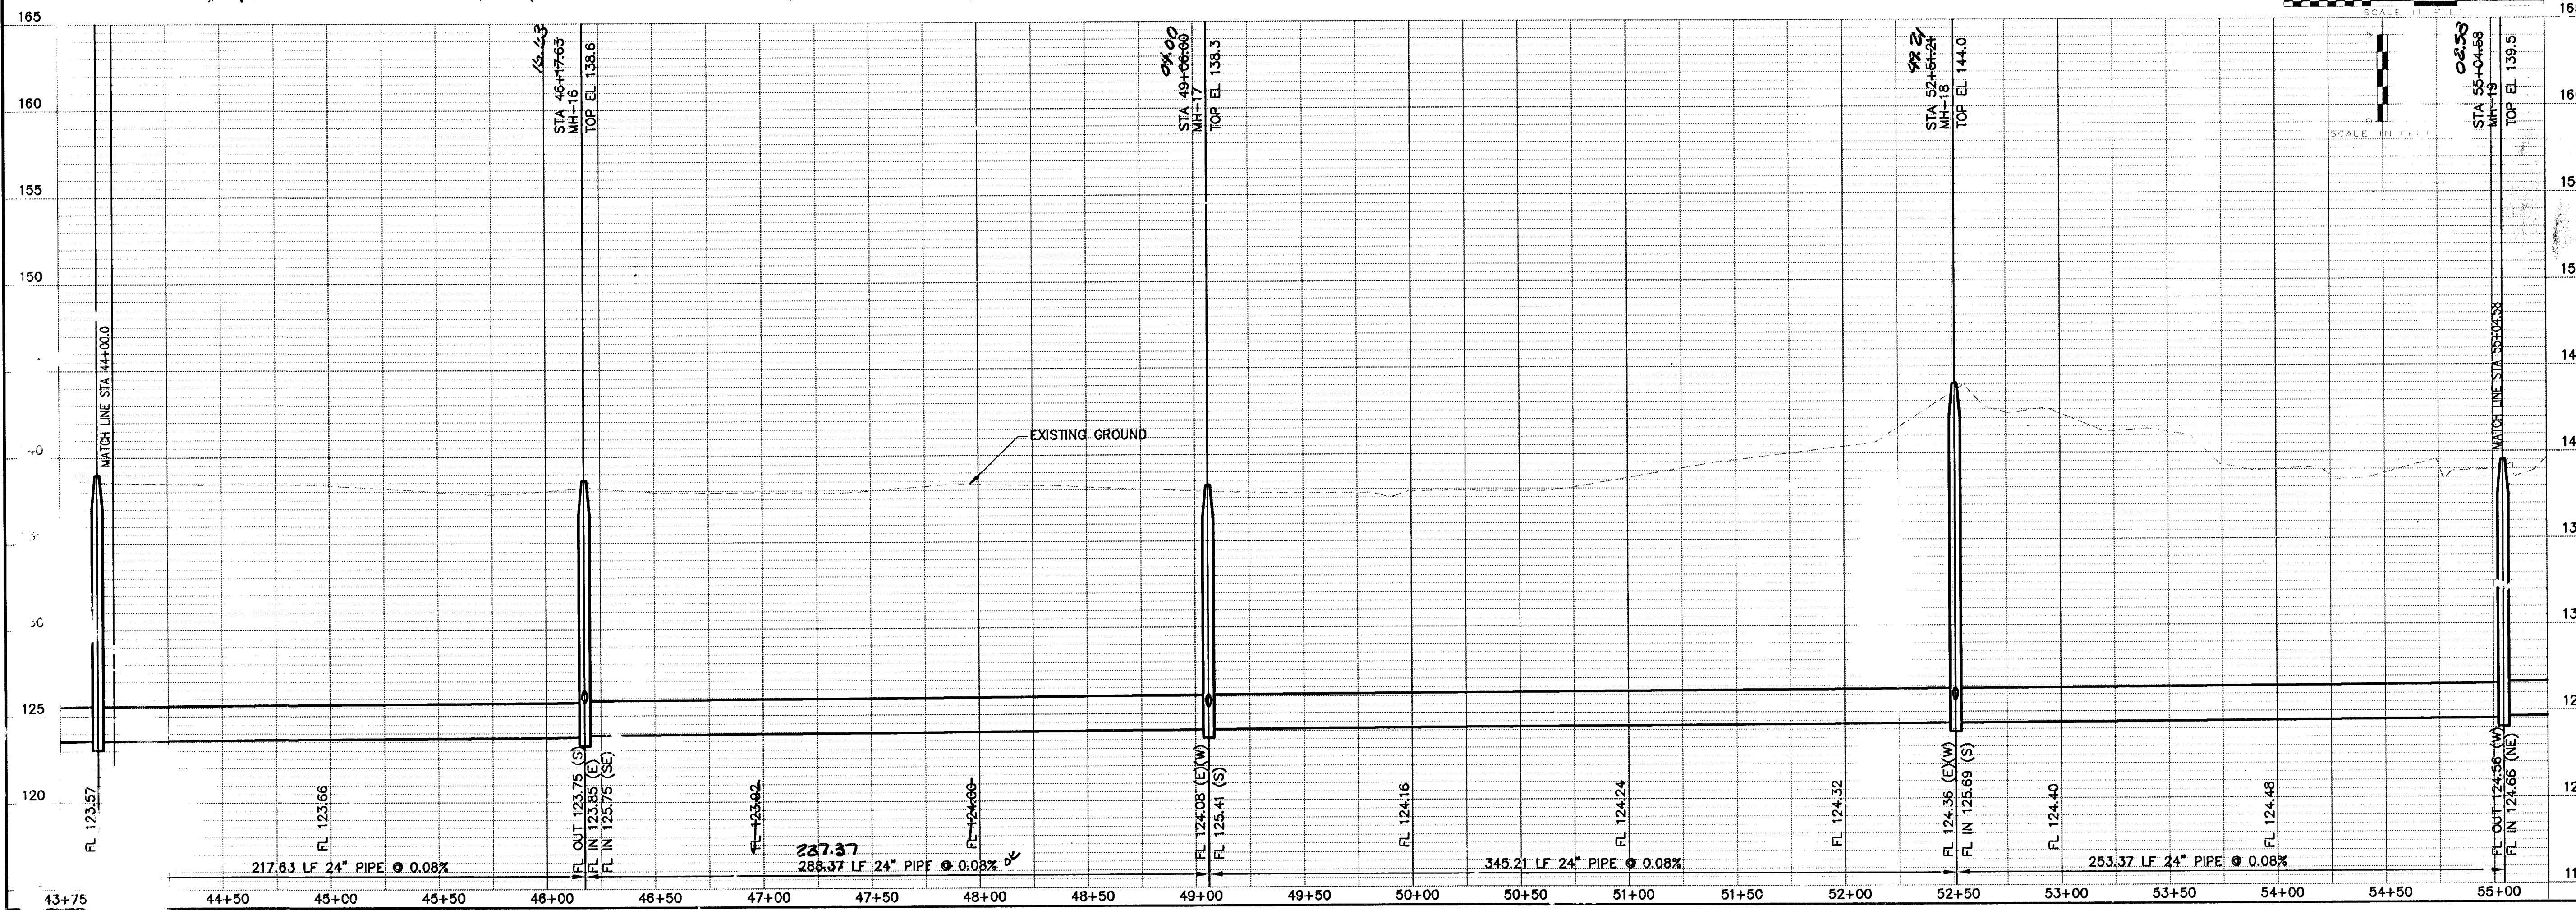


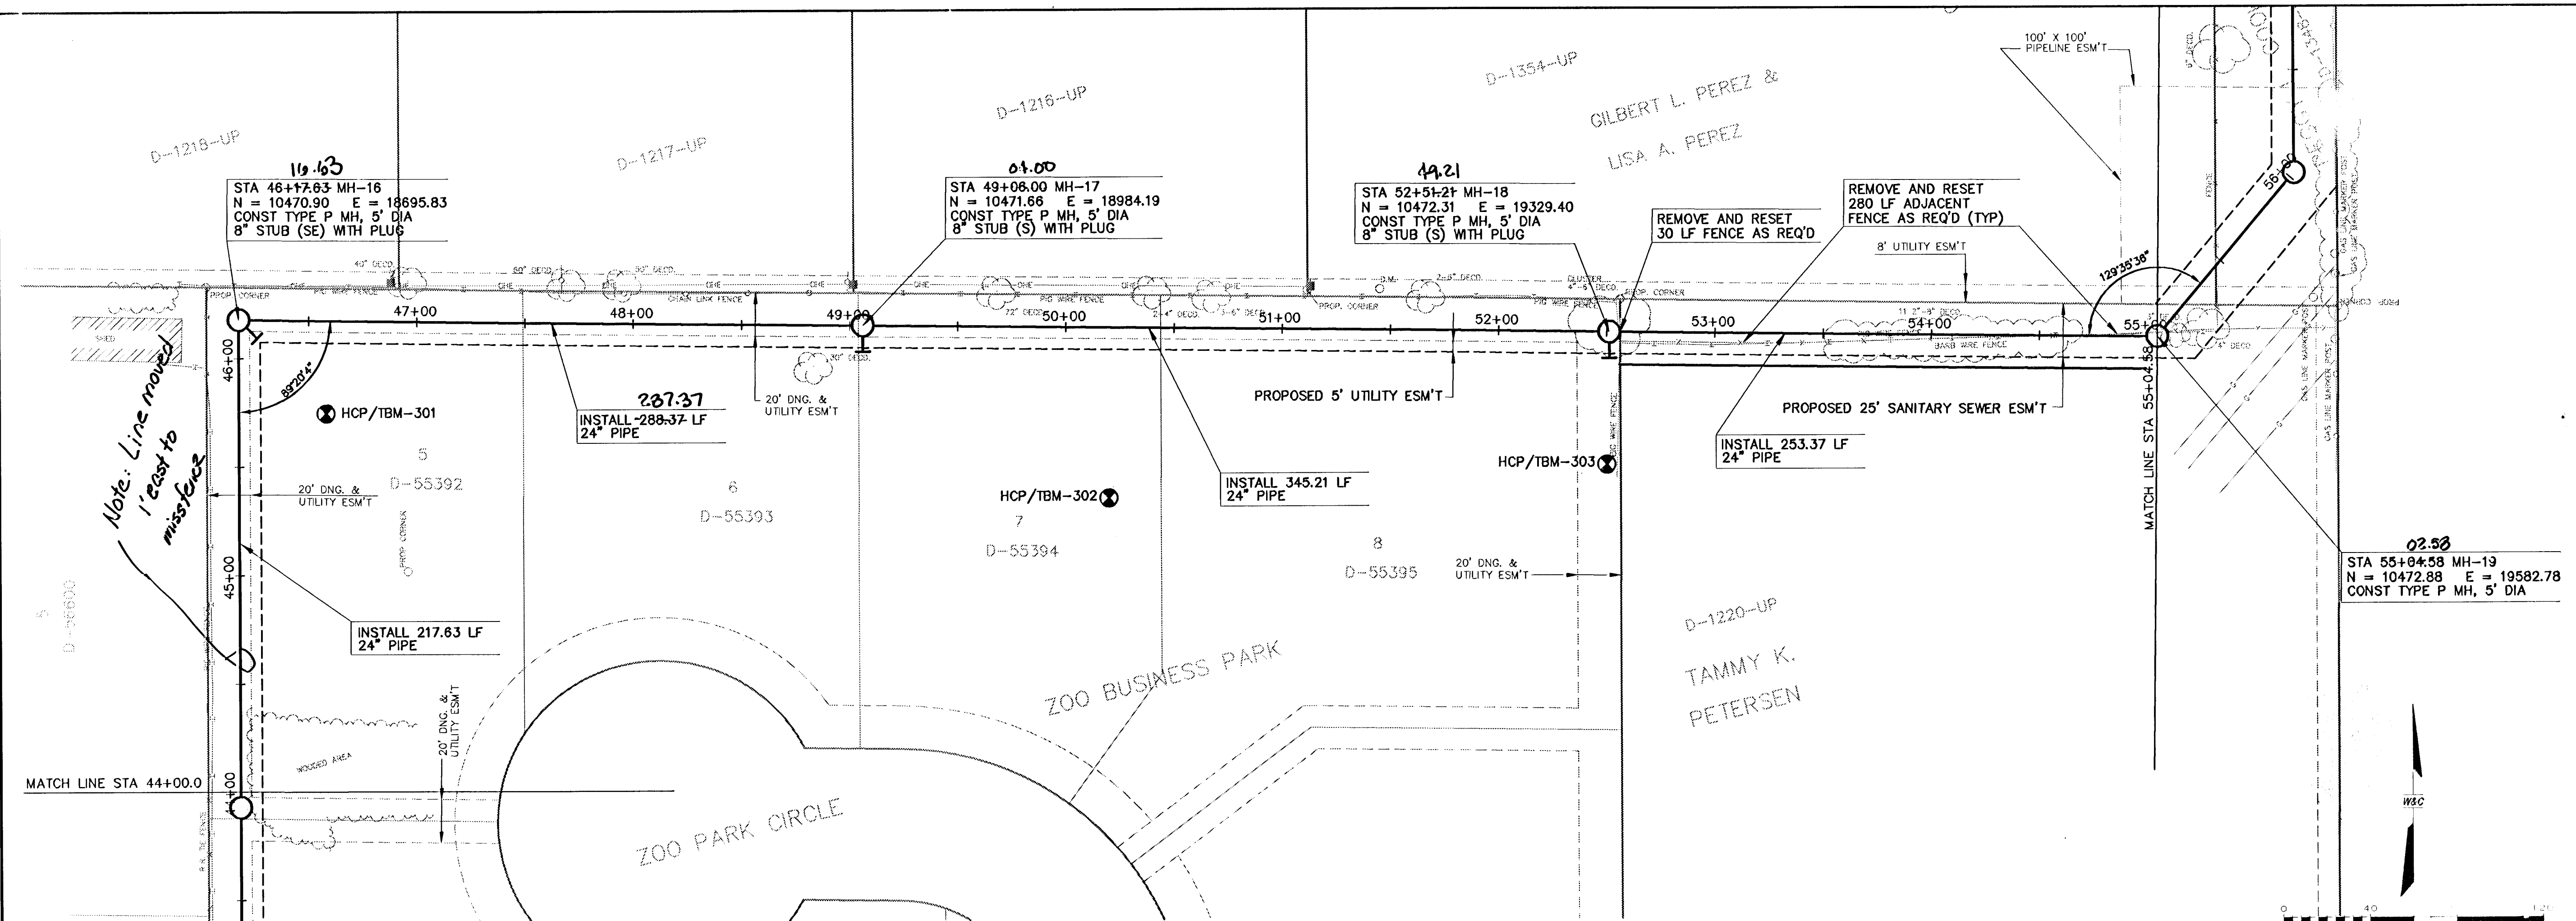

DESIGN DHW		CHECKED JLM	
DRAWN MEK/KMD		DATE APRIL 2004	
FILE NO. X1460002		SHEET NO. 7	
WILSON & COMPANY WICHITA, KANSAS			

CITY OF WICHITA, KANSAS
MAIN 20 SOUTHWEST INTERCEPTOR SEWER
PLAN & PROFILE
STA. 44+00.0 TO STA. 55+04.58

PROFESSIONAL ENGINEER
KANSAS
13329
4-06-04
M. L. ARMOUR, P.E. - CITY ENGINEER