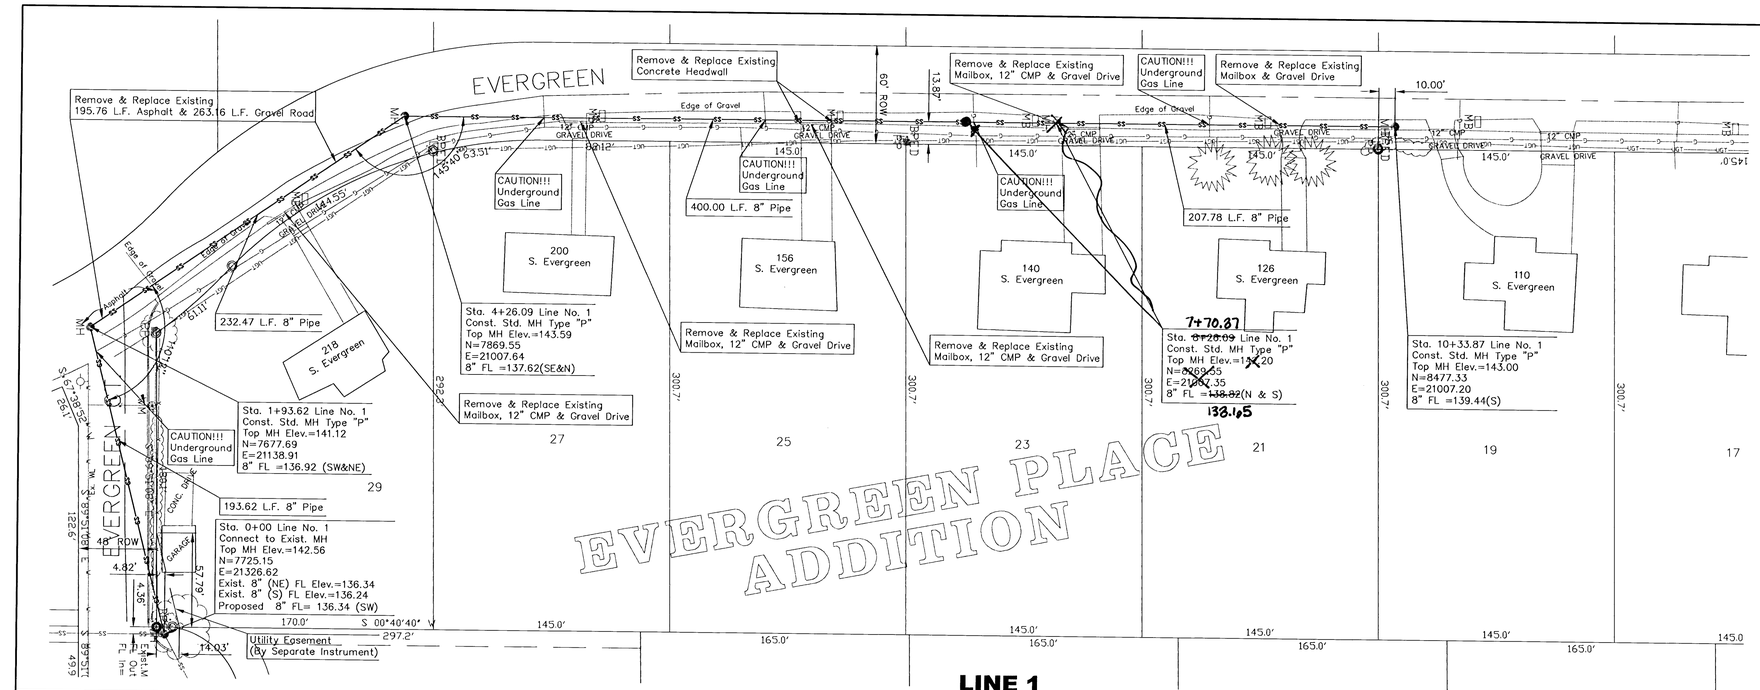

LINE 1

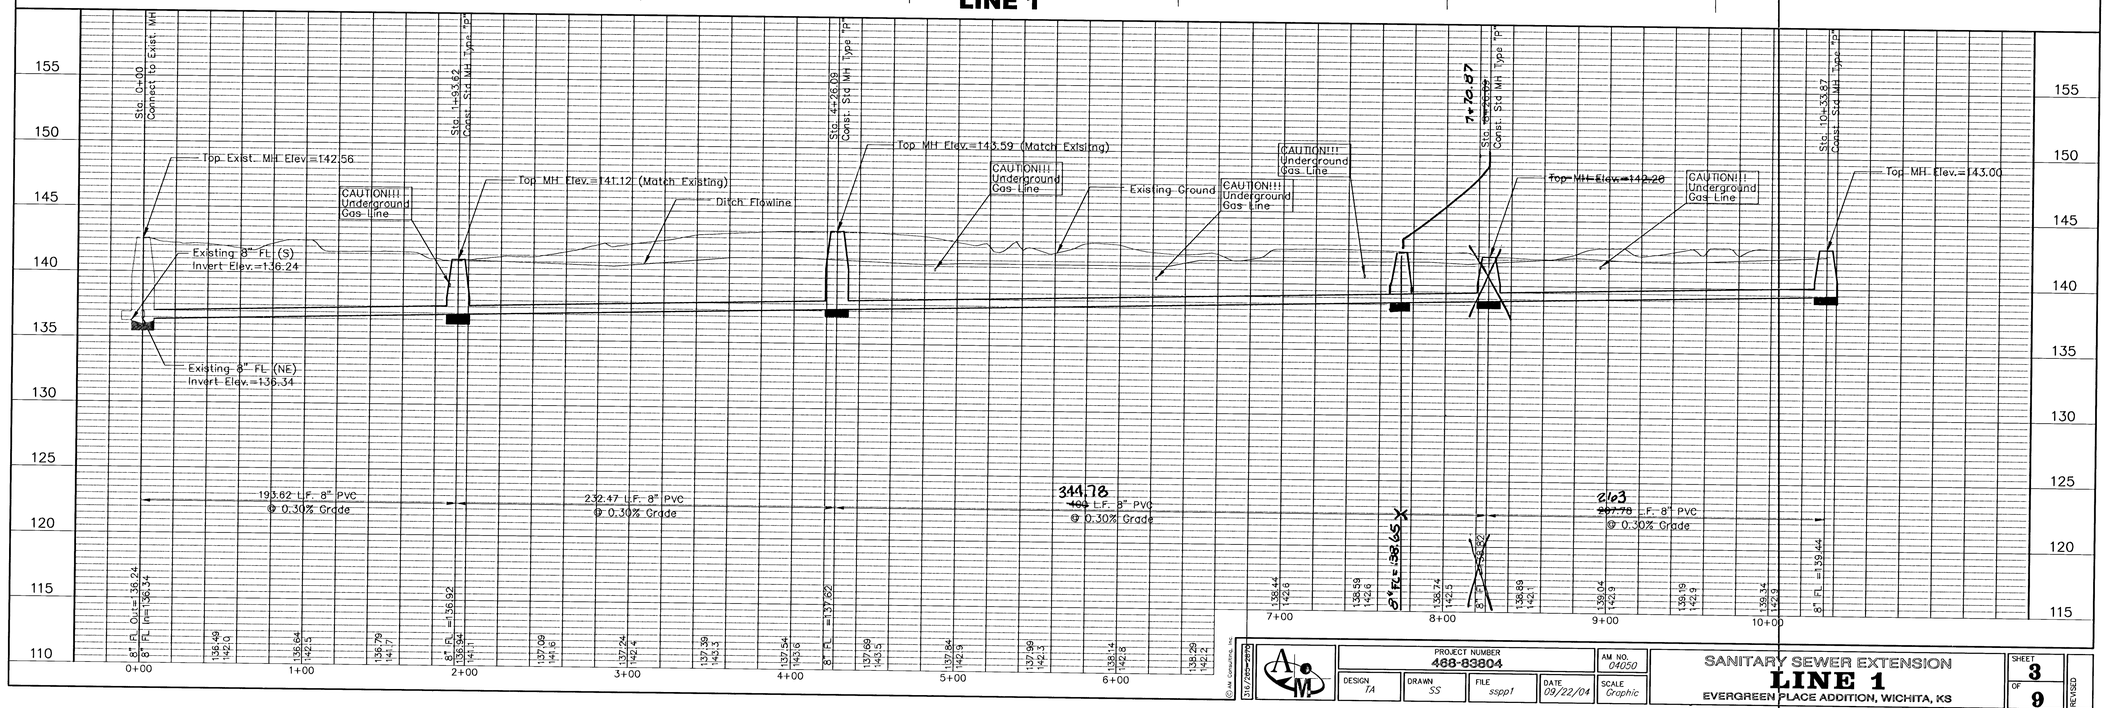

© JM Consultants, Inc.

PROJECT NUMBER 468-83804				AM NO. 04050	SANITARY SEWER EXTENSION LINE 1 EVERGREEN PLACE ADDITION, WICHITA, KS	SHEET 3 OF 9
DESIGN TA	DRAWN SS	FILE sspp1	DATE 09/22/04	SCALE Graphic		REVISED