


FINAL	SURVEY	DATE
NO.	NO.	NO.
NO.	NO.	NO.
NO.	NO.	NO.
NO.	NO.	NO.
NO.	NO.	NO.

ORIGINAL	SURVEY	DATE
NO.	NO.	NO.
NO.	NO.	NO.
NO.	NO.	NO.
NO.	NO.	NO.
NO.	NO.	NO.

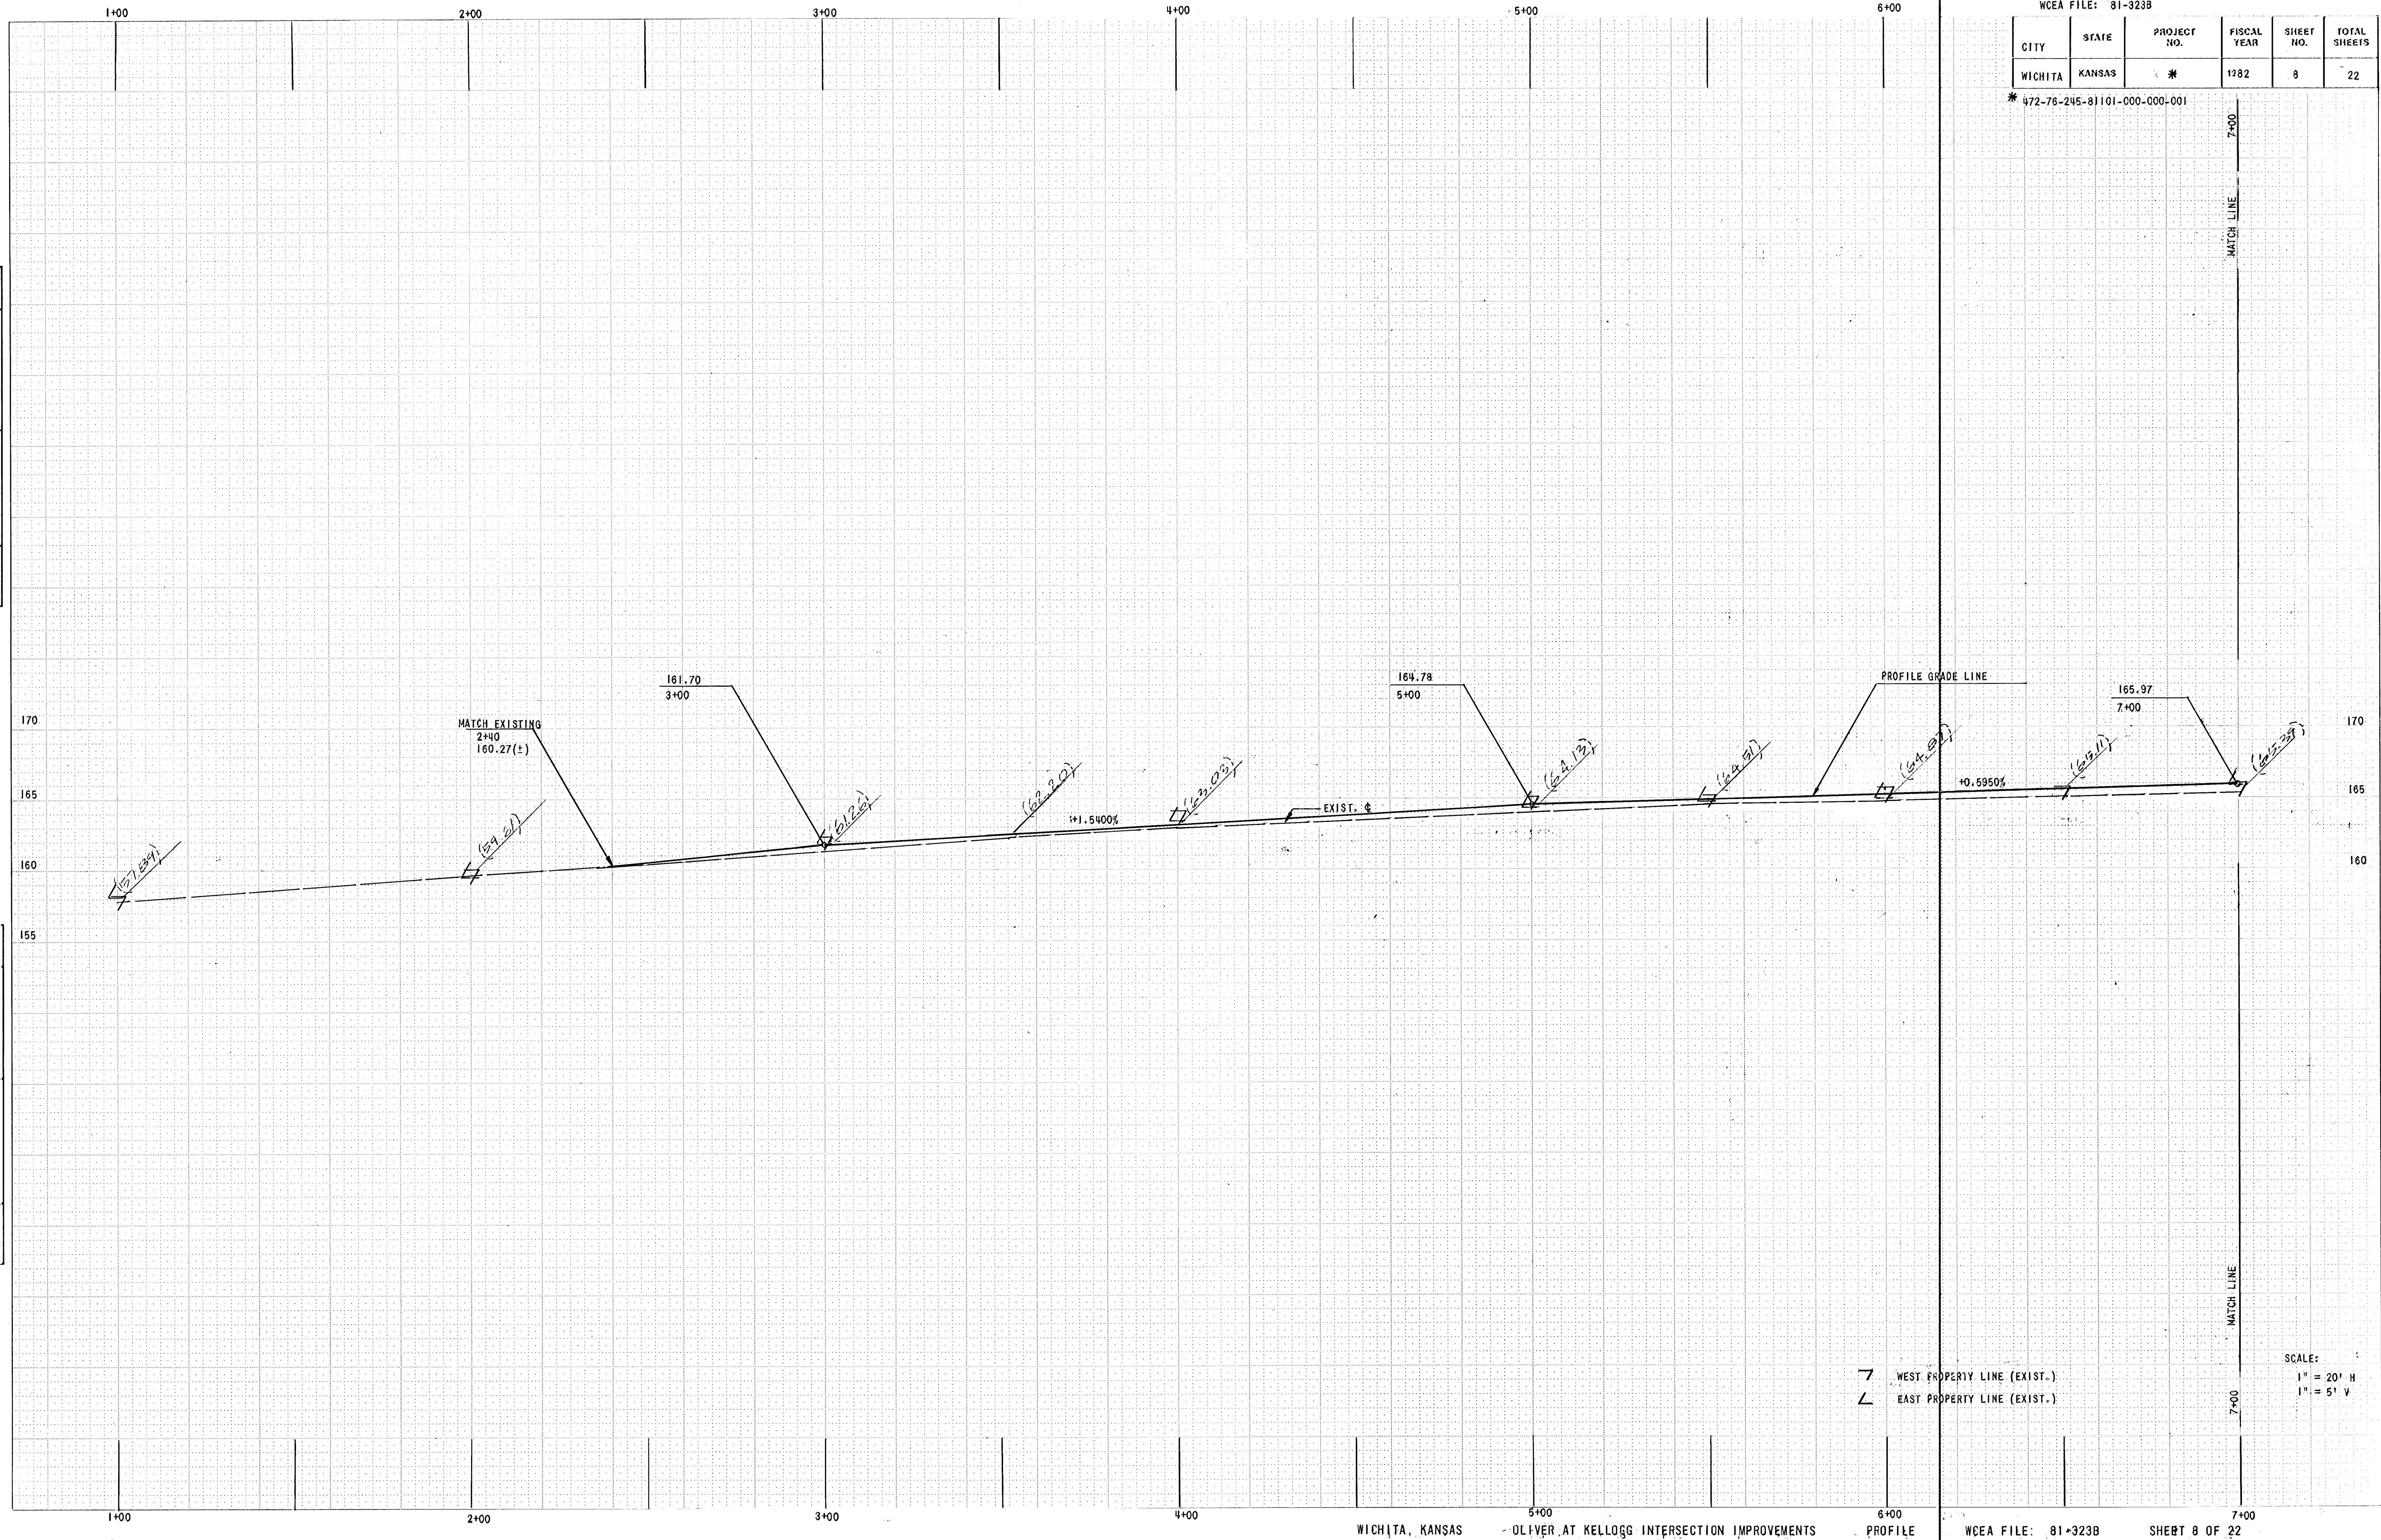

WCEA FILE: 81-323B

CITY	STATE	PROJECT NO.	FISCAL YEAR	SHEET NO.	TOTAL SHEETS
WICHITA	KANSAS	*	1982	8	22

* 472-76-245-81101-000-000-001

SCALE:
1" = 20' H
1" = 5' V