


CITY	STATE	PROJECT NO.	FISCAL YEAR	SHEET NO.	TOTAL SHEETS
WICHITA	KANSAS	*	1982	10	22

* 472-76-245-81101-000-001

FINAL	BY	DATE
SURVEYED		
TEMPLATE		
NOTE BOOK		
AREAS		
NO.		

ORIGINAL	BY	DATE
SURVEYED		
TEMPLATE		
NOTE BOOK		
AREAS		
NO.		

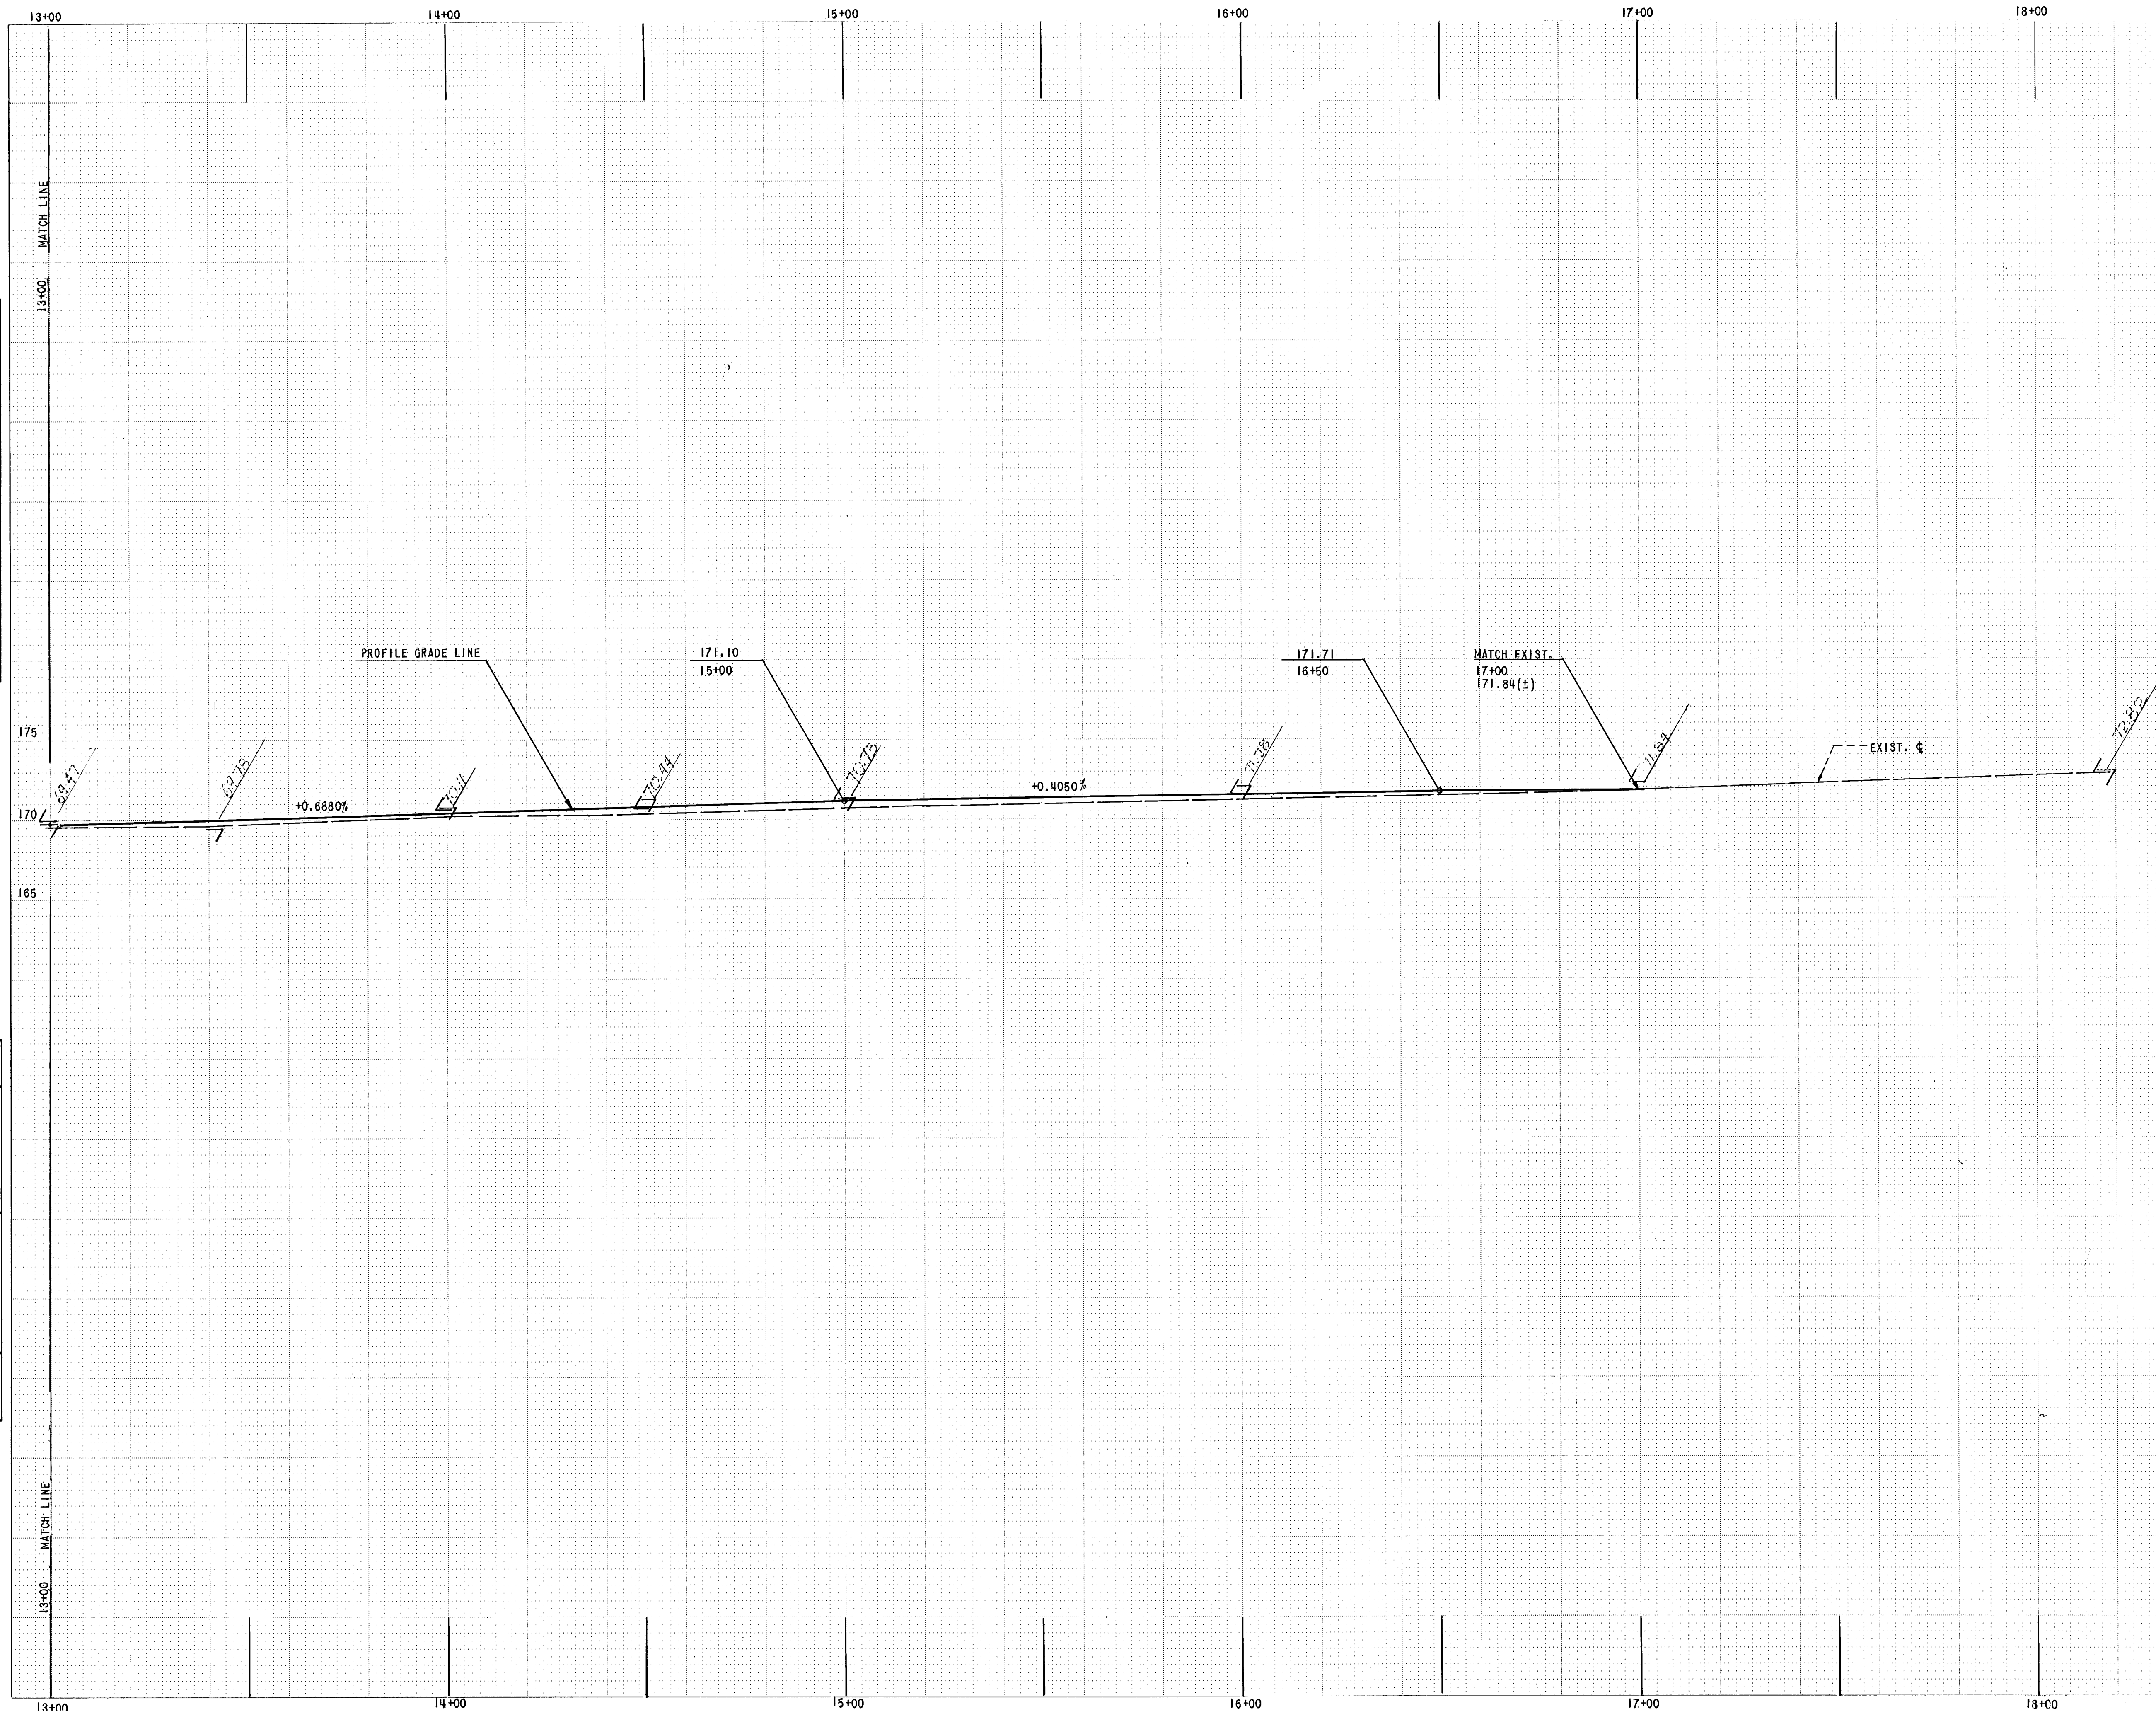

SCALE:
 1" = 20' H
 1" = 5' V