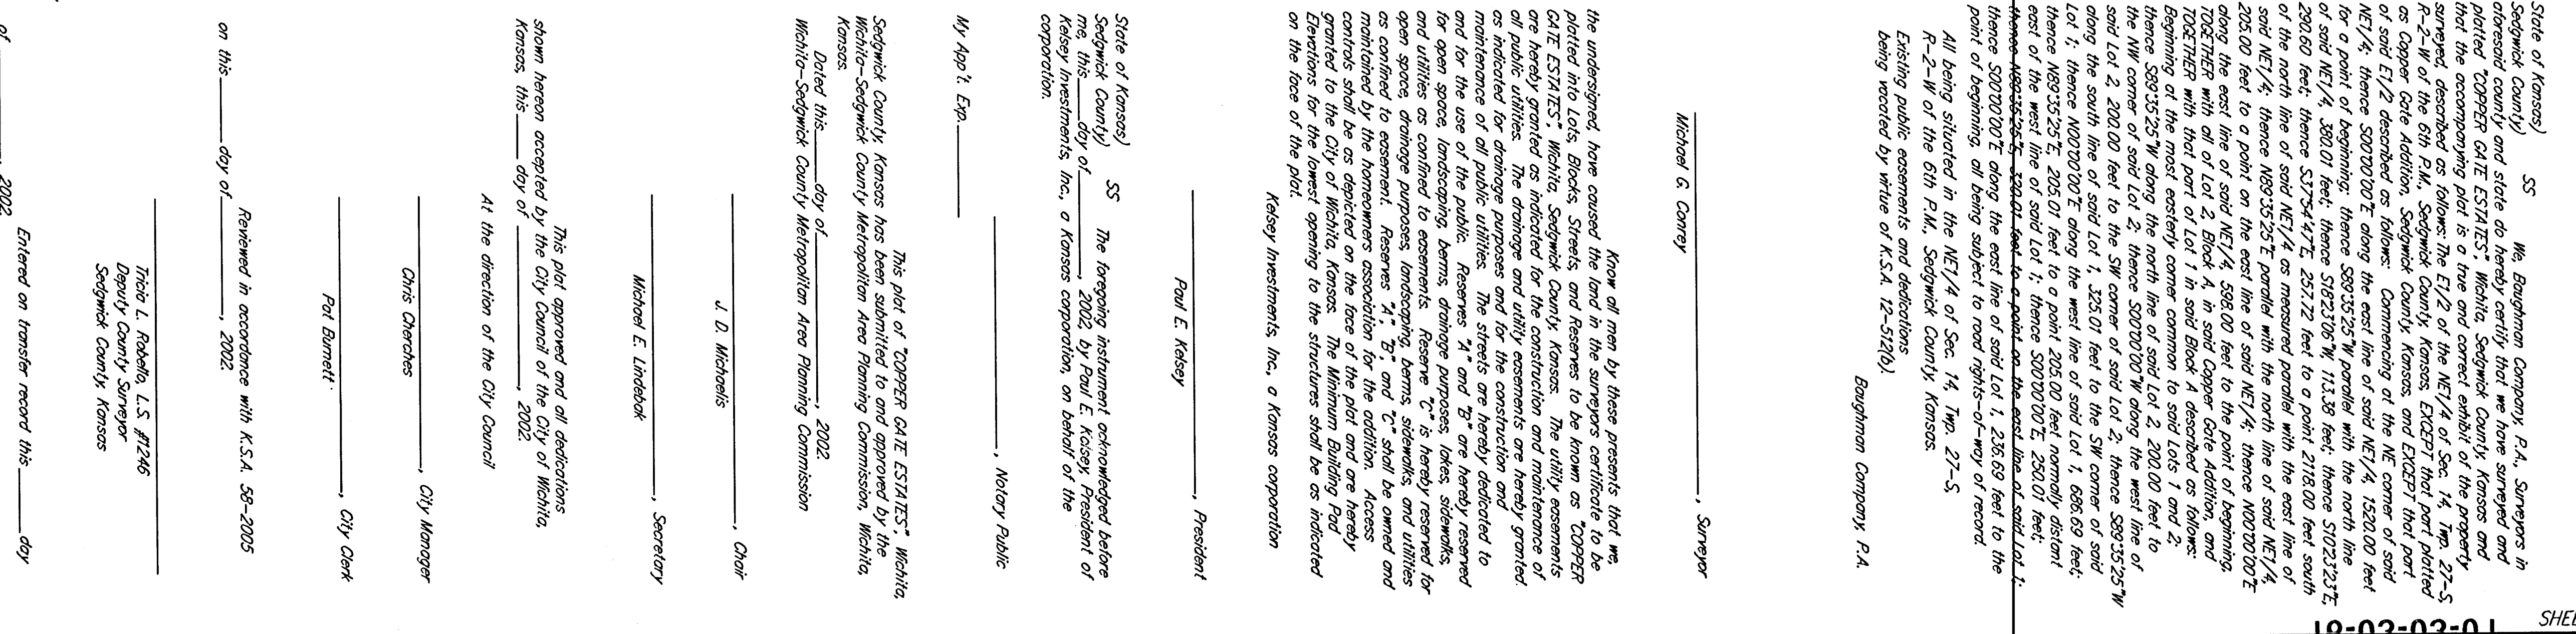


ET 30 OF 30

[illegible]

3