





Emerald Bay Estates

RESERVE C

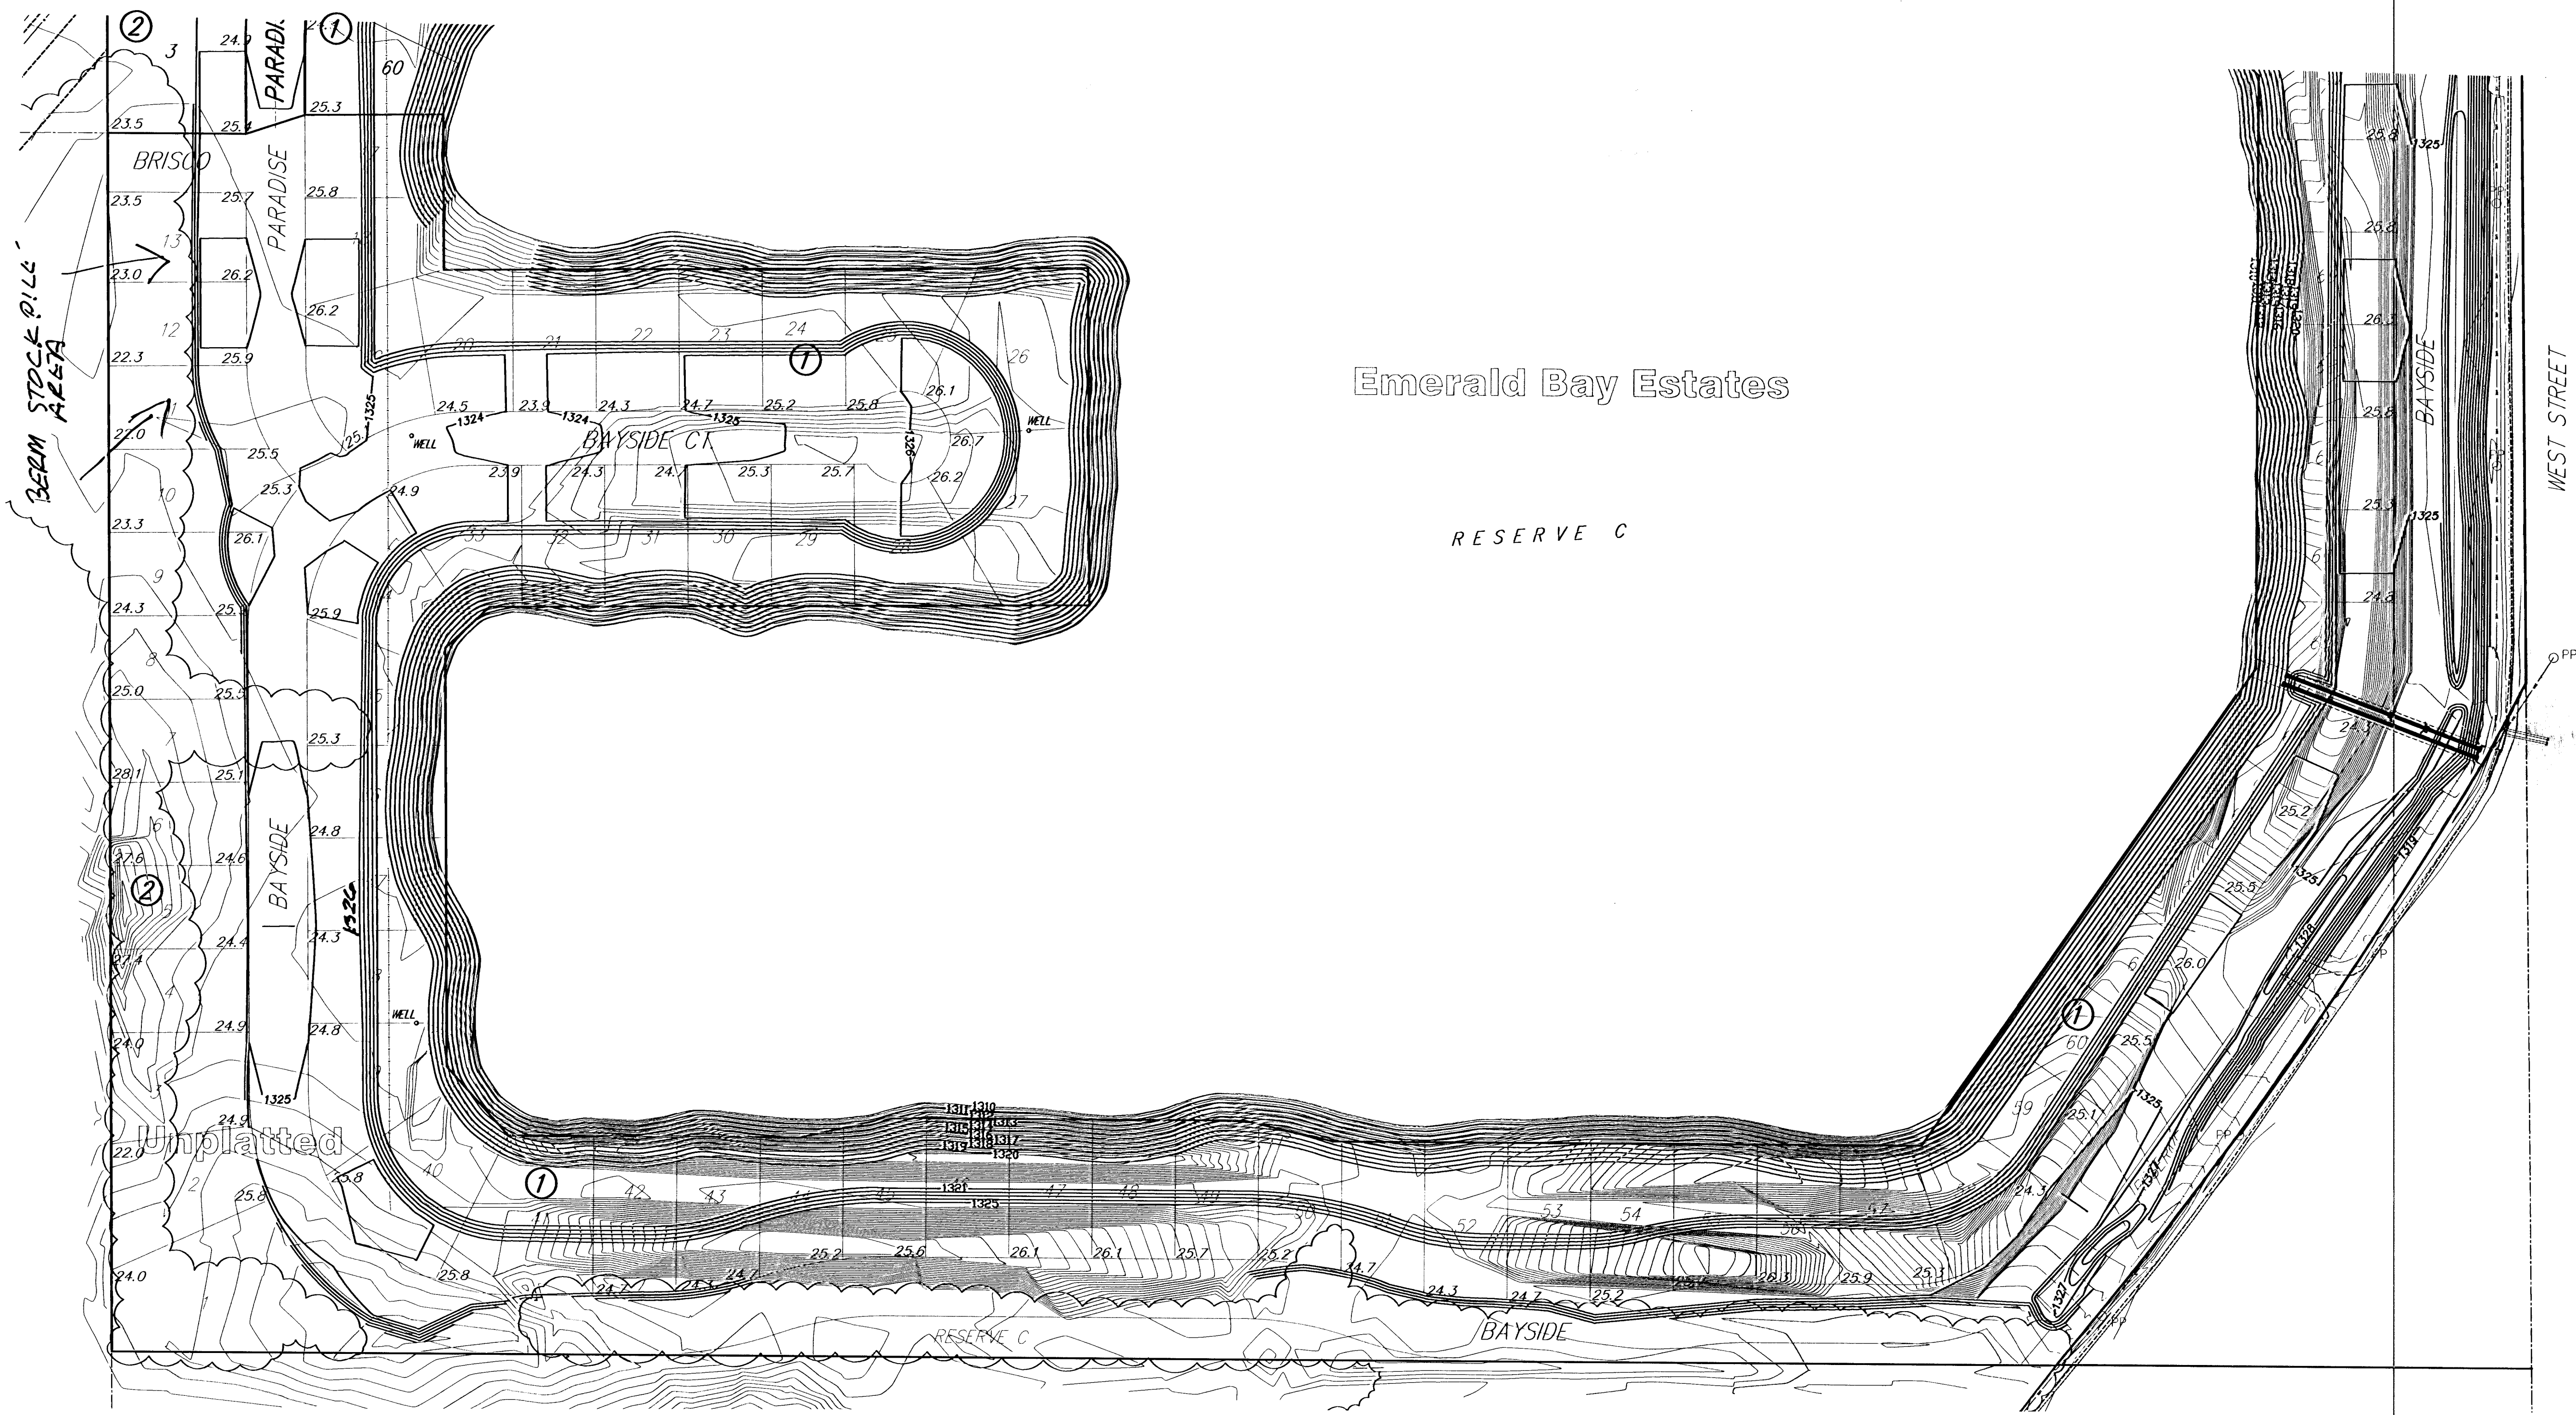

SCALE: 1" = 100'

Emerald Bay Estates
Lot Grading Plan
WICHITA, KANSAS

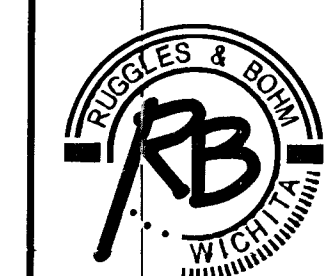

Ruggles & Bohm, P.A.
Engineering, Surveying, Land Planning
924 North Main
Wichita, Kansas 67203
www.rbkansas.com
(318) 264-8008
(318) 264-4621 fax
E-mail: info@rbkansas.com

DRAWING FILE
Grading [Four...02]

PROJECT NUMBER
468-84140

DESIGN	AML
DRAWN	AML
REVIEW	
UTILITY	
DATE	Jan. 18, 2005
SHEET	8
OF	16