
Benchmarks:

"□" Cut on Top of Curb at West Line of Lot 7, Block A, Auburn Hills 5th Addition.
Elevation = 207.73 (City Datum)

Disc in Back of Curb, North of Front Corner Common to Lots 23 and 24, Block D, Auburn Hills 12th Addition.
Elevation = 191.84 (City Datum)

"□" Cut on Center of Catch Basin North of Lot Corner Common to Lots 1 and 15, Block B, Auburn Hills 14th Addition.
Elevation = 193.65 (City Datum)

The contractor shall be required to backfill trench with sand from Sta. 0+00 to Sta. 5+20.5, Line 1 and from Sta. 0+00 to Sta. 0+59.4, Line 1A excluding locations where flowable fill is called out. Sand Backfill shall be bid per L.F. as "Sand Backfill Jetted and Vibrated".

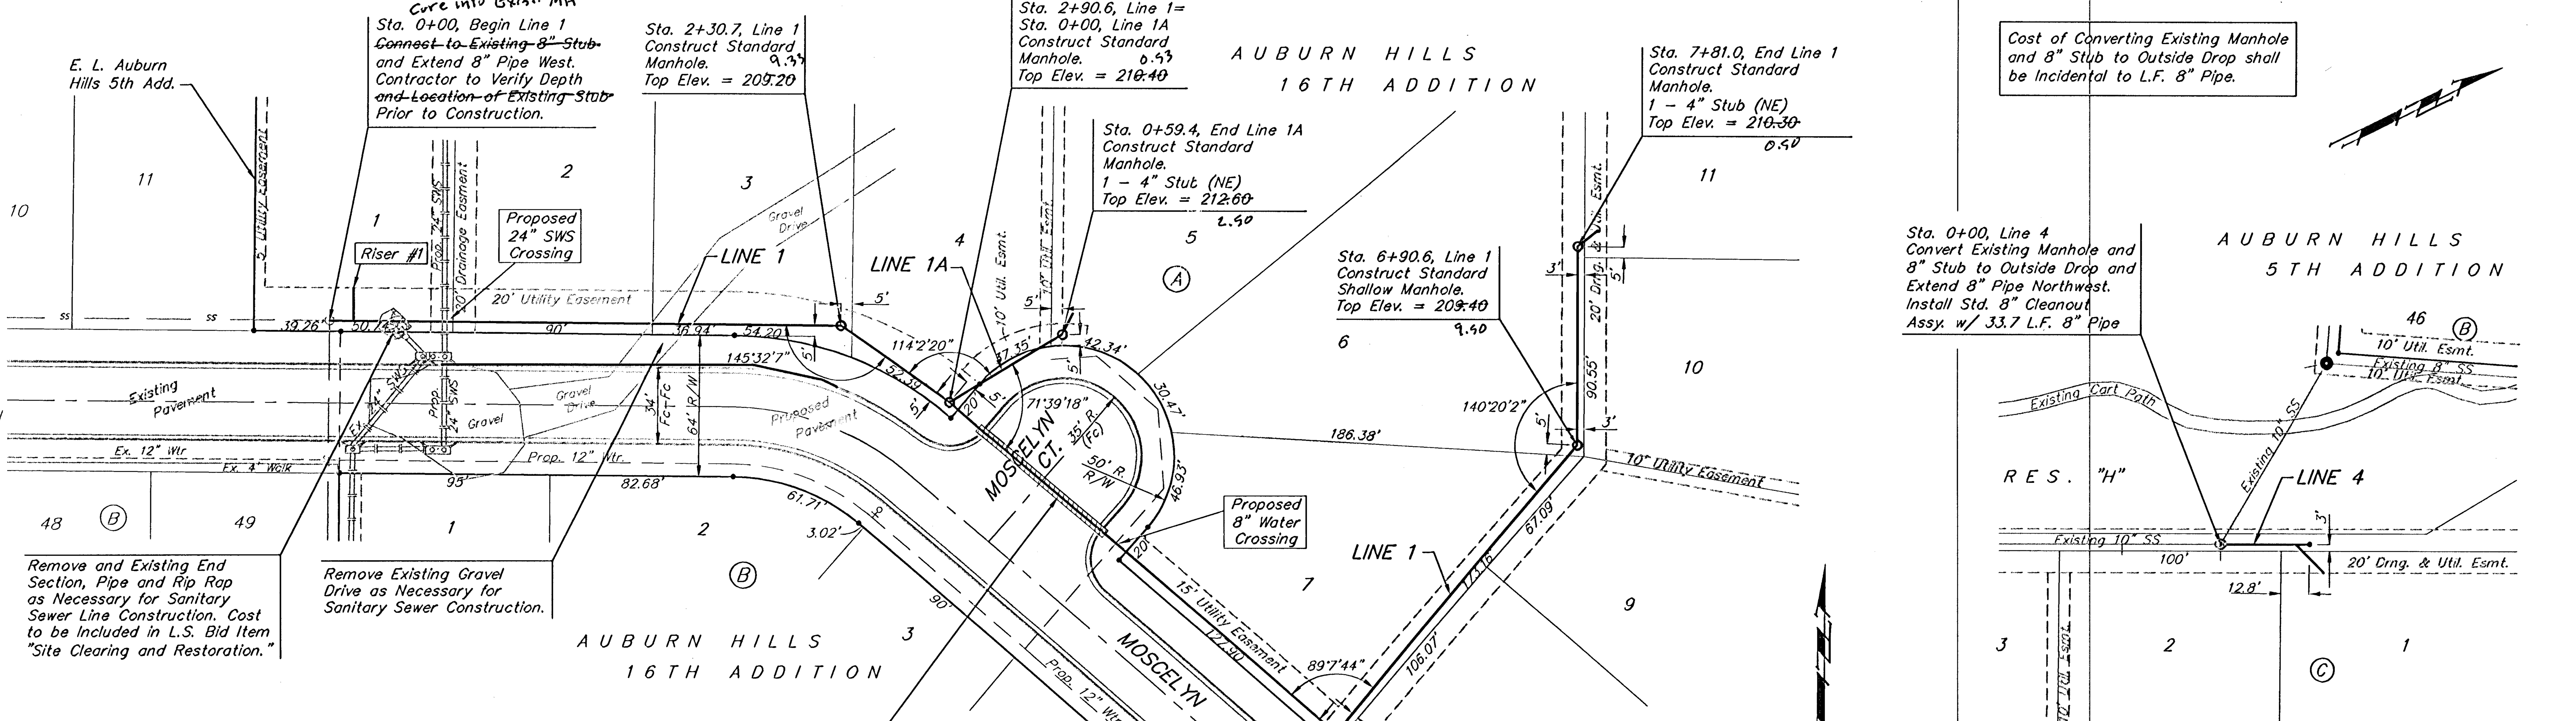

Sta. 3+08.1 to Sta. 3+83.1
Install 75.0 L.F. Flowable Fill
Per City Specifications.

Sta. 5+20.5, Line 1
Construct Standard Shallow Manhole.
Top Elev. = 207.60 7.66


Scale:
1" = 40' Horizontal
1" = 5' Vertical
• = Iron

AUBURN HILLS 16TH ADDITION

SEWER SERVICE TABLE

NUMBER	TYPE	LOCATION			STATION\	FOR INFORMATION ONLY	
		LOT	BLOCK	LINE		APPROXIMATE LENGTH 4" PIPE	
		NO.	NO.	NO.	DIRECTION	VERTICAL	HORIZONTAL
1	8" x 4" Tee Saddle	1	A	1	0+11/Lt.	10'	15'

NOTE: Vertical Riser Pipe shall be extended to 2' minimum above ground water elevation and 4' maximum below proposed ground elevation.

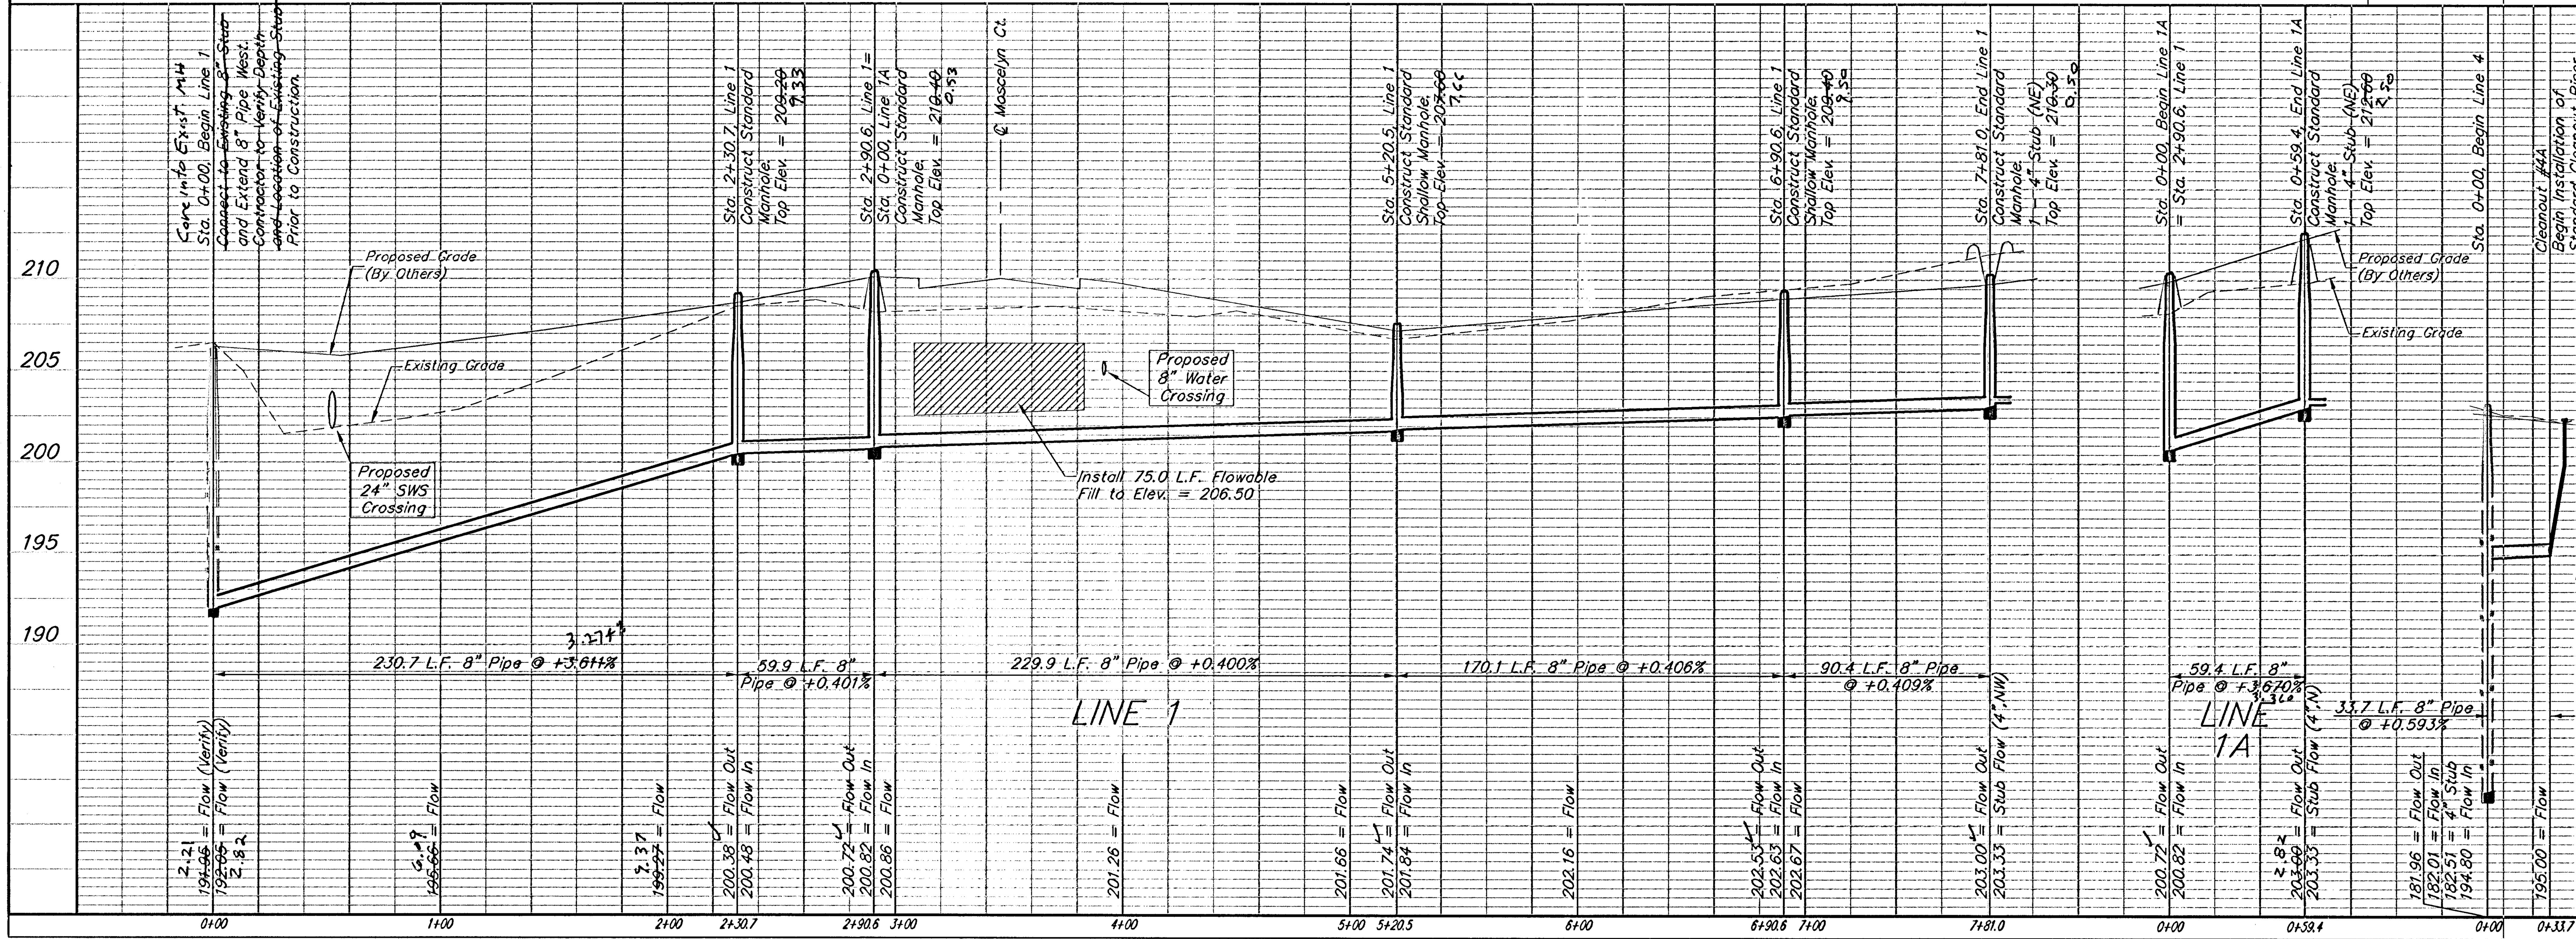

AUBURN HILLS 16TH ADD. - PH. 1

LINES 1, 1A & 4

SANITARY SEWER IMPROVEMENTS

Baughman

Baughman Company, P.A. 315 Ellis St. Wichita, KS 67211 P 316-262-7271 F 316-262-0149
ENGINEERING | SURVEYING | PLANNING | LANDSCAPE ARCHITECTURE

PROJECT NUMBER 468-84089	DESIGN DMV / DRAWN DMV
REVISIONS:	APPROVED / DATE 11/05
	SCALE NOTED
	SHEET 2 OF 17

E:\eng\auburn16\ss1.dwg