


Benchmarks:

"C" Cut on Top of Curb at West Line of Lot 7, Block A, Auburn Hills 5th Addition.
Elevation = 207.73 (City Datum)


Disc in Back of Curb, North of Front Corner Common to Lots 23 and 24, Block D, Auburn Hills 12th Addition.
Elevation = 191.84 (City Datum)

"C" Cut on Center of Catch Basin North of Lot Corner Common to Lots 1 and 15, Block B, Auburn Hills 14th Addition.
Elevation = 193.65 (City Datum)

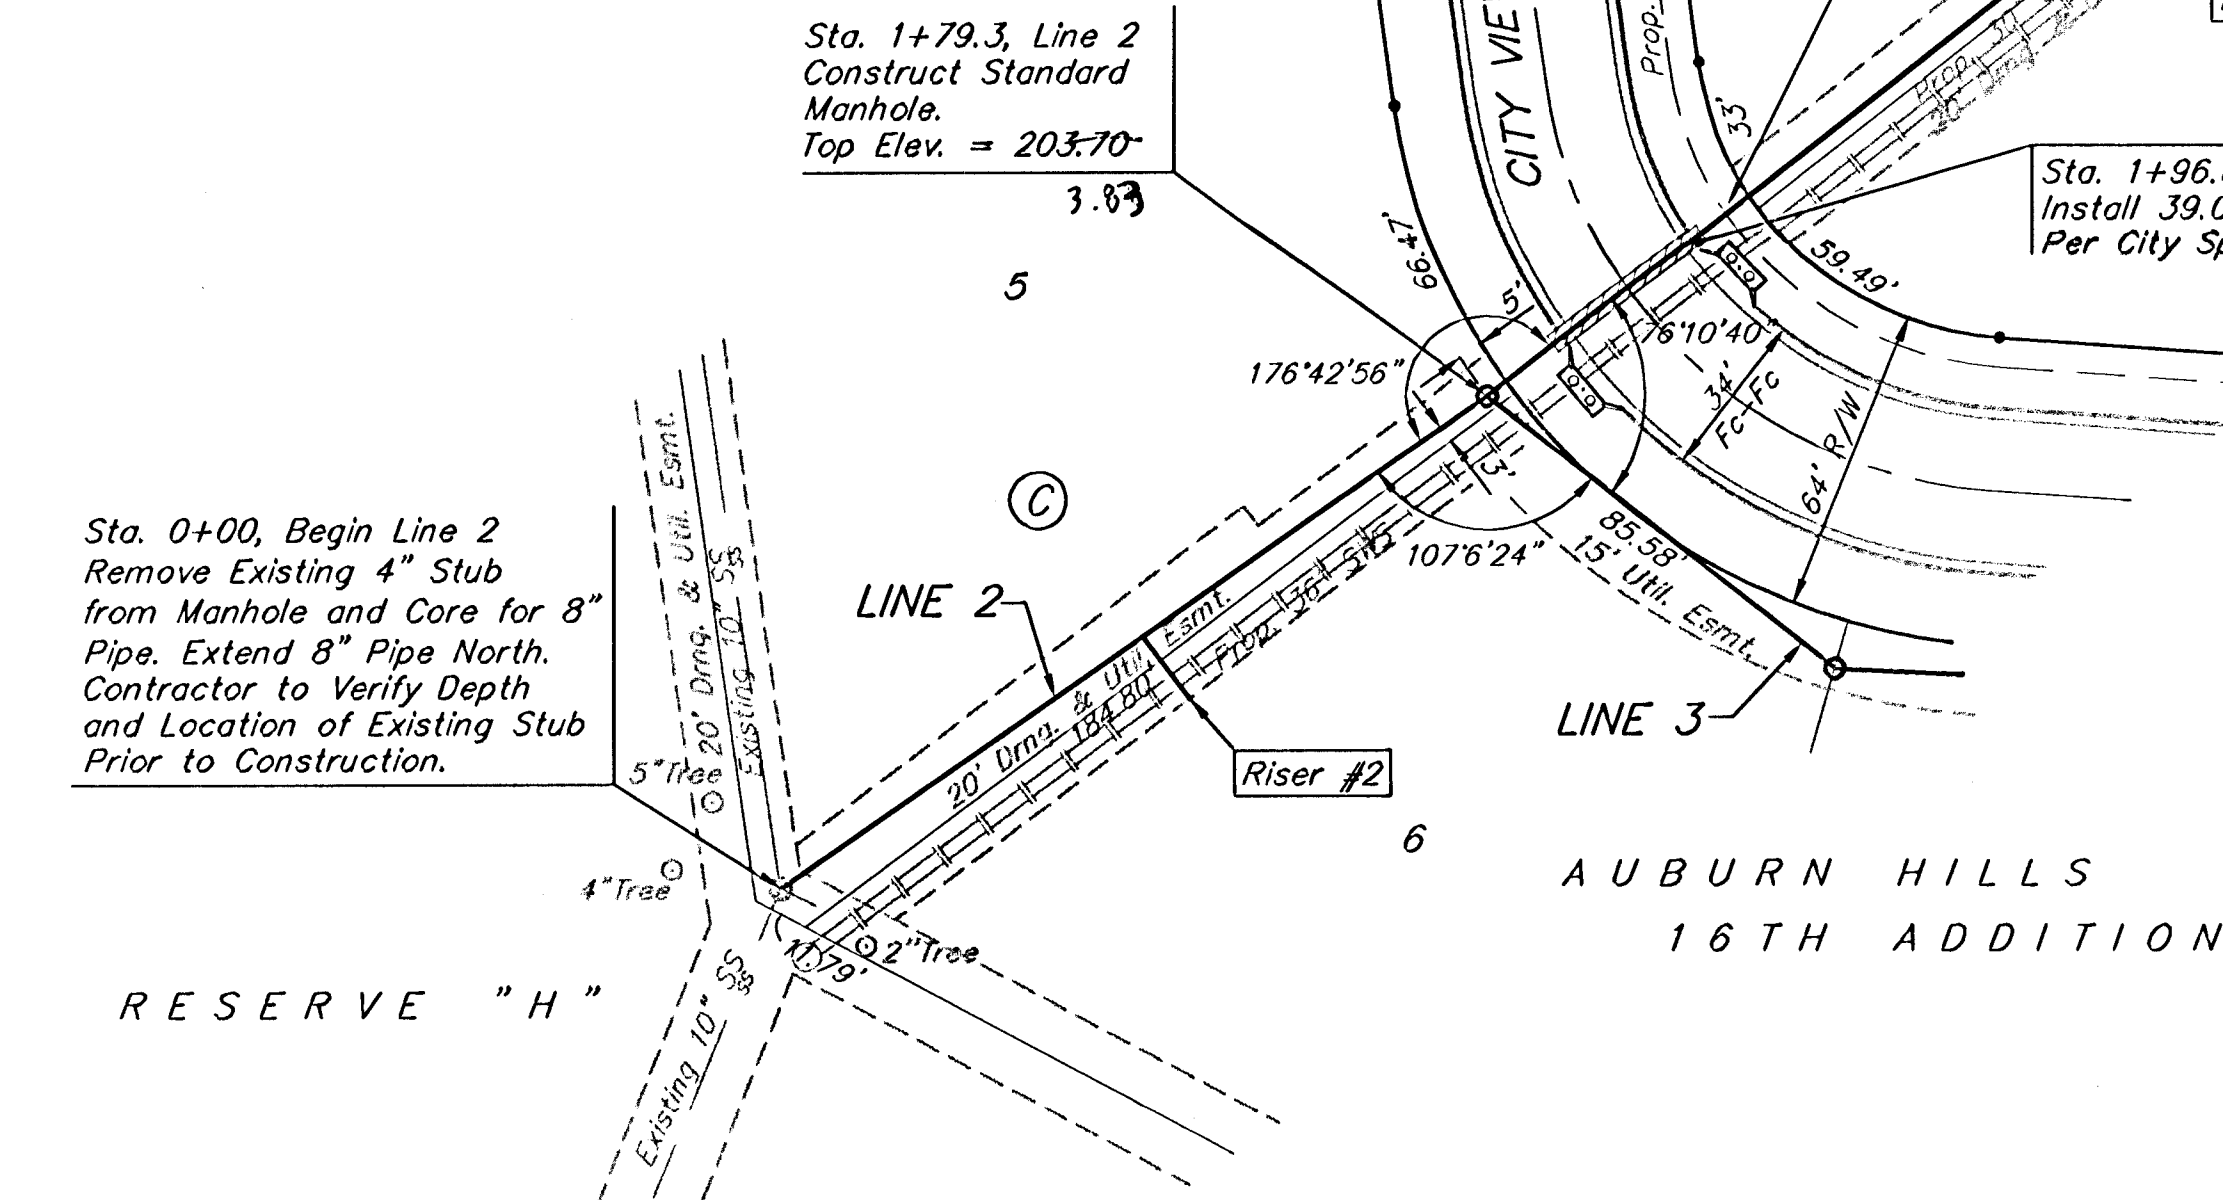

SEWER SERVICE TABLE									
NUMBER	TYPE	LOCATION			STATION\ DIRECTION	FOR INFORMATION ONLY			
		LOT NO.	BLOCK NO.	LINE NO.		APPROXIMATE LENGTH 4" PIPE	VERTICAL	HORIZONTAL	
2	8" x 4" Tee Saddle	6	C	2	0+92/Rt.	13.5'	16'		
3	8" x 4" Tee Saddle	15	D	2	3+42/Lt.	10'	6.5'		
4	8" x 4" Tee Saddle	14	D	2	3+67/Rt.	9.5'	13.5'		
5	8" x 4" Tee Saddle	13	D	2	4+94/Rt.	10'	7'		
6	8" x 4" Tee Saddle	12	D	2	5+07/Lt.	10.5'	13'		
7	8" x 4" Tee Saddle	6	D	2	6+55/Rt.	10.5'	13'		
8	8" x 4" Tee Saddle	7	D	2	7+38/Lt.	7'	7'		
9	8" x 4" Tee Saddle	5	D	2	7+92/Rt.	6'	13'		

NOTE: Vertical Riser Pipe shall be extended to 2' minimum above ground water elevation and 4' maximum below proposed ground elevation.

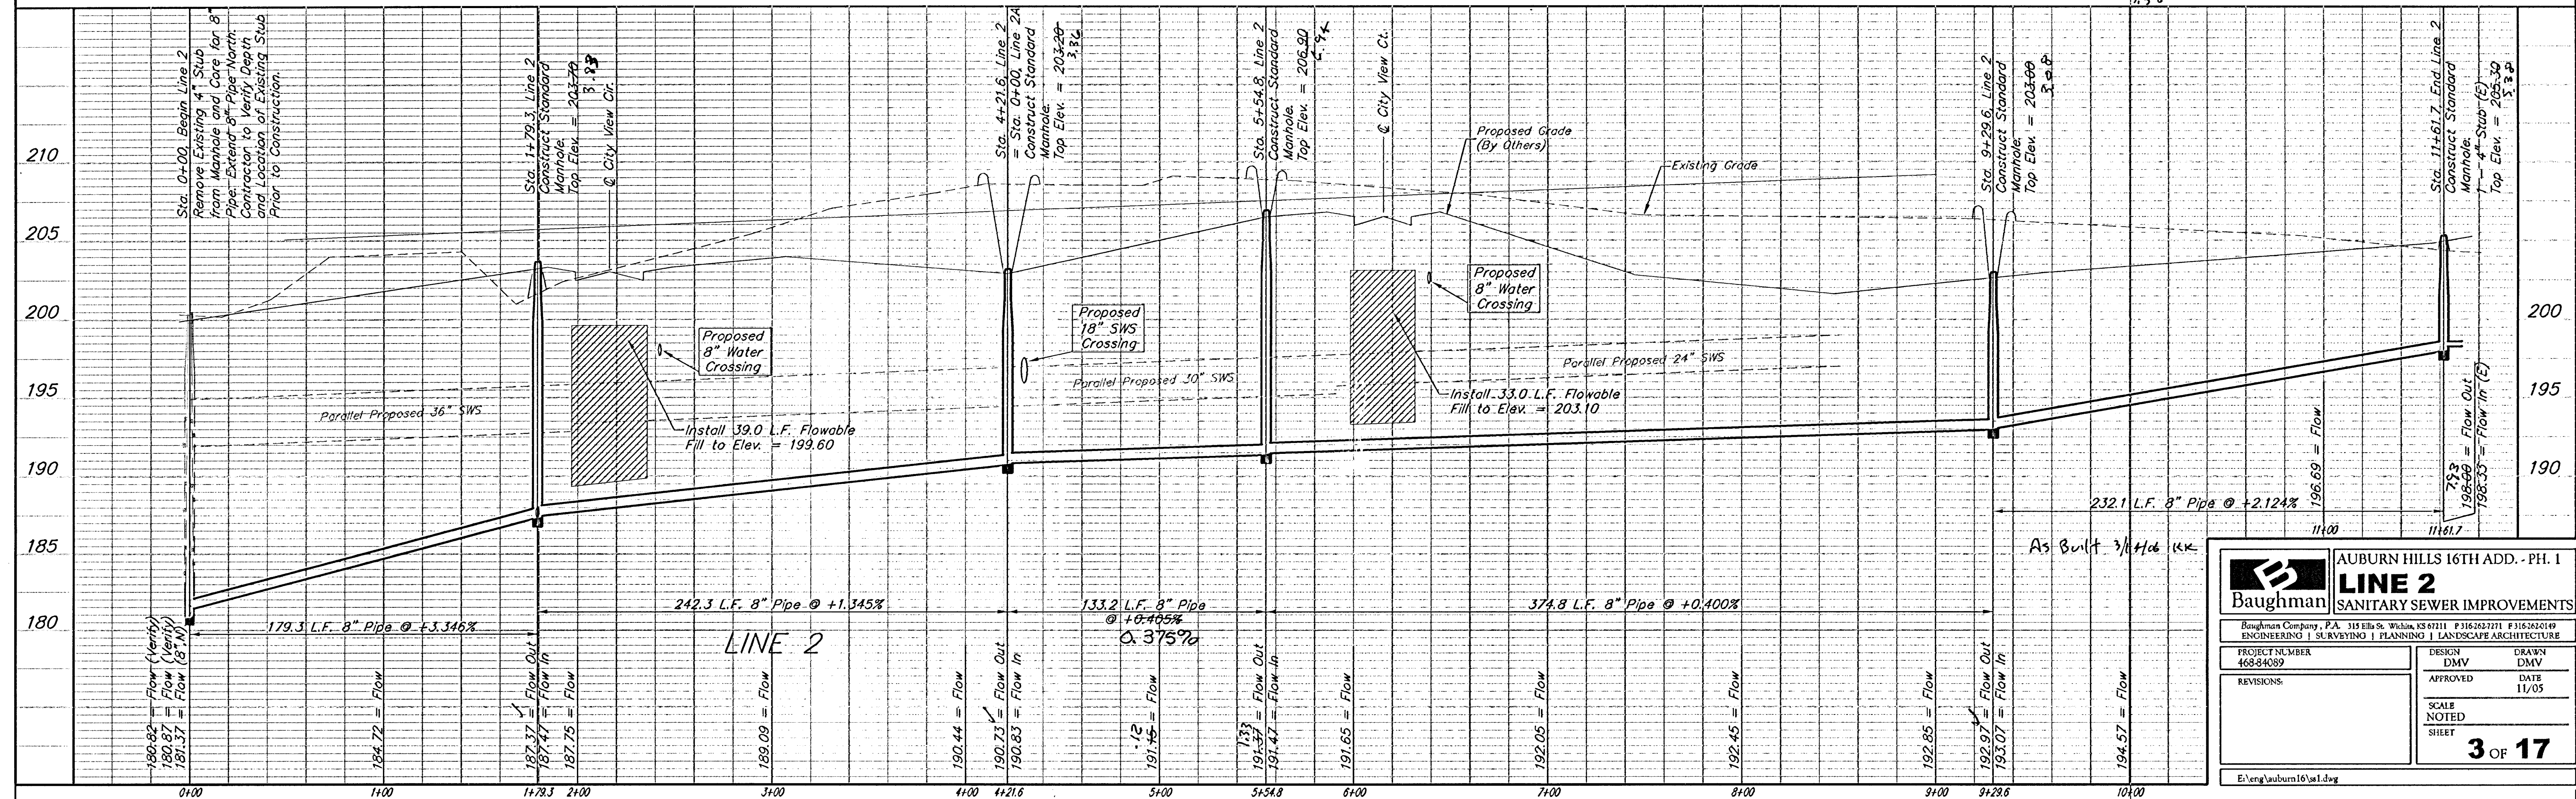

B
Baughman

ENGINEERING | SURVEYING | PLANNING | LANDSCAPE ARCHITECTURE

PROJECT NUMBER
468-84089

DESIGN
DMV

APPROVED
DATE
11/05

REVISIONS

SCALE
NOTED
SHEET

3 OF 17

AUBURN HILLS 16TH ADD. - PH. 1

LINE 2
SANITARY SEWER IMPROVEMENTS

E:\eng\auburn16\sa1.dwg