


Benchmarks:

"C" Cut on Top of Curb at West Line of Lot 7, Block A, Auburn Hills 5th Addition.
Elevation = 207.73 (City Datum)

Disc in Back of Curb, North of Front Corner Common to Lots 23 and 24, Block D, Auburn Hills 12th Addition.
Elevation = 191.84 (City Datum)


"C" Cut on Center of Catch Basin North of Lot Corner Common to Lots 1 and 15, Block B, Auburn Hills 14th Addition.
Elevation = 193.65 (City Datum)

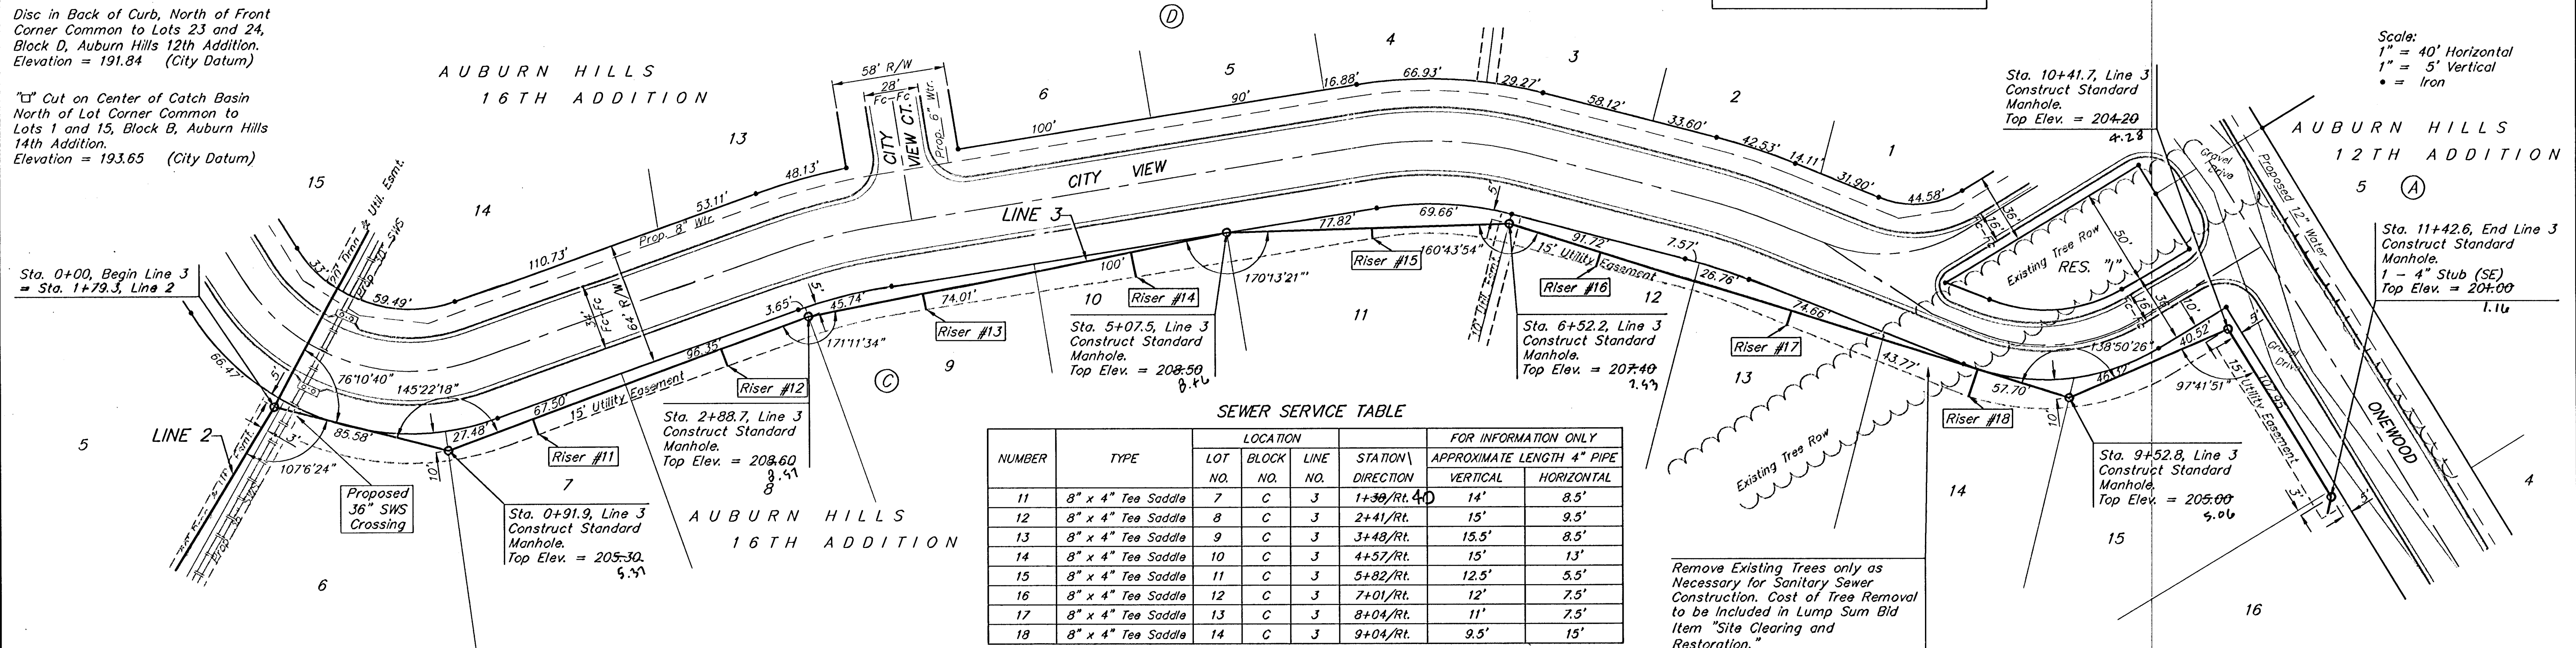

SEWER SERVICE TABLE

NUMBER	TYPE	LOCATION			FOR INFORMATION ONLY	
		LOT NO.	BLOCK NO.	LINE NO.	STATION\ DIRECTION	APPROXIMATE LENGTH 4" PIPE VERTICAL HORIZONTAL
11	8" x 4" Tee Saddle	7	C	3	1+39/Rt. 40'	14' 8.5'
12	8" x 4" Tee Saddle	8	C	3	2+41/Rt. 15'	9.5'
13	8" x 4" Tee Saddle	9	C	3	3+48/Rt. 15.5'	8.5'
14	8" x 4" Tee Saddle	10	C	3	4+57/Rt. 15'	13'
15	8" x 4" Tee Saddle	11	C	3	5+82/Rt. 12.5'	5.5'
16	8" x 4" Tee Saddle	12	C	3	7+01/Rt. 12'	7.5'
17	8" x 4" Tee Saddle	13	C	3	8+04/Rt. 11'	7.5'
18	8" x 4" Tee Saddle	14	C	3	9+04/Rt. 9.5'	15'

NOTE: Vertical Riser Pipe shall be extended to 2' minimum above ground water elevation and 4' maximum below proposed ground elevation.

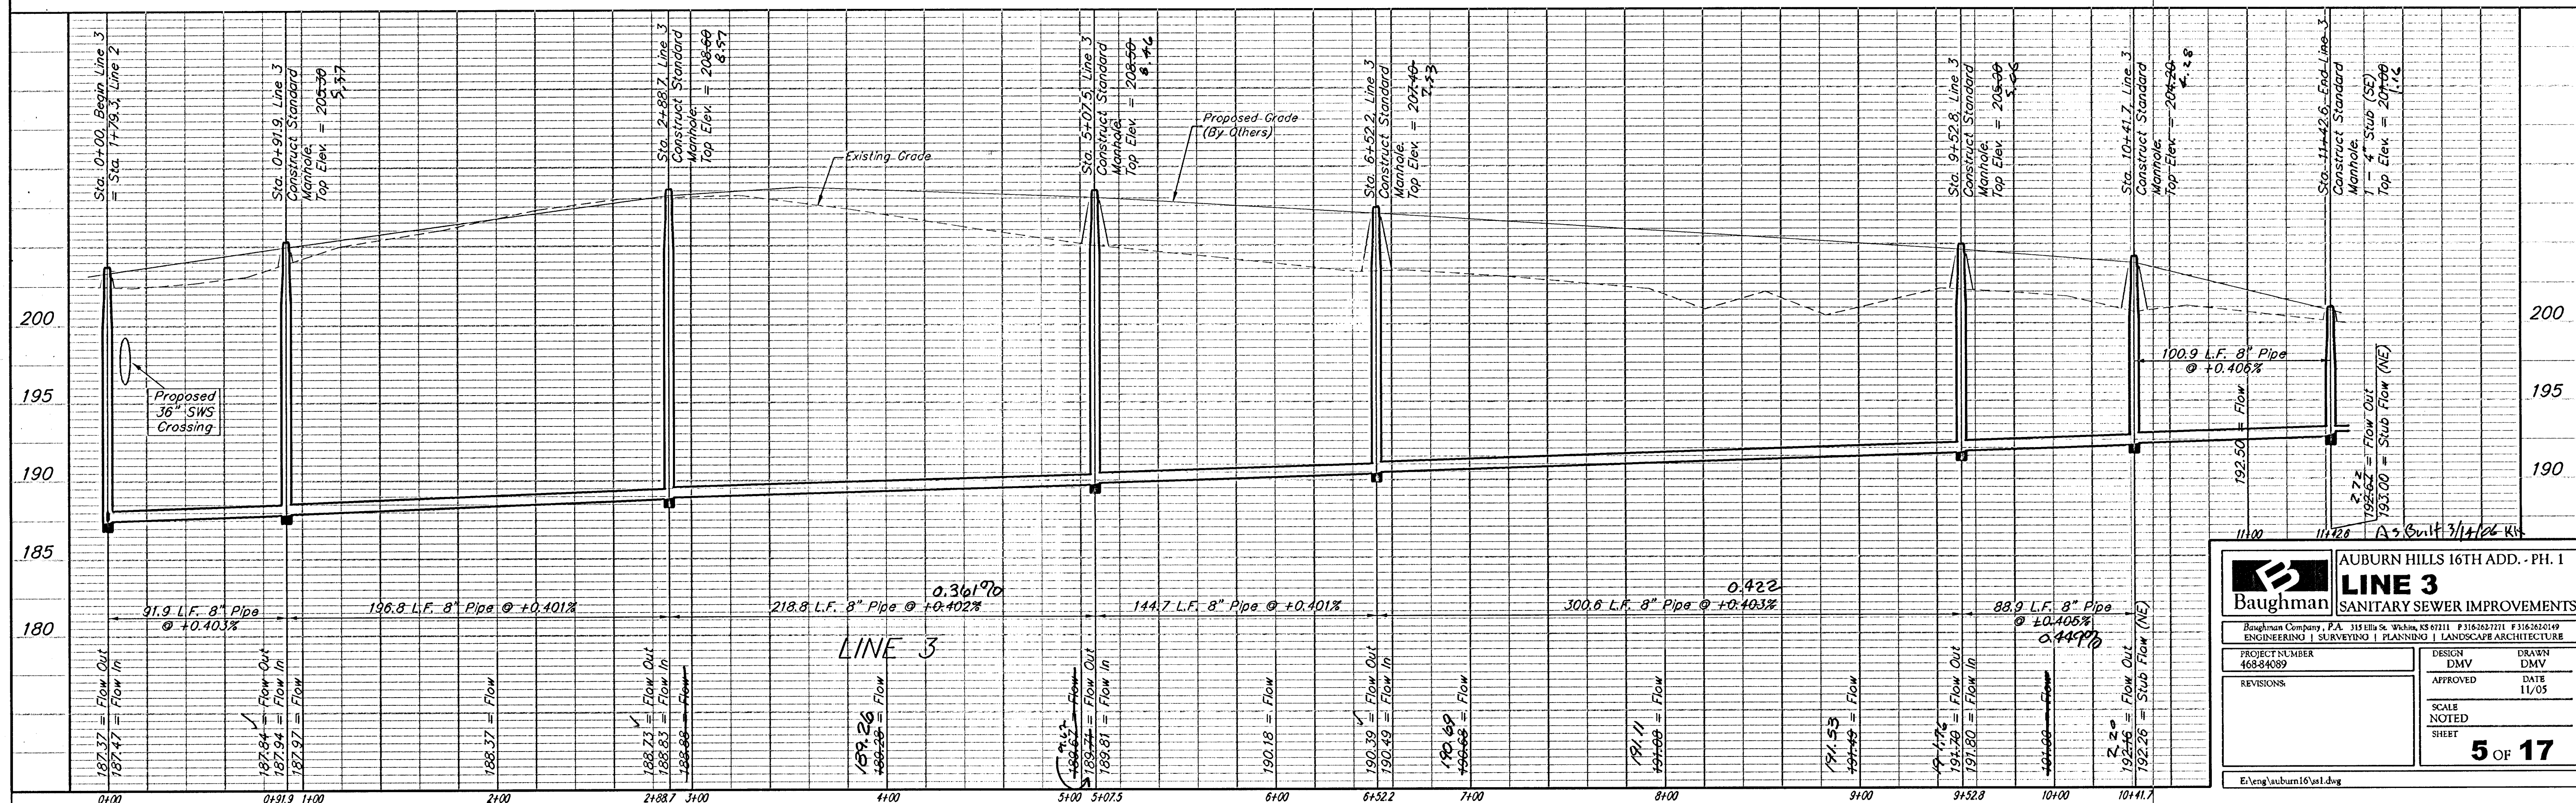

BAUGHMAN
AUBURN HILLS 16TH ADD. - PH. 1
LINE 3
SANITARY SEWER IMPROVEMENTS

PROJECT NUMBER: 468-84089
DESIGN: DMV
APPROVED: DATE: 11/05
SCALE: NOTED
SHEET: 5 OF 17

REVISIONS:

E:\eng\auburn16\1.dwg