BENCHMARK:
BM #1: "□" Cut in middle of N headwall of RCBC on 21st St. North. 1004.3' W & 22.1' N of SE Cor., SE1/4, Sec. 2, T-27-S, R-2-E.
Elev. = 173.23 City Datum


BM #2: "□" Cut at the SE corner of the intersection of Castle Rock & Castle Rock Ct., Krug North Addition.
Elev. = 183.50 City Datum


SEWER SERVICE TABLE

NUMBER	TYPE	LOCATION LOT NO.	LOCATION BLOCK NO.	LOCATION LINE NO.	STATION \ DIRECTION	FOR INFORMATION ONLY APPROXIMATE LENGTH 4" PIPE VERTICAL	FOR INFORMATION ONLY APPROXIMATE LENGTH 4" PIPE HORIZONTAL
16	8" X 4" Tee	14	E	1A	5+14/Lt.	7'	13' 4.6'
17	8" X 4" Tee	10	E	1A	8+45/Rt.	8'	7' 8.3'
18	8" X 4" Tee	17	E	1A	8+55/Lt.	8'	13' 15.2'
19	8" X 4" Tee	9	E	1A	8+70/Rt.	9'	7' 8.1'
20	8" X 4" Tee	18	E	1A	8+90/Lt.	9'	13' 14.6'
21	8" X 4" Tee	8	E	1A	9+50/Rt.	9'	7' 8.5'
22	8" X 4" Tee	19	E	1A	9+70/Lt. 72.5	9'	13' 16.1'
23	8" X 4" Tee	20	E	1A	10+16/Lt. 46.2	9'	13' 15.75'

NOTE: Vertical Riser Pipe shall be extended to 2' minimum above ground water elevation and 4' maximum below proposed ground elevation.

Scale: 1" = 40' Horizontal
1" = 5' Vertical
• = Iron

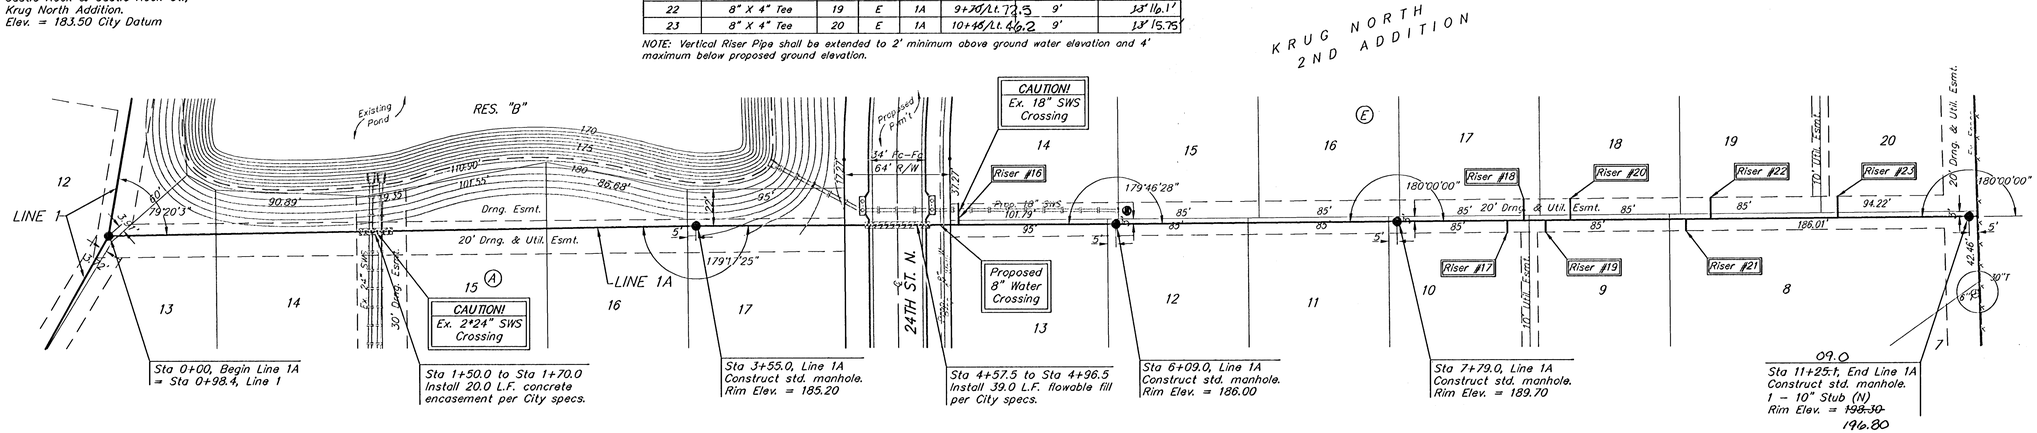

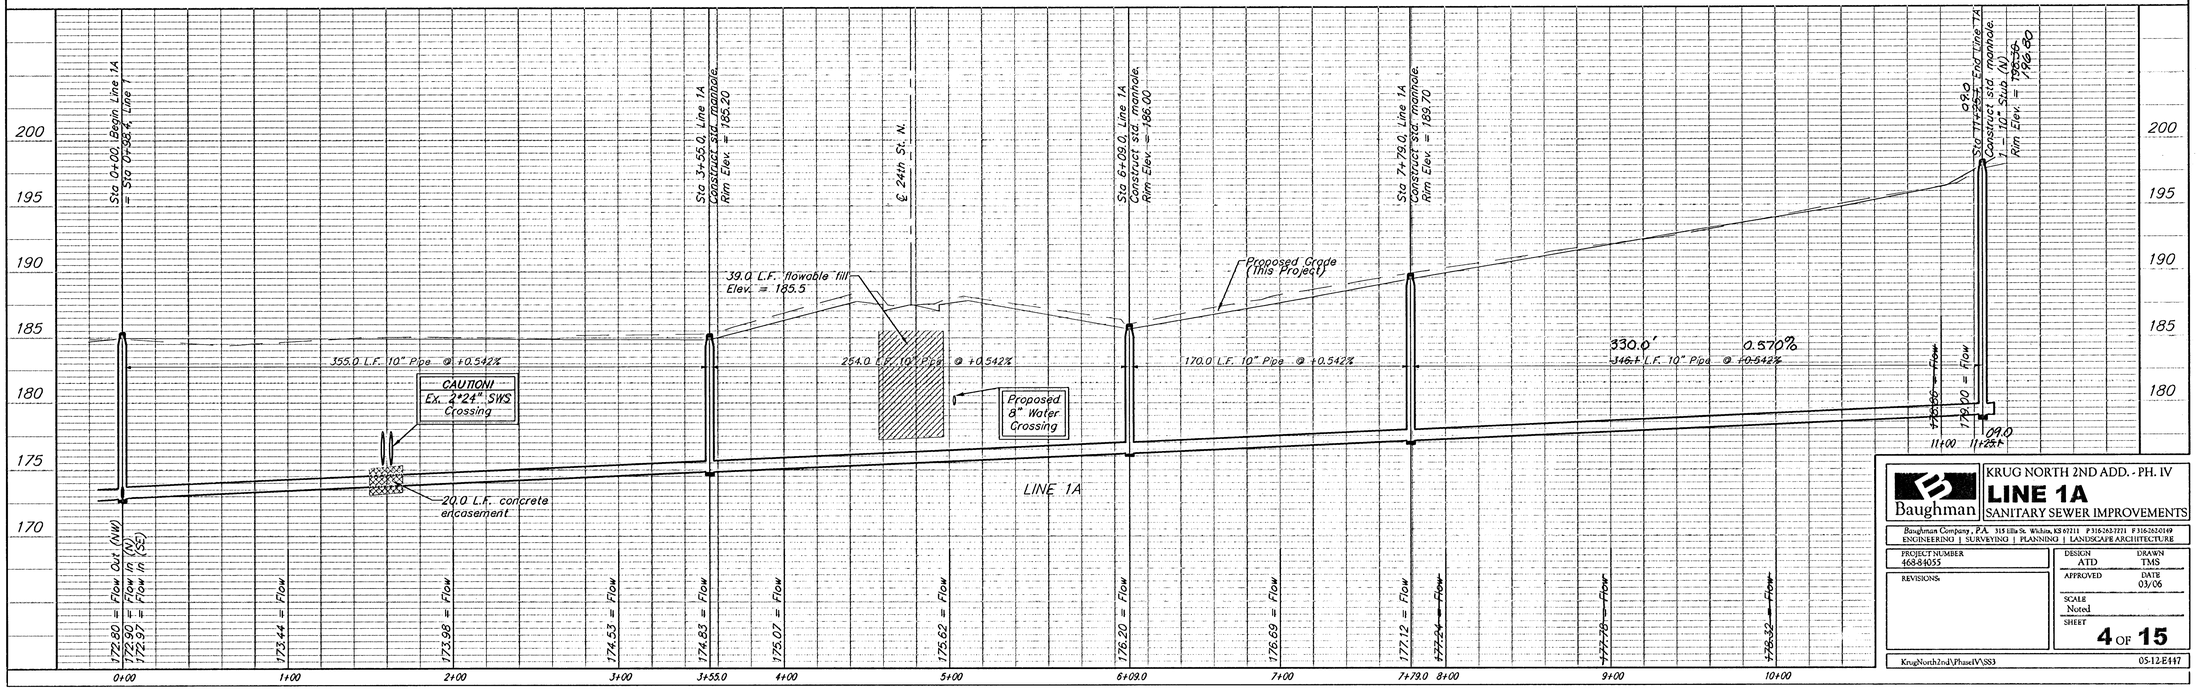

Baughman

KRUG NORTH 2ND ADD. - PH. IV
LINE 1A
SANITARY SEWER IMPROVEMENTS

Baughman Company, P.A. 315 Ellis St. Wichita, KS 67211 P 316.263.7221 F 316.263.0149
ENGINEERING | SURVEYING | PLANNING | LANDSCAPE ARCHITECTURE

PROJECT NUMBER 468-84055
REVISIONS:
DESIGN ATD
DRAWN TMS
APPROVED
DATE 03/06
SCALE Noted
SHEET 4 OF 15

KrugNorth2nd\PhaseIV\SS3 05-12-E147