


BENCHMARKS:

BM #1: "C" Cut on Top of Curb
at West Line of Lot 7, Block A,
Auburn Hills 5th Addition.
Elev. = 207.73 (City Datum)


BM #2: Disc in Back of Curb,
North of Front Corner Common
to Lots 23 and 24, Block D,
Auburn Hills 12th Addition.
Elev. = 191.84 (City Datum)

BM #3: "C" Cut in Middle of Curb
Inlet Top Adjacent to the South
Corner of Lot 15, Block B.
Elev. = 193.65 (City Datum)

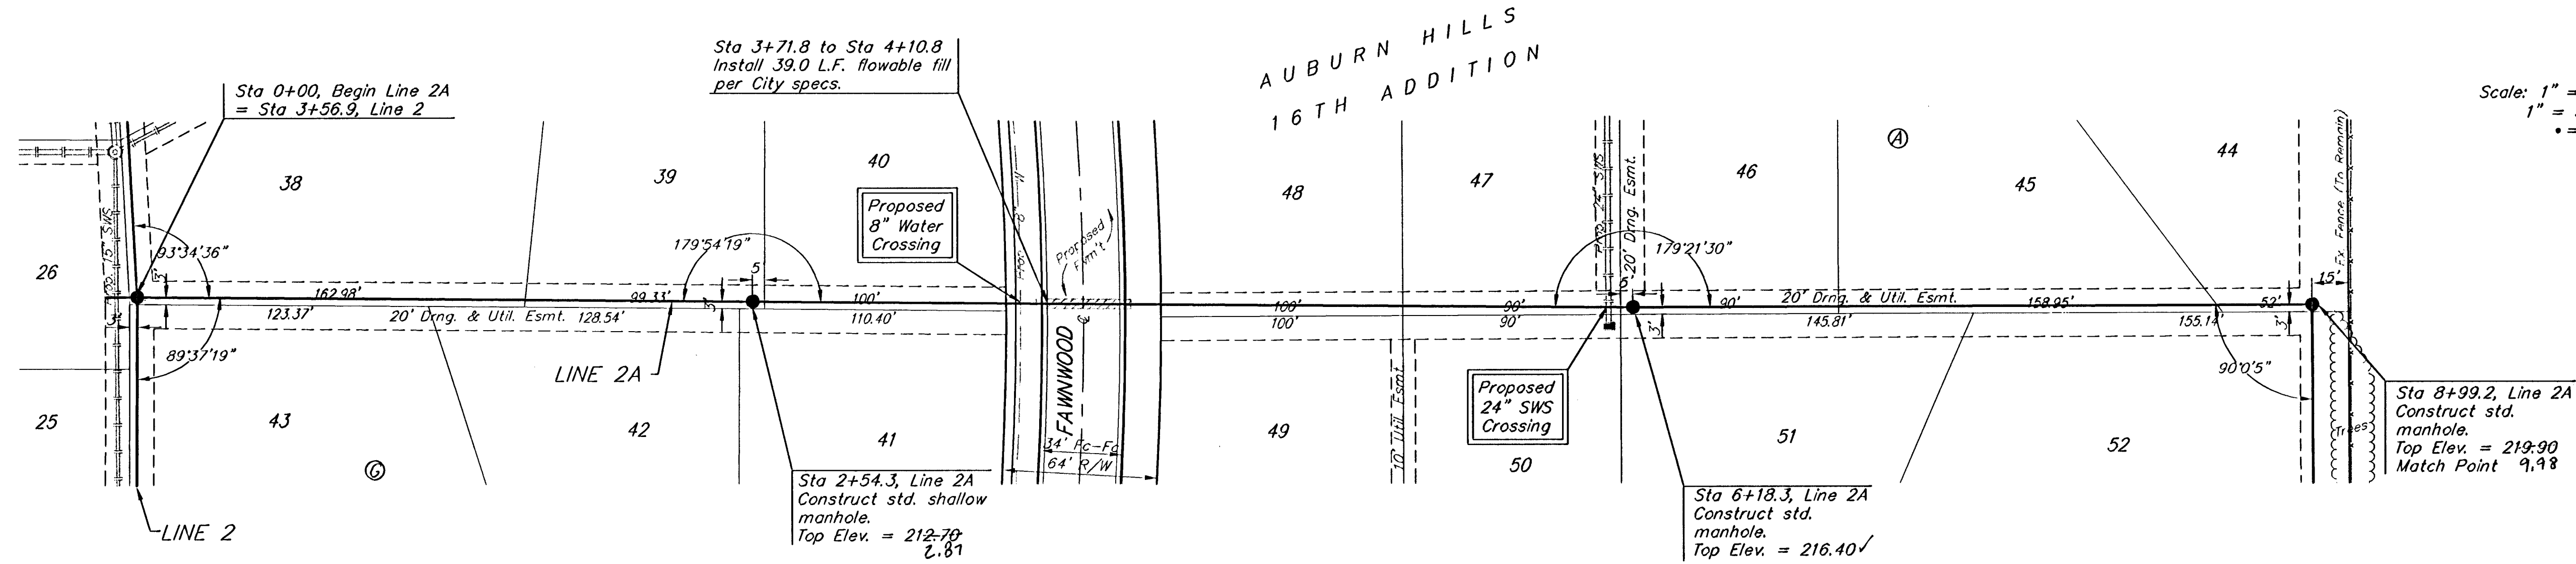

Scale: 1" = 40' Horizontal
1" = 5' Vertical
• = Iron

Remove trees only as necessary
for sanitary sewer construction
and only with permission of
Developer or Baughman Co.
Cost of removal to be incidental
to lump sum bid item "Site
Clearing & Restoration".

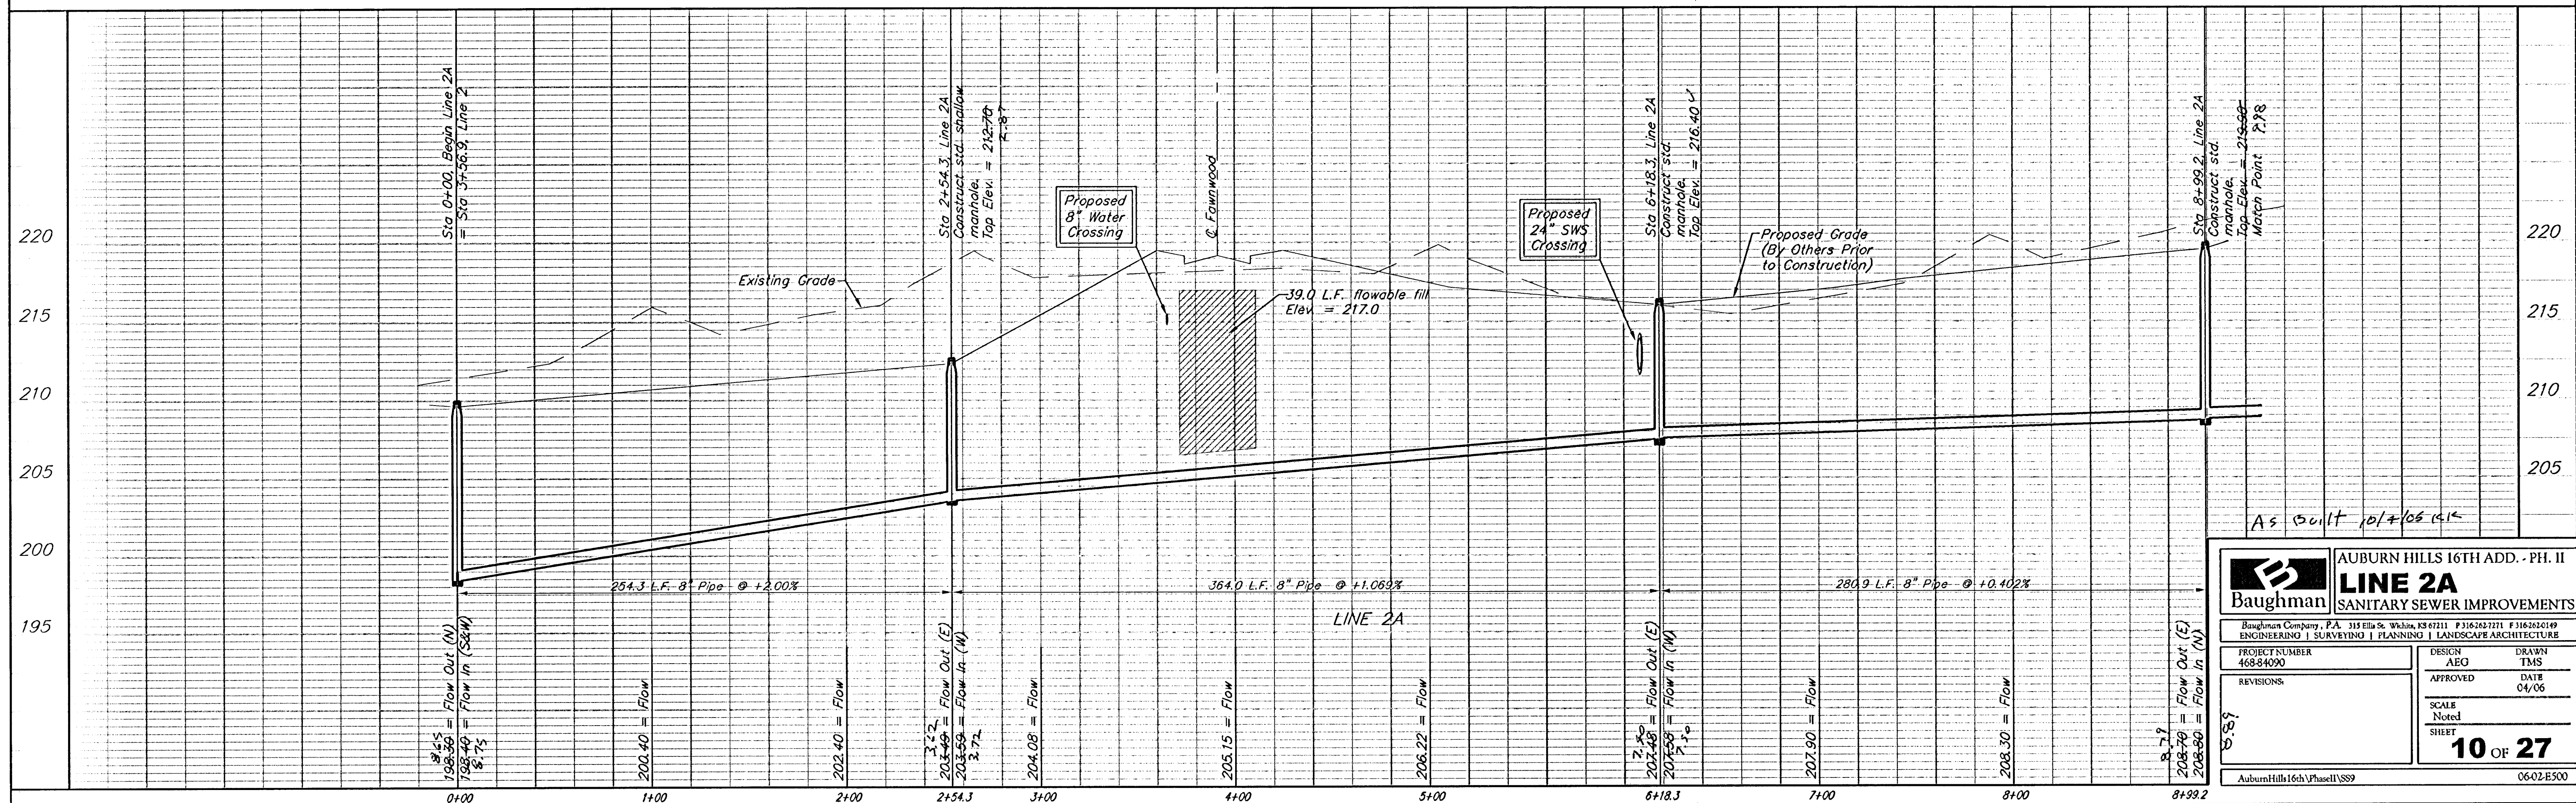

Baughman		AUBURN HILLS 16TH ADD. - PH. II	
LINE 2A		SANITARY SEWER IMPROVEMENTS	
Baughman Company, P.A. 315 Ella St. Wichita, KS 67211 P 316-262-7271 F 316-262-0149		ENGINEERING SURVEYING PLANNING LANDSCAPE ARCHITECTURE	
PROJECT NUMBER 468-84090	DESIGN AEG	DRAWN TMS	DATE 04/06
REVISIONS	APPROVED	SCALE Noted	SHEET 10 OF 27
Auburn Hills 16th Phase II SSS		06-02-E500	