




FOX RIDGE ADDITION

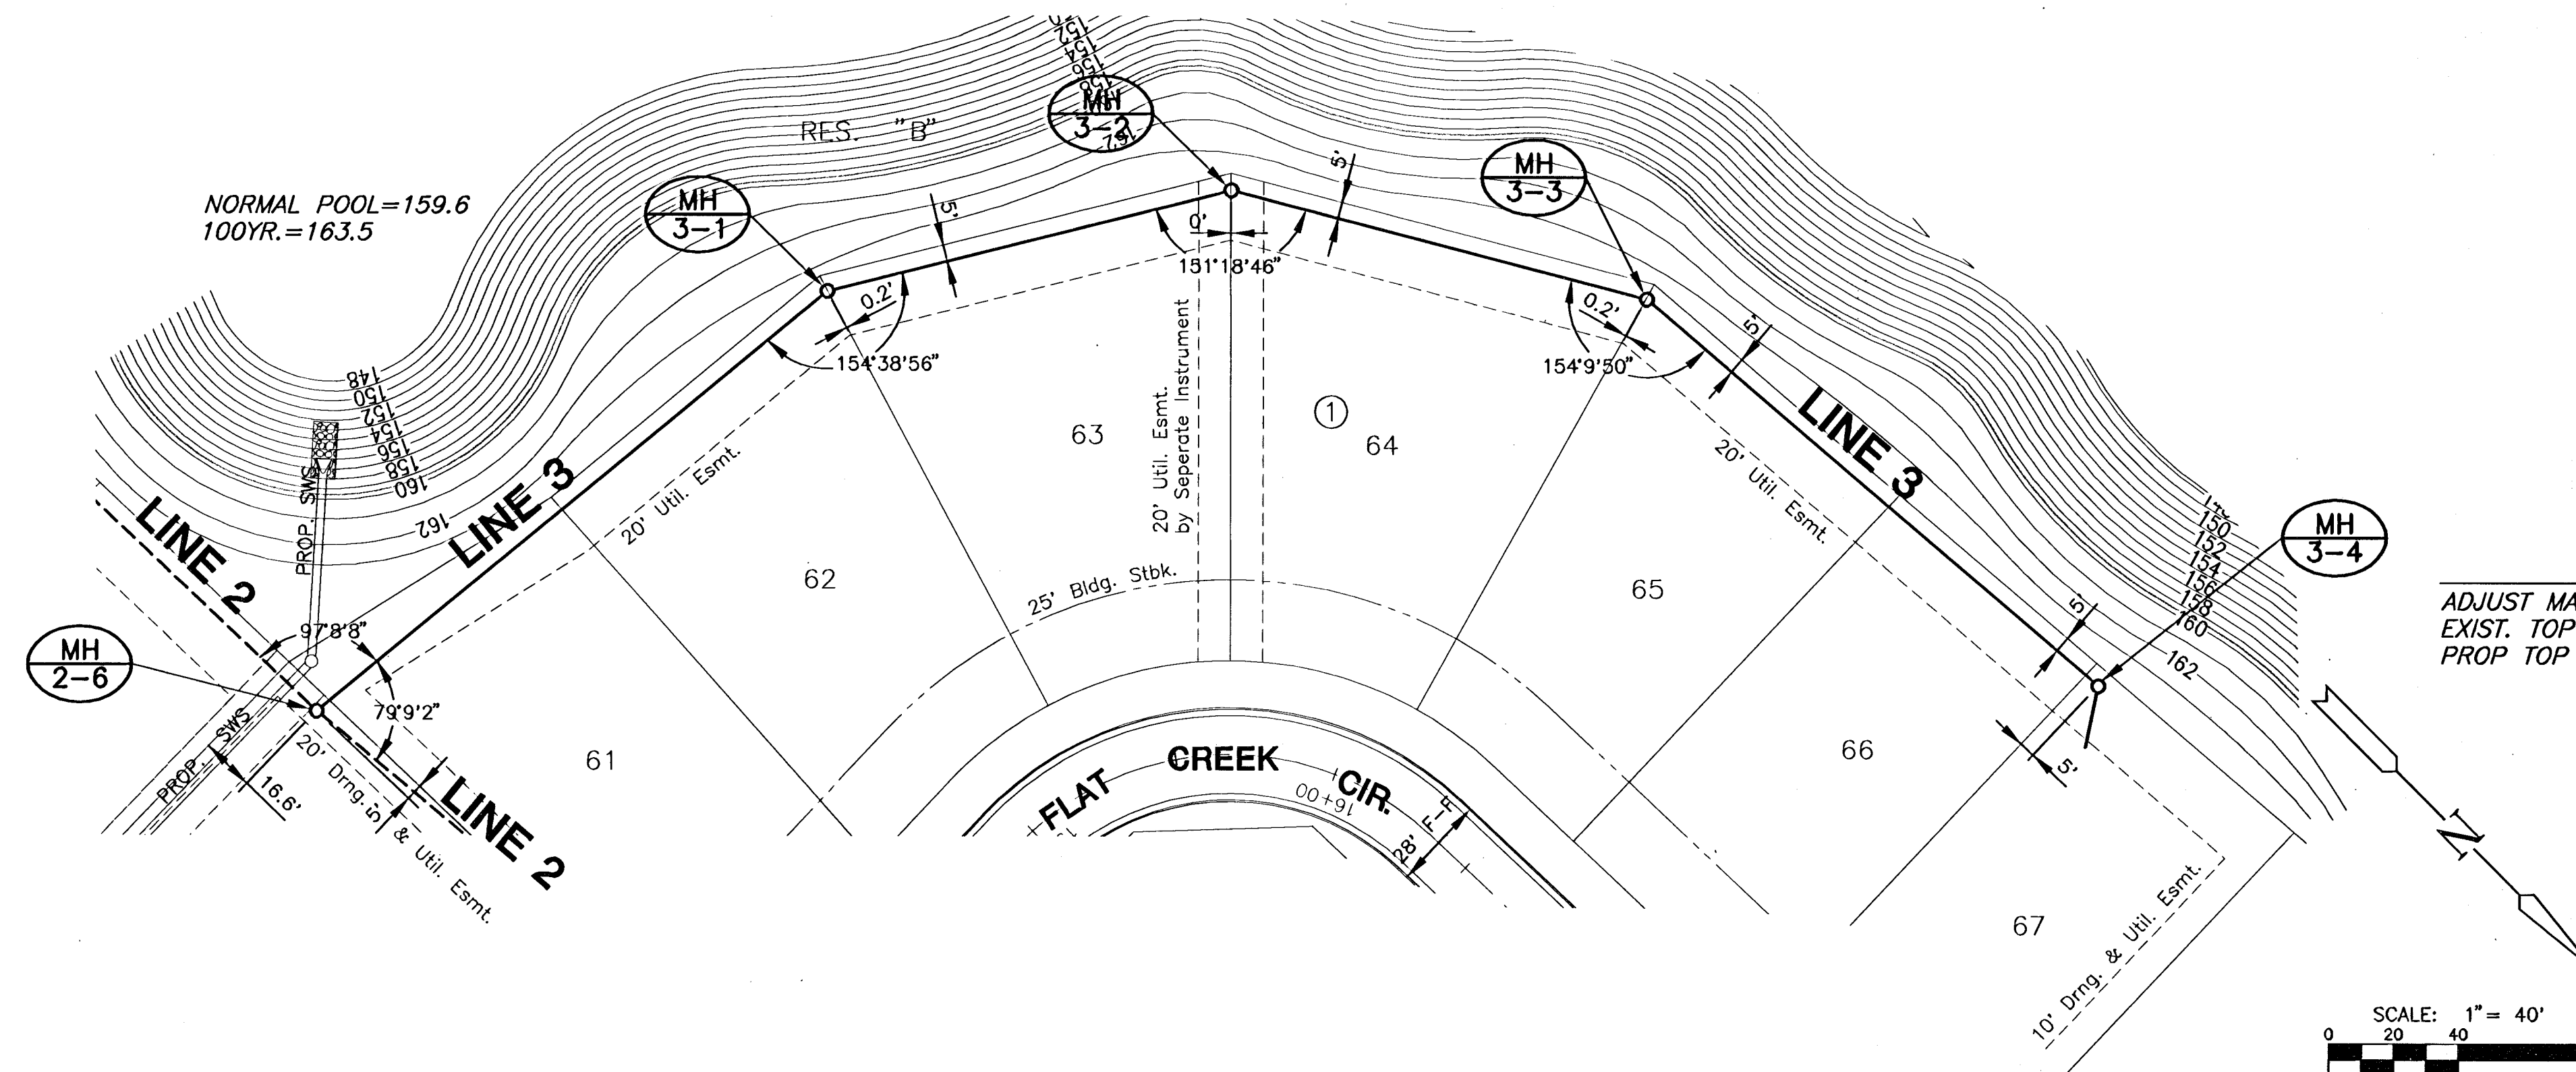


PLAN LINE 3

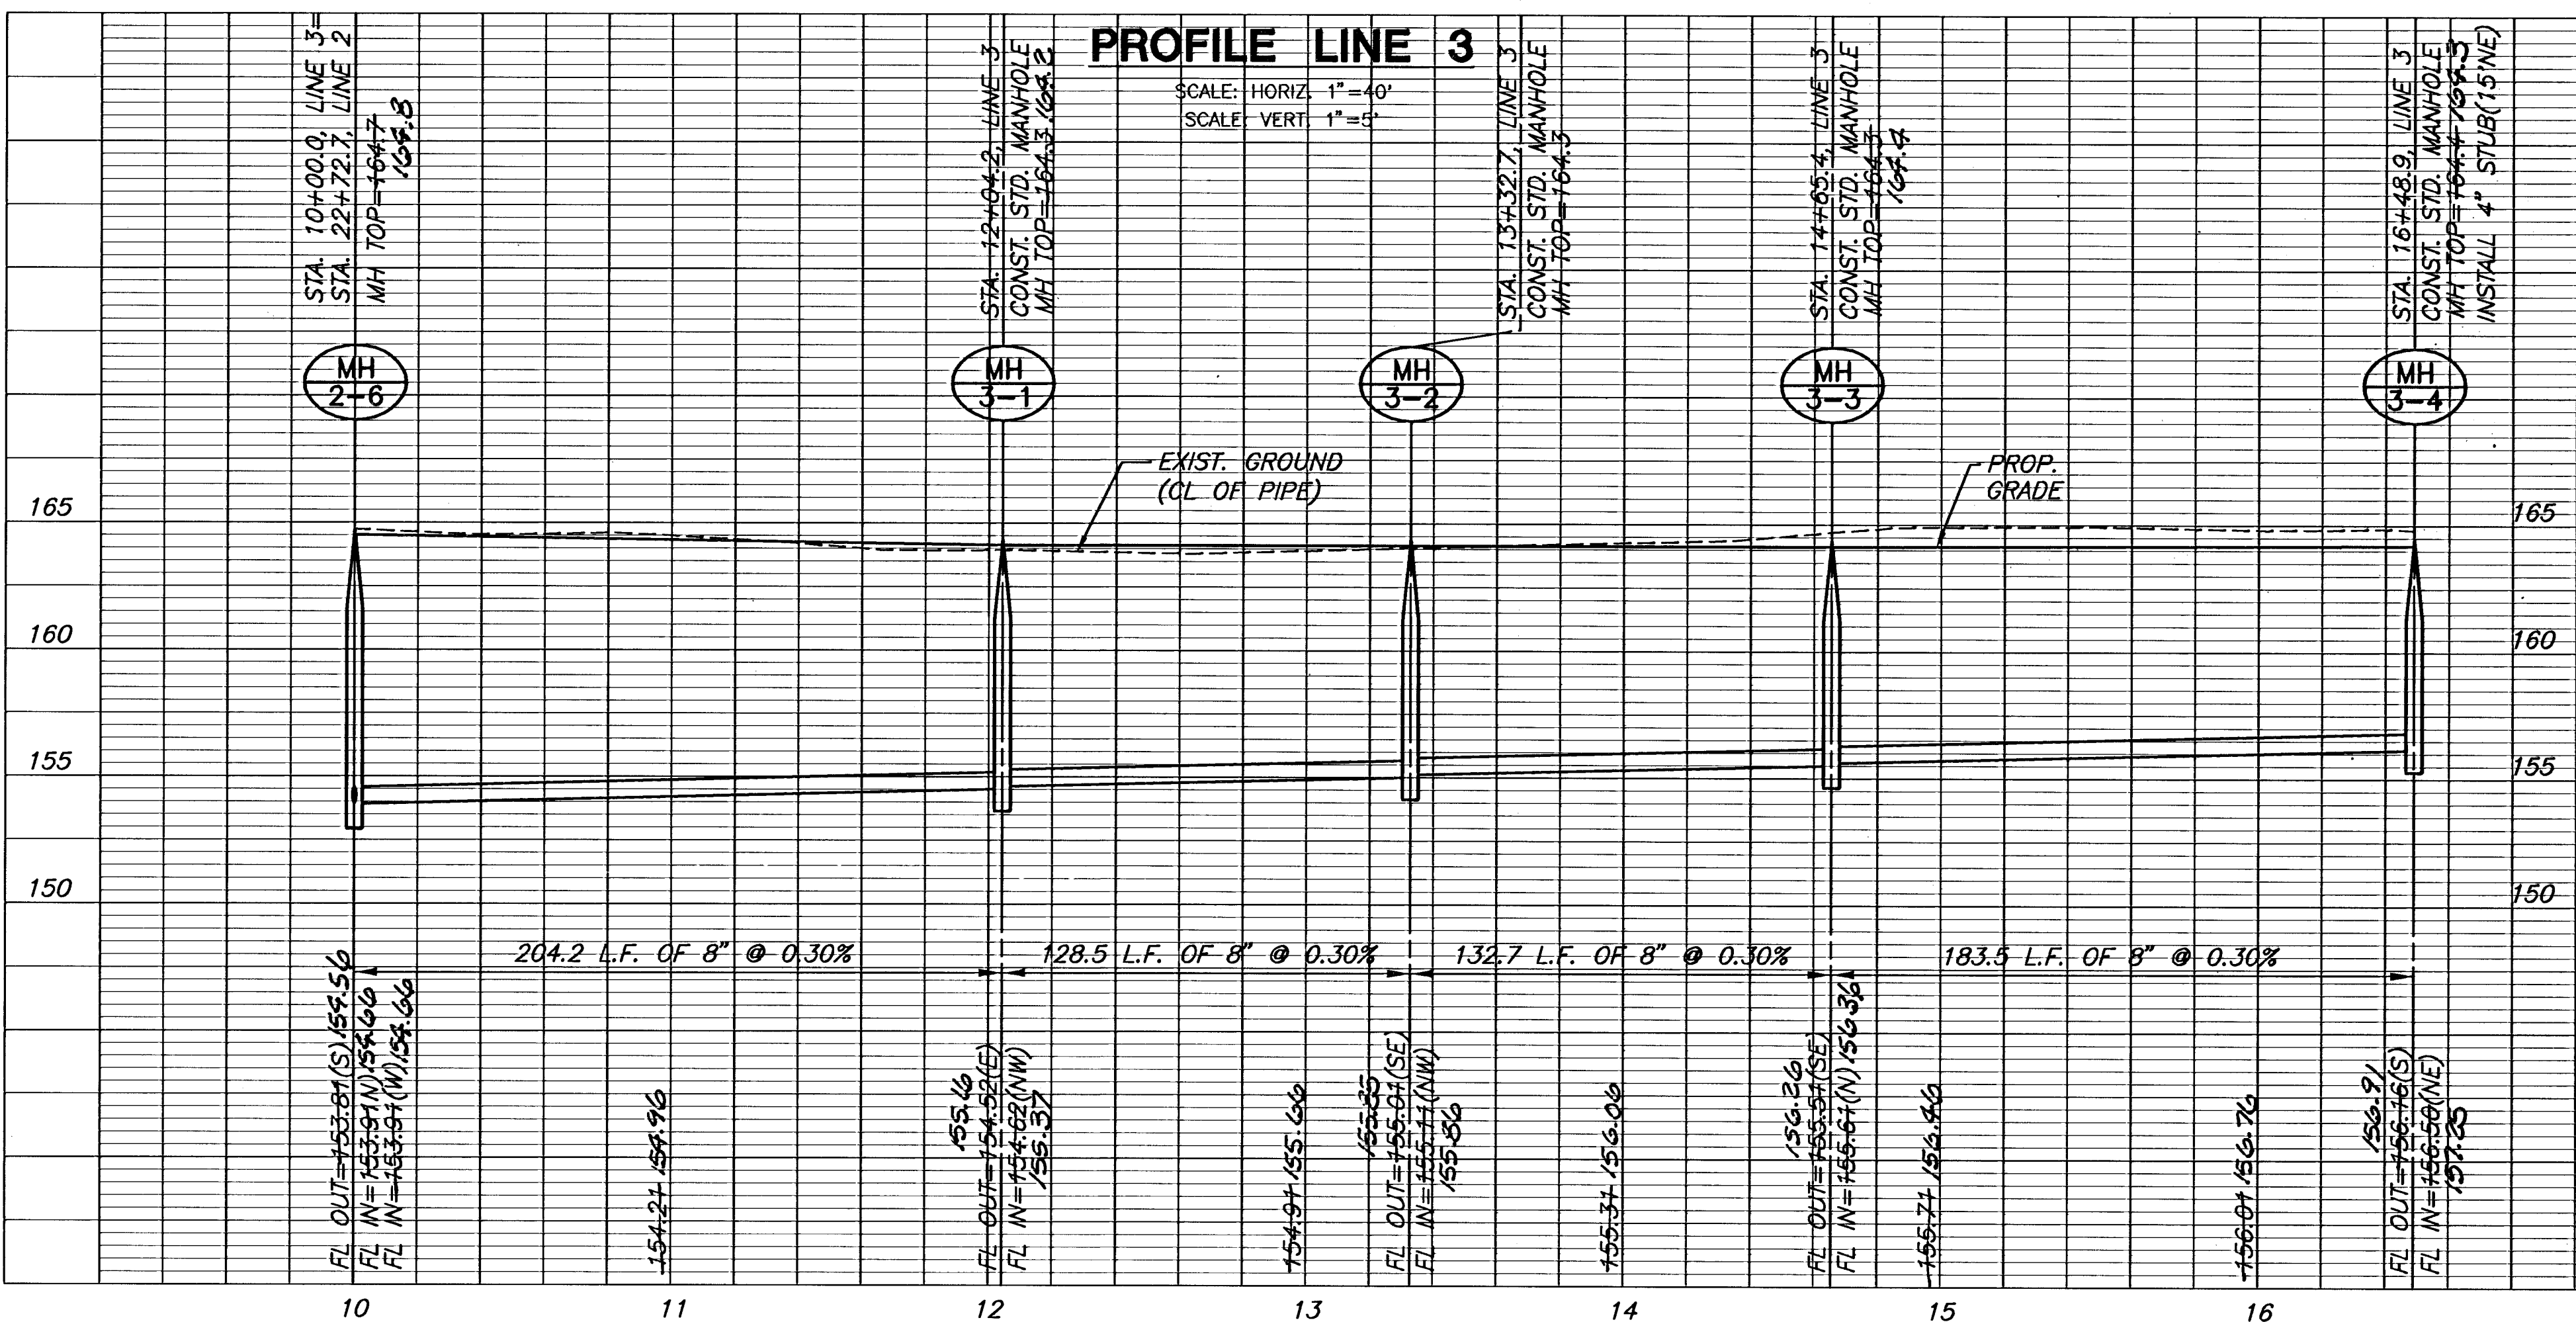

PROFILE LINE 3

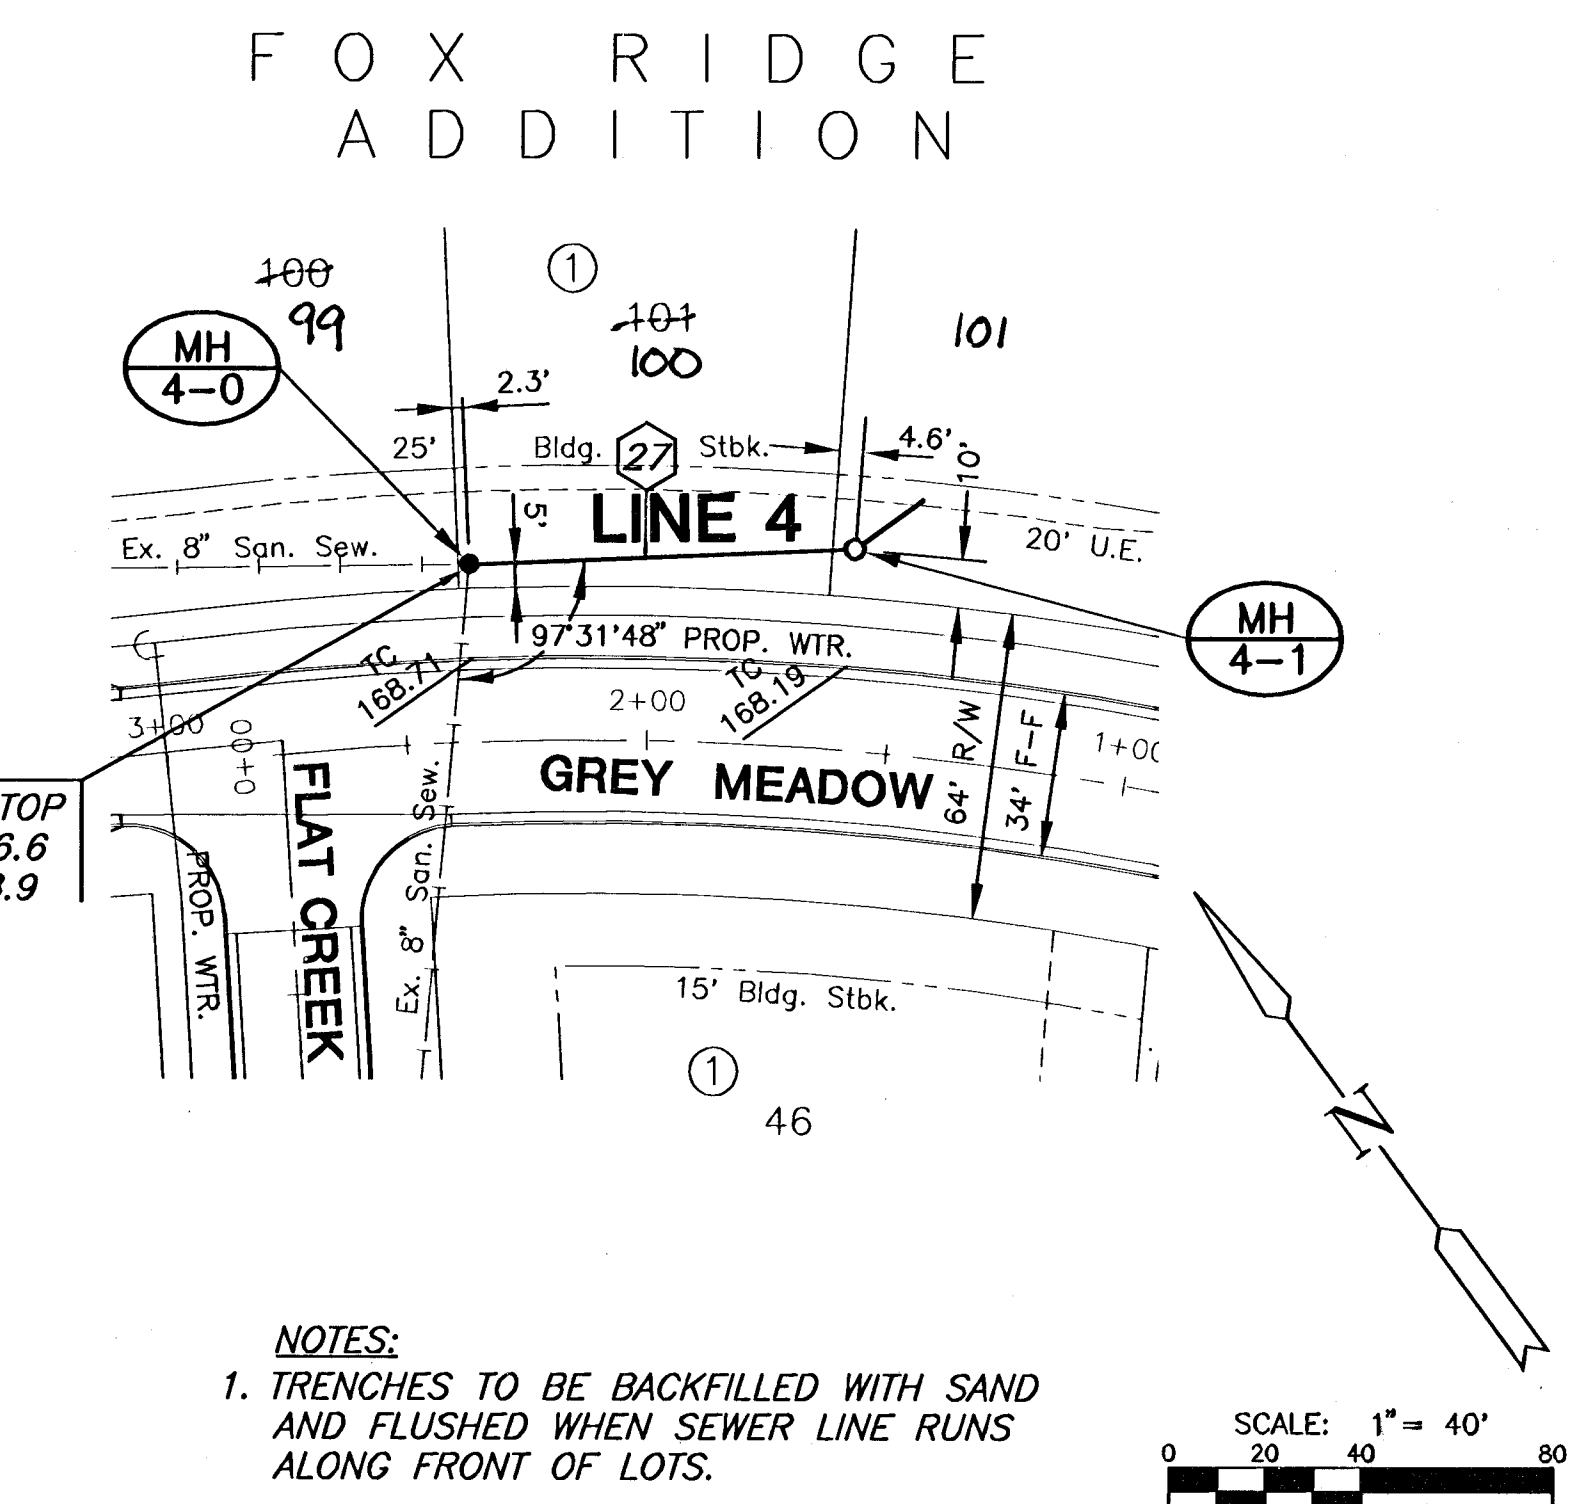

PLAN LINE 4

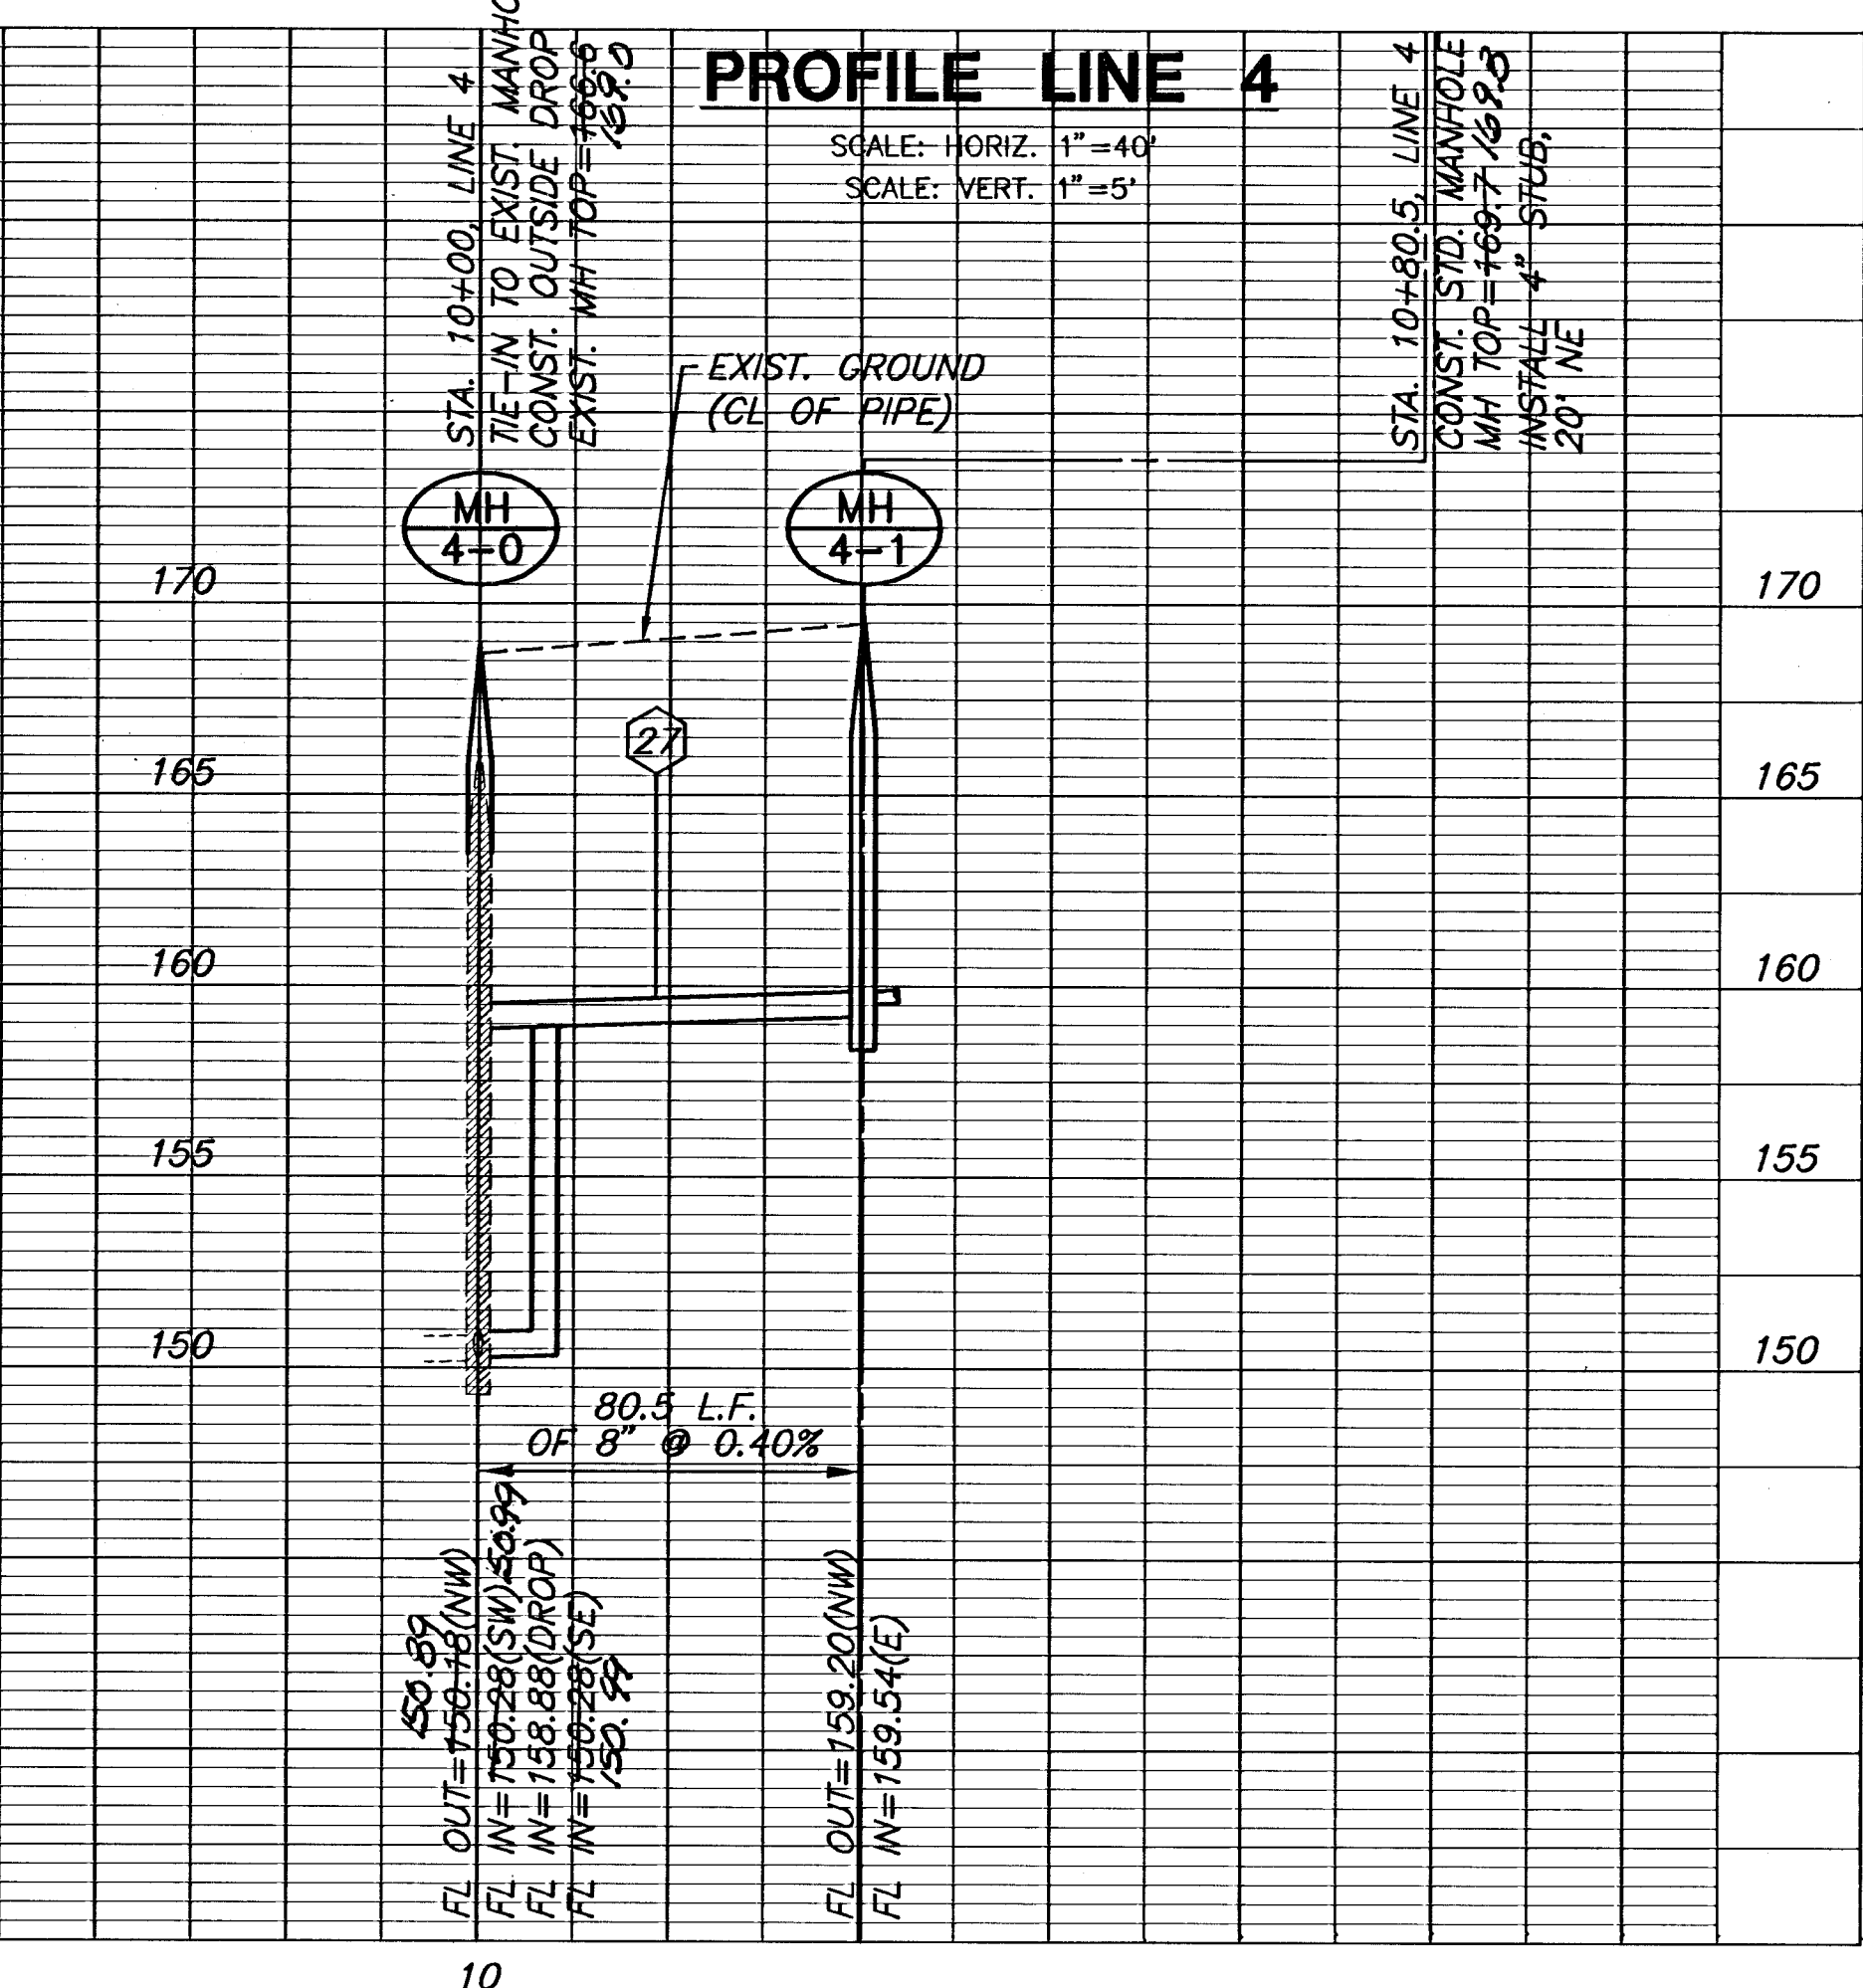

PROFILE LINE 4

NOTES:
1. TRENCHES TO BE BACKFILLED WITH SAND AND FLUSHED WHEN SEWER LINE RUNS ALONG FRONT OF LOTS.

MKEC
ENGINEERING
CONSULTANTS, INC.
411 N. WEBB ROAD
WICHITA, KS. 67206
316-684-9600

SANITARY SEWER PLANS FOX RIDGE PHASE 9

LINE 3 & 4
SHEET TITLE
468-84202
PROJECT NUMBER

DESIGN BY DFL
DRAWN BY MKEC
CHECKED BY GJA

ISSUED JULY 2006
REVISED

SHEET NO.
7 of 14

PLOTTED: Wednesday, July 05, 2006 @ 09:03AM

MKEC ENGINEERING CONSULTANTS, INC. © COPYRIGHT