


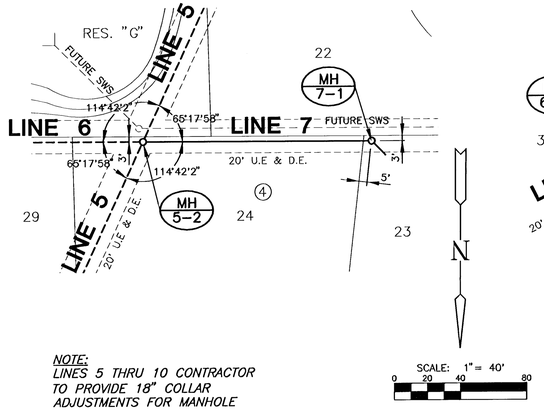


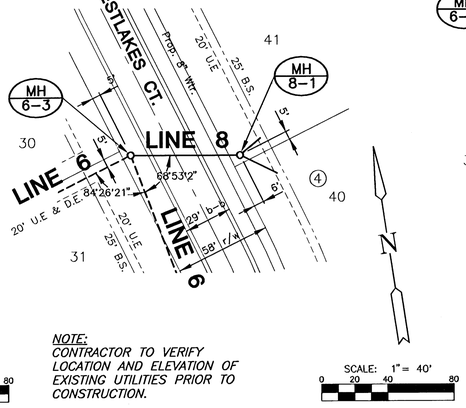

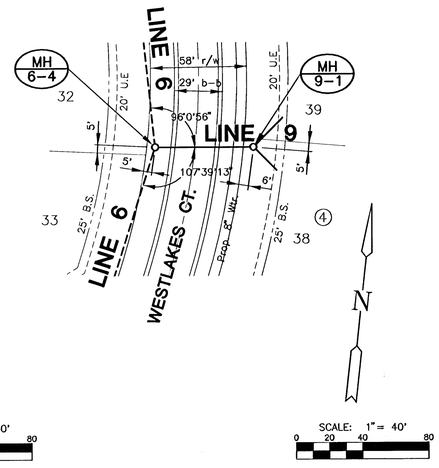

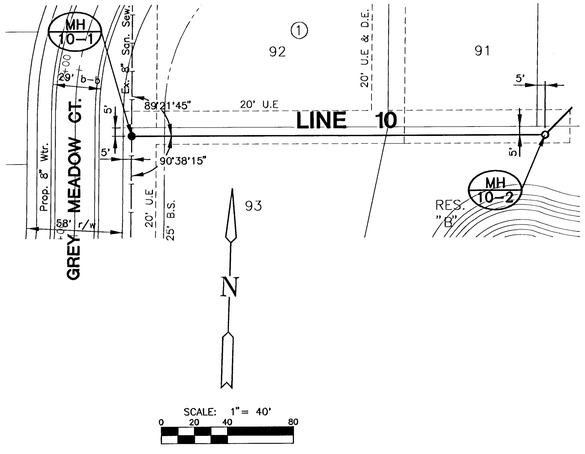

NOTE:
LINES 5 THRU 10 CONTRACTOR TO PROVIDE 18" COLLAR ADJUSTMENTS FOR MANHOLE

SCALE: 1" = 40'
0 20 40 80

PLAN LINE 7

NOTE:
CONTRACTOR TO VERIFY LOCATION AND ELEVATION OF EXISTING UTILITIES PRIOR TO CONSTRUCTION.

SCALE: 1" = 40'
0 20 40 80


PLAN LINE 8

SCALE: 1" = 40'
0 20 40 80

PLAN LINE 9

SCALE: 1" = 40'
0 20 40 80

PLAN LINE 10

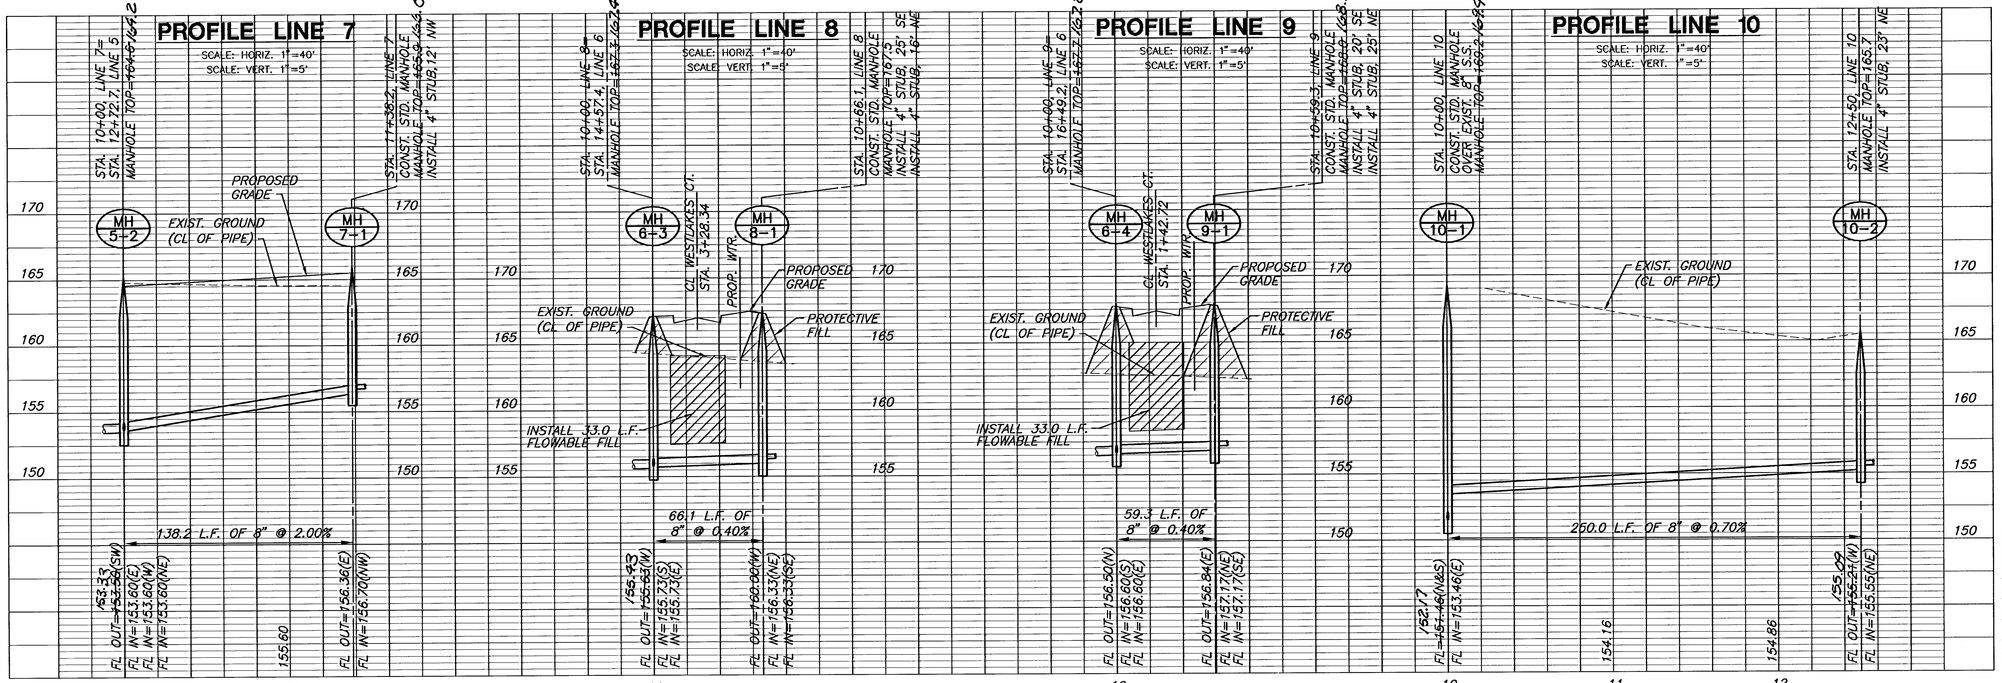

PLOTTED: Wednesday, JULY 05, 2006 @ 08:04AM

MKEC ENGINEERING CONSULTANTS, INC.
411 N. WEBB ROAD
WICHITA, KS. 67206
316 - 684 - 9600

SANITARY SEWER PLANS

FOX RIDGE

PHASE 9

LINES 7, 8, 9, & 10
SHEET TITLE

468-84202
PROJECT NUMBER

DFL
DESIGN BY

MKEC
DRAWN BY

GJA
CHECKED BY

ISSUED
JULY 2006
REVISED

SHEET NO.
10 of 14

G:\CIVIL\98118\dwg\SAN\PHP\98118877.dwg

MKEC ENGINEERING CONSULTANTS, INC. © COPYRIGHT