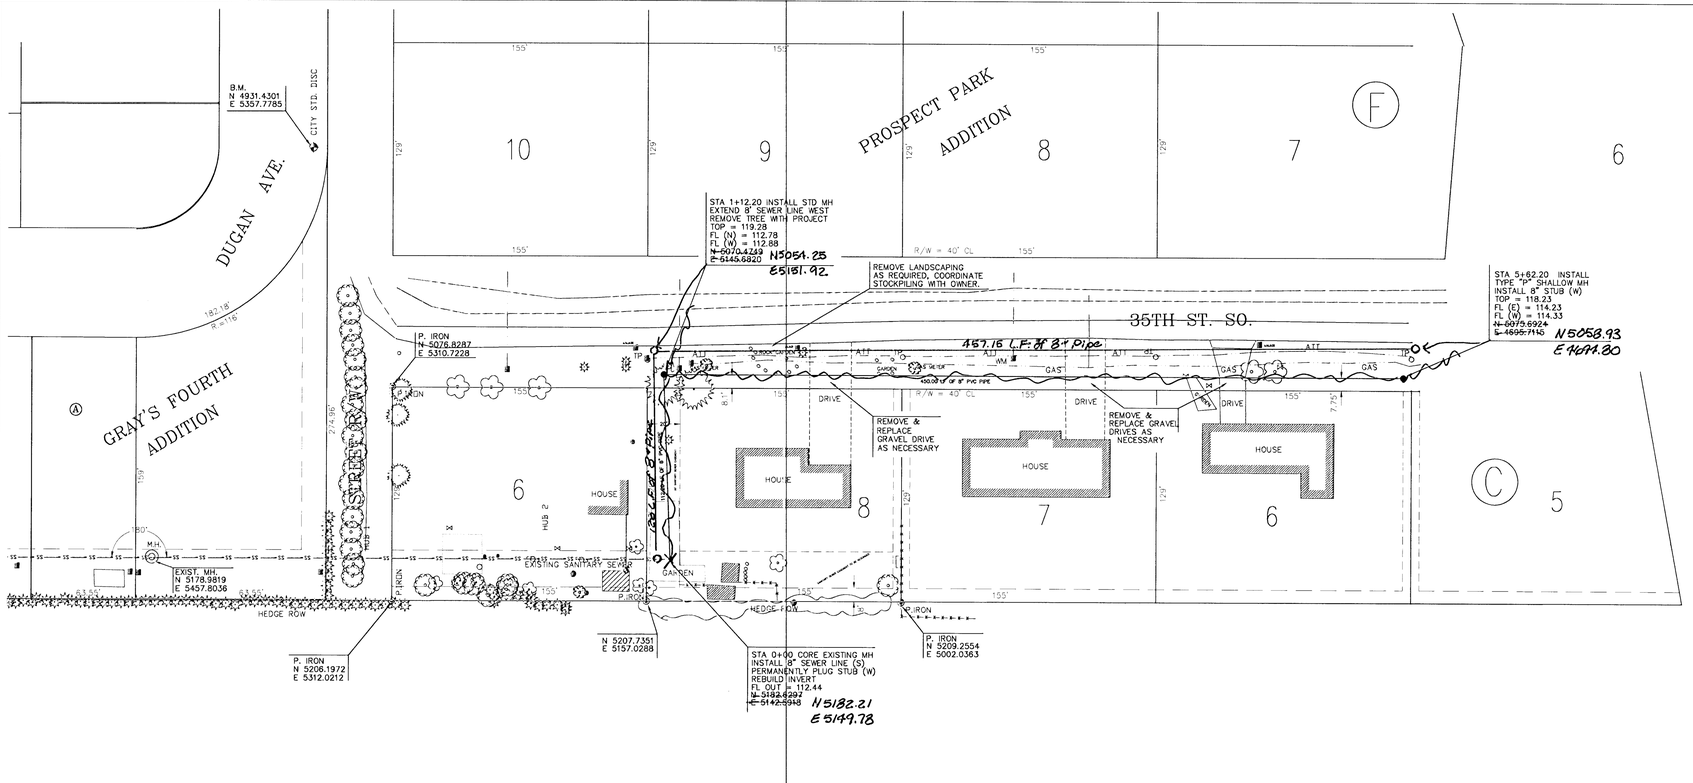

SCALE: PLAN 1" = 40'
PROFILE HORZ. 1" = 40'
VERT. 1" = 5'

BM. CITY STD. DISC, 38 FT. EAST AND 27.5 FT. NORTH OF CENTERLINE OF RIDGE ROAD AND 35TH ST. SOUTH ELEVATION = 121.65

BM. CITY STD. DISC, 23 FT. WEST AND 81.5 FT. SOUTH OF CENTERLINE OF DUGAN ROAD AND 35TH ST. SOUTH ELEVATION = 119.56

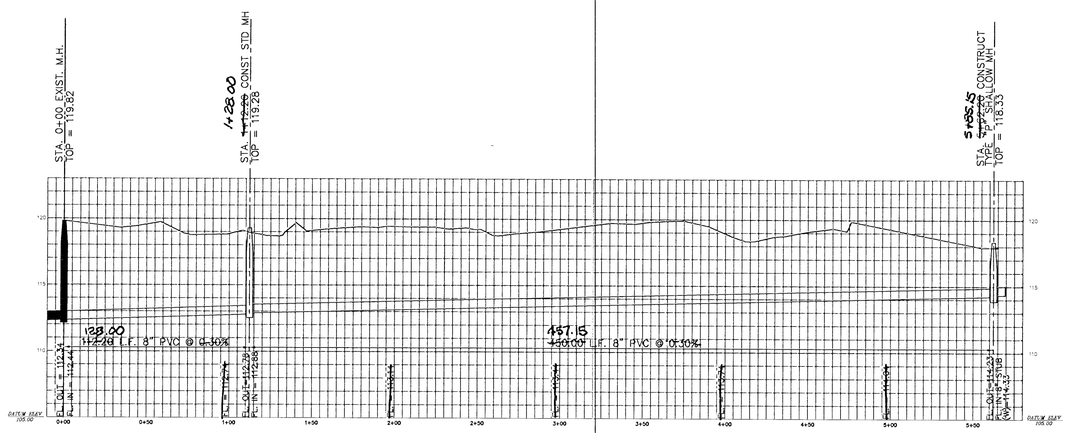

CITY OF WICHITA
PUBLIC WORKS
ENGINEERING

LAT 506, SOUTHWEST INTERCEPTOR SEWER

CITY ENGINEER
JAMES L. ARMOUR, P.E.

PROJECT NUMBER	OCA NUMBER	DATE
468-83953	744107	10/06

CITY ENGINEER'S OFFICE
CITY HALL – SEVENTH FLOOR
455 NORTH MAIN STREET
WICHITA, KANSAS 67202-1620
(316) 268-4501
(316) 268-4114 FAX

DESIGN YOUNKIN
DRAWN LONG
SHEET 2 OF 5