
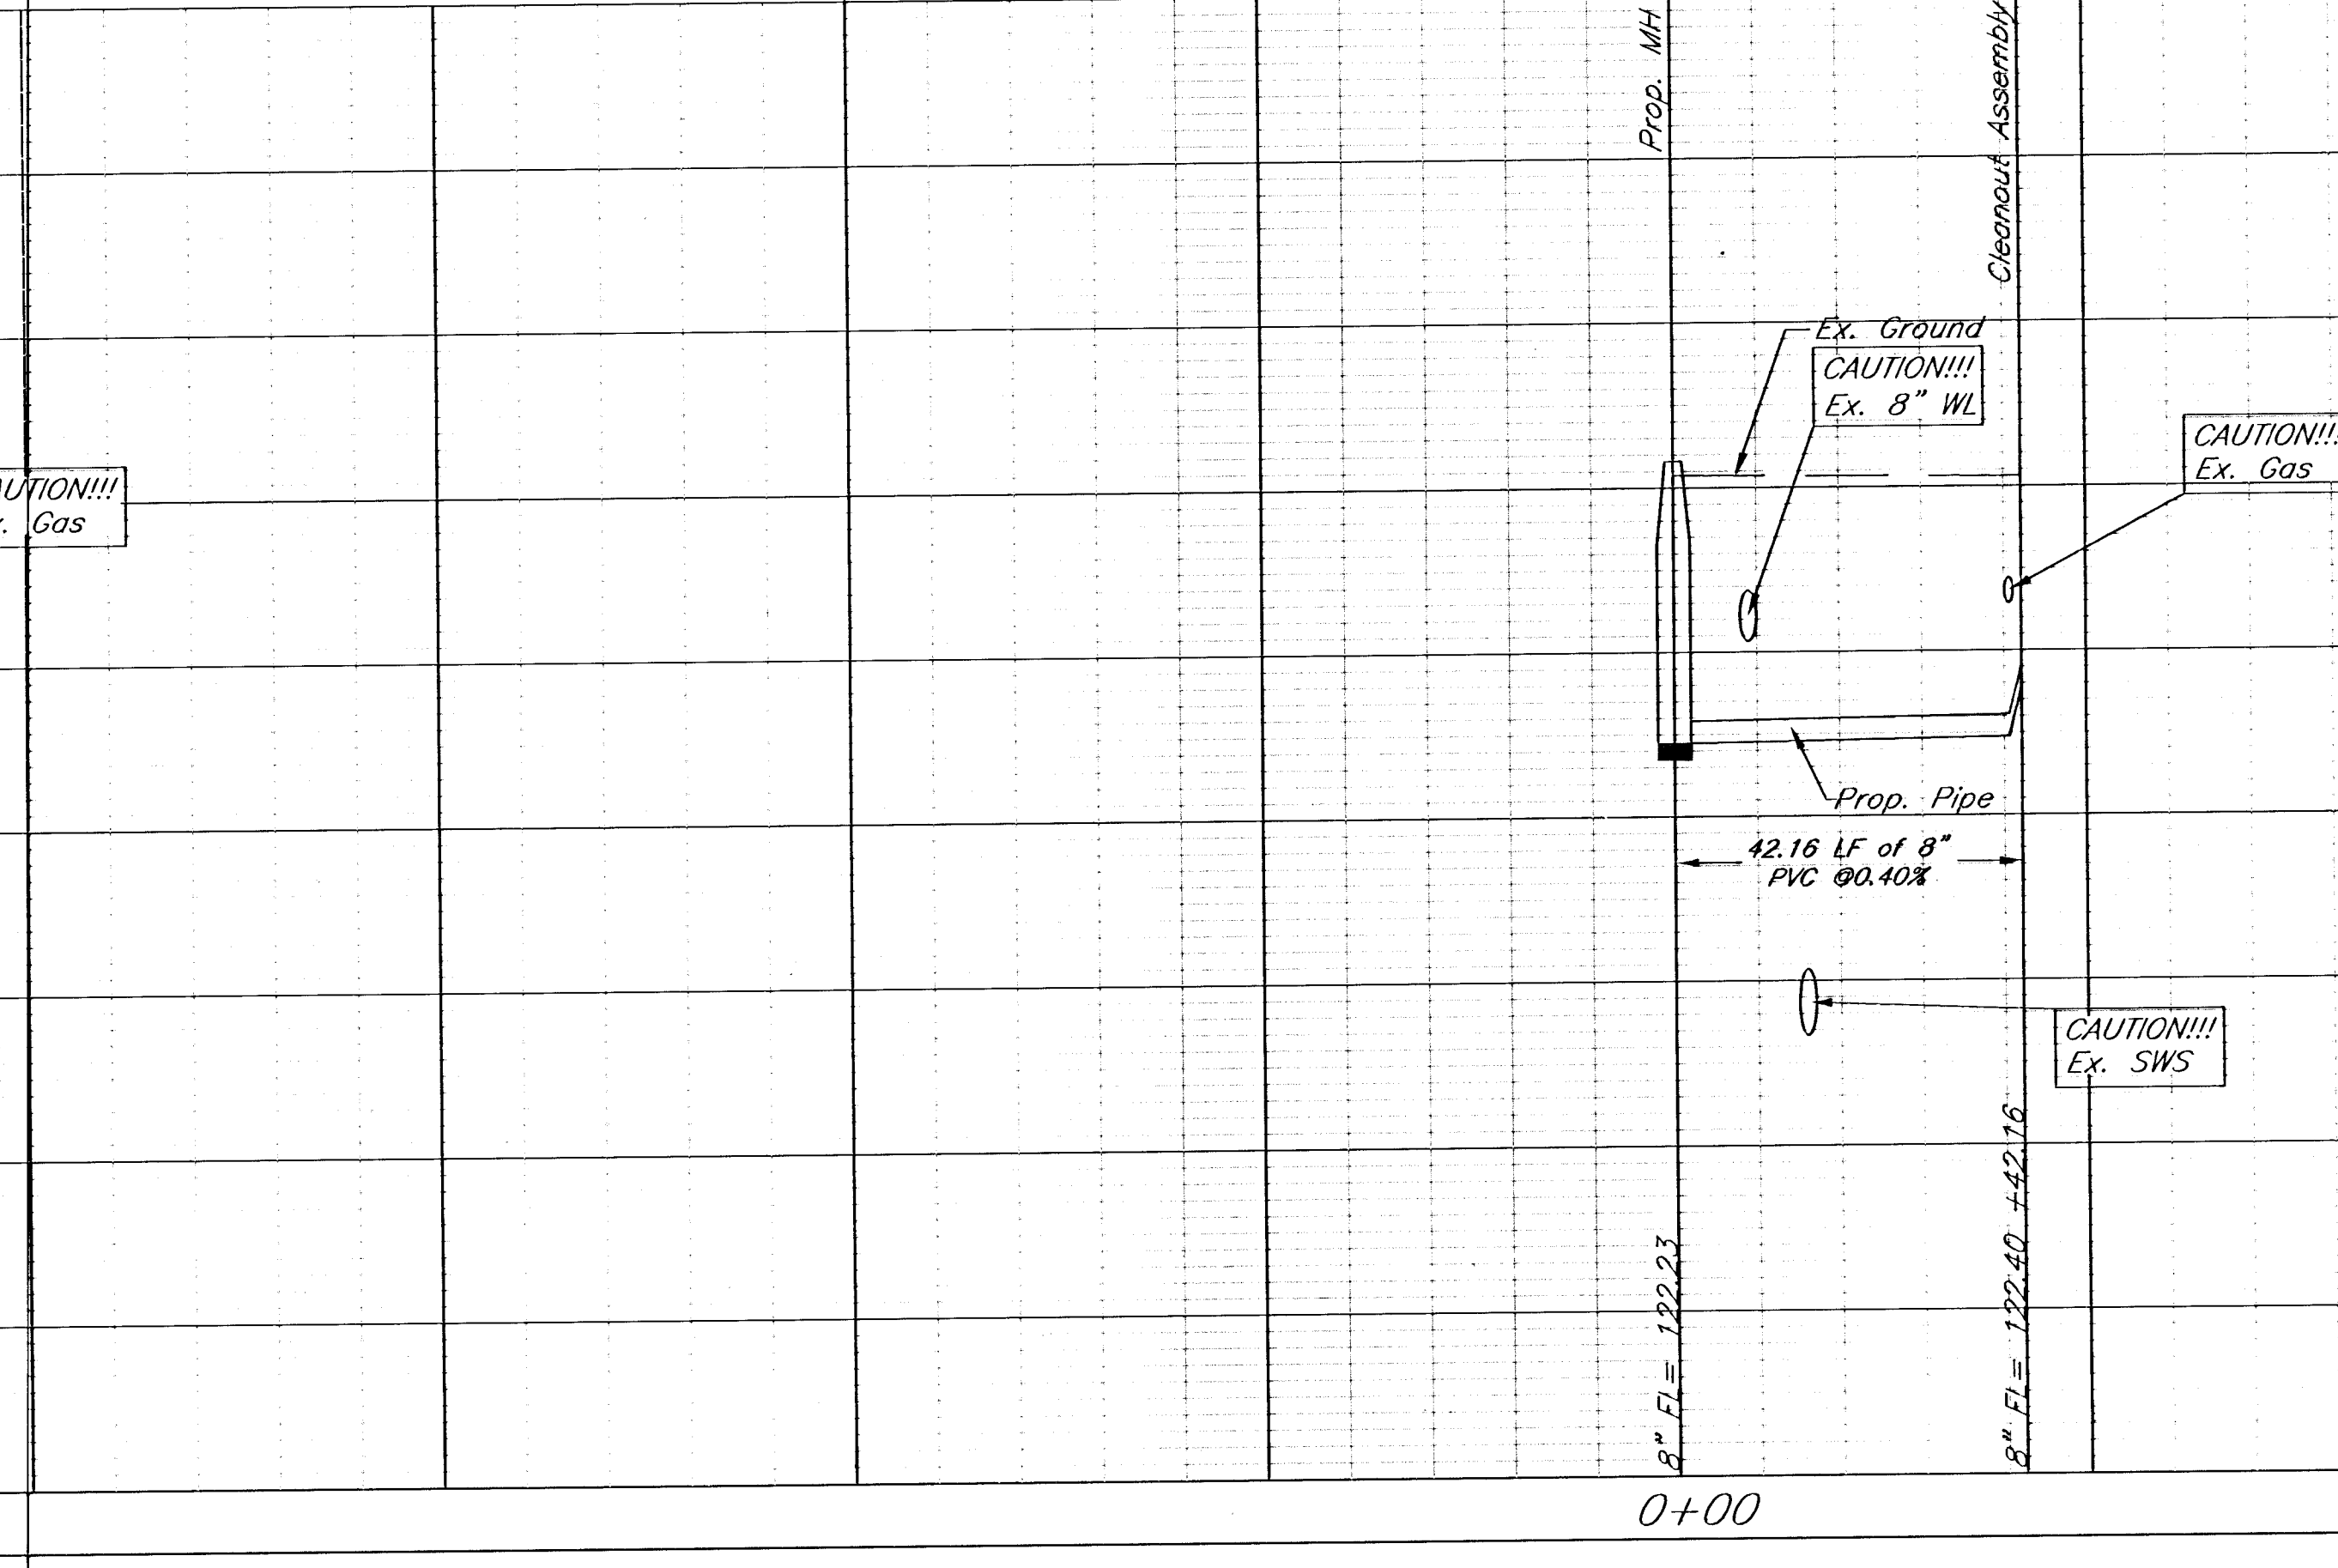
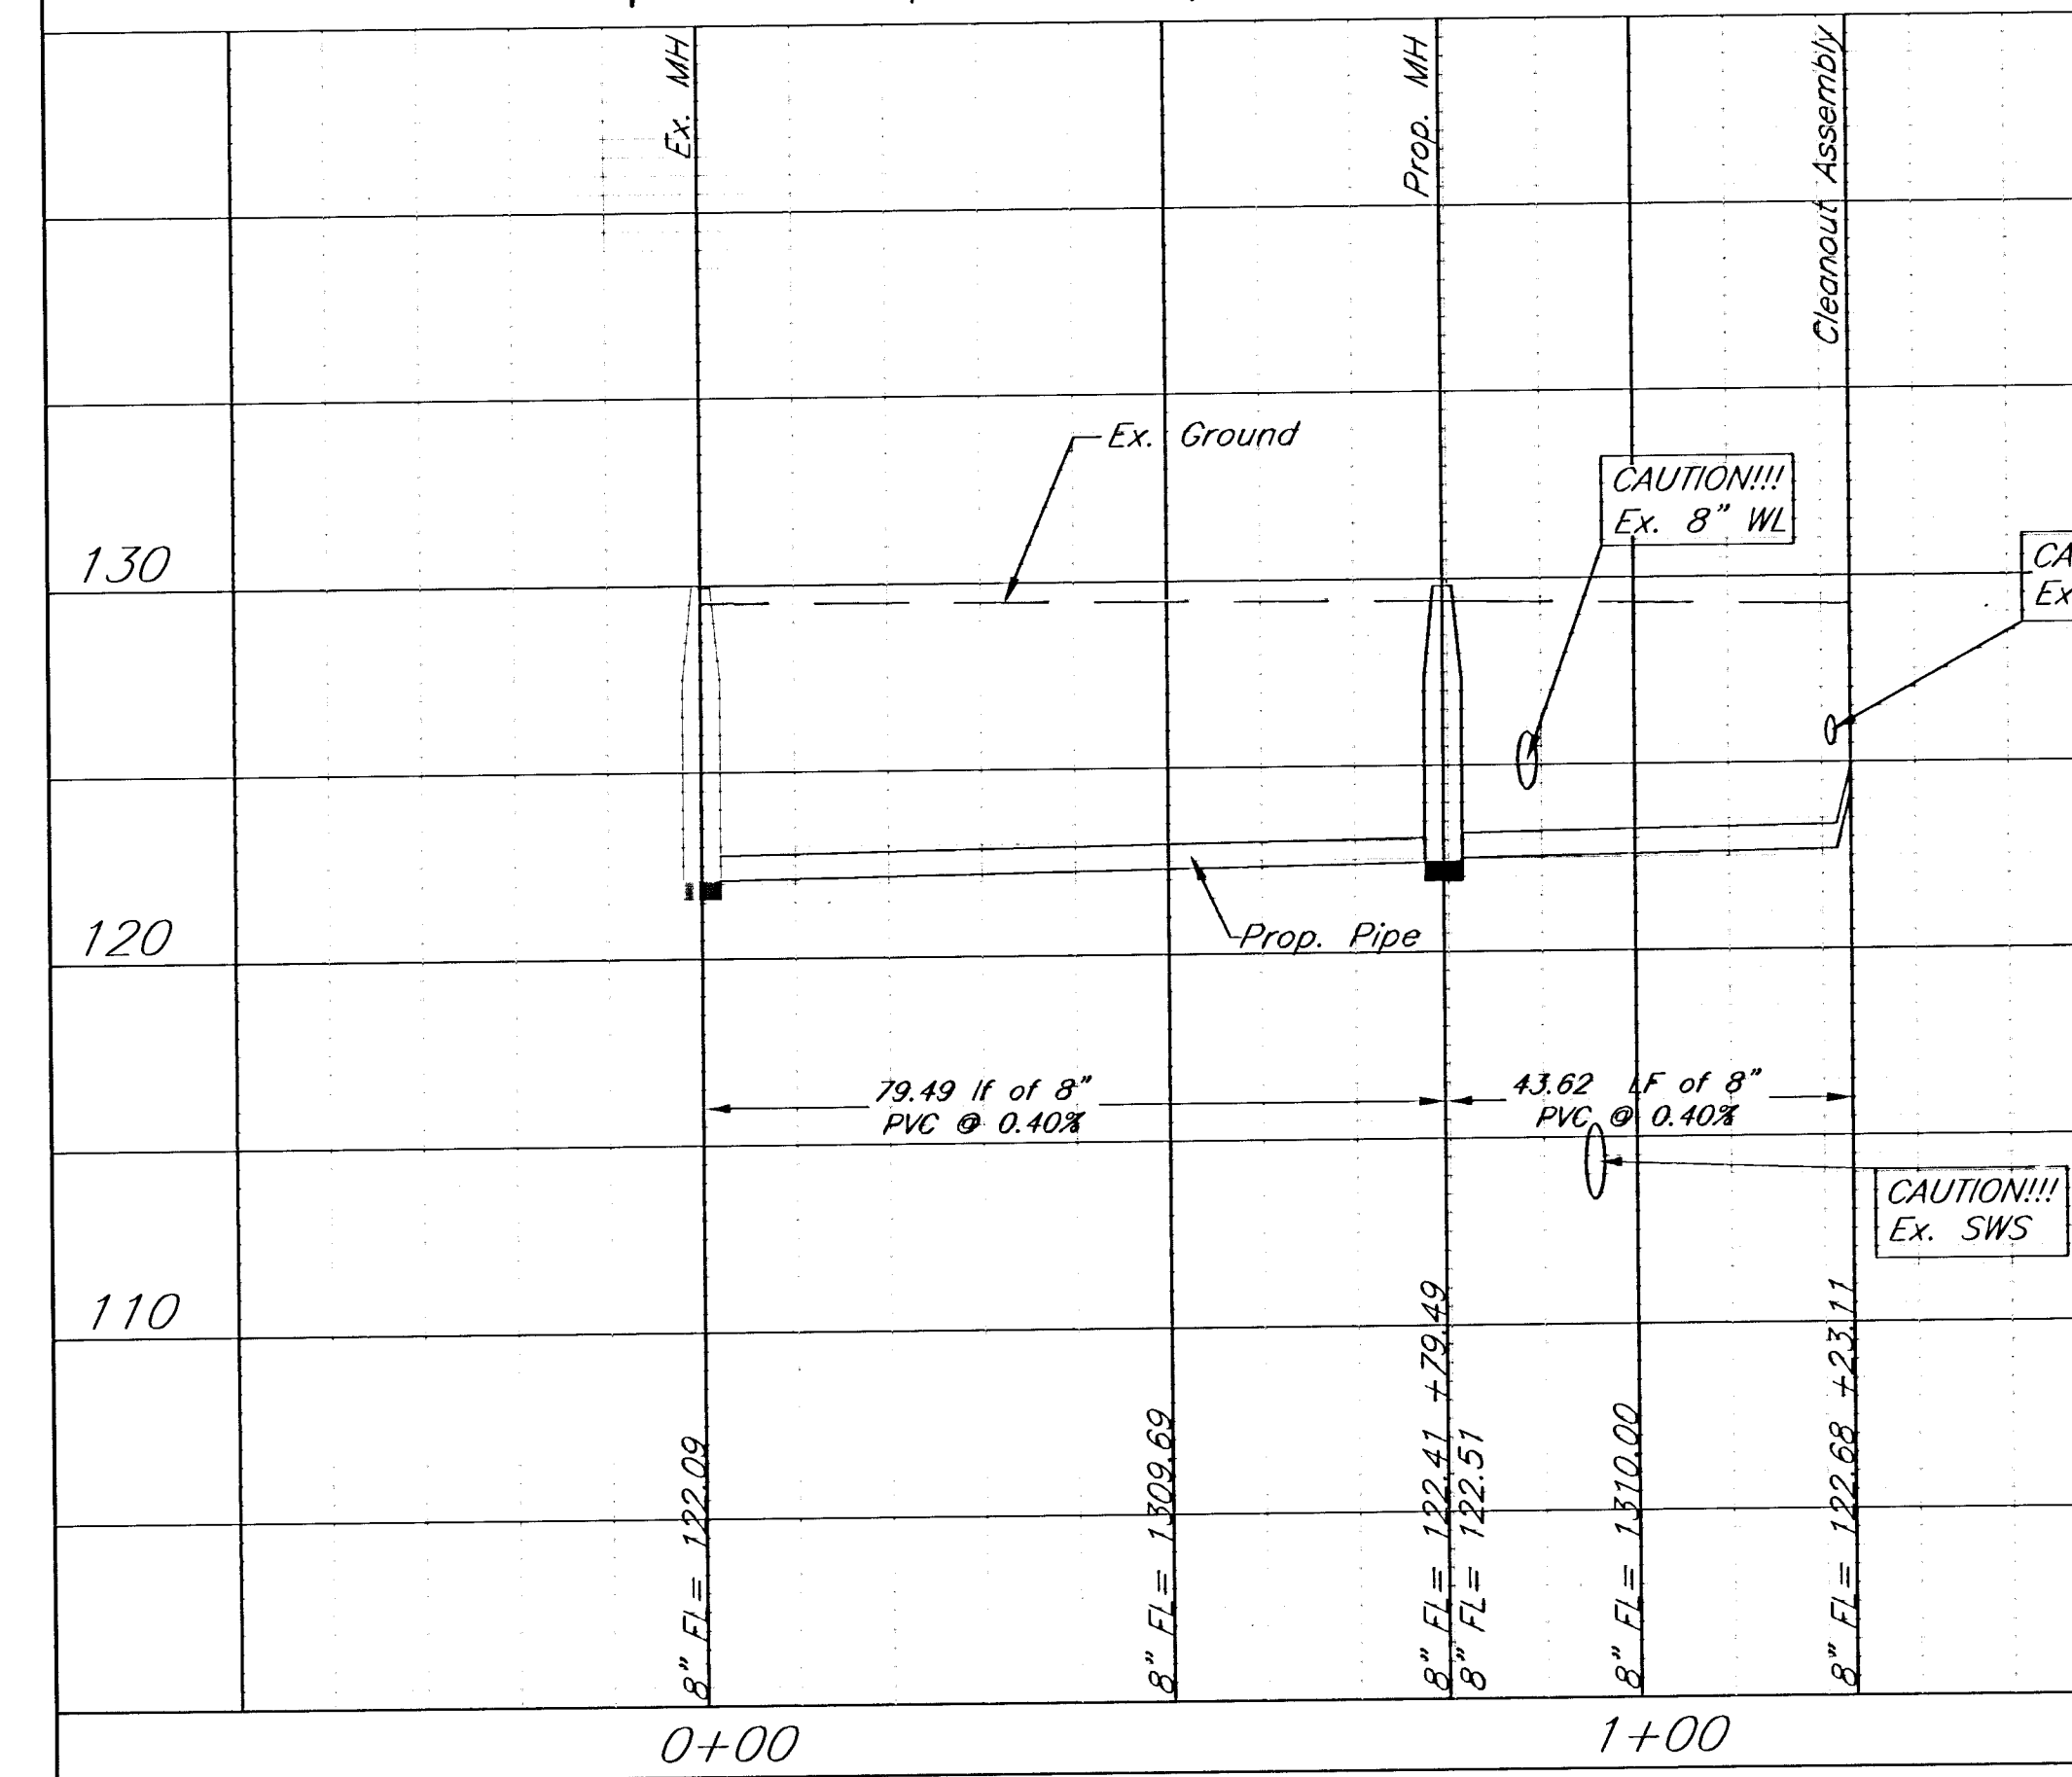
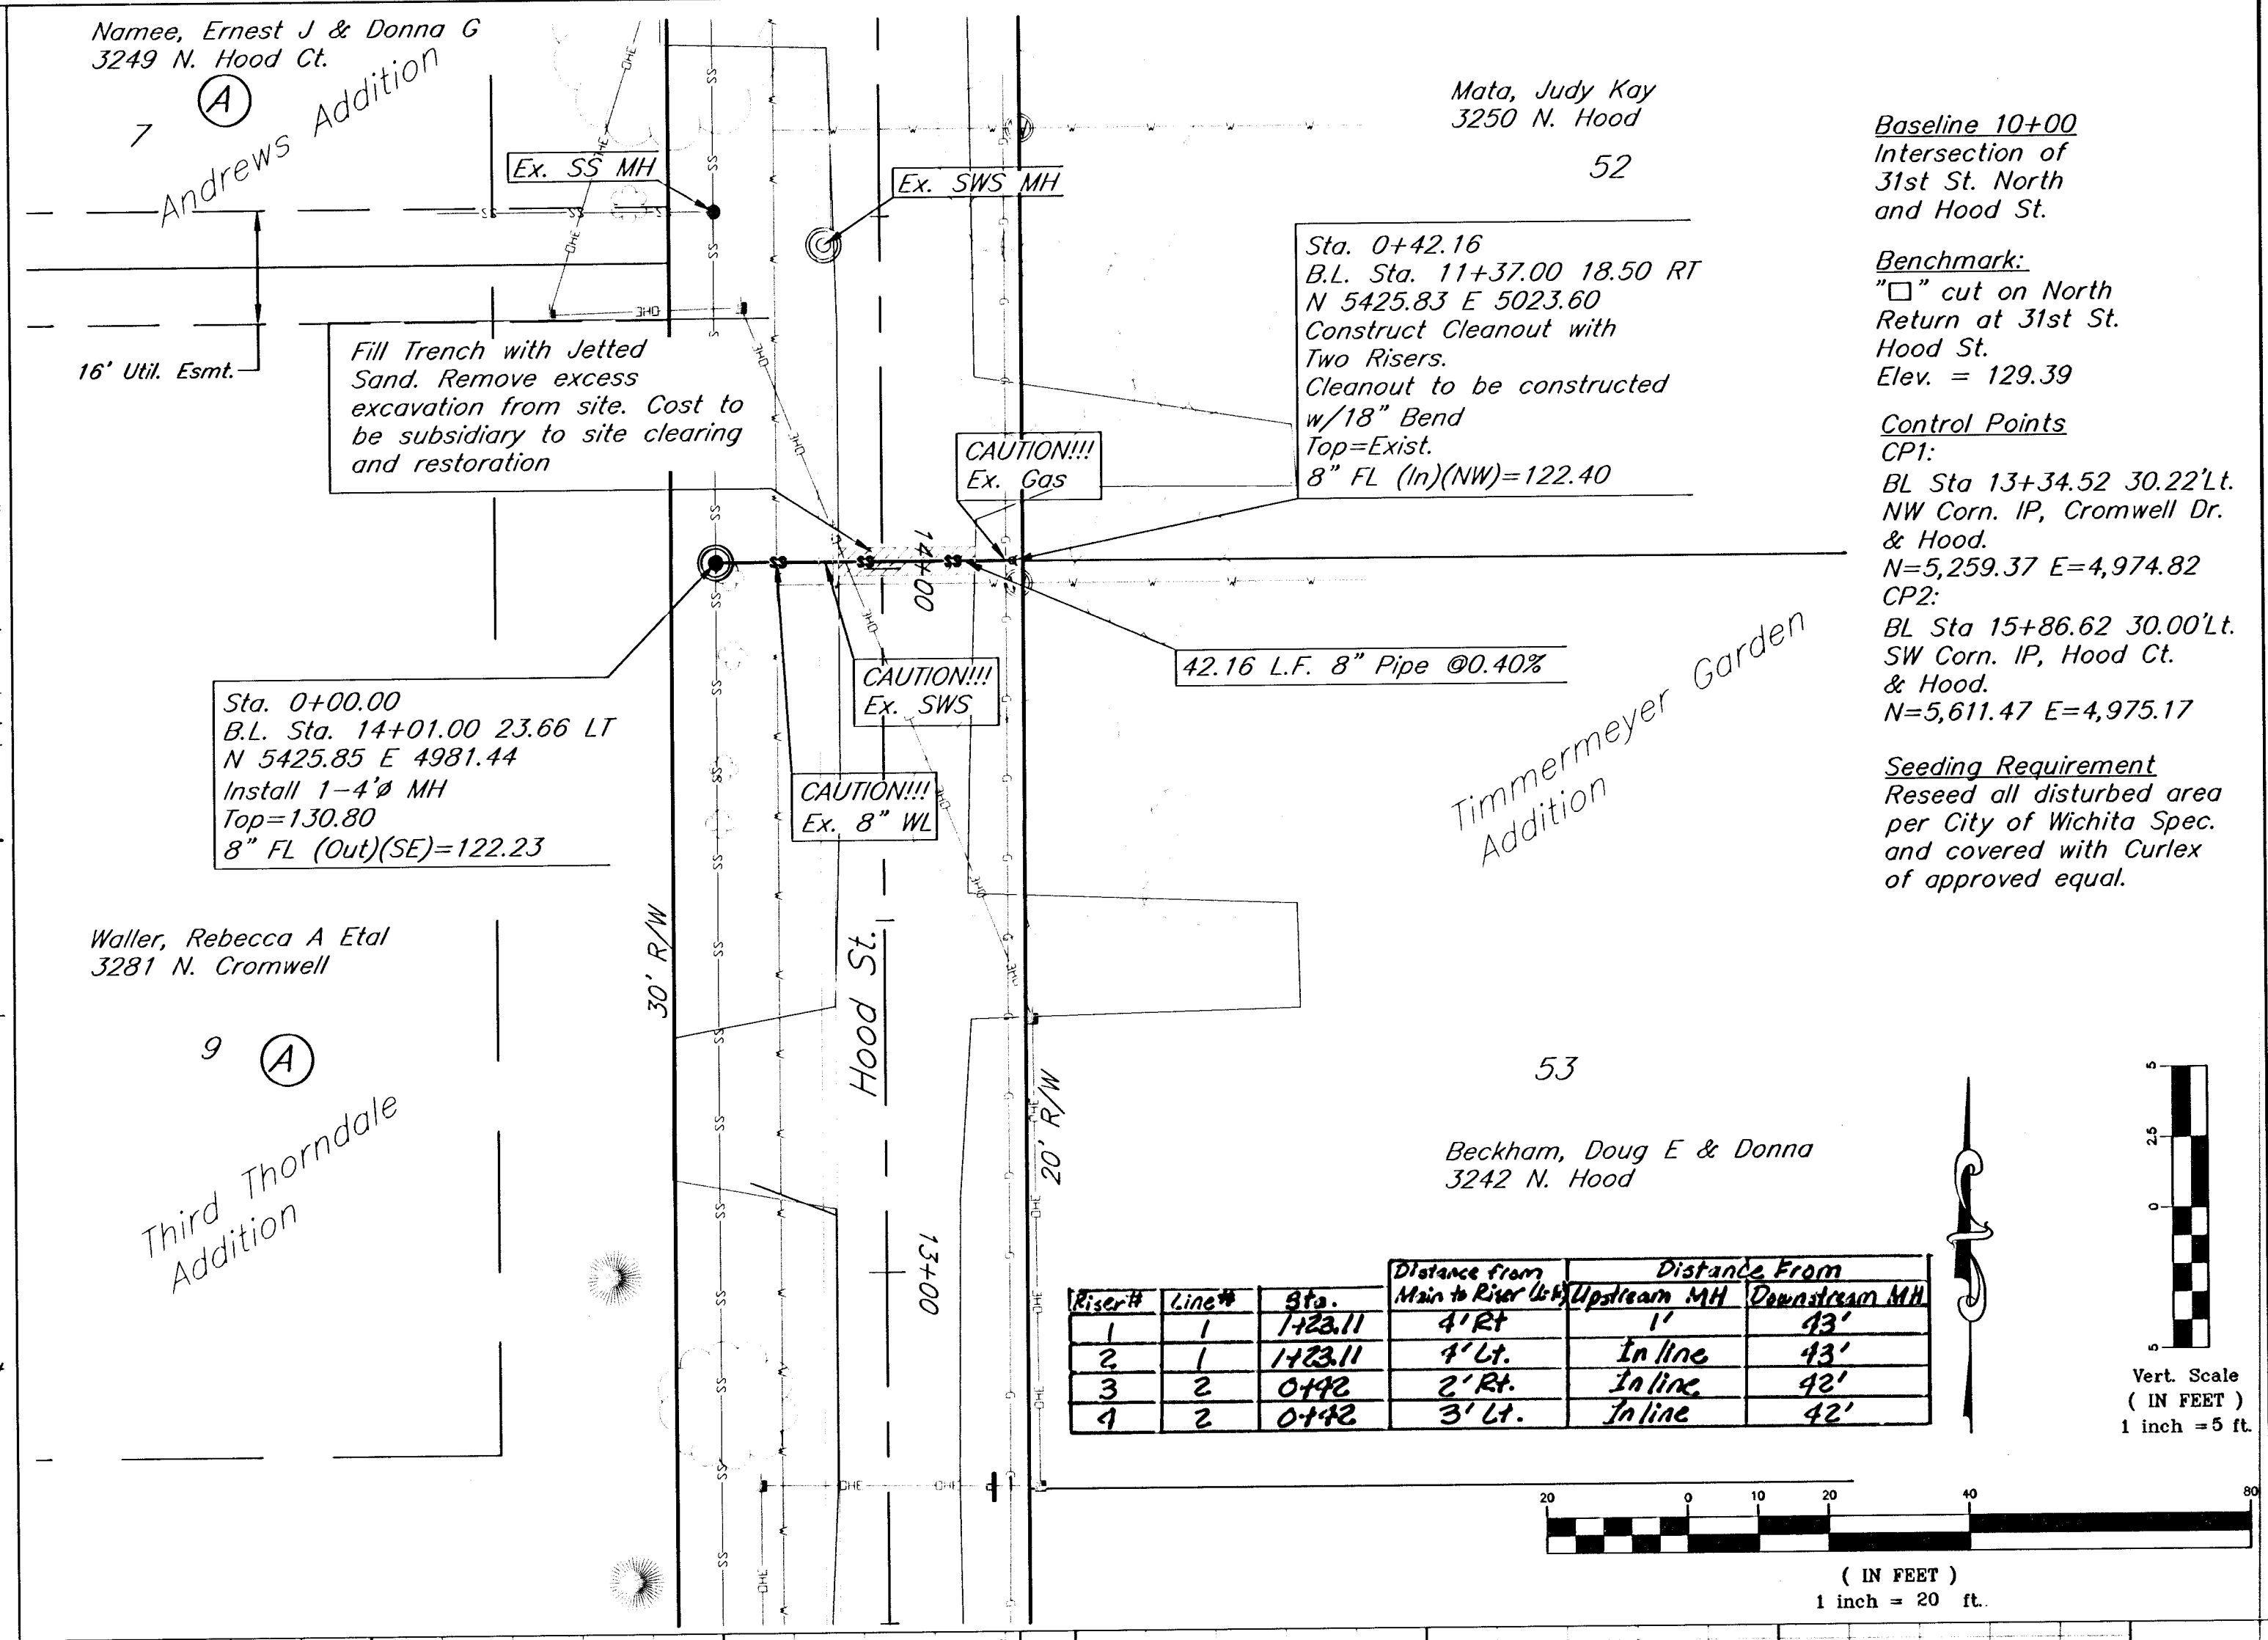


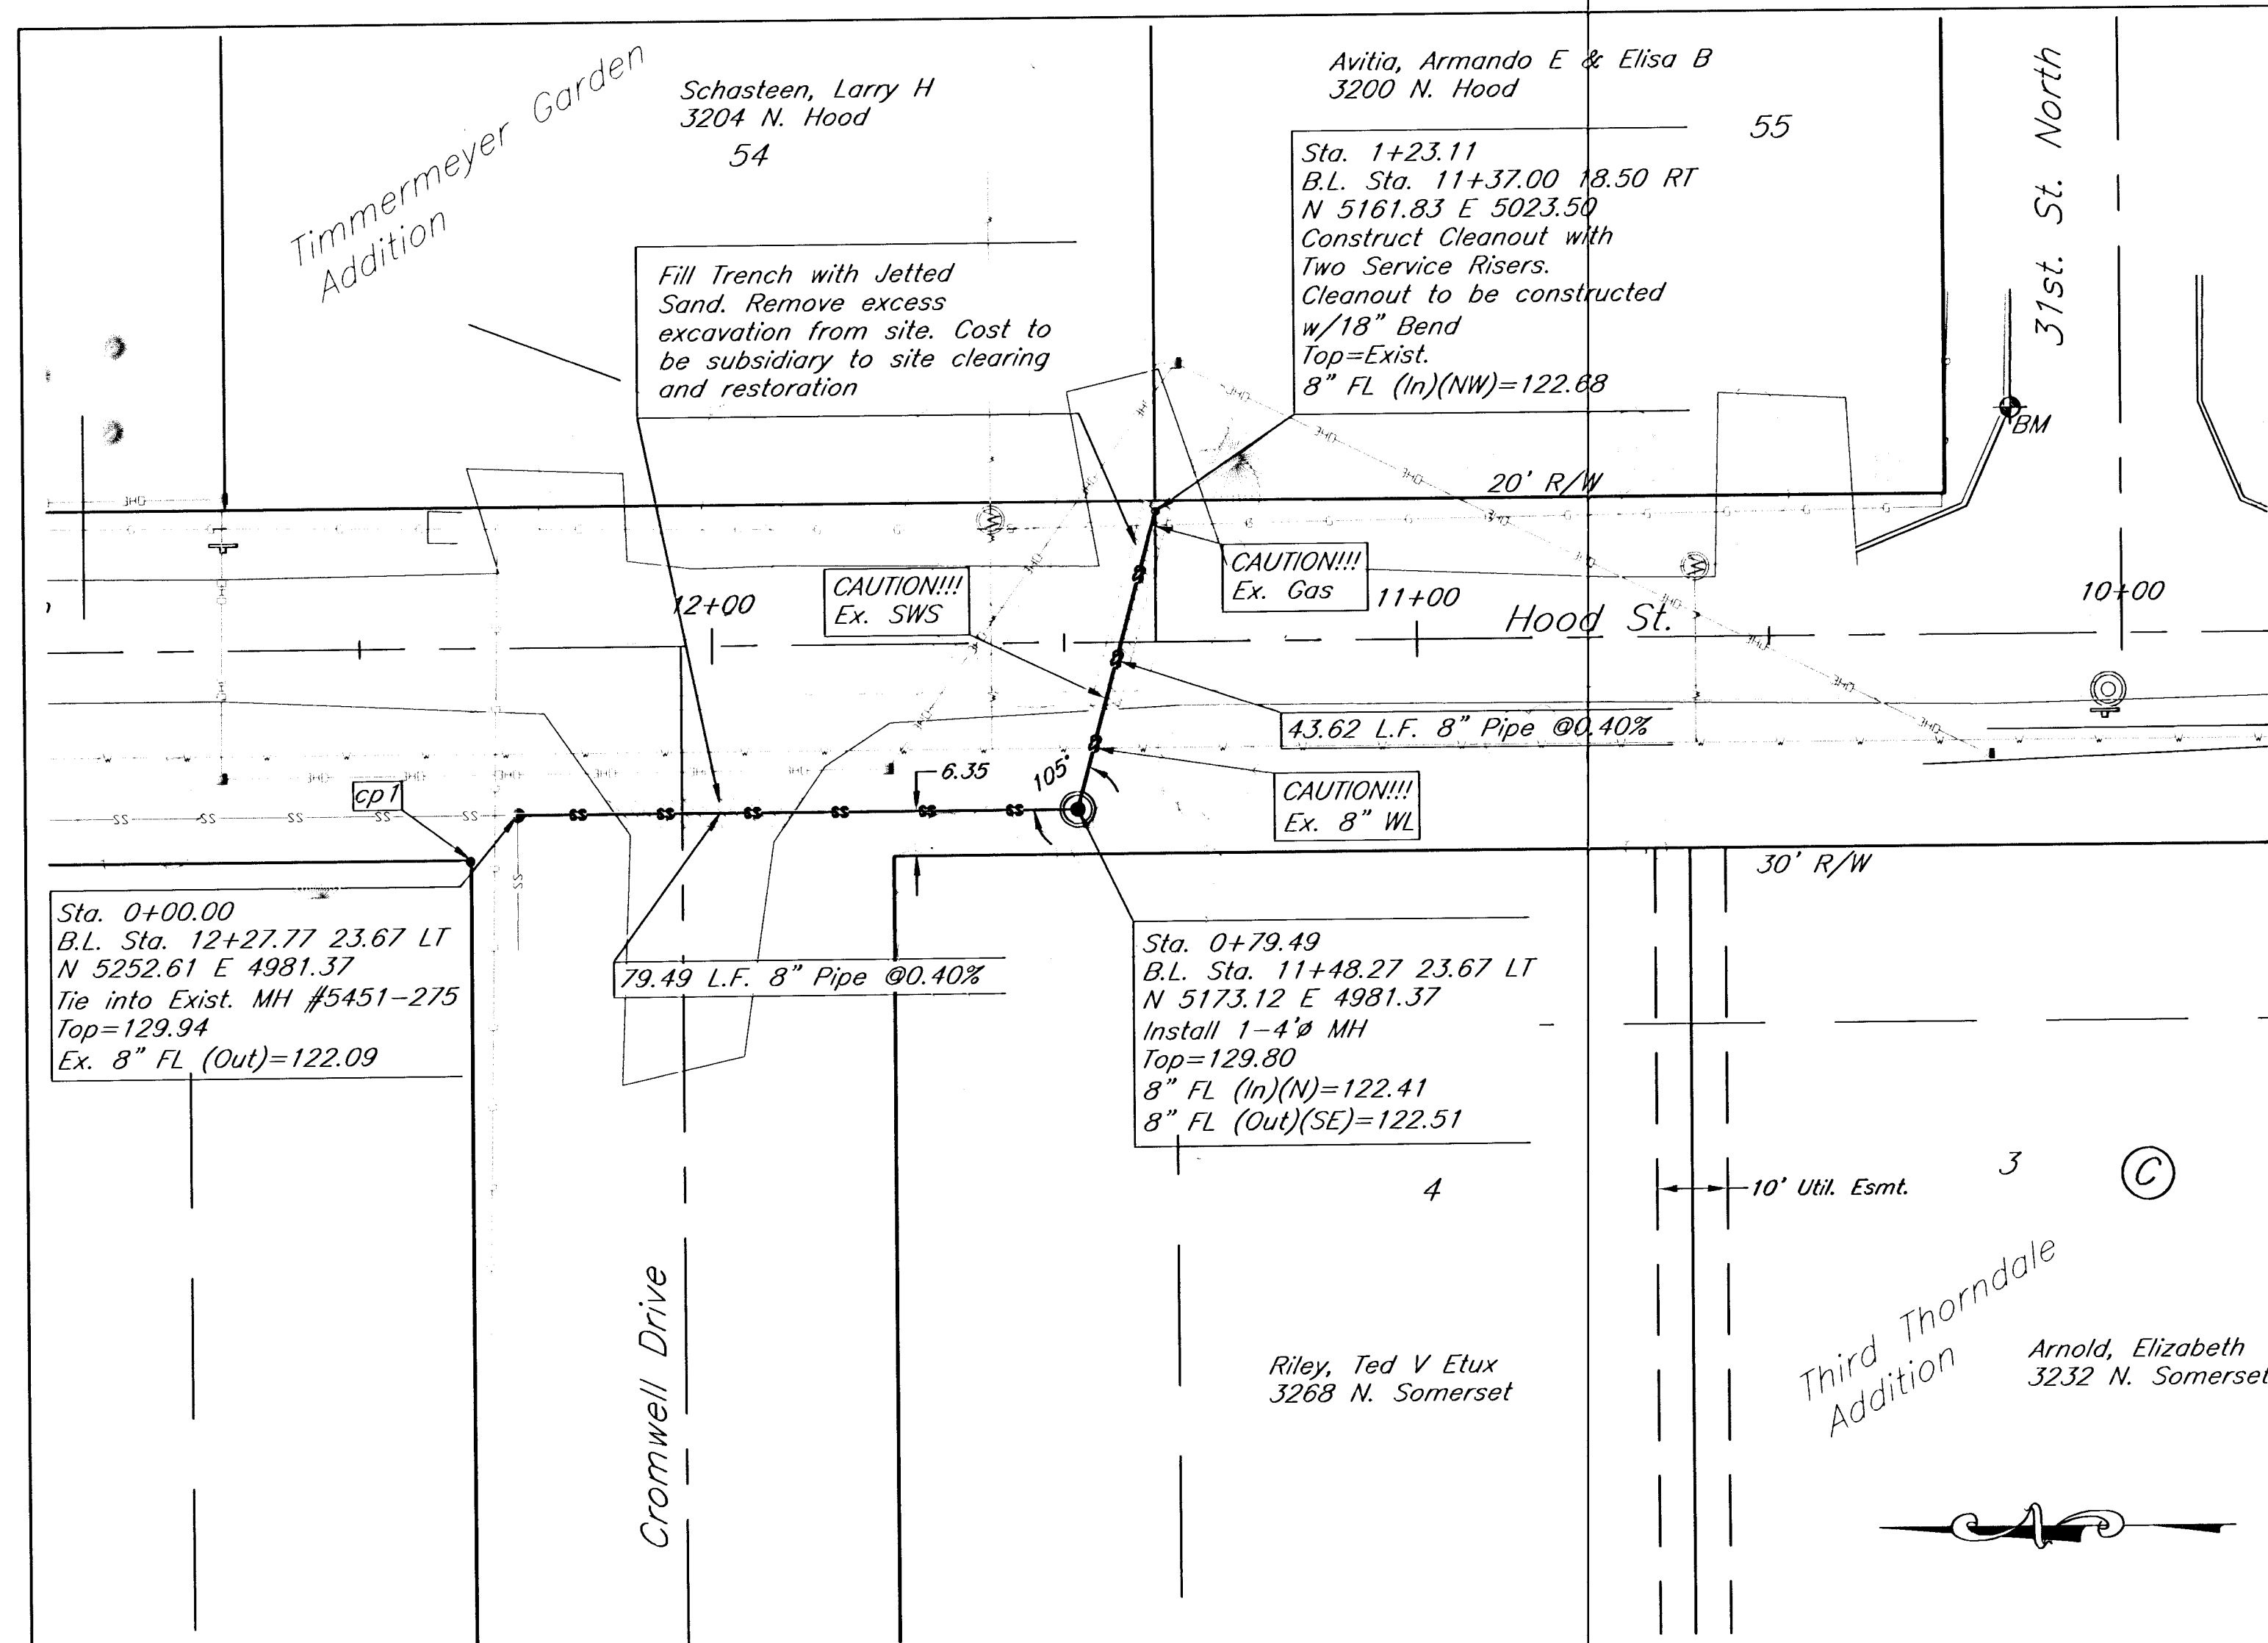

Sanitary Sewer to Serve
Lateral 149 Main 4 Sanitary Sewer # 23
Hood, Between 31st & Hood Ct., Wichita, KS

PROJECT NUMBER
City of Wichita Project # 468 84061

kemiller engineering	KEM NO. 06117	FILE ssline	DATE 9/2005	SHEET 2
	DESIGN PB	DRAWN JO	REVISED 9/19/2006	OF 4

516 S. Market,
Wichita, KS 67202

316/264-0242