



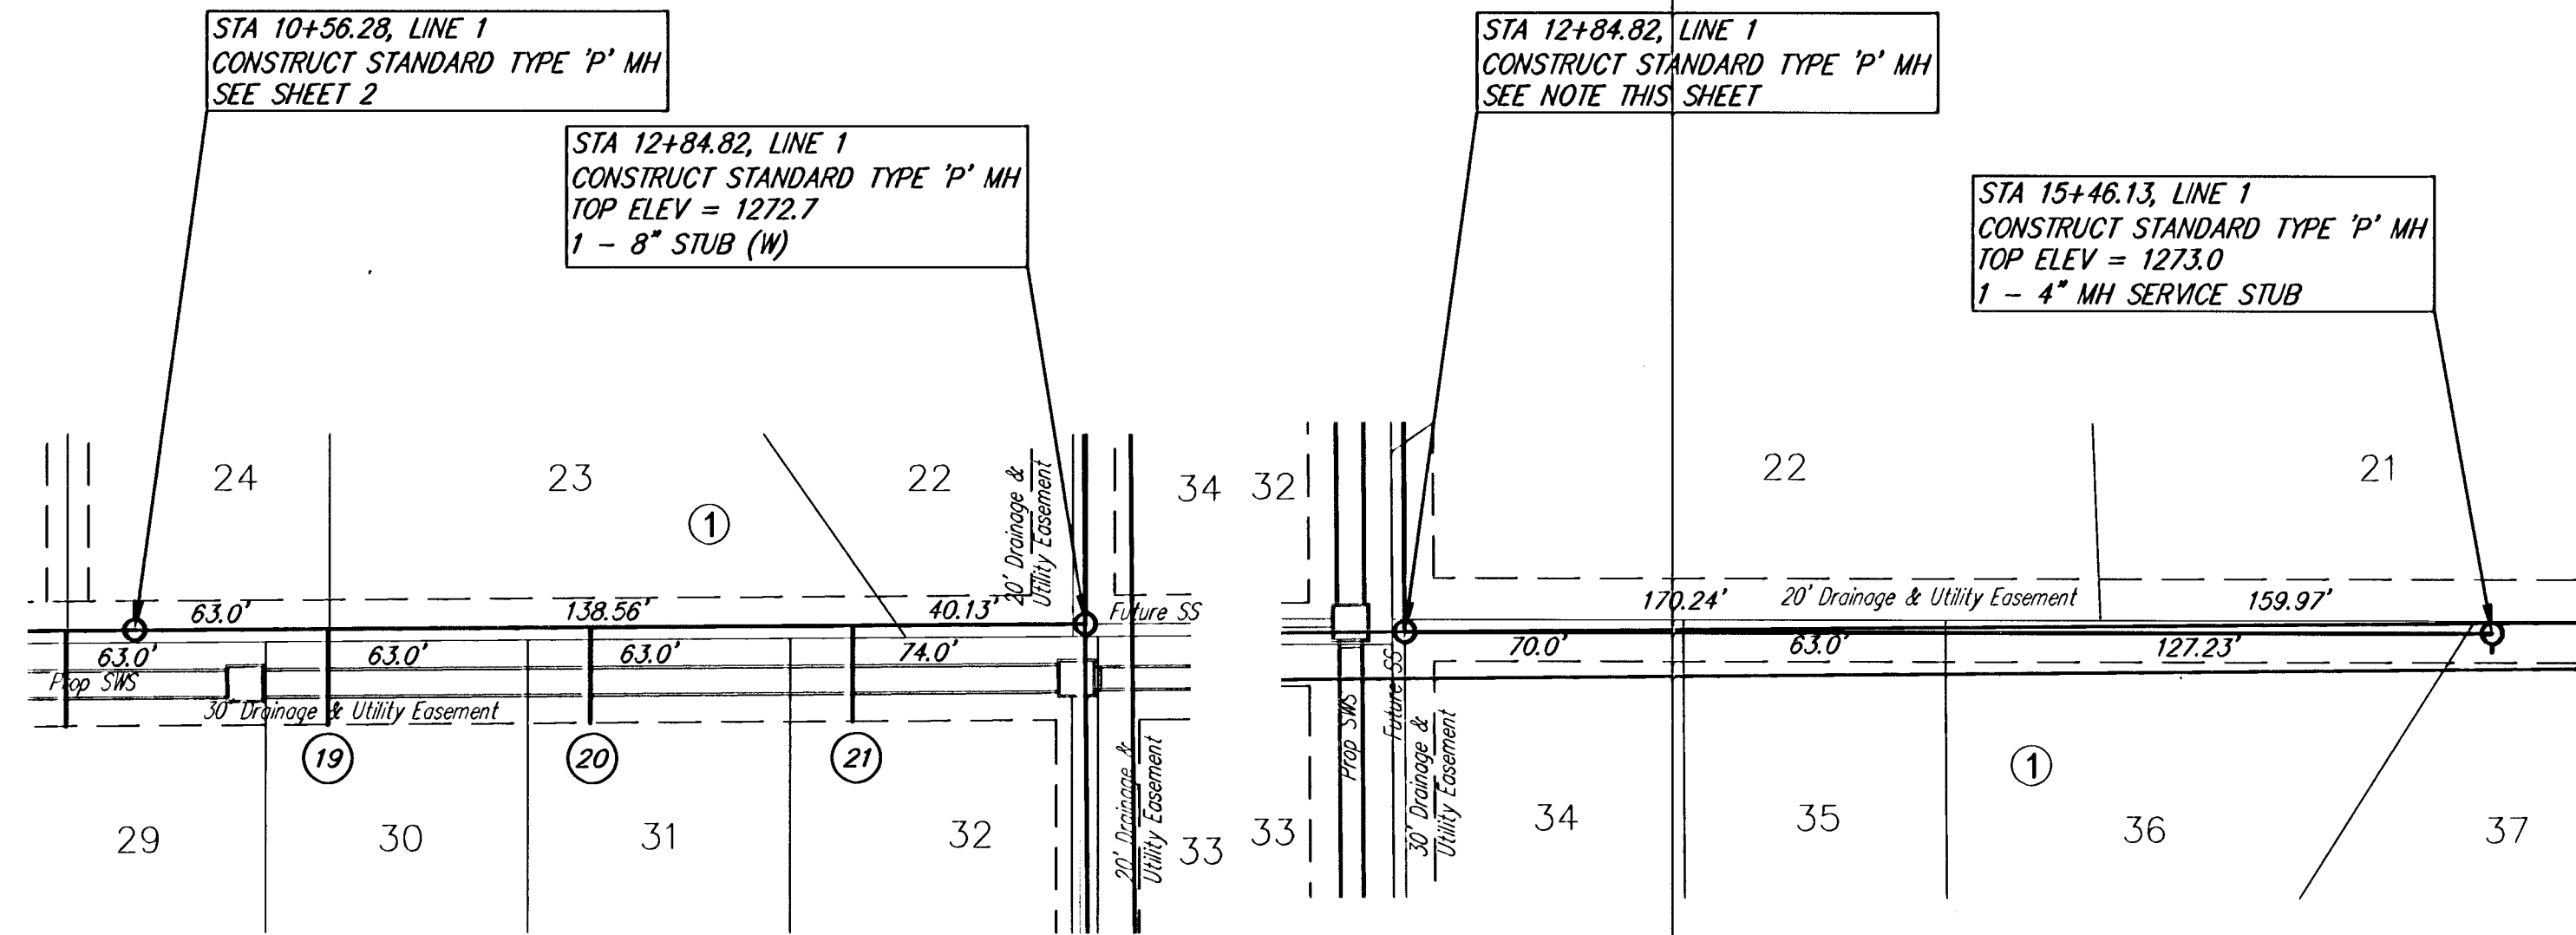

SEWER SERVICE TABLE

NUMBER	TYPE	LOCATION			STATION\ DIRECTION	FOR INFORMATION ONLY	
		LOT NO.	BLOCK NO.	LINE NO.		APPROXIMATE LENGTH 4" PIPE	
19	8" X 4" Tee Saddle	30	1	2	11+02.82/Rt.	7'	23'
20	8" X 4" Tee Saddle	31	1	2	11+65.82/Rt.	7'	23'
21	8" X 4" Tee Saddle	32	1	2	12+28.82/Rt.	7'	23'

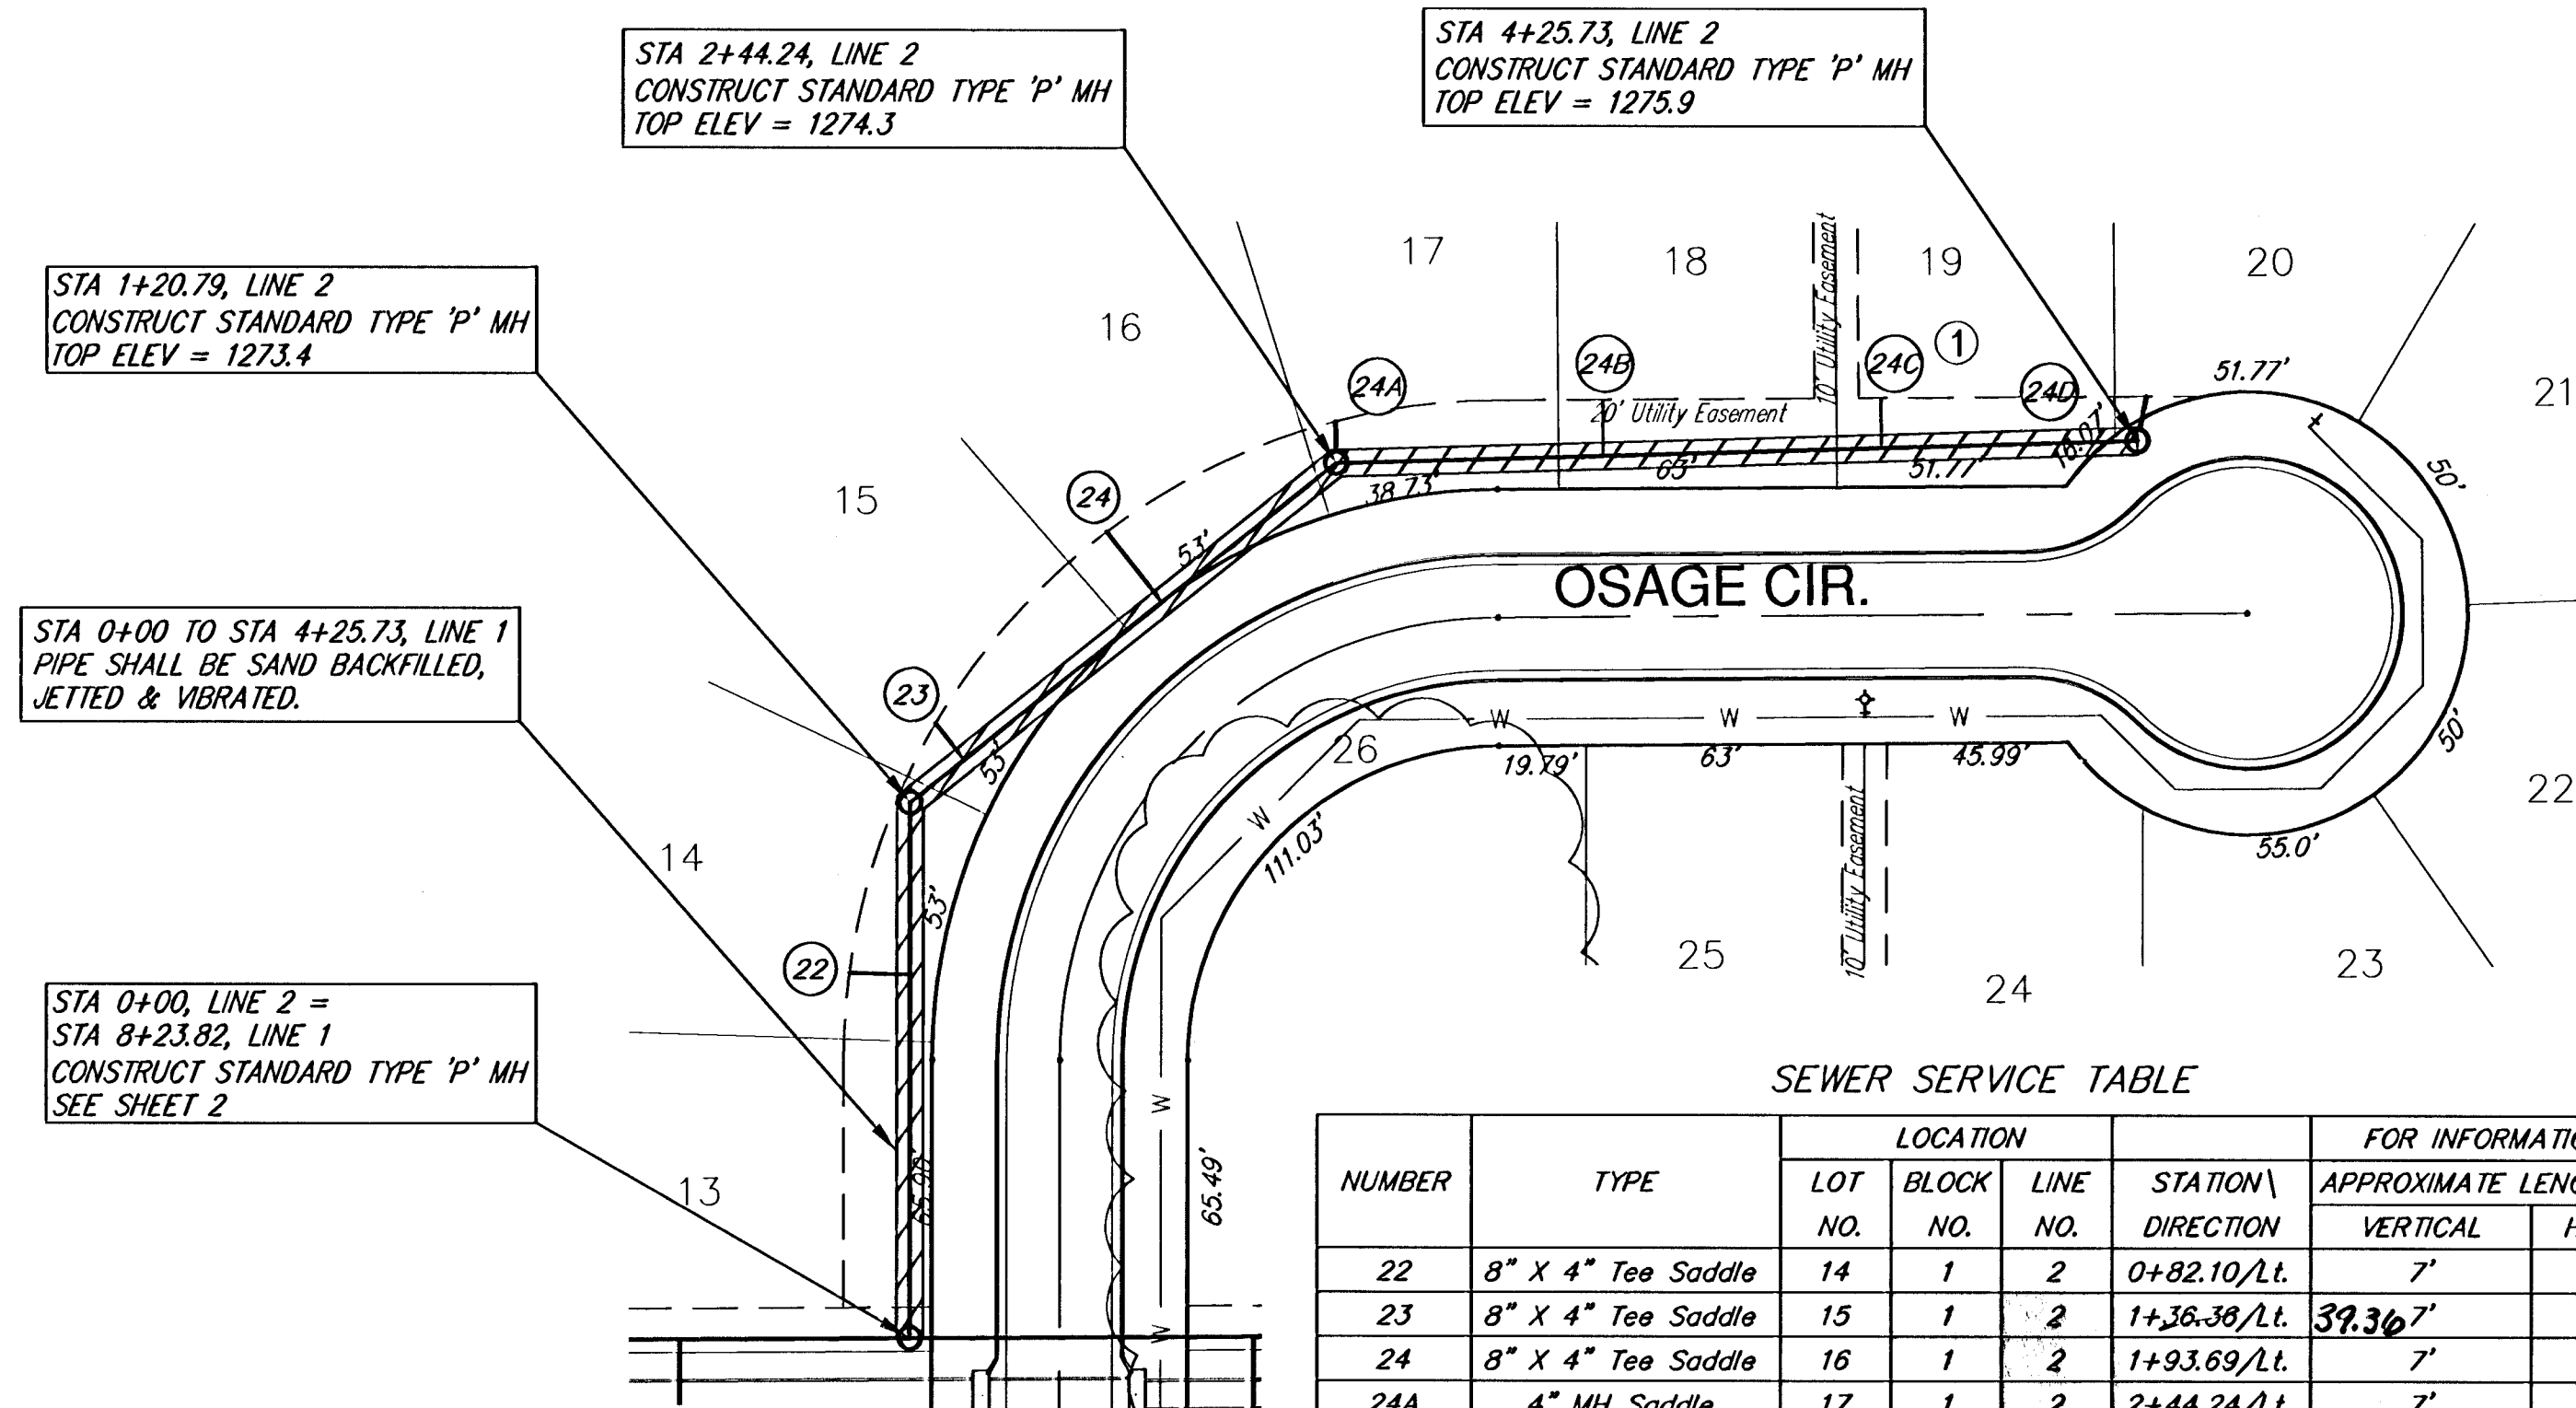

SEWER SERVICE TABLE

NUMBER	TYPE	LOCATION			STATION\ DIRECTION	FOR INFORMATION ONLY	
		LOT NO.	BLOCK NO.	LINE NO.		APPROXIMATE LENGTH 4" PIPE	
22	8" X 4" Tee Saddle	14	1	2	0+82.10/Lt.	7'	18'
23	8" X 4" Tee Saddle	15	1	2	1+38.38/Lt.	39.36'	19'
24	8" X 4" Tee Saddle	16	1	2	1+93.69/Lt.	7'	20'
24A	4" MH Saddle	17	1	2	2+44.24/Lt.	7'	10'
24B	8" X 4" Tee Saddle	18	1	2	3+04.70/Lt.	7'	13'
24C	8" X 4" Tee Saddle	19	1	2	3+67.72/Lt.	7'	12'
24D	4" MH Saddle	20	1	2	4+25.73/Lt.	7'	10'

