


SCALE 1" = 30'
IRON = •

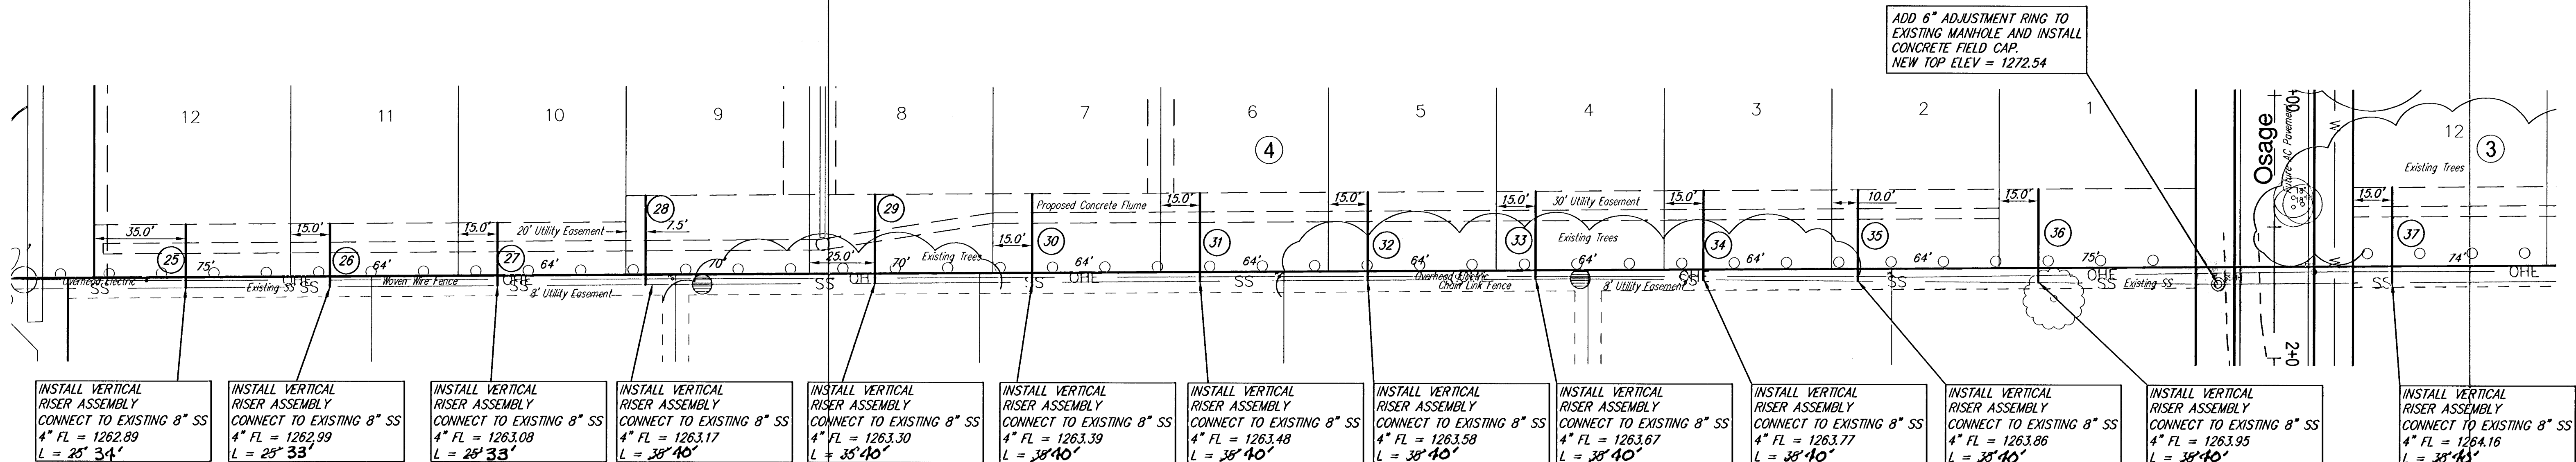

Note: Risers installed on existing SS line (Lat. 21, Main 3, SWI 468-76-246-80328 Book D-287)

SEWER SERVICE TABLE

NUMBER	TYPE	LOCATION			FOR INFORMATION ONLY	
		LOT NO.	BLOCK NO.	LINE NO.	APPROXIMATE LENGTH 4" PIPE	
					VERTICAL	HORIZONTAL
25	8" X 4" Tee Saddle	12	4	1	5'	25' 34'
26	8" X 4" Tee Saddle	11	4	1	5'	25' 33'
27	8" X 4" Tee Saddle	10	4	1	5'	25' 33'
28	8" X 4" Tee Saddle	9	4	1	5'	35' 40'
29	8" X 4" Tee Saddle	8	4	1	5'	35' 40'
30	8" X 4" Tee Saddle	7	4	1	5'	35' 40'
31	8" X 4" Tee Saddle	6	4	1	5'	35' 40'
32	8" X 4" Tee Saddle	5	4	1	5'	35' 40'
33	8" X 4" Tee Saddle	4	4	1	5'	35' 40'
34	8" X 4" Tee Saddle	3	4	1	5'	35' 40'
35	8" X 4" Tee Saddle	2	4	1	5'	35' 40'
36	8" X 4" Tee Saddle	1	4	1	5'	35' 40'
37	8" X 4" Tee Saddle	12	3	1	5'	35' 40'

NOTE: Vertical Riser Pipe shall be extended to 2' minimum above ground water elevation and 4' maximum below proposed ground elevation.

REMOVE TREES AS NECESSARY FOR CONSTRUCTION

Sycamore Pond Addition
SS Line 3
WICHITA, KANSAS

Ruggles & Bohm, P.A.
Engineering, Surveying, Land Planning
924 North Main
Wichita, Kansas 67203
www.rbkansas.com
(316) 264-8008
(316) 264-4621 fax
E-mail: info@rbkansas.com

DESIGN E.J.G.	SHEET 4 OF 13
DRAWN E.J.G.	
REVIEW UTILITY	
DRAWING FILE SS {SS Line 1 (3)}	
PROJECT NUMBER 468-84191	
DATE May 25, 2008	