



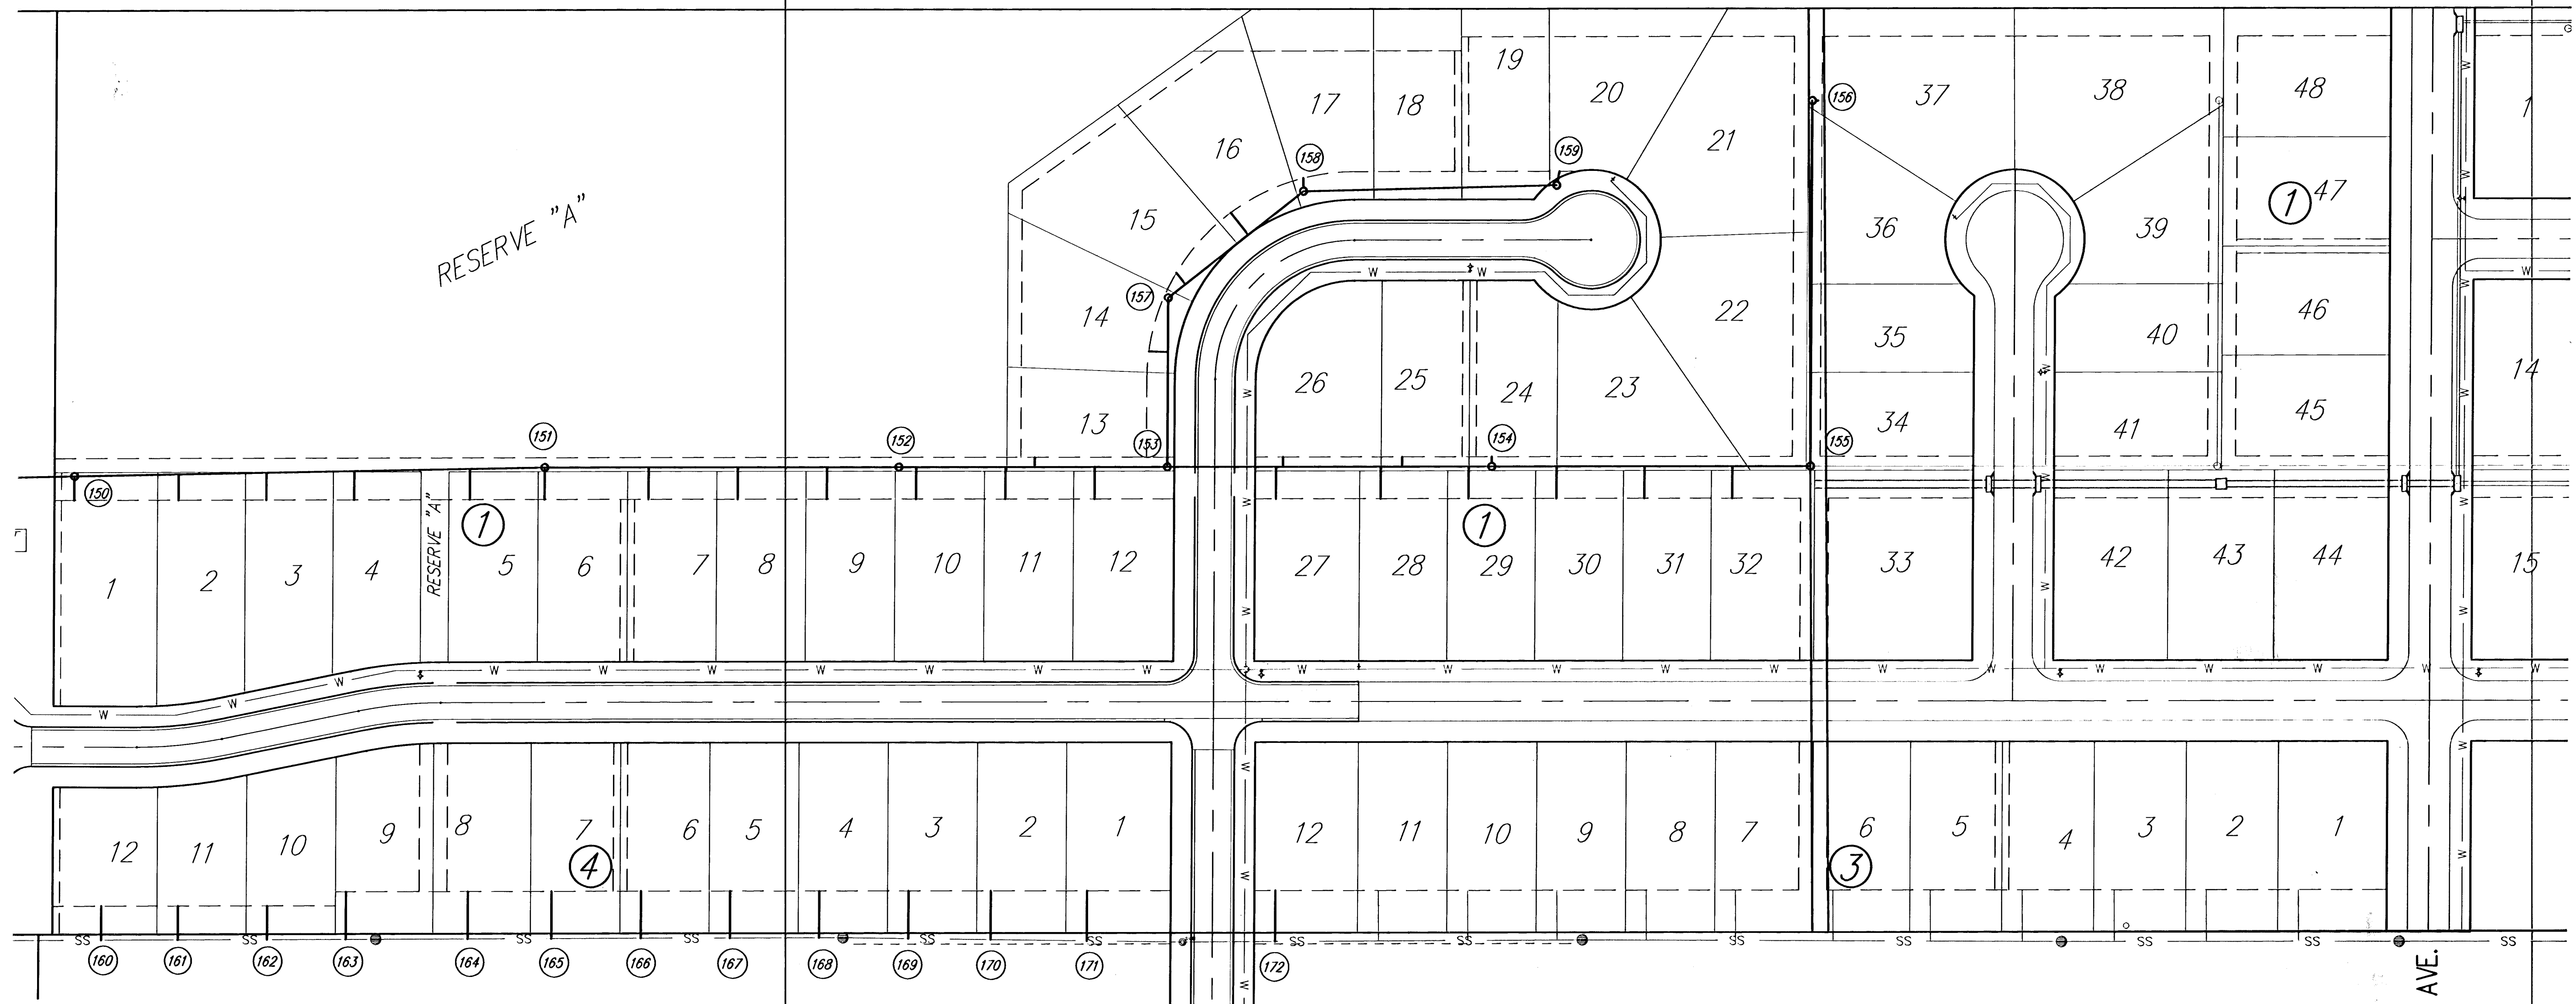

SCALE 1" = 60'

150	N 19985.30	E 18280.31	0+40, LINE 1 MH
151	N 19993.36	E 18617.61	3+77.40, LINE 1 MH
152	N 19995.13	E 18871.34	6+31.33, LINE 1 MH
153	N 19996.47	E 19064.02	8+23.02, LINE 1 MH
154	N 19998.10	E 19296.47	10+56.28, LINE 1 MH
155	N 19999.69	E 19525.01	12+04.02, LINE 1 MH
156	N 20261.00	E 19525.01	15+46.13, LINE 1 MH
157	N 20117.26	E 19064.02	1+20.79, LINE 2 MH
158	N 20194.19	E 19160.57	2+44.74, LINE 2 MH
159	N 20199.41	E 19341.99	4+25.73, LINE 2 MH
160	N 19653.79	E 18301.04	Sewer Riser, L12, B4
161	N 19654.24	E 18356.04	Sewer Riser, L11, B4
162	N 19654.76	E 18420.04	Sewer Riser, L10, B4
163	N 19655.22	E 18476.53	Sewer Riser, L9, B4
164	N 19655.96	E 18504.03	Sewer Riser, L8, B4
165	N 19656.47	E 18624.03	Sewer Riser, L7, B4
166	N 19657.02	E 18698.03	Sewer Riser, L6, B4
167	N 19657.57	E 18752.03	Sewer Riser, L5, B4
168	N 19658.12	E 18816.03	Sewer Riser, L4, B4
169	N 19657.98	E 18880.03	Sewer Riser, L3, B4
170	N 19657.62	E 18939.02	Sewer Riser, L2, B4
171	N 19657.20	E 19008.02	Sewer Riser, L1, B4
172	N 19657.50	E 19143.02	Sewer Riser, L12, B3

Sycamore Pond Addition
Sanitary Sewer Bubble Map
WICHITA, KANSAS

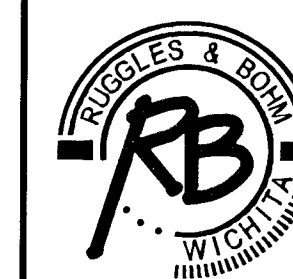

Ruggles & Bohm, P.A.
Engineering, Surveying, Land Planning
924 North Main
Wichita, Kansas 67203
www.rbkansas.com
(316) 284-8008
(316) 284-4621 fax
E-mail: info@rbkansas.com

DRAWING FILE
SS [Sanitary Sewer Bubble Map]

PROJECT NUMBER
468-84191

DESIGN
EJG
DRAWN
EJG
REVIEW
EJG
UTILITY
DATE
May 25, 2008

SHEET
12
OF
13