BENCHMARK:
Arkansas River bridge & 63rd St. S. City of Wichita Benchmark Disc. SW Cor. of bridge, top of hubguard. 500'± E. of Grove.
Elev. = 1269.95 NGVD29 (per City record)

Brass plate on the NE wingwall of Arkansas River bridge & 63rd St. S.
Elev. = 1267.48 NGVD29 (per County record)

SEWER SERVICE TABLE

NUMBER	TYPE	LOCATION LOT NO.	BLOCK NO.	LINE NO.	STATION/ DIRECTION	FOR INFORMATION ONLY APPROXIMATE LENGTH 4" PIPE VERTICAL		HORIZONTAL
52	12" X 4" Tee Saddle	30	A	1	0+60/Lt.		11.5'	7'
51	8" X 4" Tee Saddle	29	A	1	1+34/Lt.	35	11.5'	5'
1	8" X 4" Tee Saddle	28	A	1	2+37/Lt.	12	11'	5'
2	8" X 4" Tee Saddle	27	A	1	2+97/Lt.	99	11'	5'
3	8" X 4" Tee Saddle	26	A	1	3+82/Lt.		11'	5'
4	8" X 4" Tee Saddle	25	A	1	4+87/Lt.	70	11'	5'
5	8" X 4" Tee Saddle	24	A	1	5+52/Lt.	52.5	10.5'	5'
6	8" X 4" Tee Saddle	23	A	1	6+37/Lt.	38	9.5'	5'
7	8" X 4" Tee Saddle	22	A	1	7+22/Lt.		9'	5'

NOTE: Vertical Riser Pipe shall be extended to 2' minimum above ground water elevation and 4' maximum below proposed ground elevation.

SCALE:
1" = 40' HORIZONTAL
1" = 5' VERTICAL
• = IRON

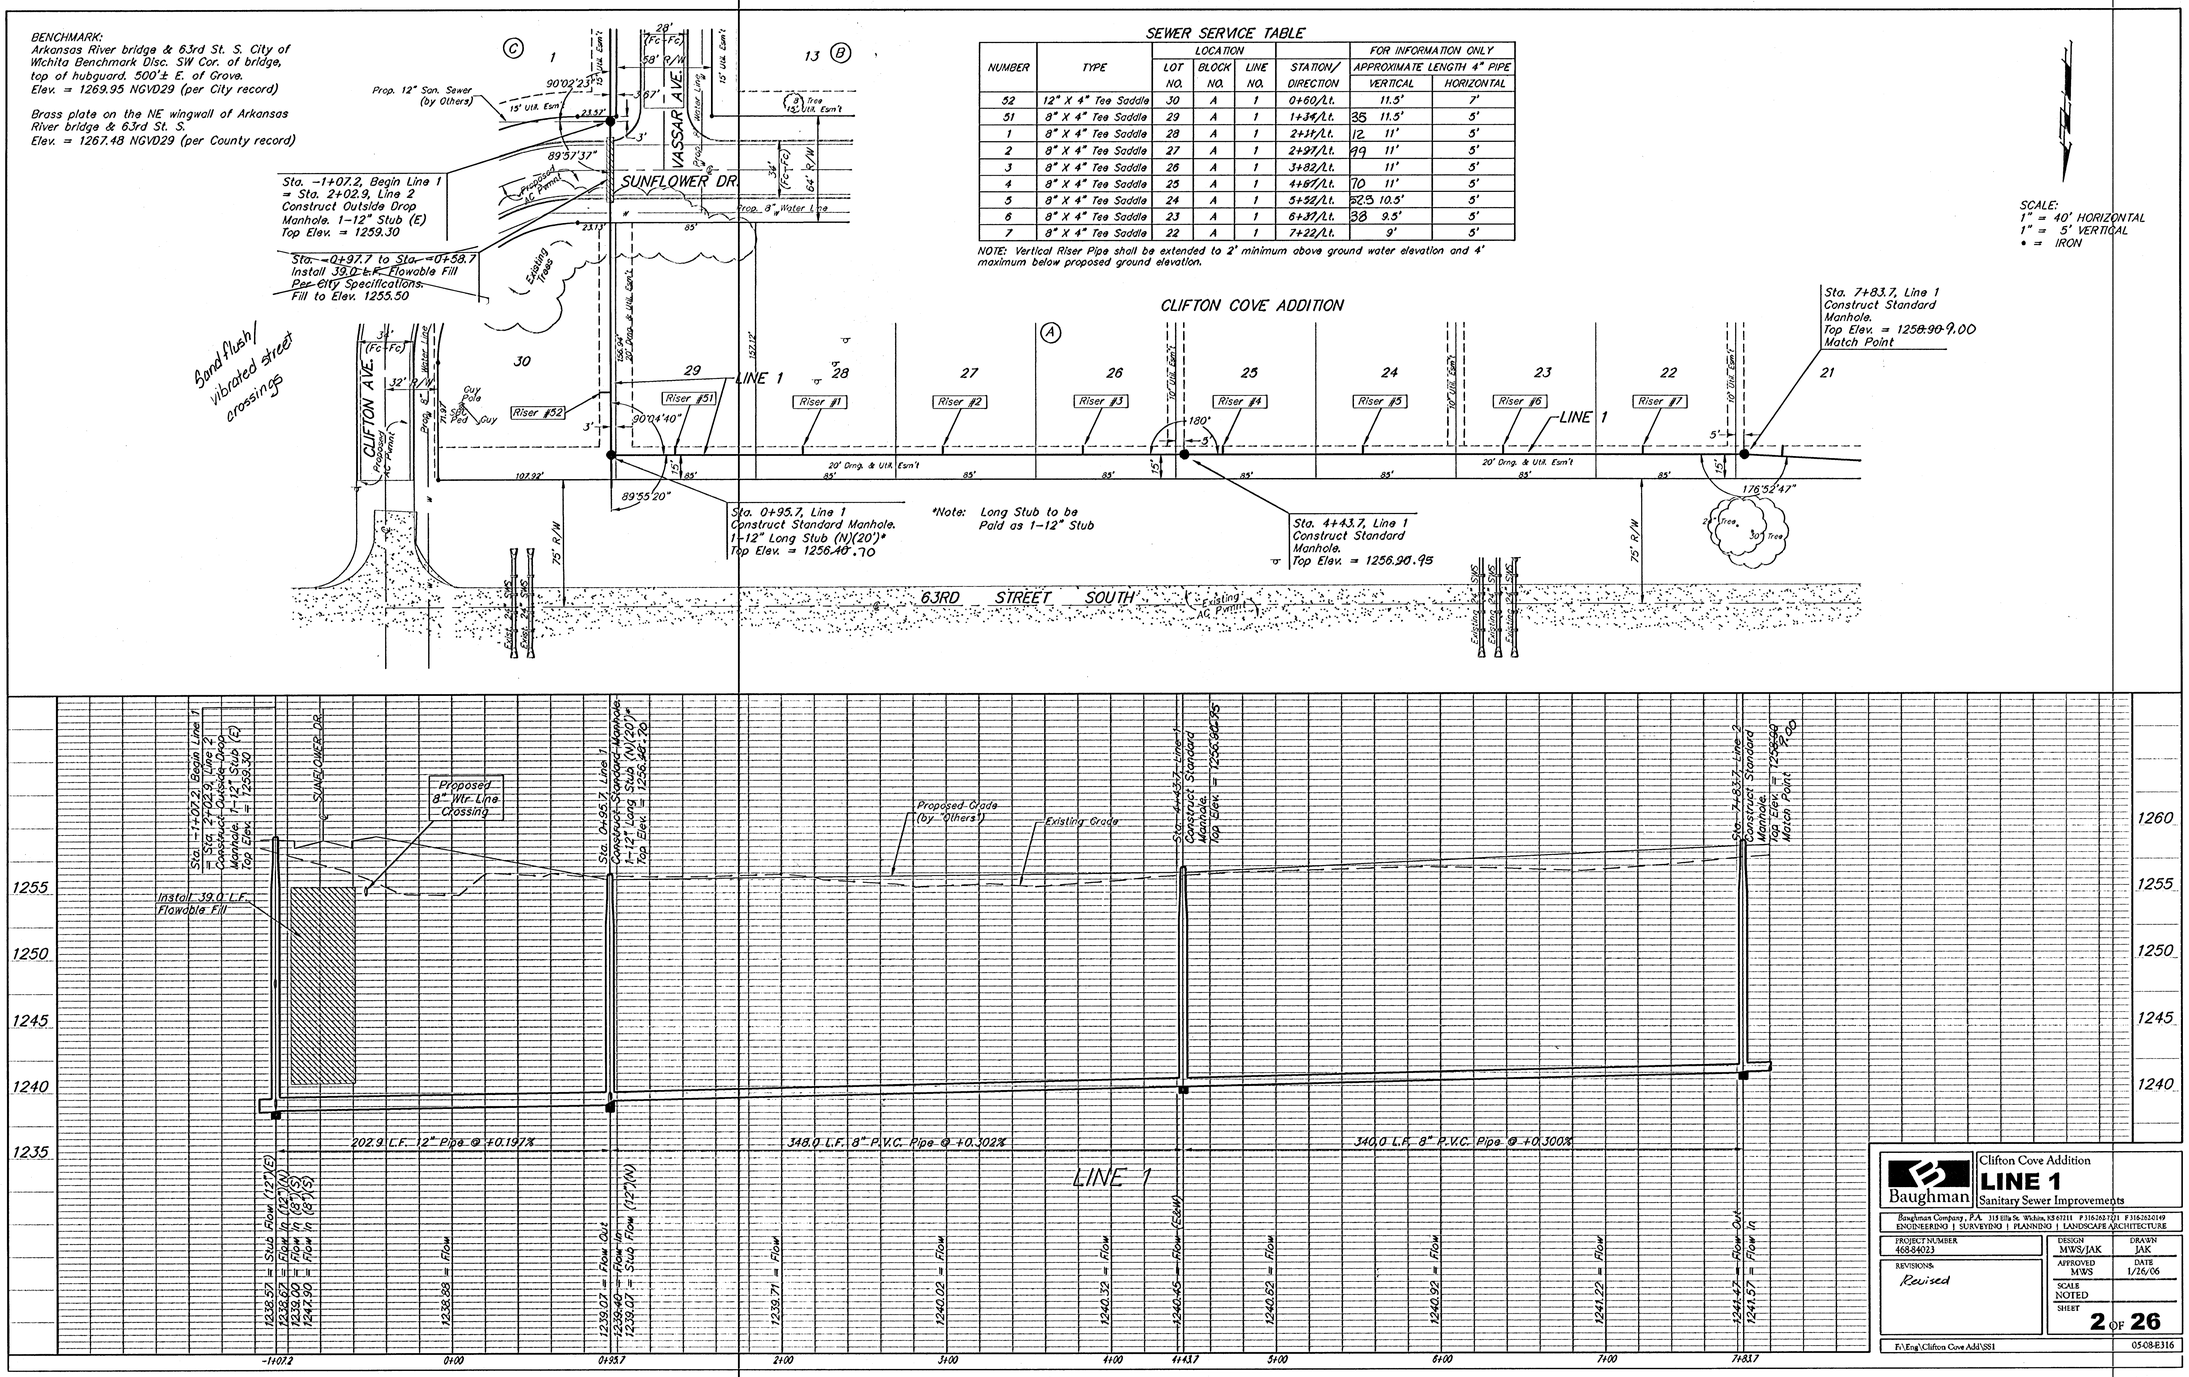

Baughman
Clifton Cove Addition
LINE 1
Sanitary Sewer Improvements

Baughman Company, P.A. 315 Ellis St. Wichita, KS 67211 P 316.263.7221 F 316.263.6149
ENGINEERING | SURVEYING | PLANNING | LANDSCAPE ARCHITECTURE

PROJECT NUMBER 468-84023	DESIGN MWS/JAK	DRAWN JAK
REVISIONS: Revised	APPROVED MWS	DATE 1/26/06
	SCALE NOTED	
	SHEET 2 OF 26	

F:\Eng\Clifton Cove Add\SS1 05-08-E316