


BENCHMARK:
Arkansas River bridge & 63rd St. S. City of
Wichita Benchmark Disc. SW Cor. of bridge,
top of hubguard. 500'± E. of Grove.
Elev. = 1269.95 NGVD29 (per City record)


Brass plate on the NE wingwall of Arkansas
River bridge & 63rd St. S.
Elev. = 1267.48 NGVD29 (per County record)

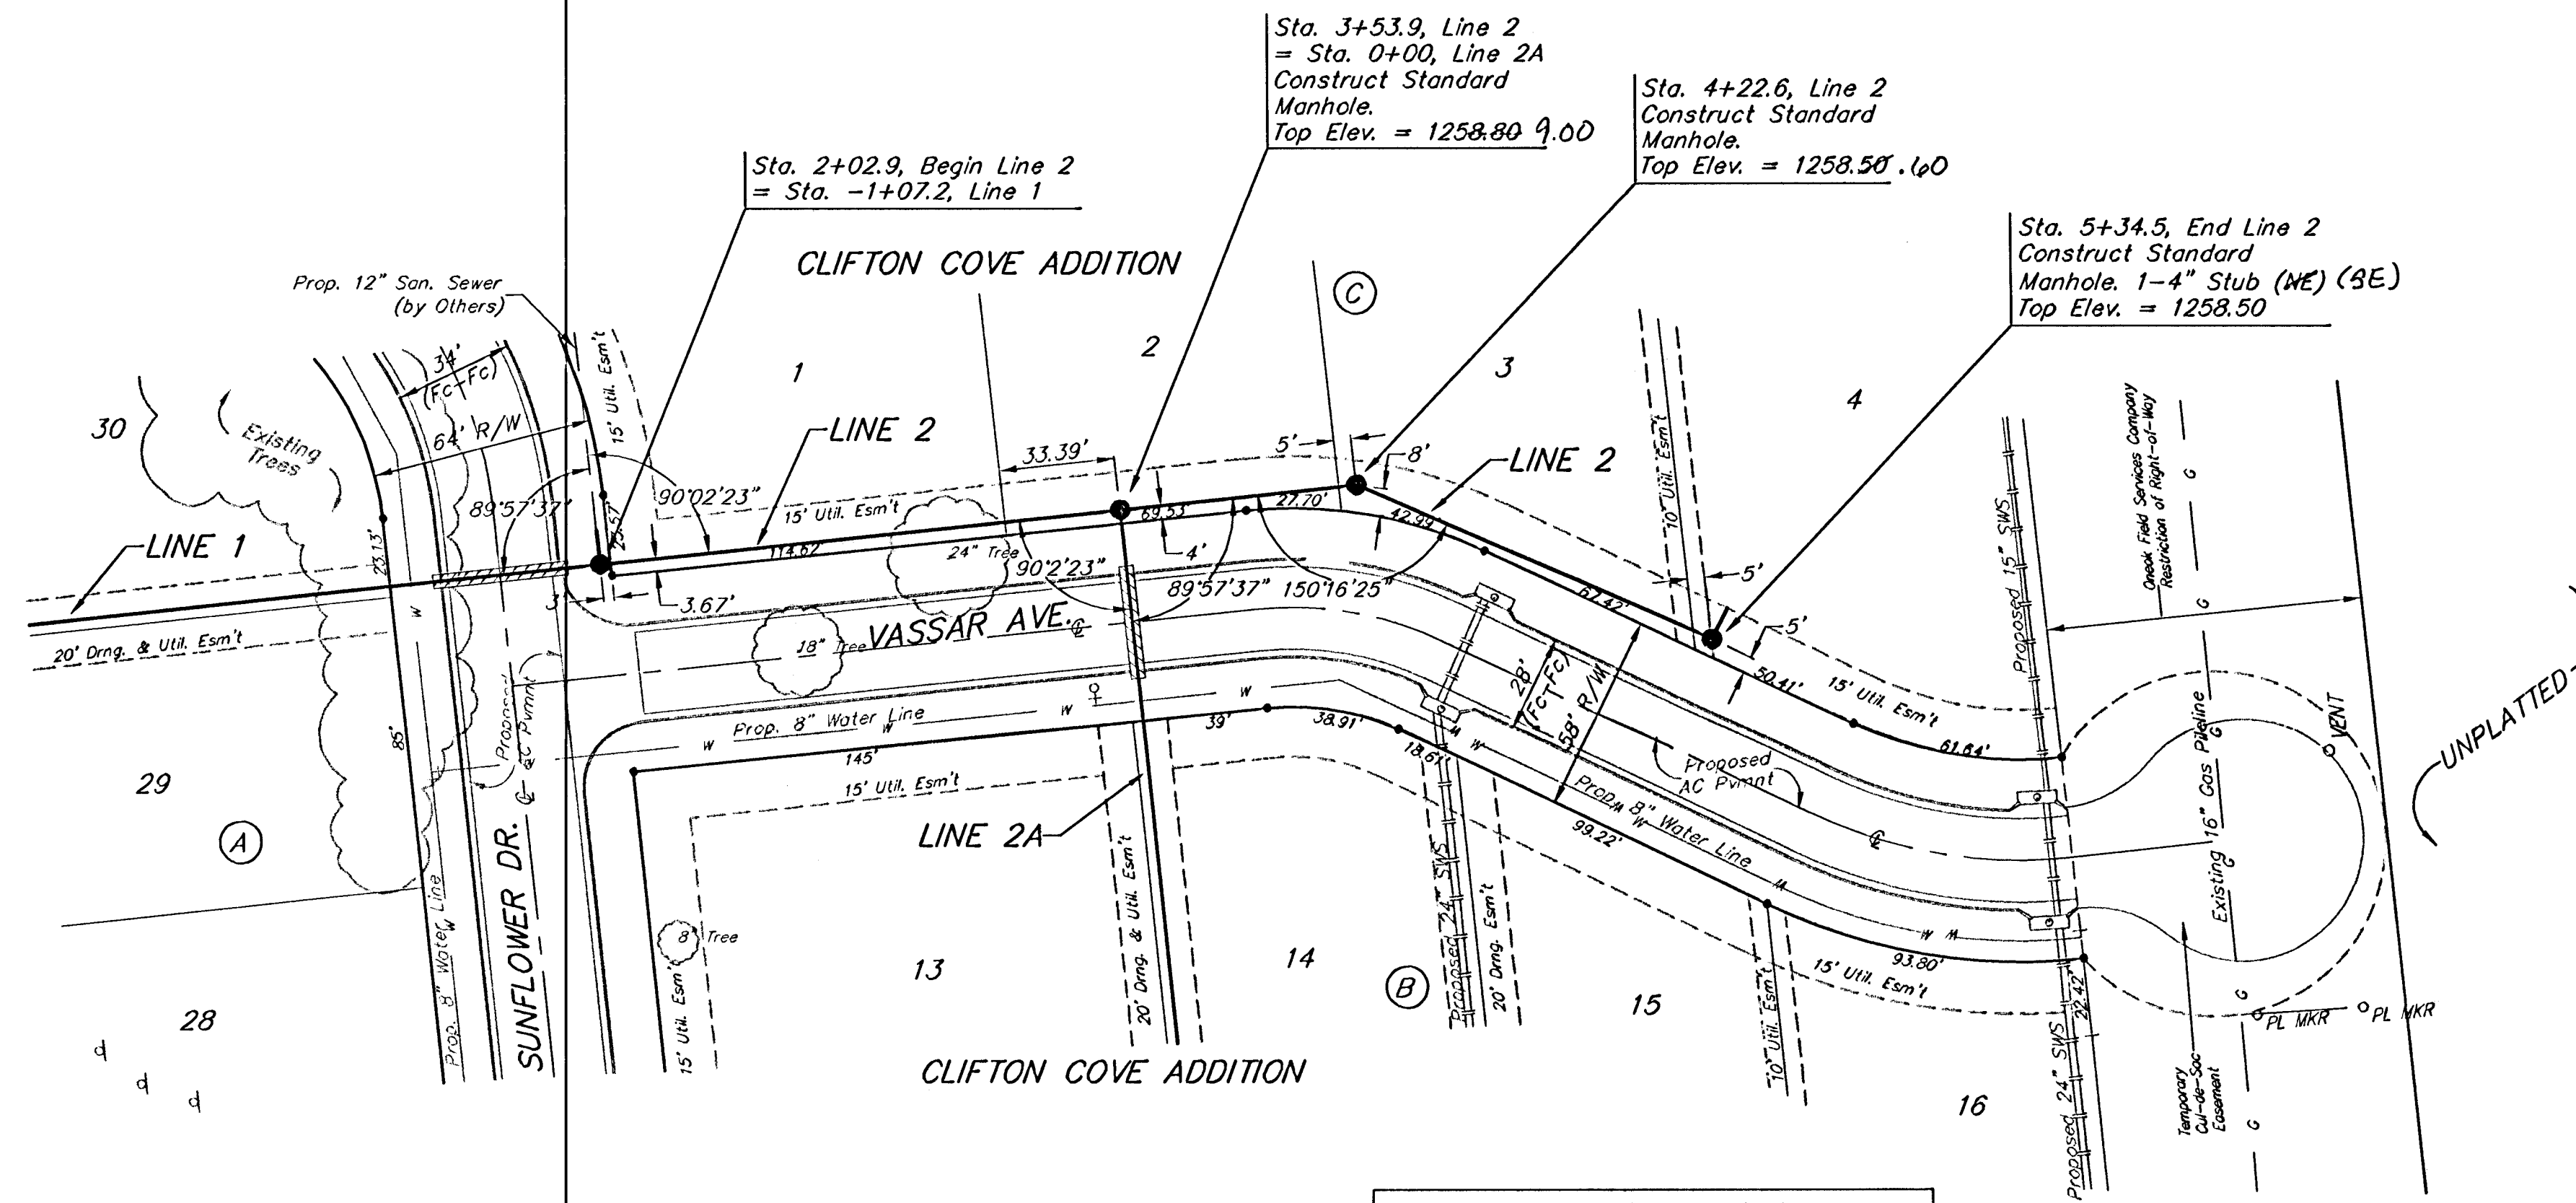

The Contractor shall be required to
backfill trench with sand from Sta. 2+02.9
to Sta. 5+34.5, Line 2. To be bid as
"L.F. Sand Backfill Jetted and Vibrated"



SCALE:
1" = 40' HORIZONTAL
1" = 5' VERTICAL
• = IRON

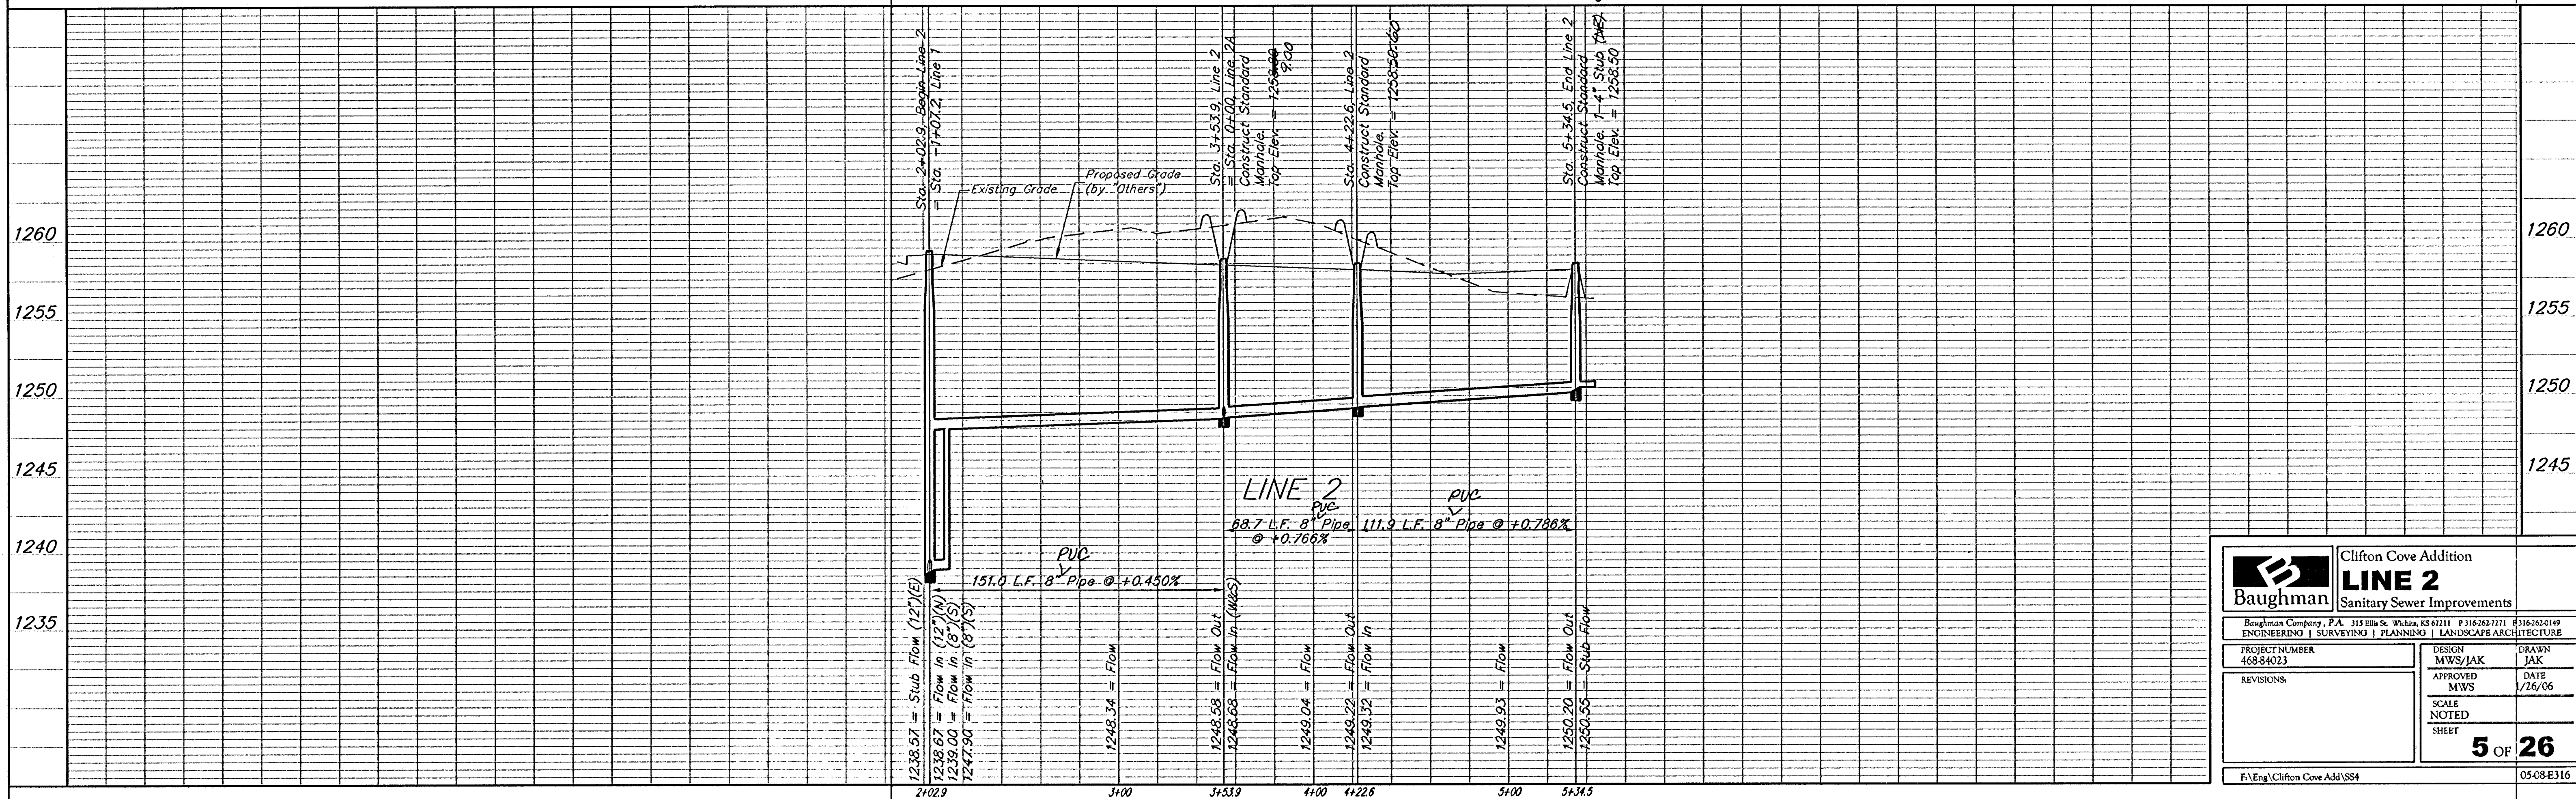

Baughman		Clifton Cove Addition	
LINE 2		Sanitary Sewer Improvements	
Baughman Company, P.A. 315 Ellis St. Wichita, KS 67211 P:316-262-7771 F:316-262-0149			
ENGINEERING SURVEYING PLANNING LANDSCAPE ARCHITECTURE			
PROJECT NUMBER 468-84023	DESIGN MWS/JAK	DRAWN JAK	
APPROVED MWS	DATE 1/26/06		
SCALE NOTED SHEET			
5 OF 26			
F:\Eng\Clifton Cove Add\SS4		05-08-E316	