
BENCHMARK:
Arkansas River bridge & 63rd St. S. City of Wichita Benchmark Disc. SW Cor. of bridge, top of hubguard. 500'± E. of Grove.
Elev. = 1269.95 NGVD29 (per City record)

Brass plate on the NE wingwall of Arkansas River bridge & 63rd St. S.
Elev. = 1267.48 NGVD29 (per County record)

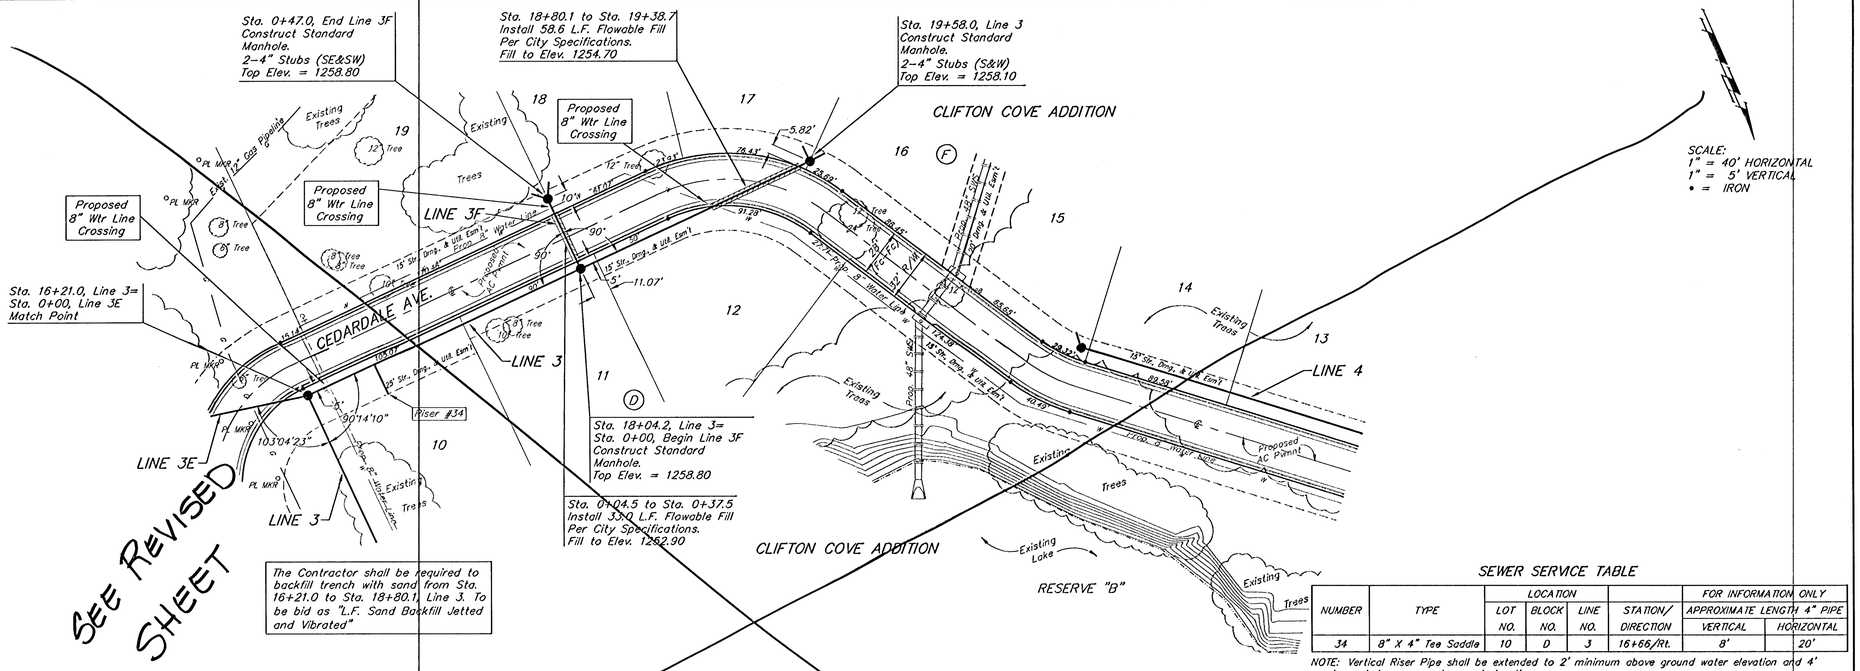


See Revised Sheet

The Contractor shall be required to backfill trench with sand from Sta. 16+21.0 to Sta. 18+80.1, Line 3. To be bid as "L.F. Sand Backfill Jetted and Vibrated"

SEWER SERVICE TABLE

NUMBER	TYPE	LOCATION			STATION/ DIRECTION	FOR INFORMATION ONLY	
		LOT NO.	BLOCK NO.	LINE NO.		APPROXIMATE LENGTH 4" PIPE VERTICAL	HORIZONTAL
34	8" X 4" Tee Saddle	10	D	3	16+66/Rt.	8'	20'

NOTE: Vertical Riser Pipe shall be extended to 2' minimum above ground water elevation and 4' maximum below proposed ground elevation.

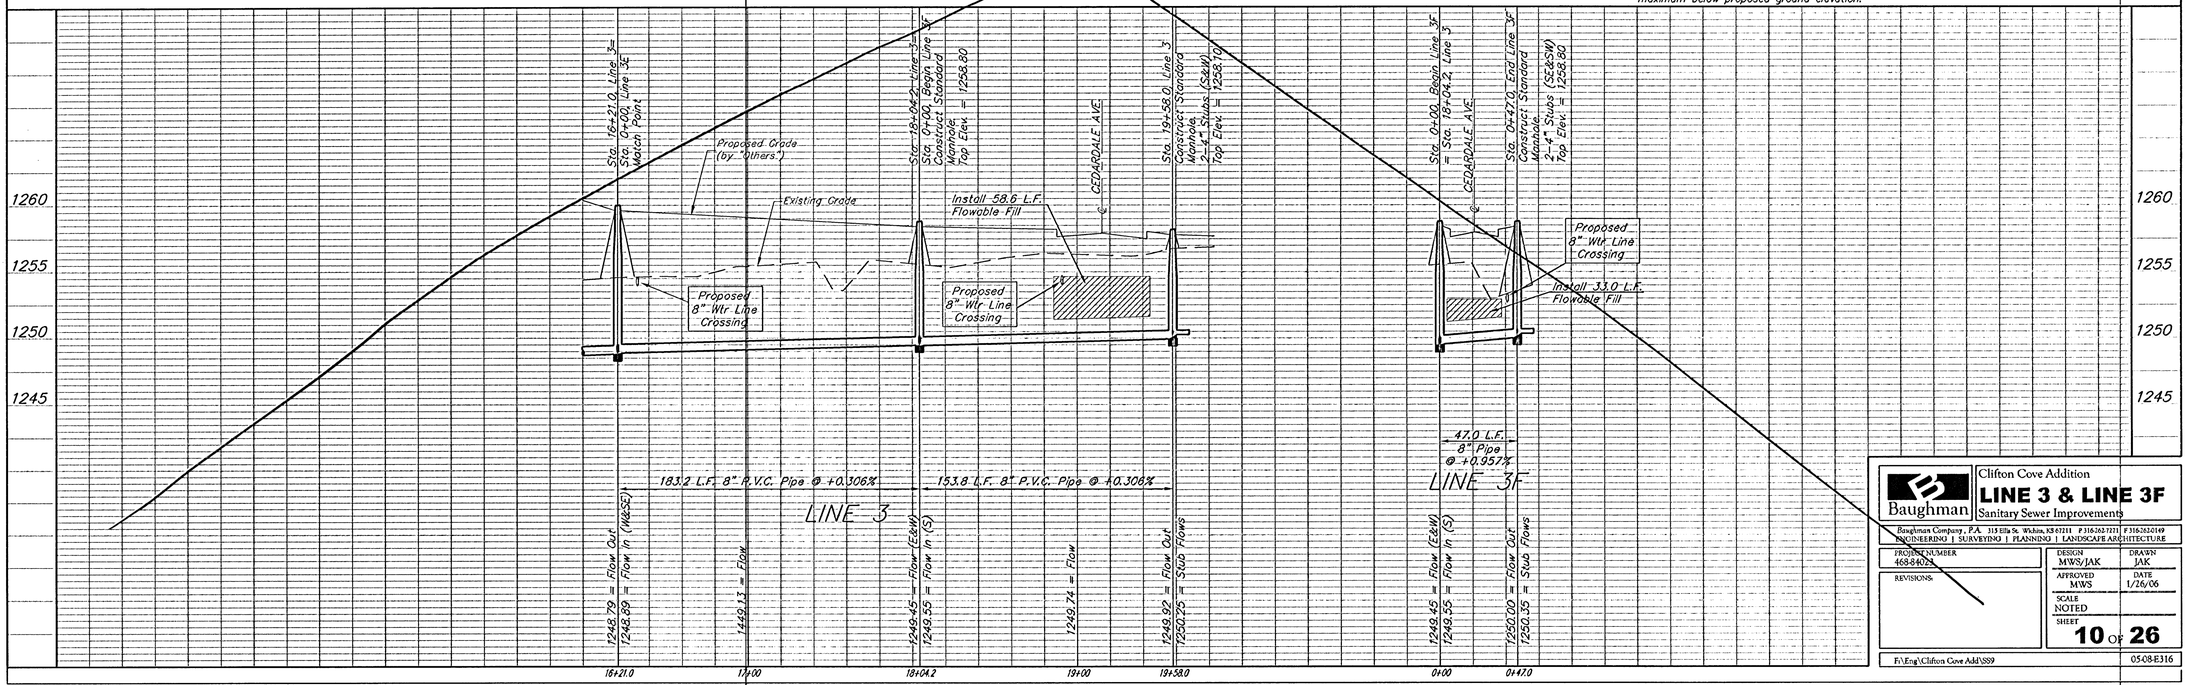

Baughman
Clifton Cove Addition
LINE 3 & LINE 3F
Sanitary Sewer Improvements

Baughman Company, P.A. 315 Ella St. Wichita, KS 67211 P 3162637271 F 3162632149
ENGINEERING | SURVEYING | PLANNING | LANDSCAPE ARCHITECTURE

PROJECT NUMBER 468-84024	DESIGN MWS/JAK
REVISIONS	DRAWN JAK
	APPROVED MWS
	DATE 1/26/06
	SCALE NOTED
	SHEET 10 OF 26

F:\Eng\Clifton Cove Add\SS9 — 05-08-E316