


BENCHMARK:
Arkansas River bridge & 63rd St. S. City of
Wichita Benchmark Disc. SW Cor. of bridge,
top of hubguard. 500'± E. of Grove.
Elev. = 1269.95 NGVD29 (per City record)


Brass plate on the NE wingwall of Arkansas
River bridge & 63rd St. S.
Elev. = 1267.48 NGVD29 (per County record)

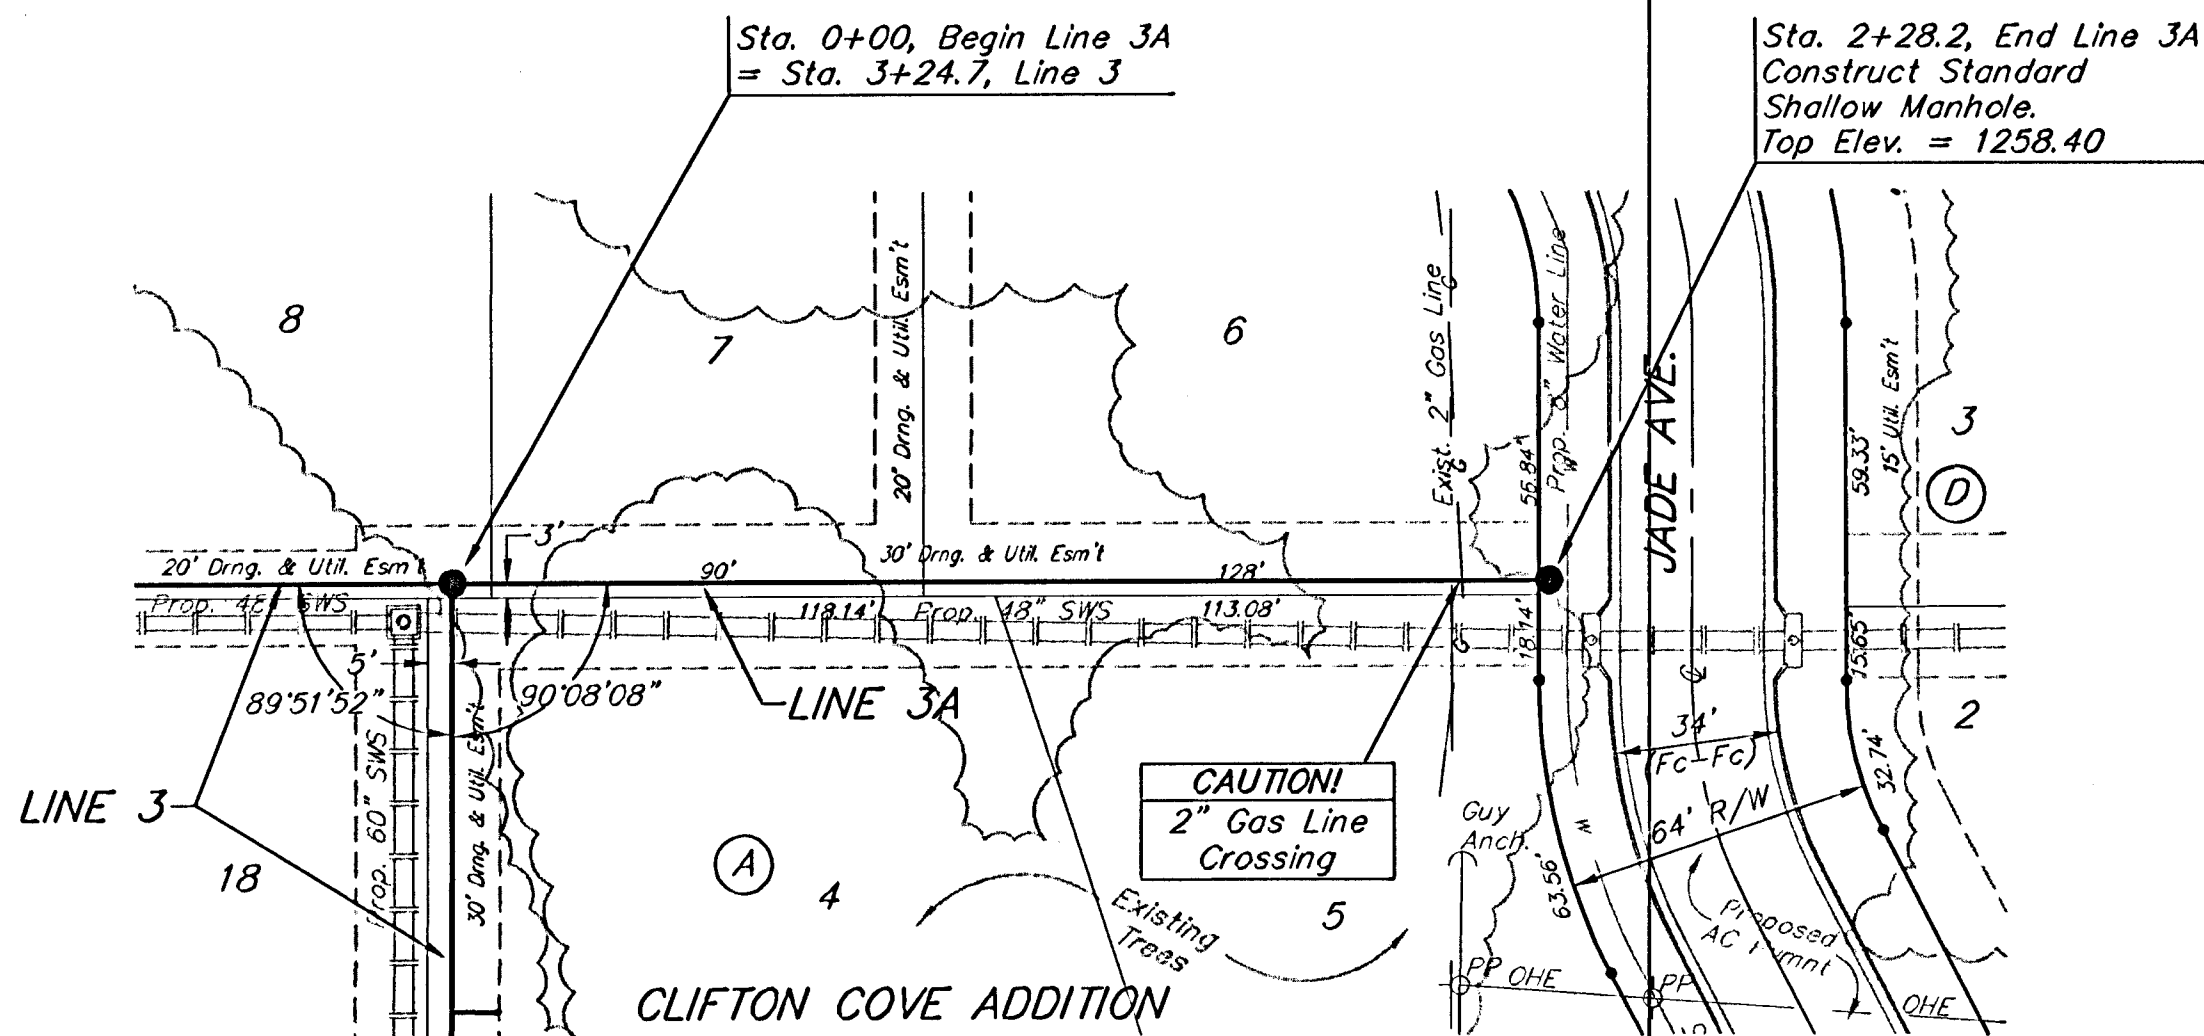



SEWER SERVICE TABLE

NUMBER	TYPE	LOCATION			FOR INFORMATION ONLY		
		LOT NO.	BLOCK NO.	LINE NO.	STATION/DIRECTION	APPROXIMATE LENGTH 4" PIPE	
35	8" X 4" Tee Saddle	16	A	3B	1+03/Lt.	05 4'	13'

NOTE: Vertical Riser Pipe shall be extended to 2' minimum above ground water elevation and 4' maximum below proposed ground elevation.

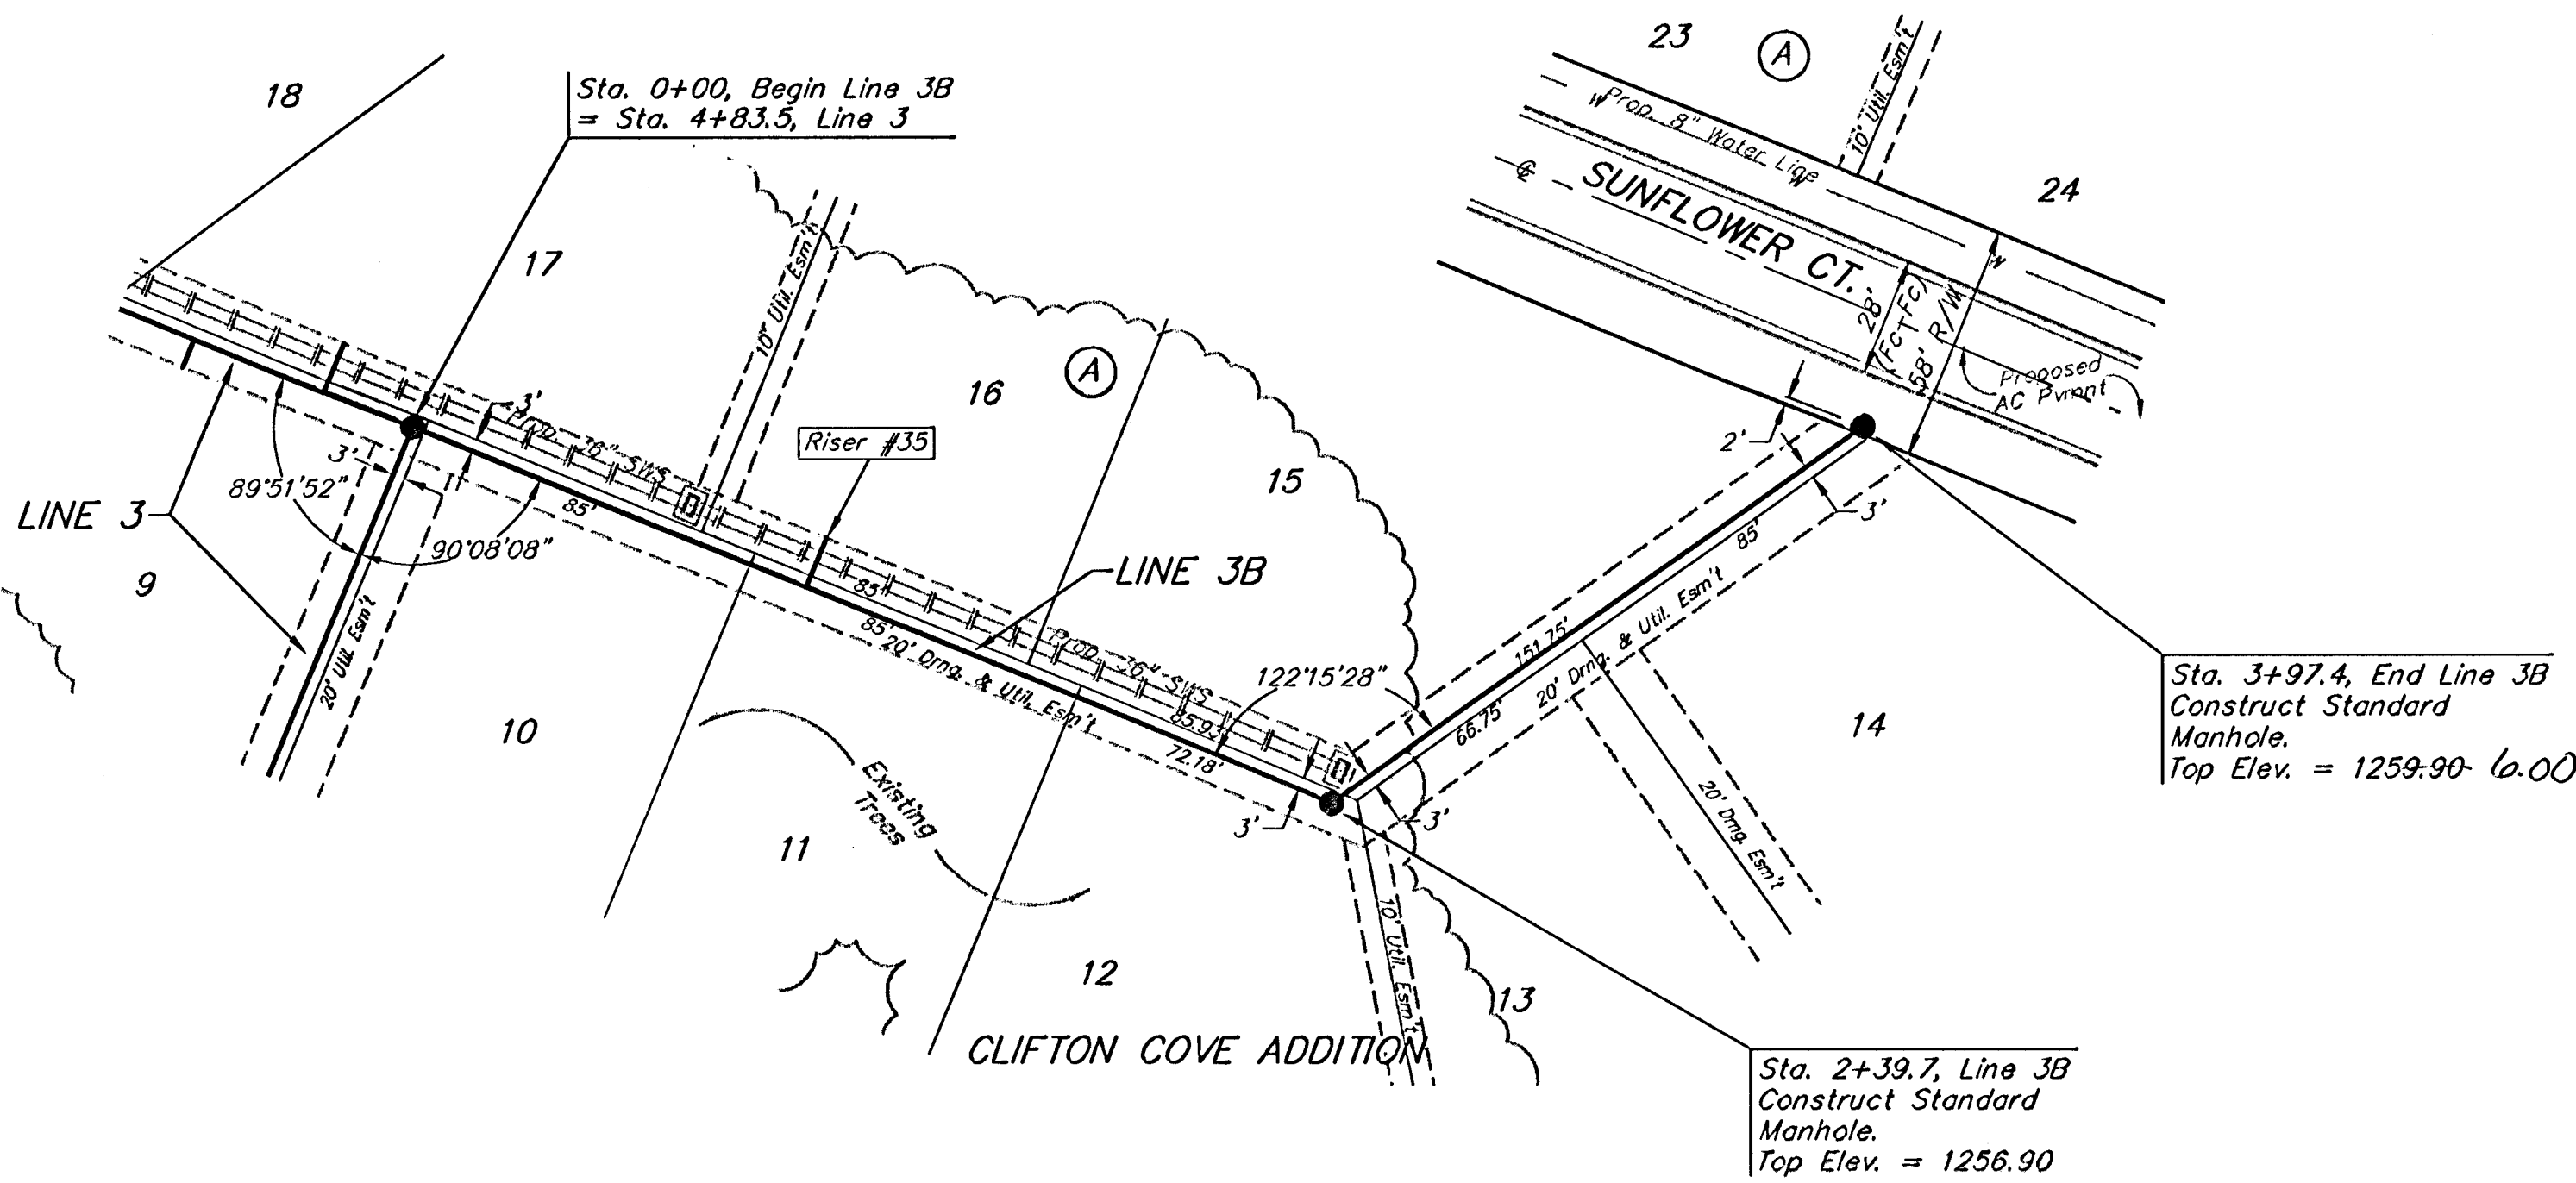

SCALE:
1" = 40' HORIZONTAL
1" = 5' VERTICAL
• = IRON

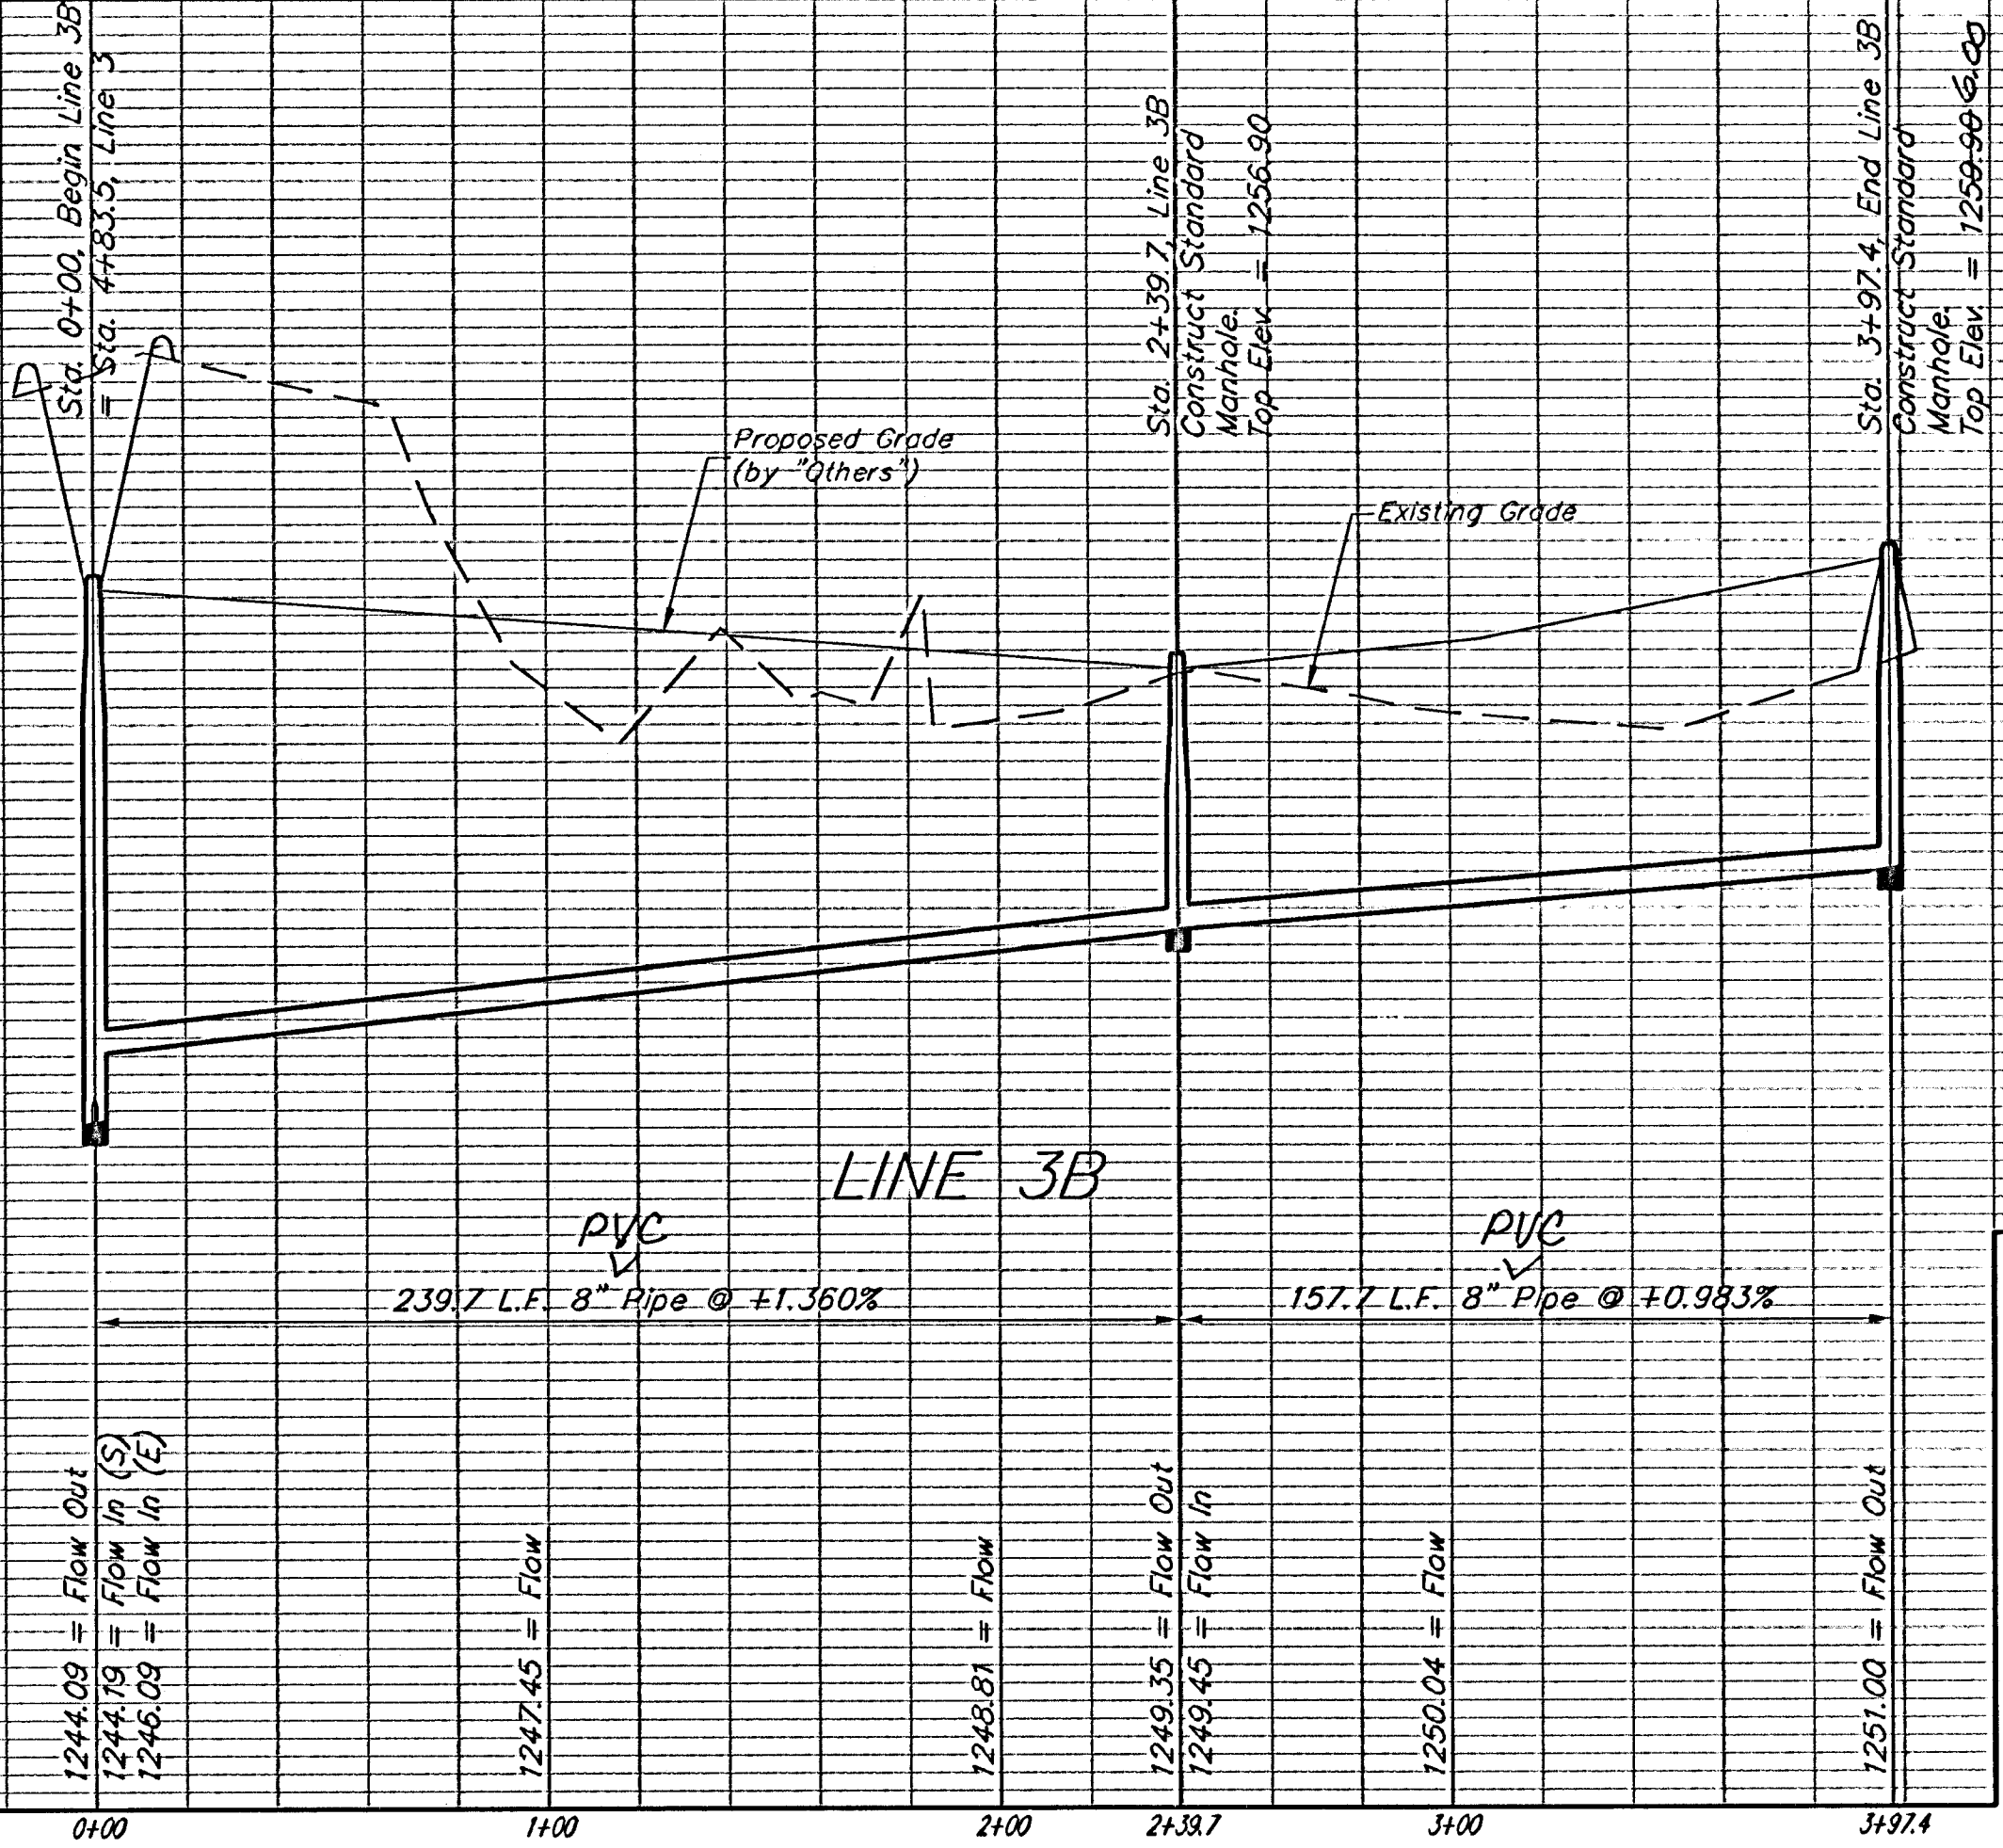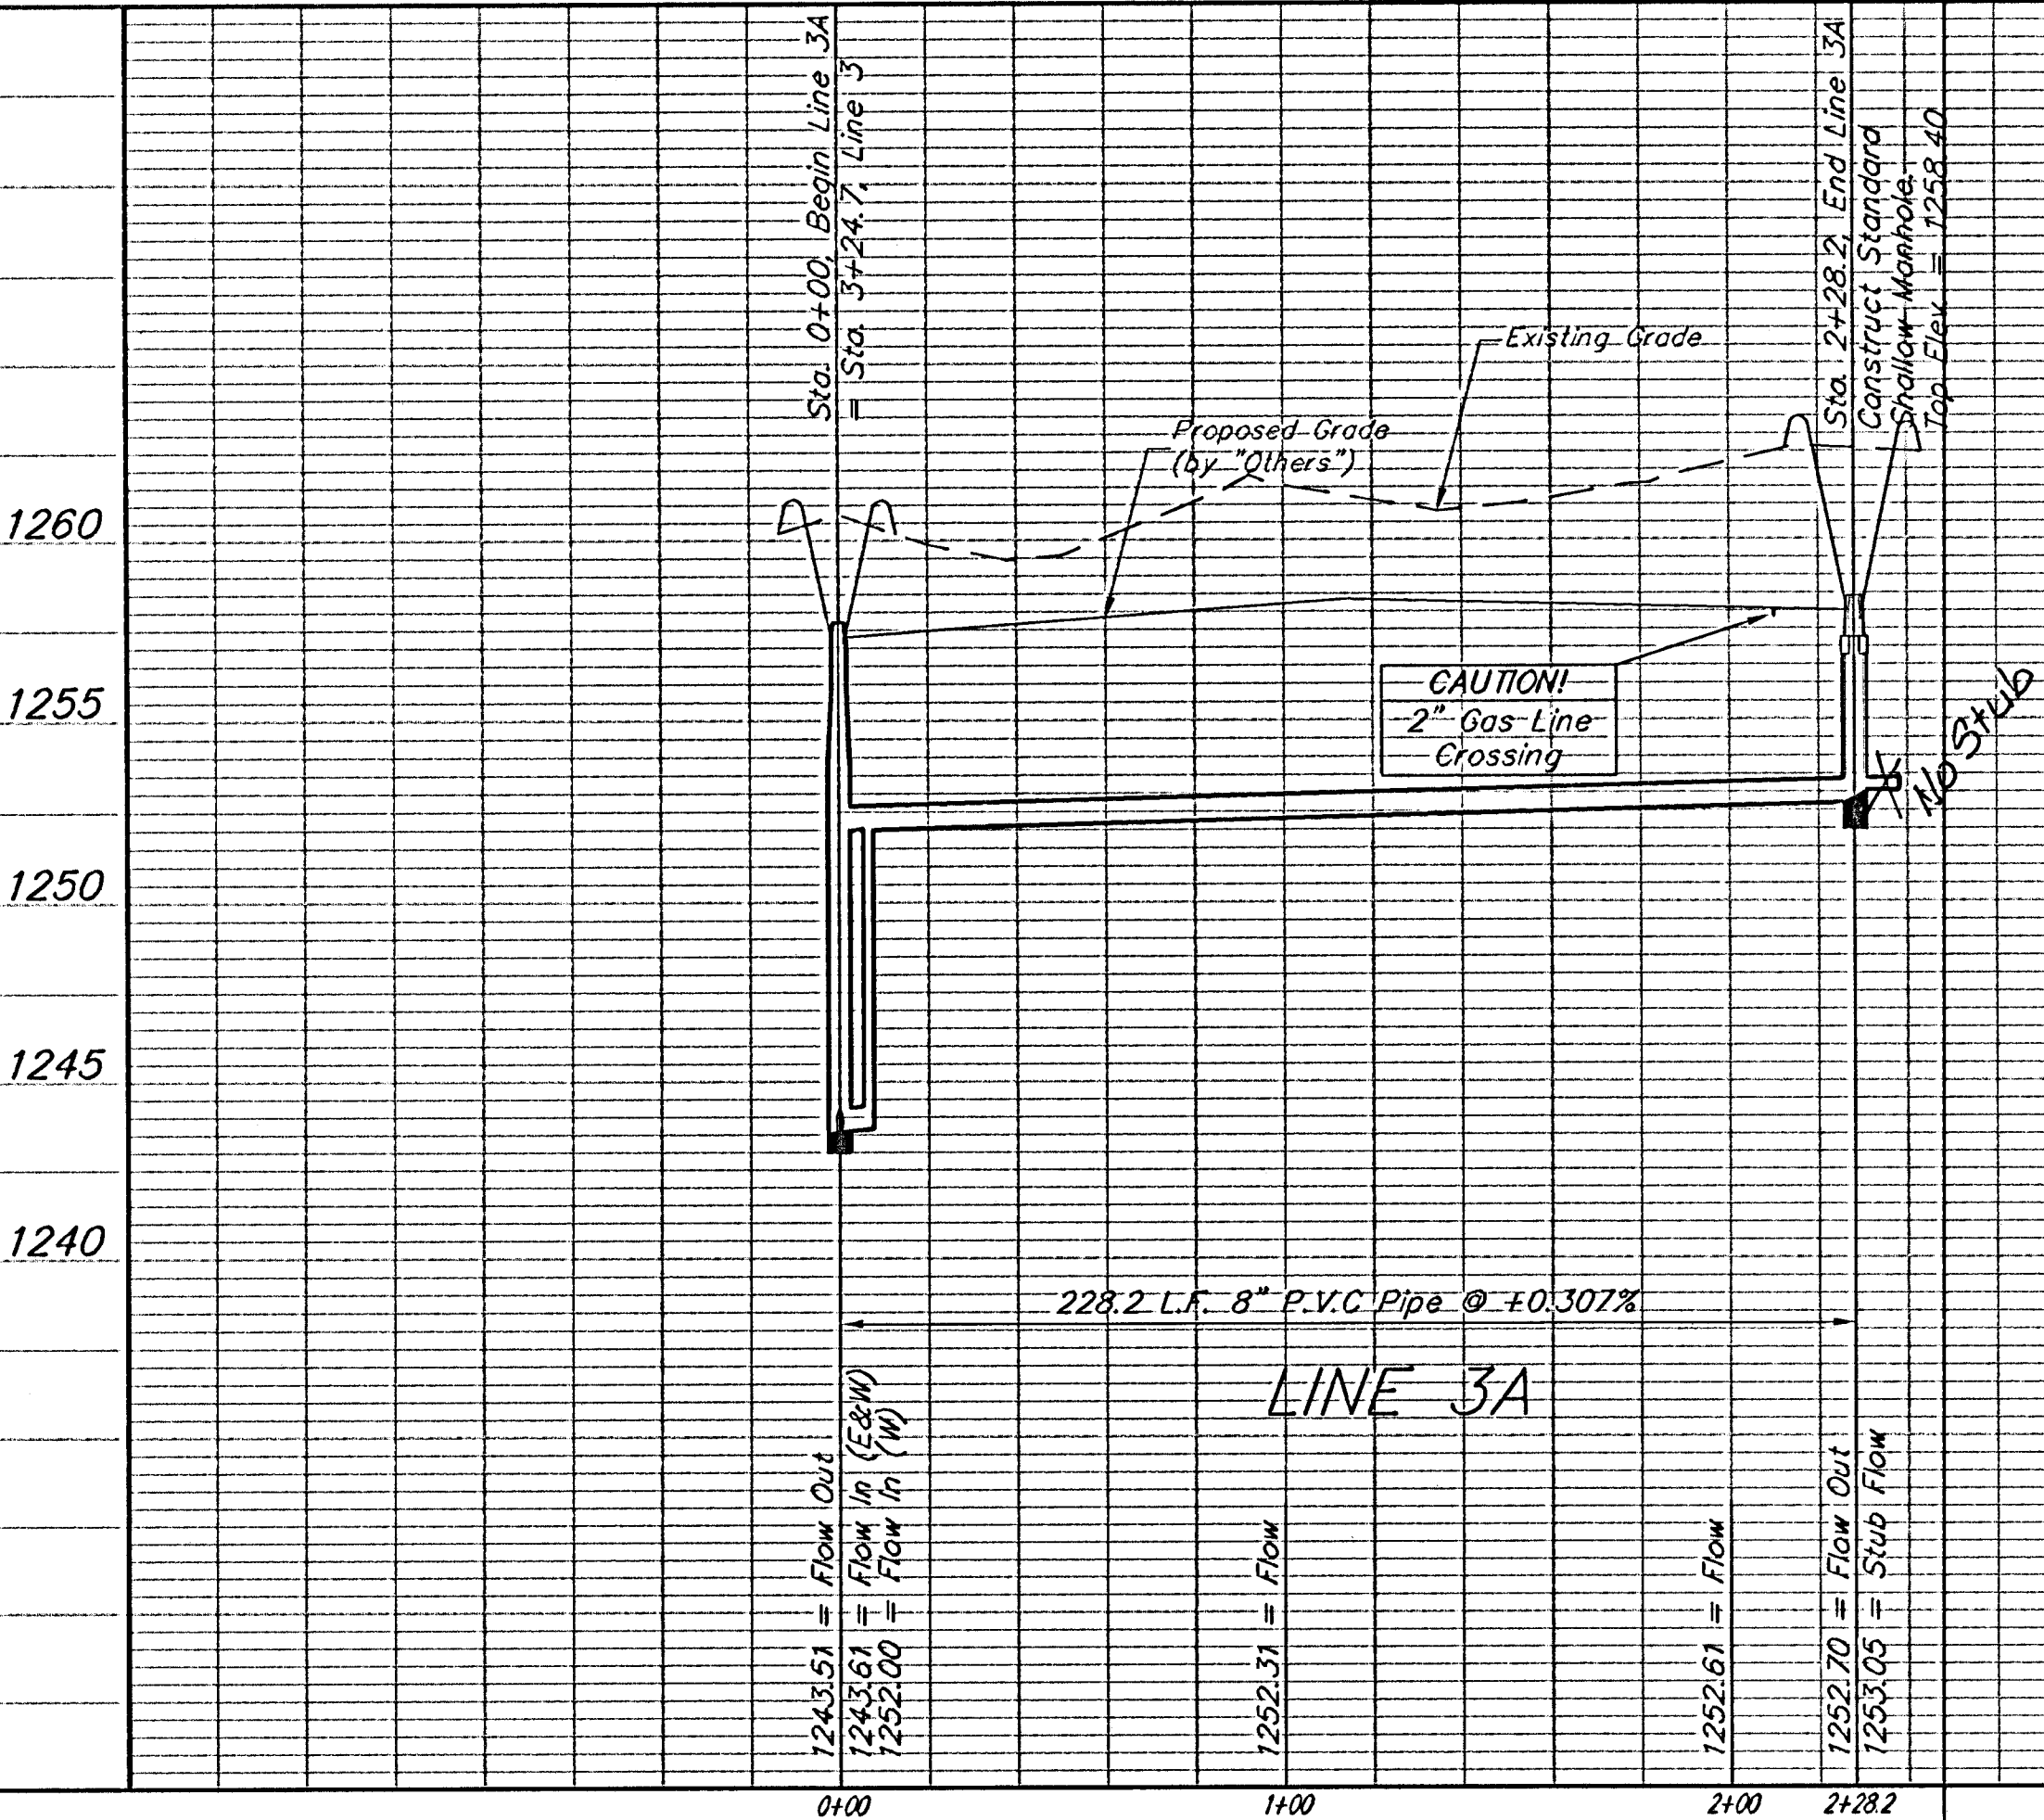



Baughman

Clifton Cove Addition
LINE 3A & LINE 3B
Sanitary Sewer Improvements

Baughman Company, P.A. 315 Ellis St. Wichita, KS 67211 P 316-262-7211 F 316-262-0149
ENGINEERING | SURVEYING | PLANNING | LANDSCAPE ARCHITECTURE

PROJECT NUMBER
468-84023

DESIGN
MWS/JAK

DRAWN
JAK

APPROVED
MWS

DATE
1/26/06

SCALE
NOTED
SHEET

11 OF 26

F:\Eng\Clifton Cove Add\SS10

0508-E316