
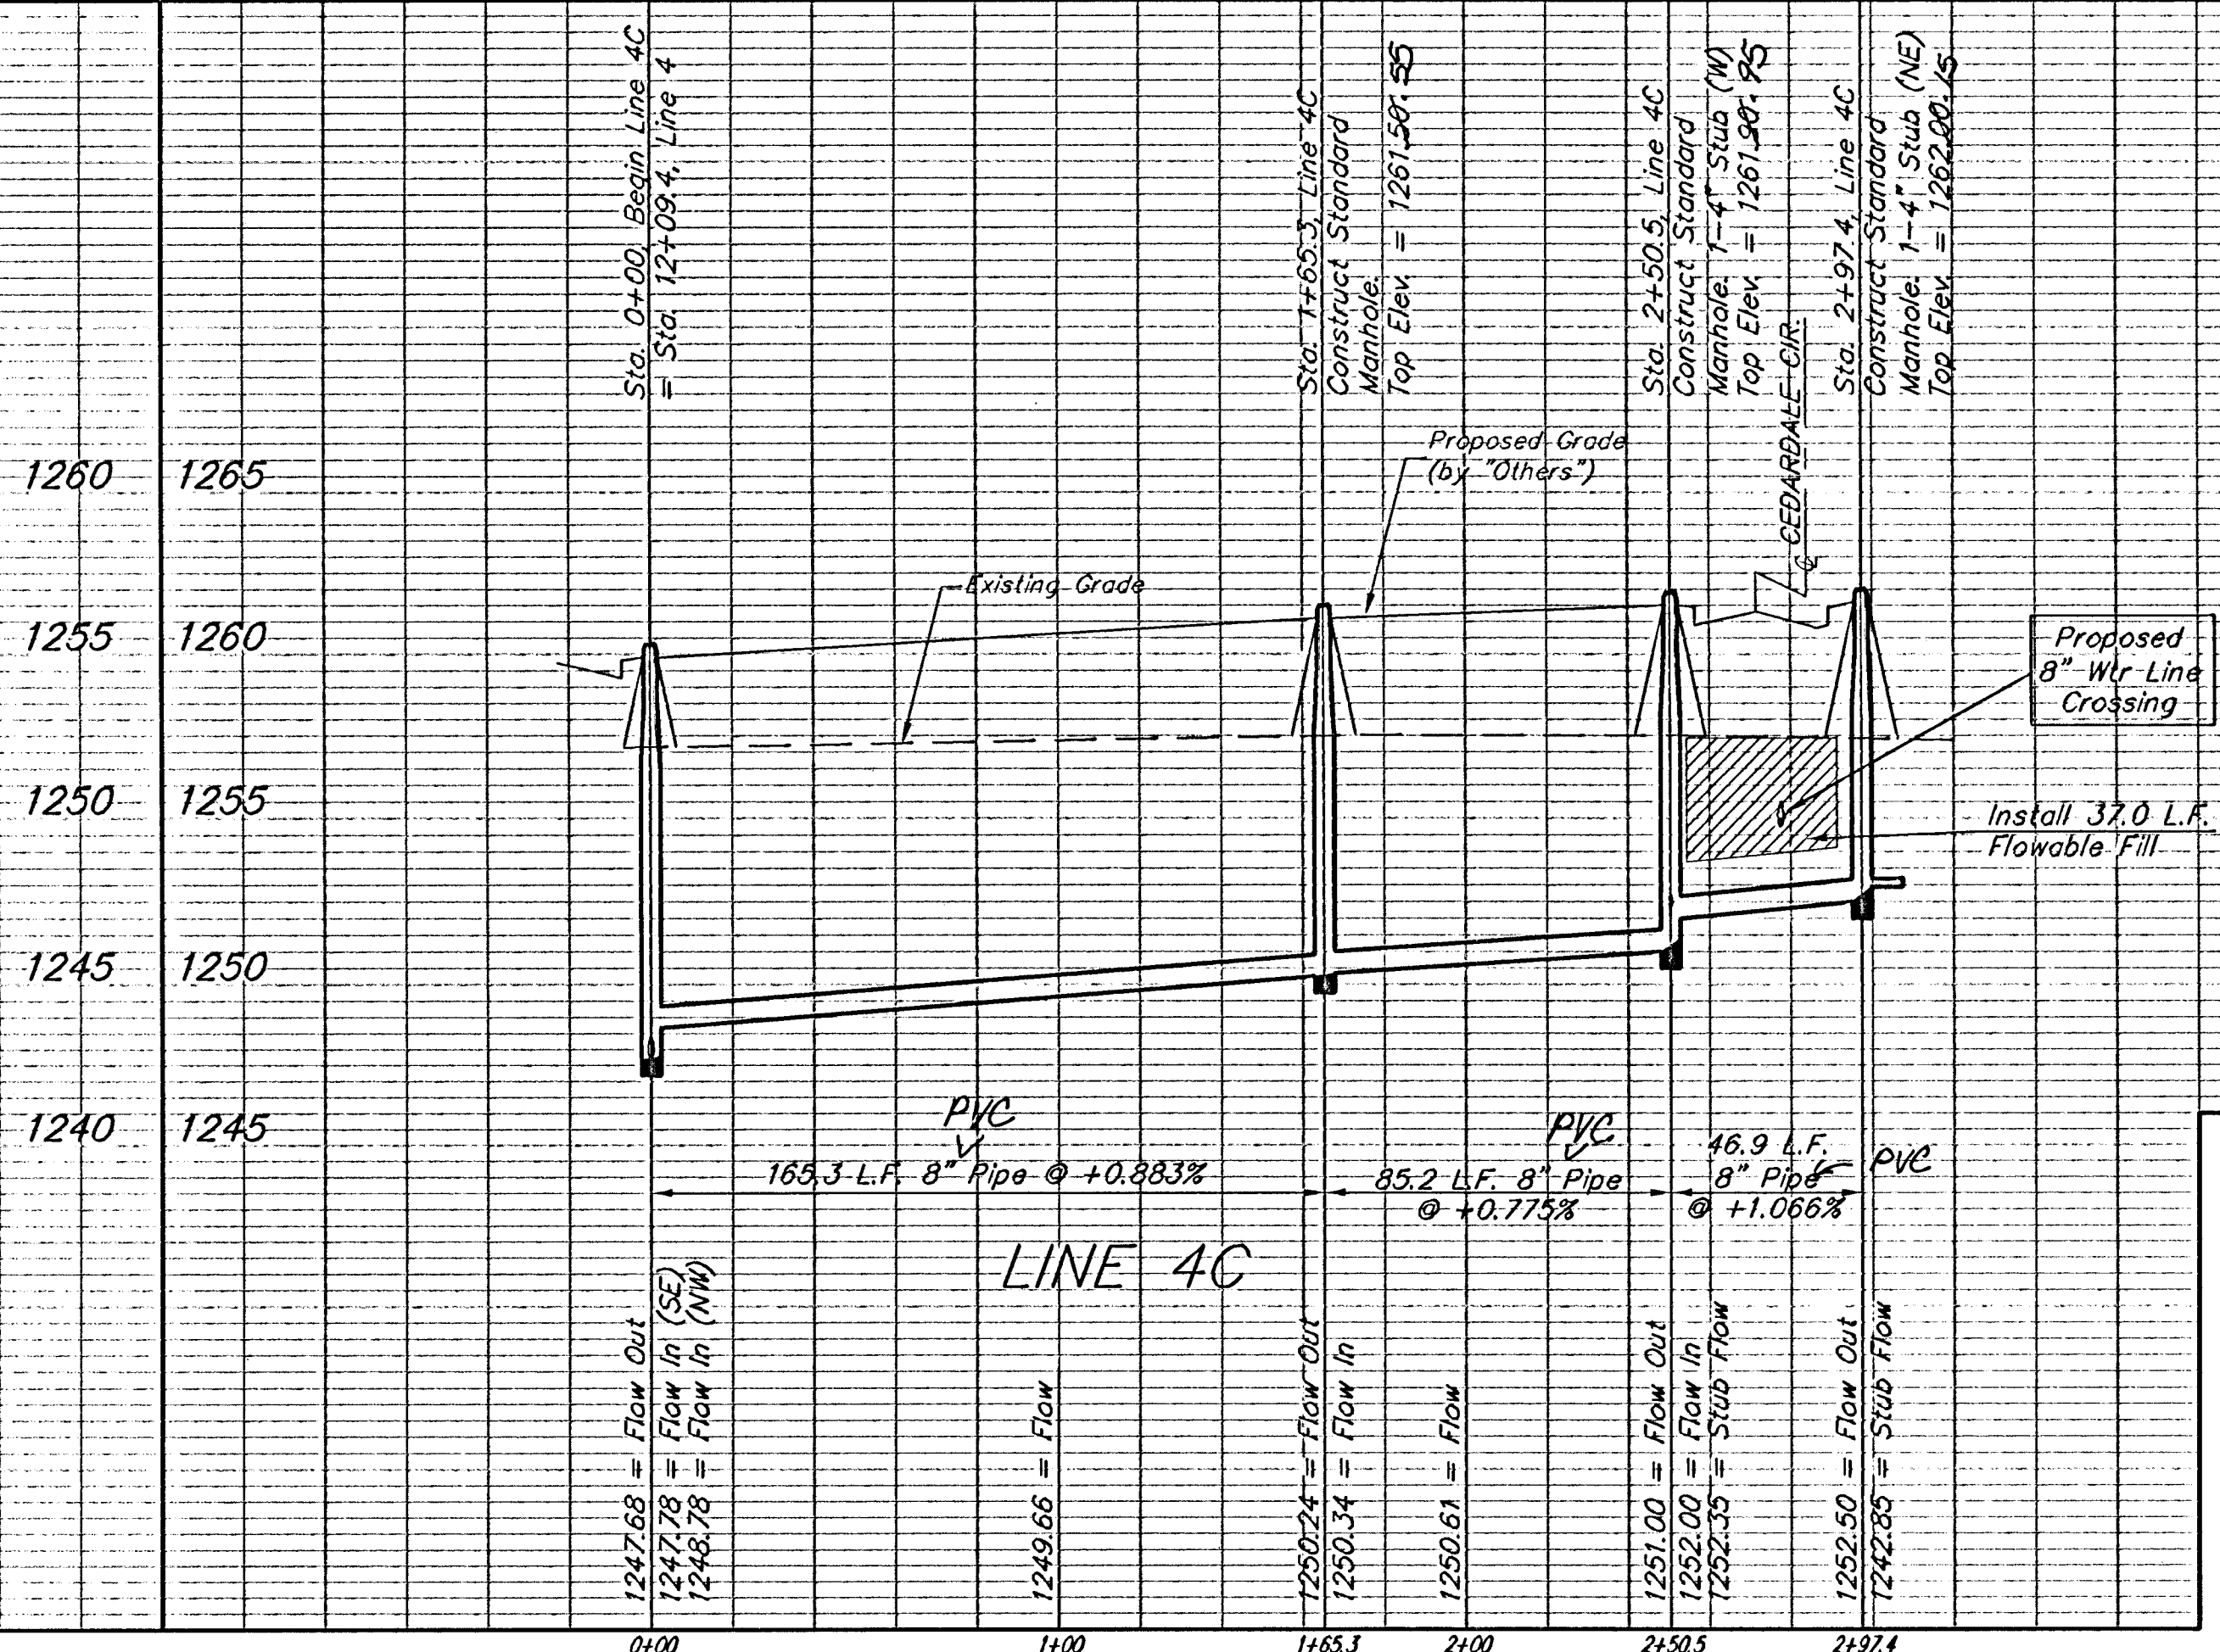
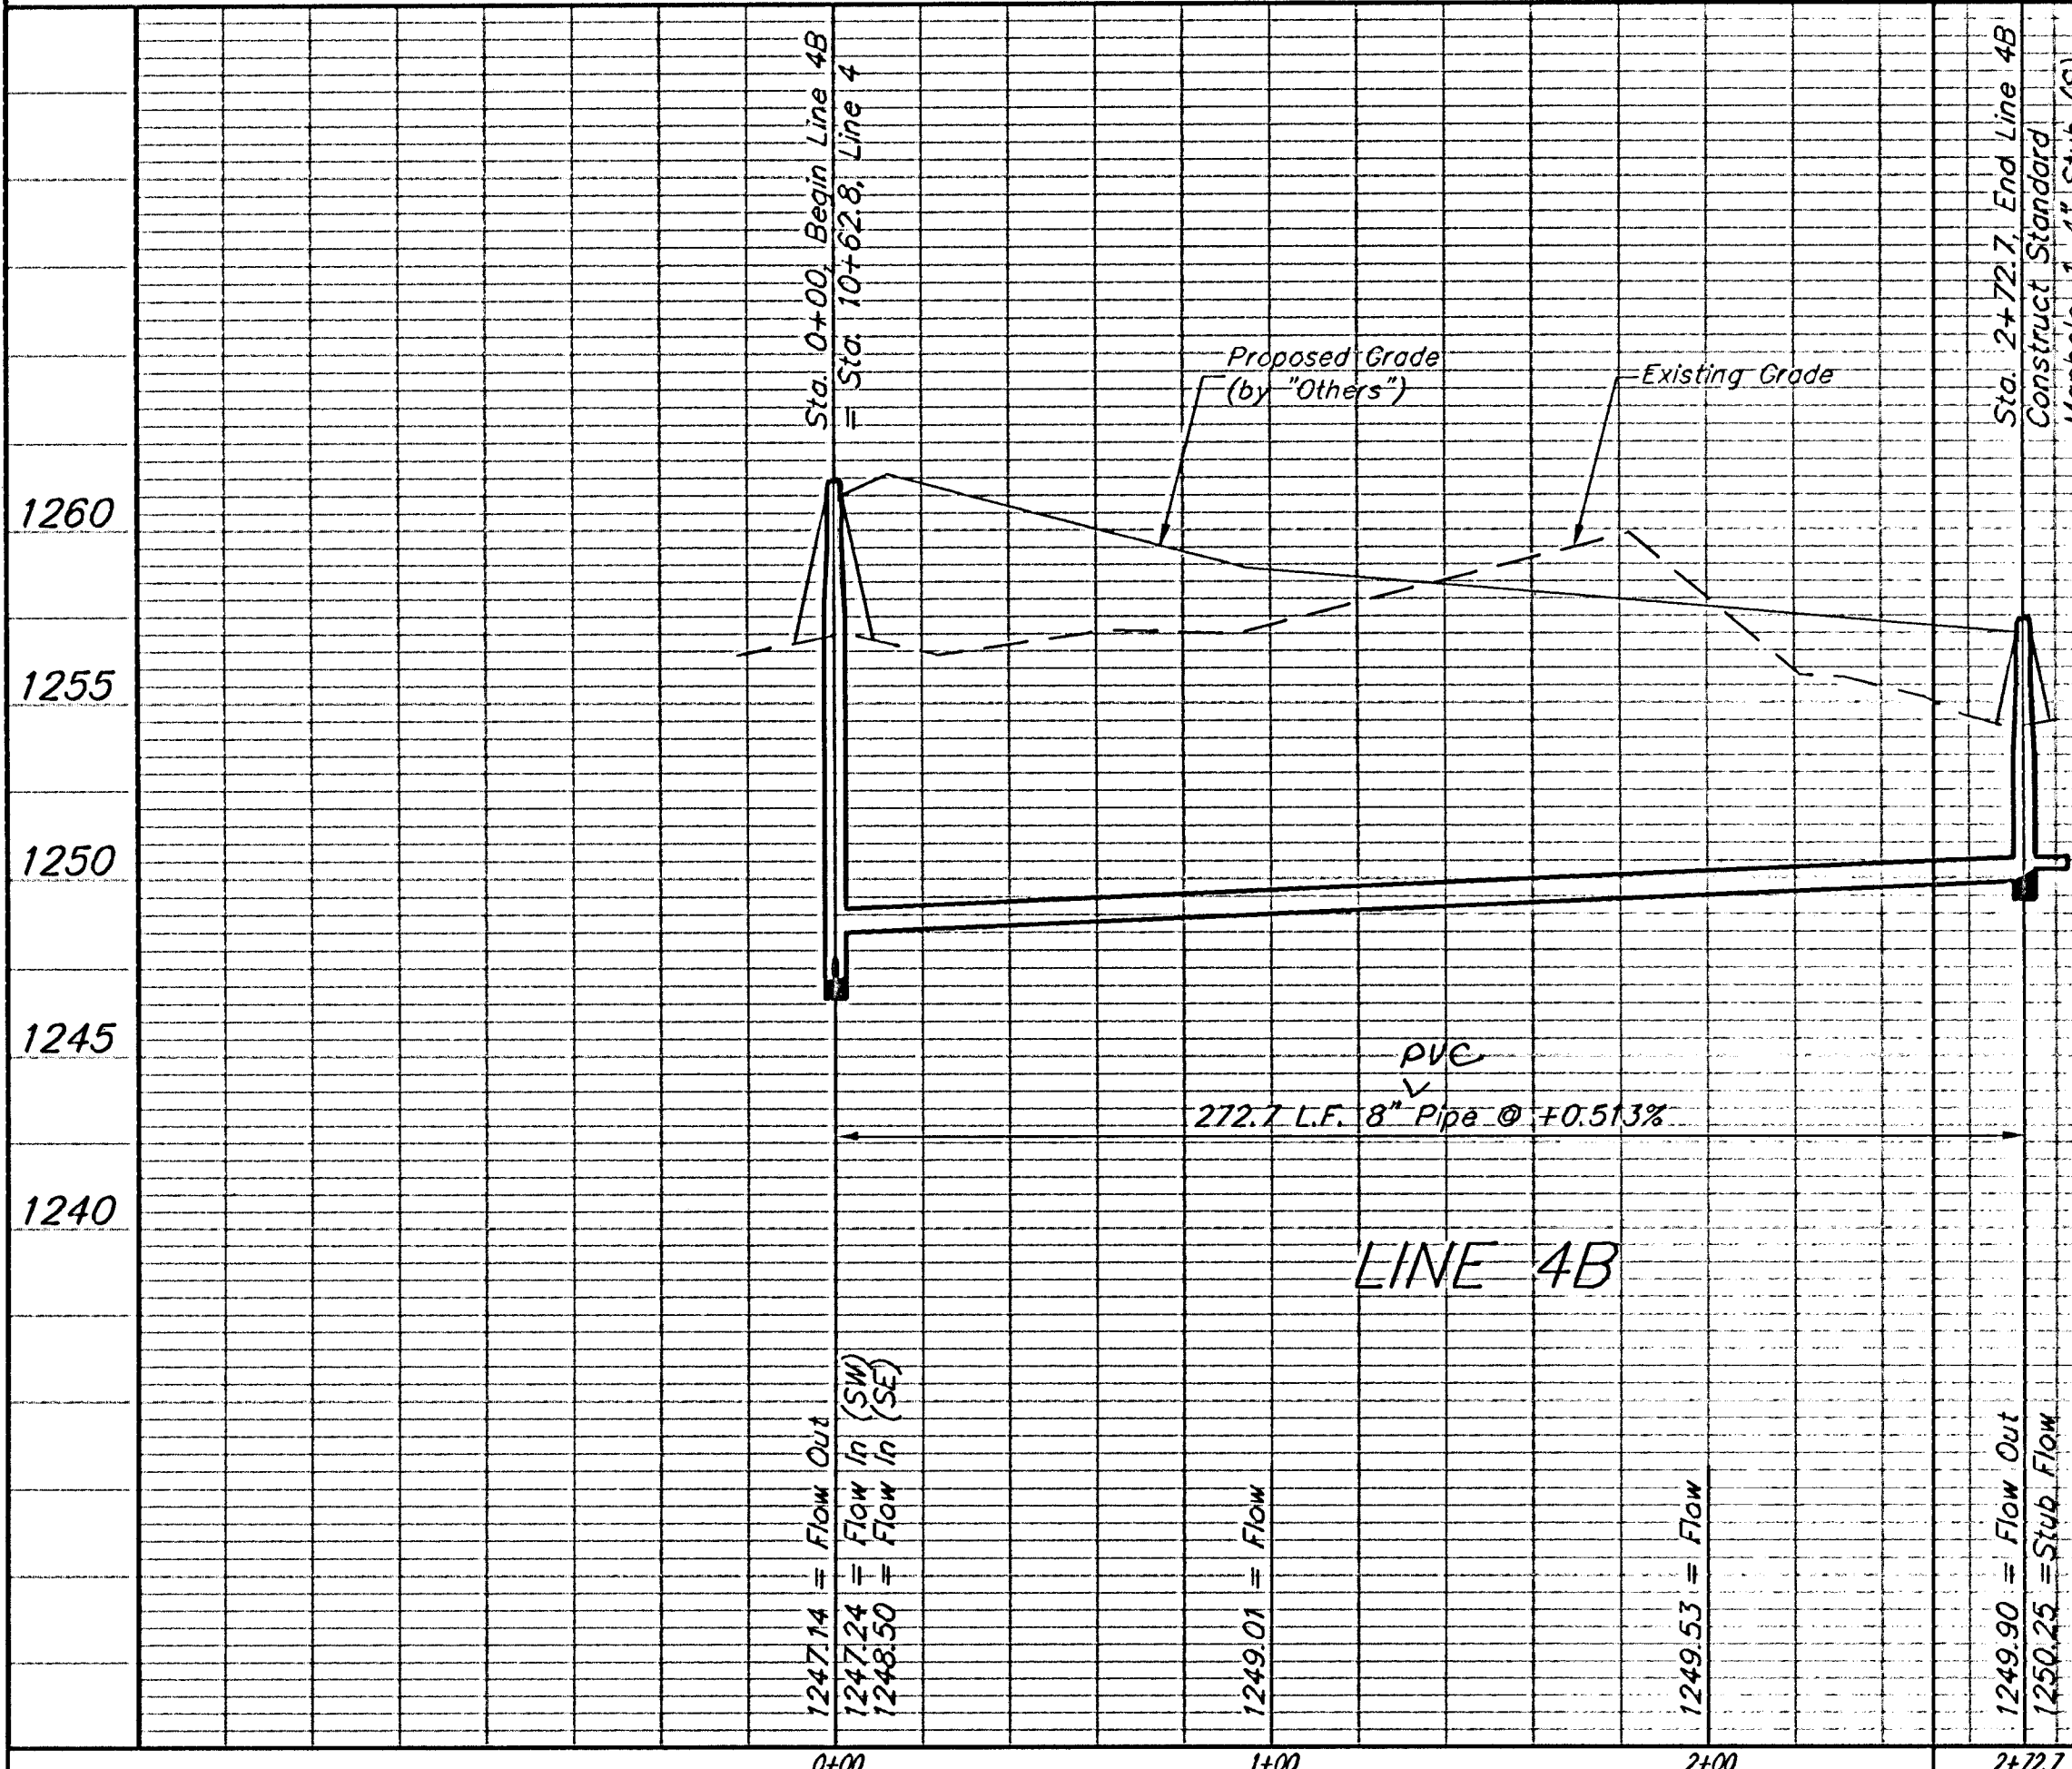
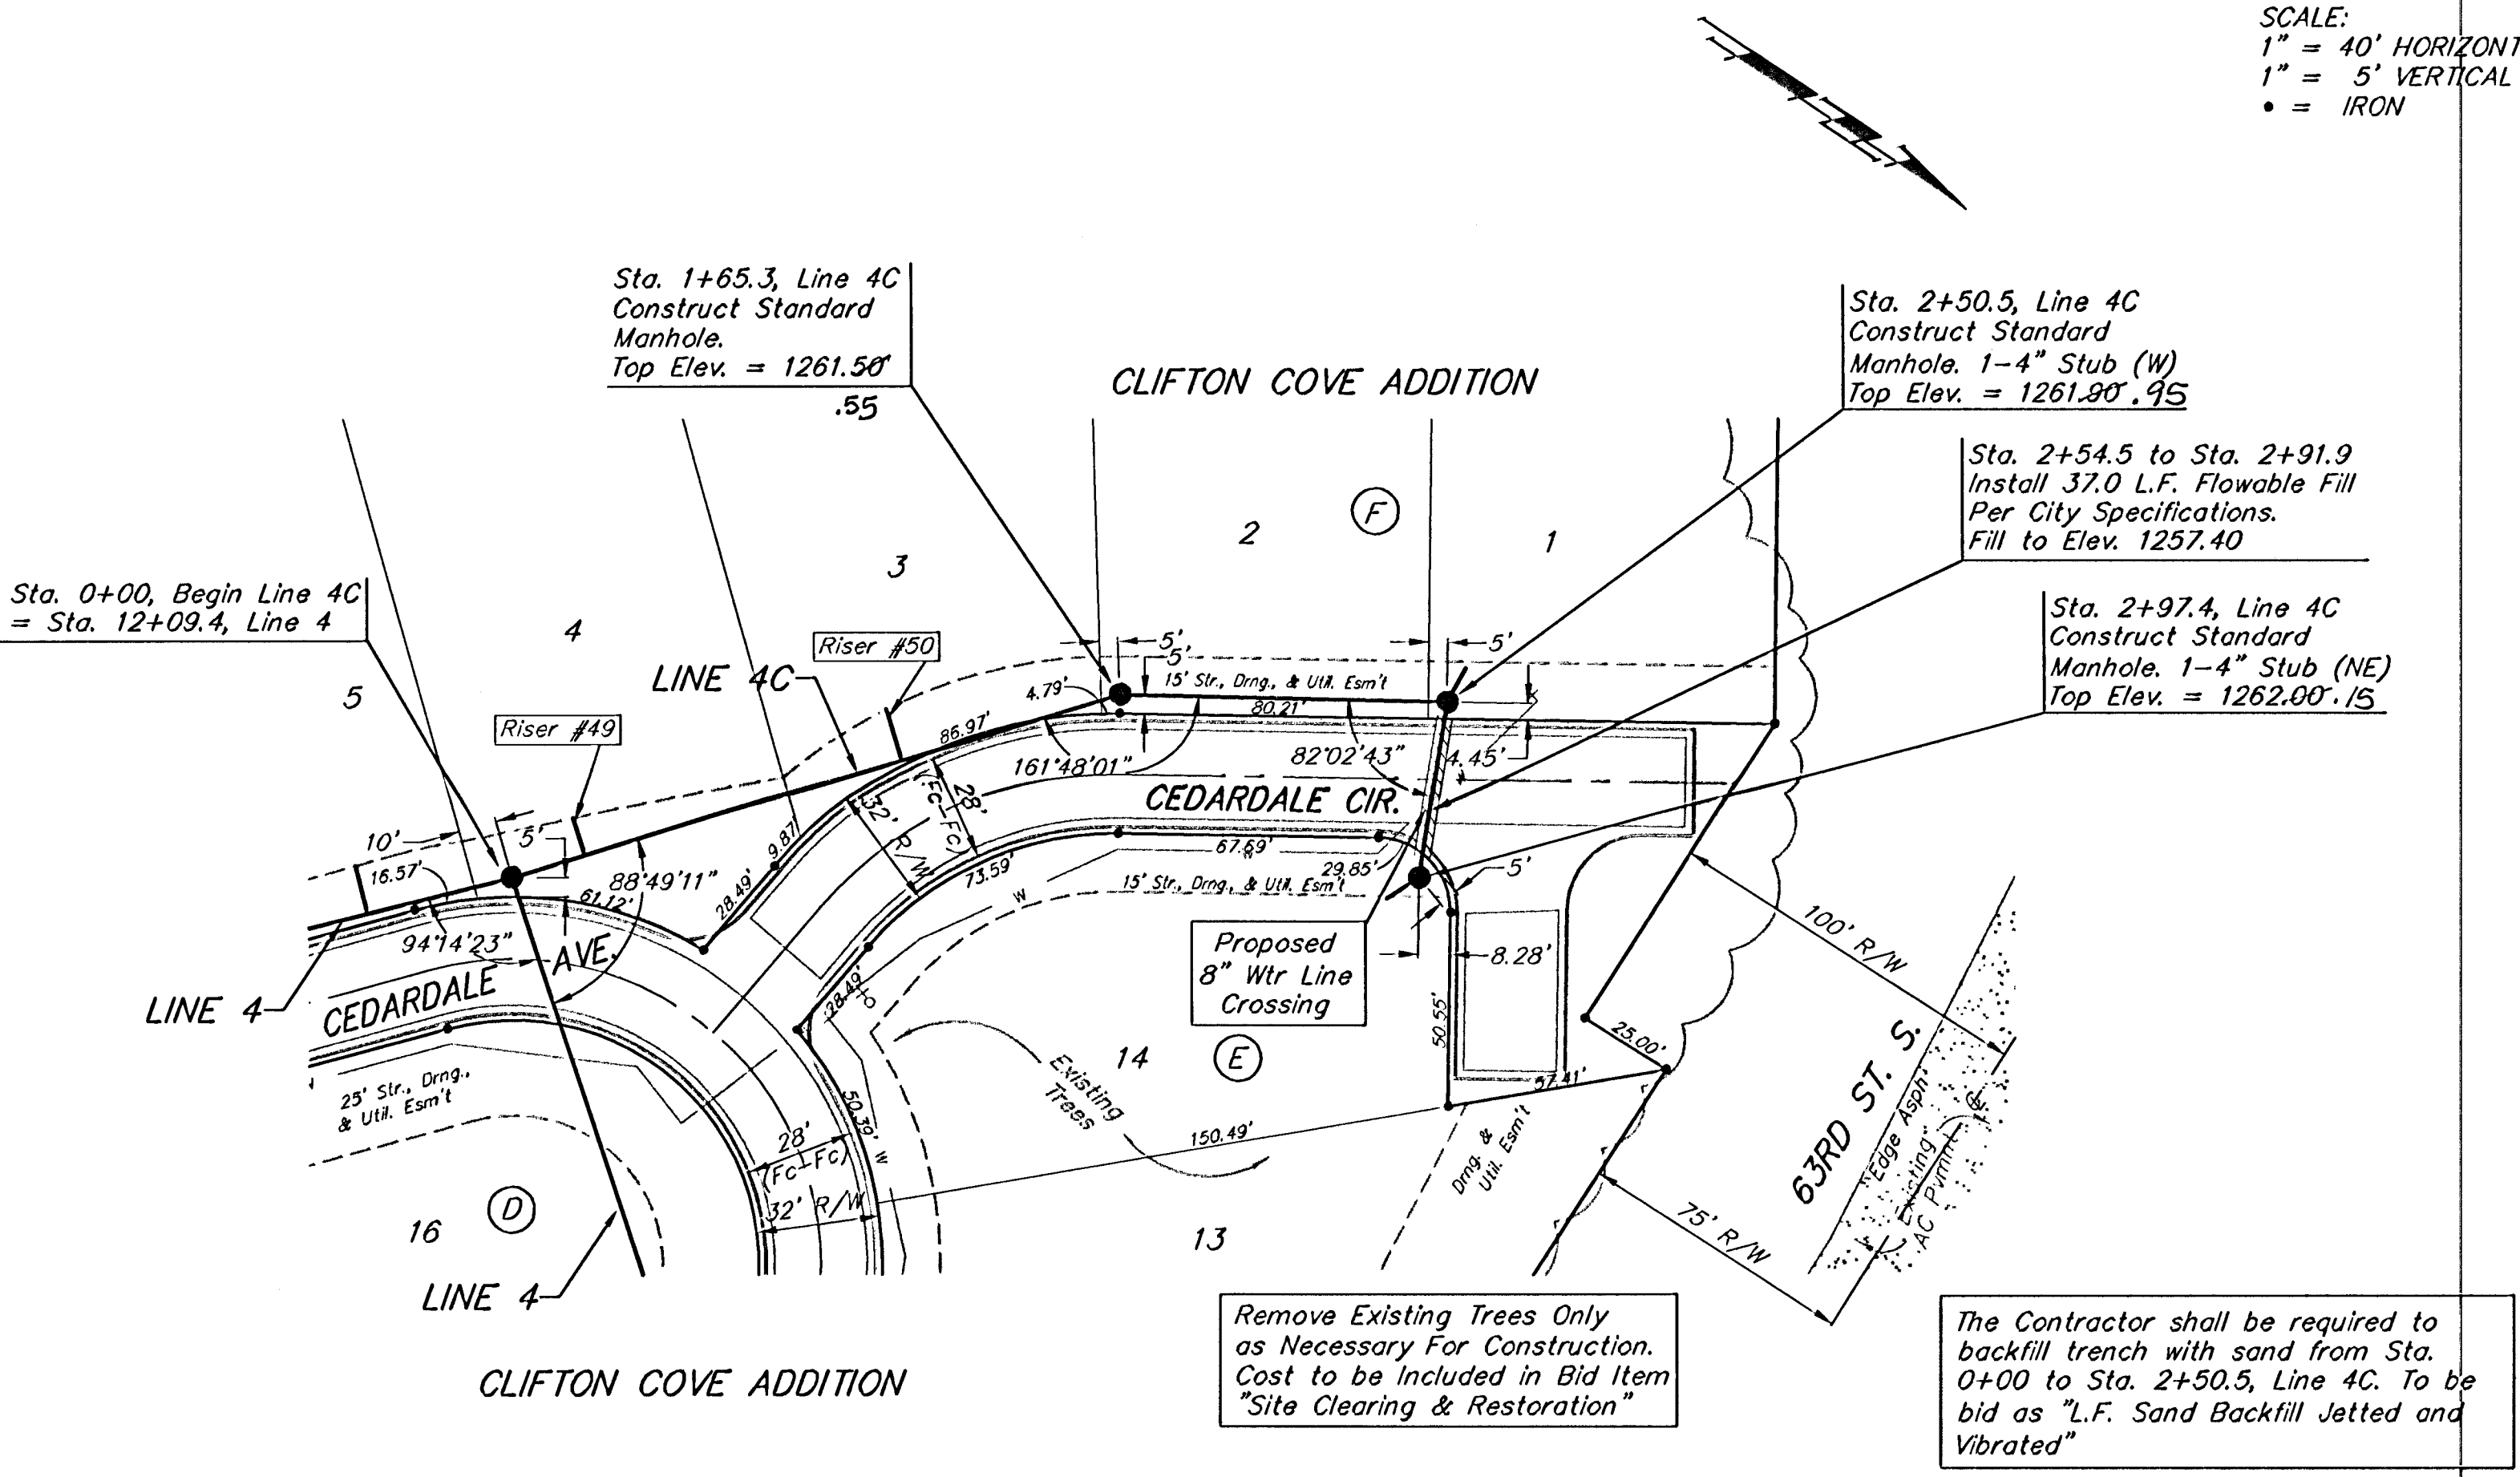


BENCHMARK:
Arkansas River bridge & 63rd St. S. City of
Wichita Benchmark Disc. SW Cor. of bridge,
top of hubguard. 500'± E. of Grove.
Elev. = 1269.95 NGVD29 (per City record)

Brass plate on the NE wall of Arkansas
River bridge & 63rd St. S.
Elev. = 1267.48 NGVD29 (per County record)

SEWER SERVICE TABLE							
NUMBER	TYPE	LOCATION			FOR INFORMATION ONLY		
		LOT NO.	BLOCK NO.	LINE NO.	STATION/DIRECTION	APPROXIMATE LENGTH 4" PIPE	
47	8" X 4" Tee Saddle	16	D	4B	0+34.1/Rt.	35	10'
48	8" X 4" Tee Saddle	15	D	4B	1+36/Rt.		6.5'
49	8" X 4" Tee Saddle	4	F	4C	0+20/Lt.		7'
50	8" X 4" Tee Saddle	3	F	4C	1+06/Lt.		6'

NOTE: Vertical Riser Pipe shall be extended to 2' minimum above ground water elevation and 4' maximum below proposed ground elevation.

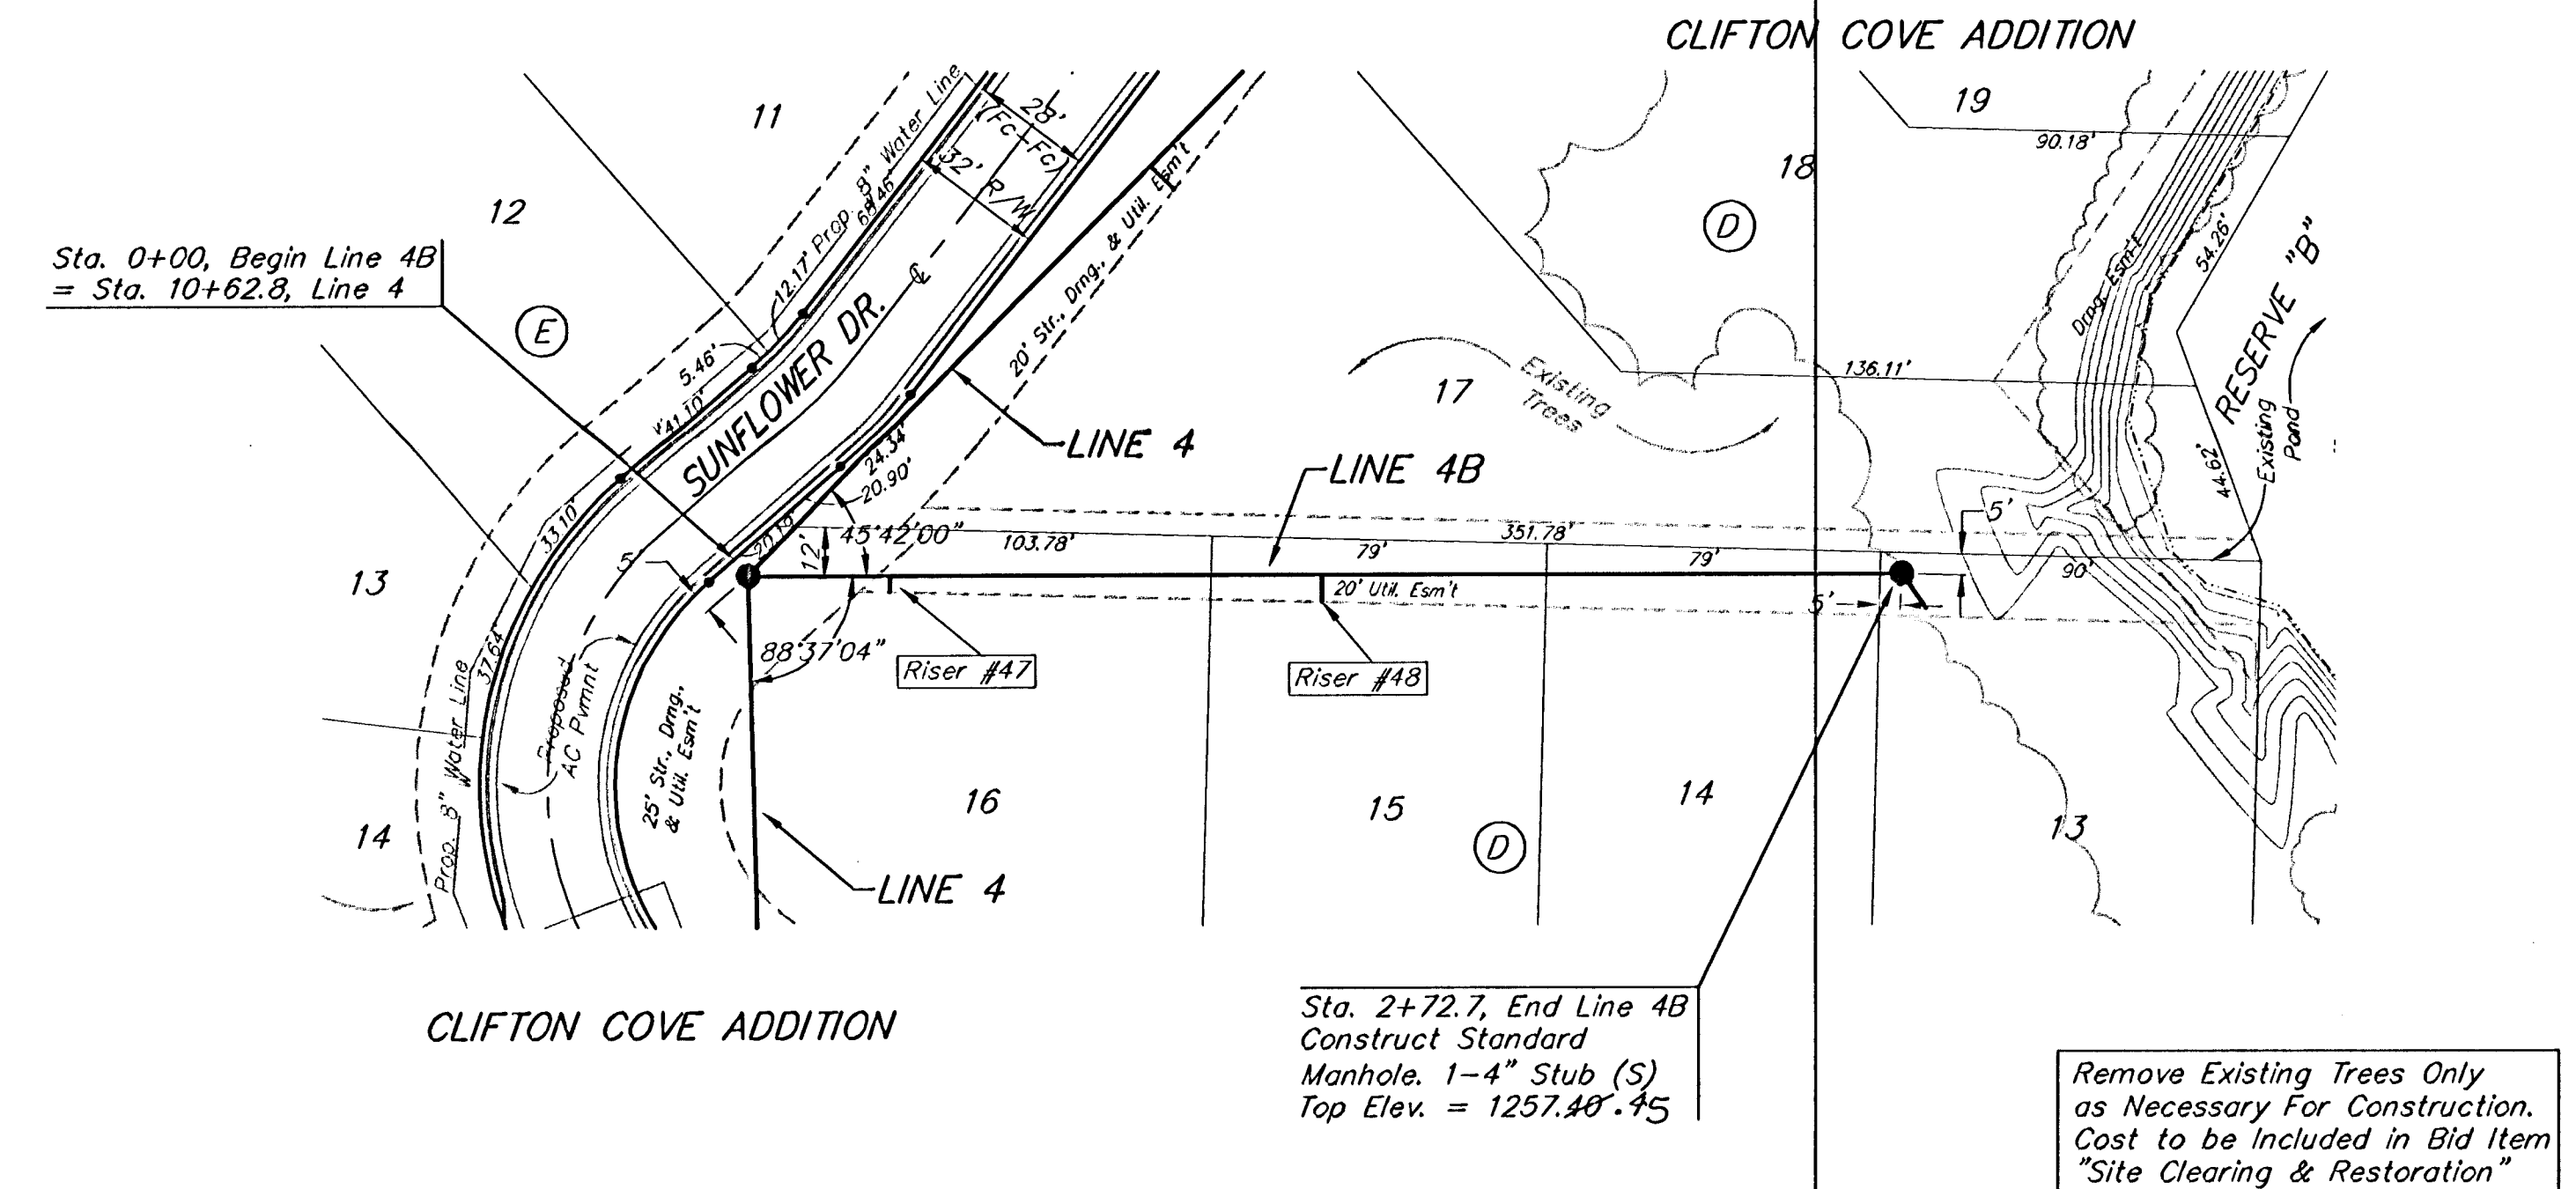

Clifton Cove Addition
LINE 4B & LINE 4C
Sanitary Sewer Improvements

Baughman Company, P.A. 315 Ellis St., Wichita, KS 67211 P 3162637271 F 3162620149
ENGINEERING | SURVEYING | PLANNING | LANDSCAPE ARCHITECTURE

PROJECT NUMBER
468-84023

DESIGN
MWS/JAK

DRAWN
JAK

APPROVED
MWS

DATE
1/26/06

SCALE
NOTED

SHEET
16 OF **26**

FILE:Eng\Clifton Cove Add\SS15

0508E316