

CAUTION! UNDERGROUND
TELEPHONE AND POWER
CABLES

NOTE: CONTRACTOR SHALL
SUPPORT EXISTING UTILITIES AS
REQUIRED TO CONSTRUCT
SANITARY SEWER


REEDS COVE 4TH ADDITION

PLAN LINE 3

REEDS COVE 4TH ADDITION

NOTE:
SEE SHEET 7 FOR
RISER TABLE.

SCALE: 1" = 40'
0 20 40 80

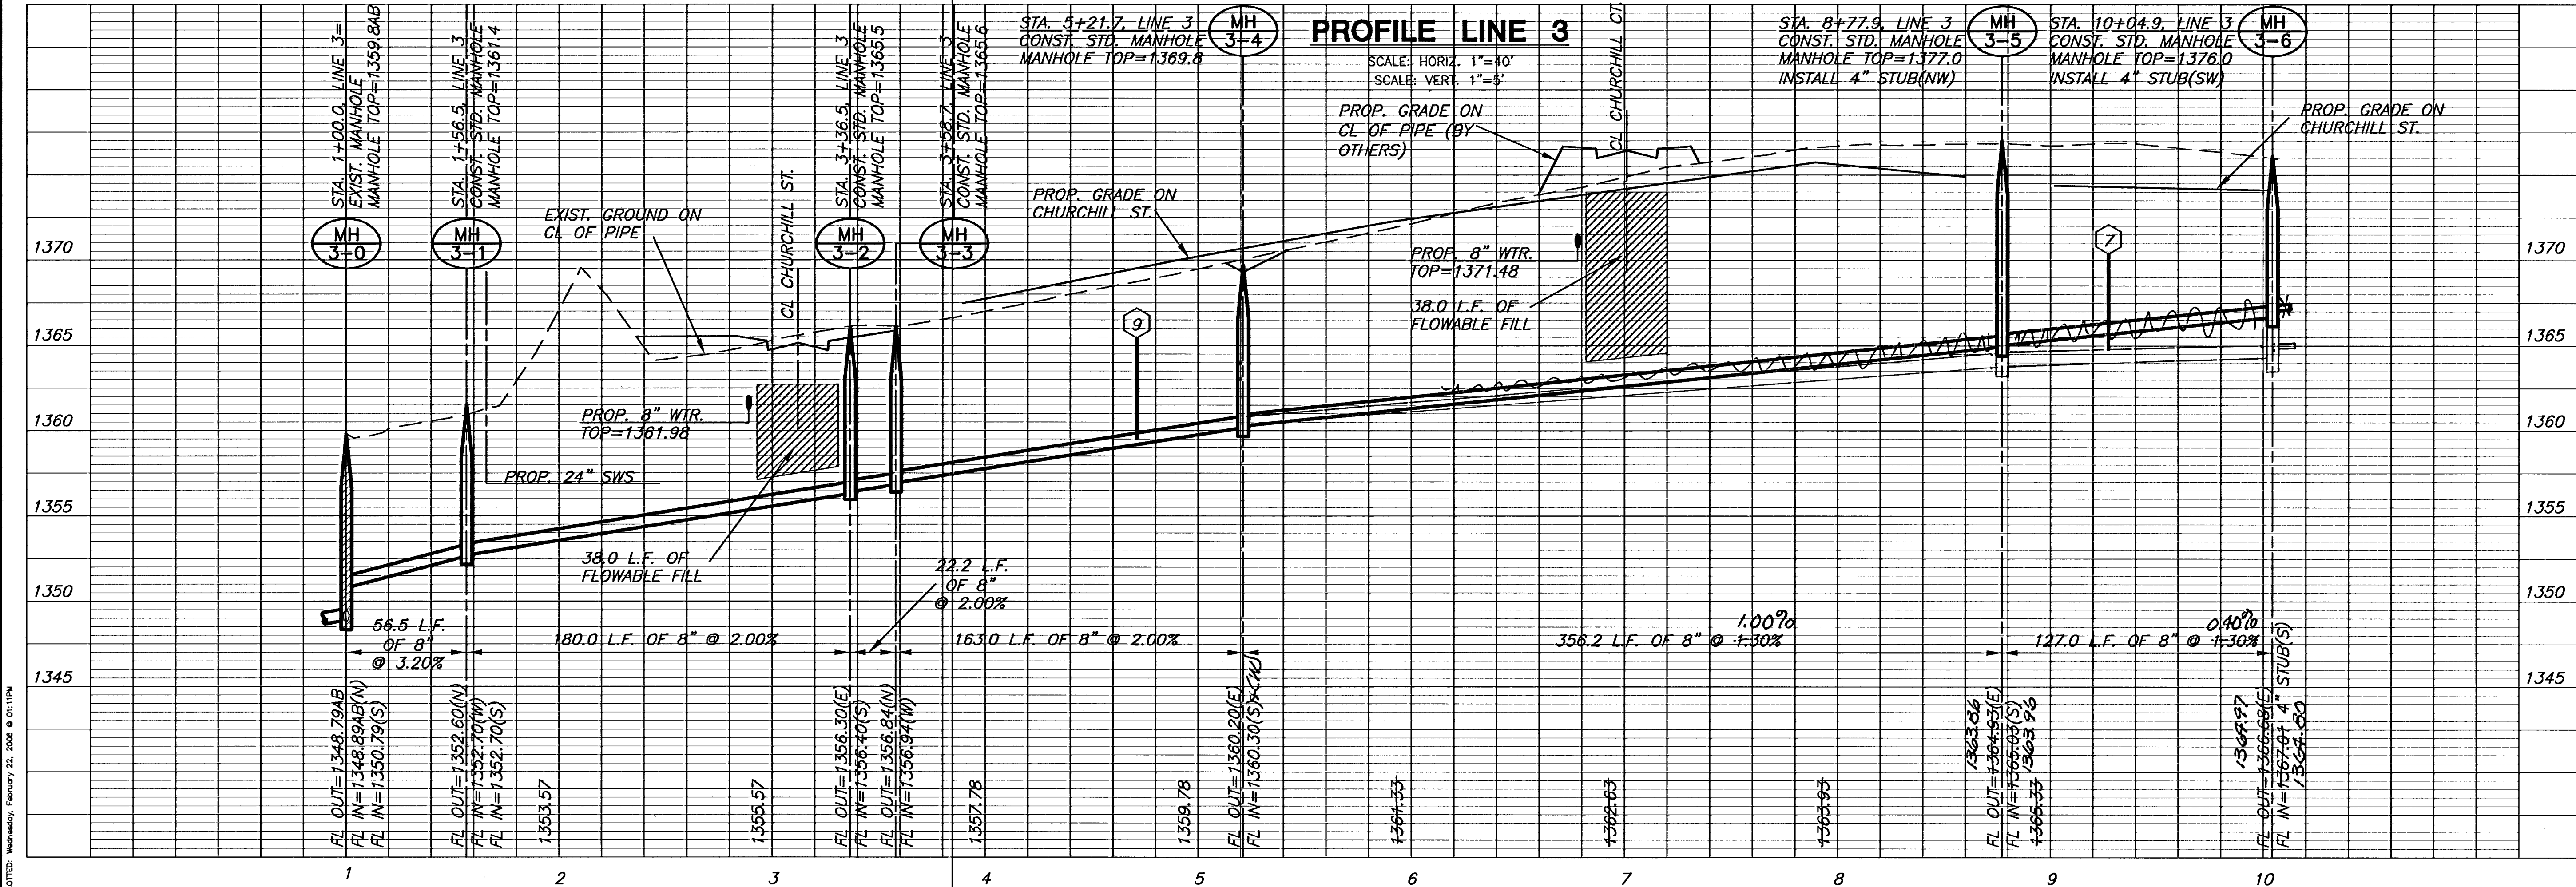

MKEC
ENGINEERING
CONSULTANTS, INC.

411 N. WEBB ROAD
WICHITA, KS. 67206
316-684-9600

SANITARY SEWER PLANS

REED'S COVE

FOURTH ADDITION

LINE 3

SHEET TITLE

448-00000

PROJECT NUMBER

SRS

DESIGN BY

DM/BFL

DRAWN BY

GJA

CHECKED BY

ISSUED

FEBRUARY 2006

REVISED

SHEET NO.

5 of 11