
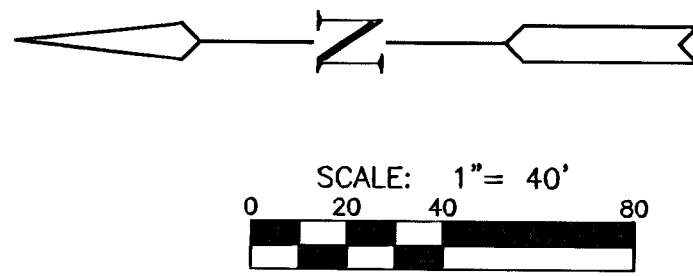


REEDS COVE ADDITION

CAUTION:
UNDERGROUND
TELEPHONE AND POWER
CABLES.

NOTE:
SEE SHEET 7 FOR RISER
TABLE.

Note: MH moved 1' west to
avoid conflict.
15' Stub out (SW)
8' Stub out area inlet on SWS (NW)

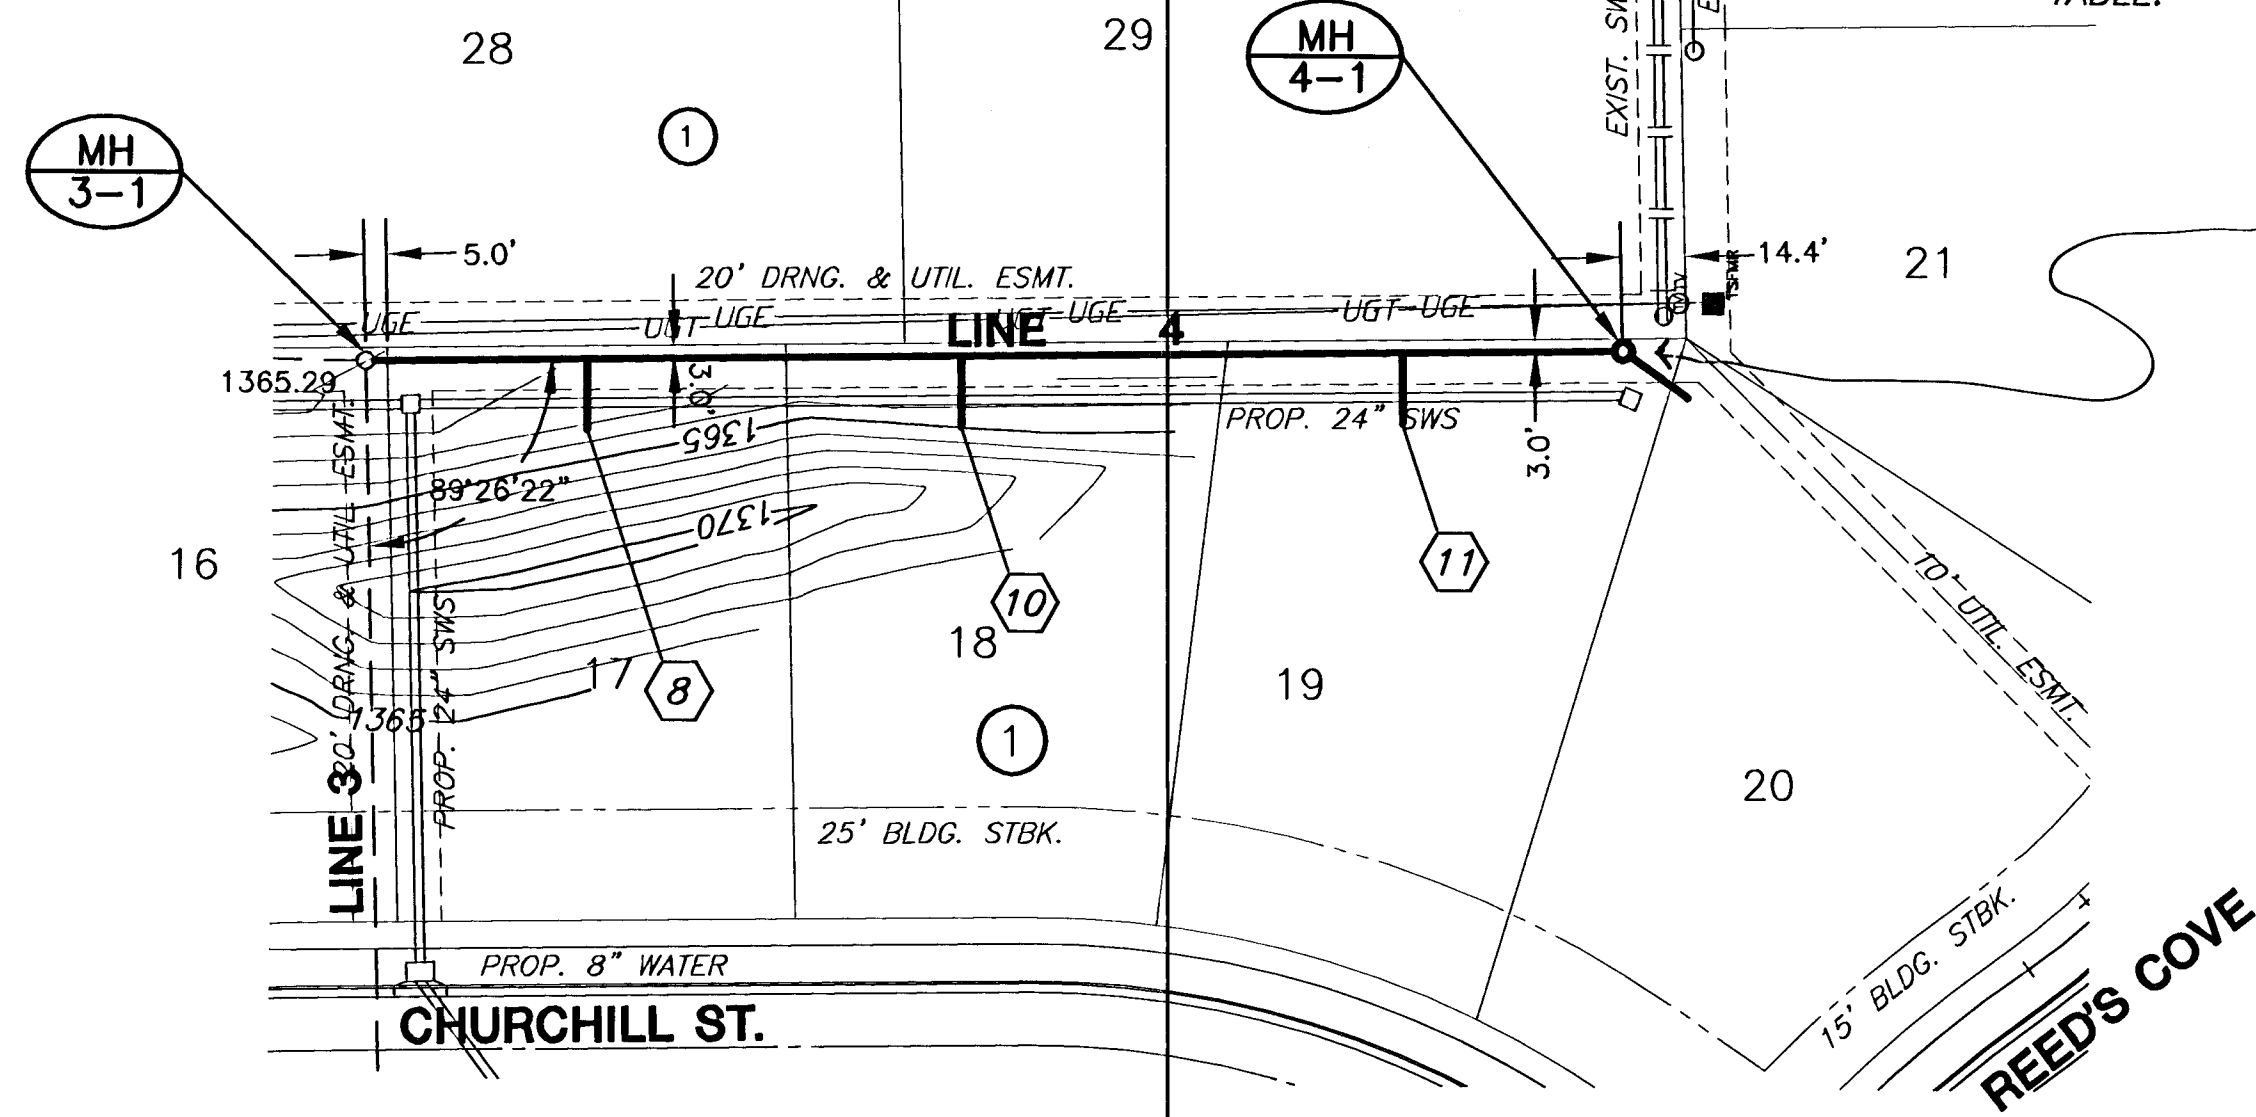


NOTE:
CONTRACTOR SHALL SUPPORT
EXISTING UTILITIES AS REQUIRED
TO CONSTRUCT SANITARY SEWER.

PLAN LINE 4

PROFILE LINE 4

SCALE: HORIZ. 1"=40'
SCALE: VERT. 1"=5'

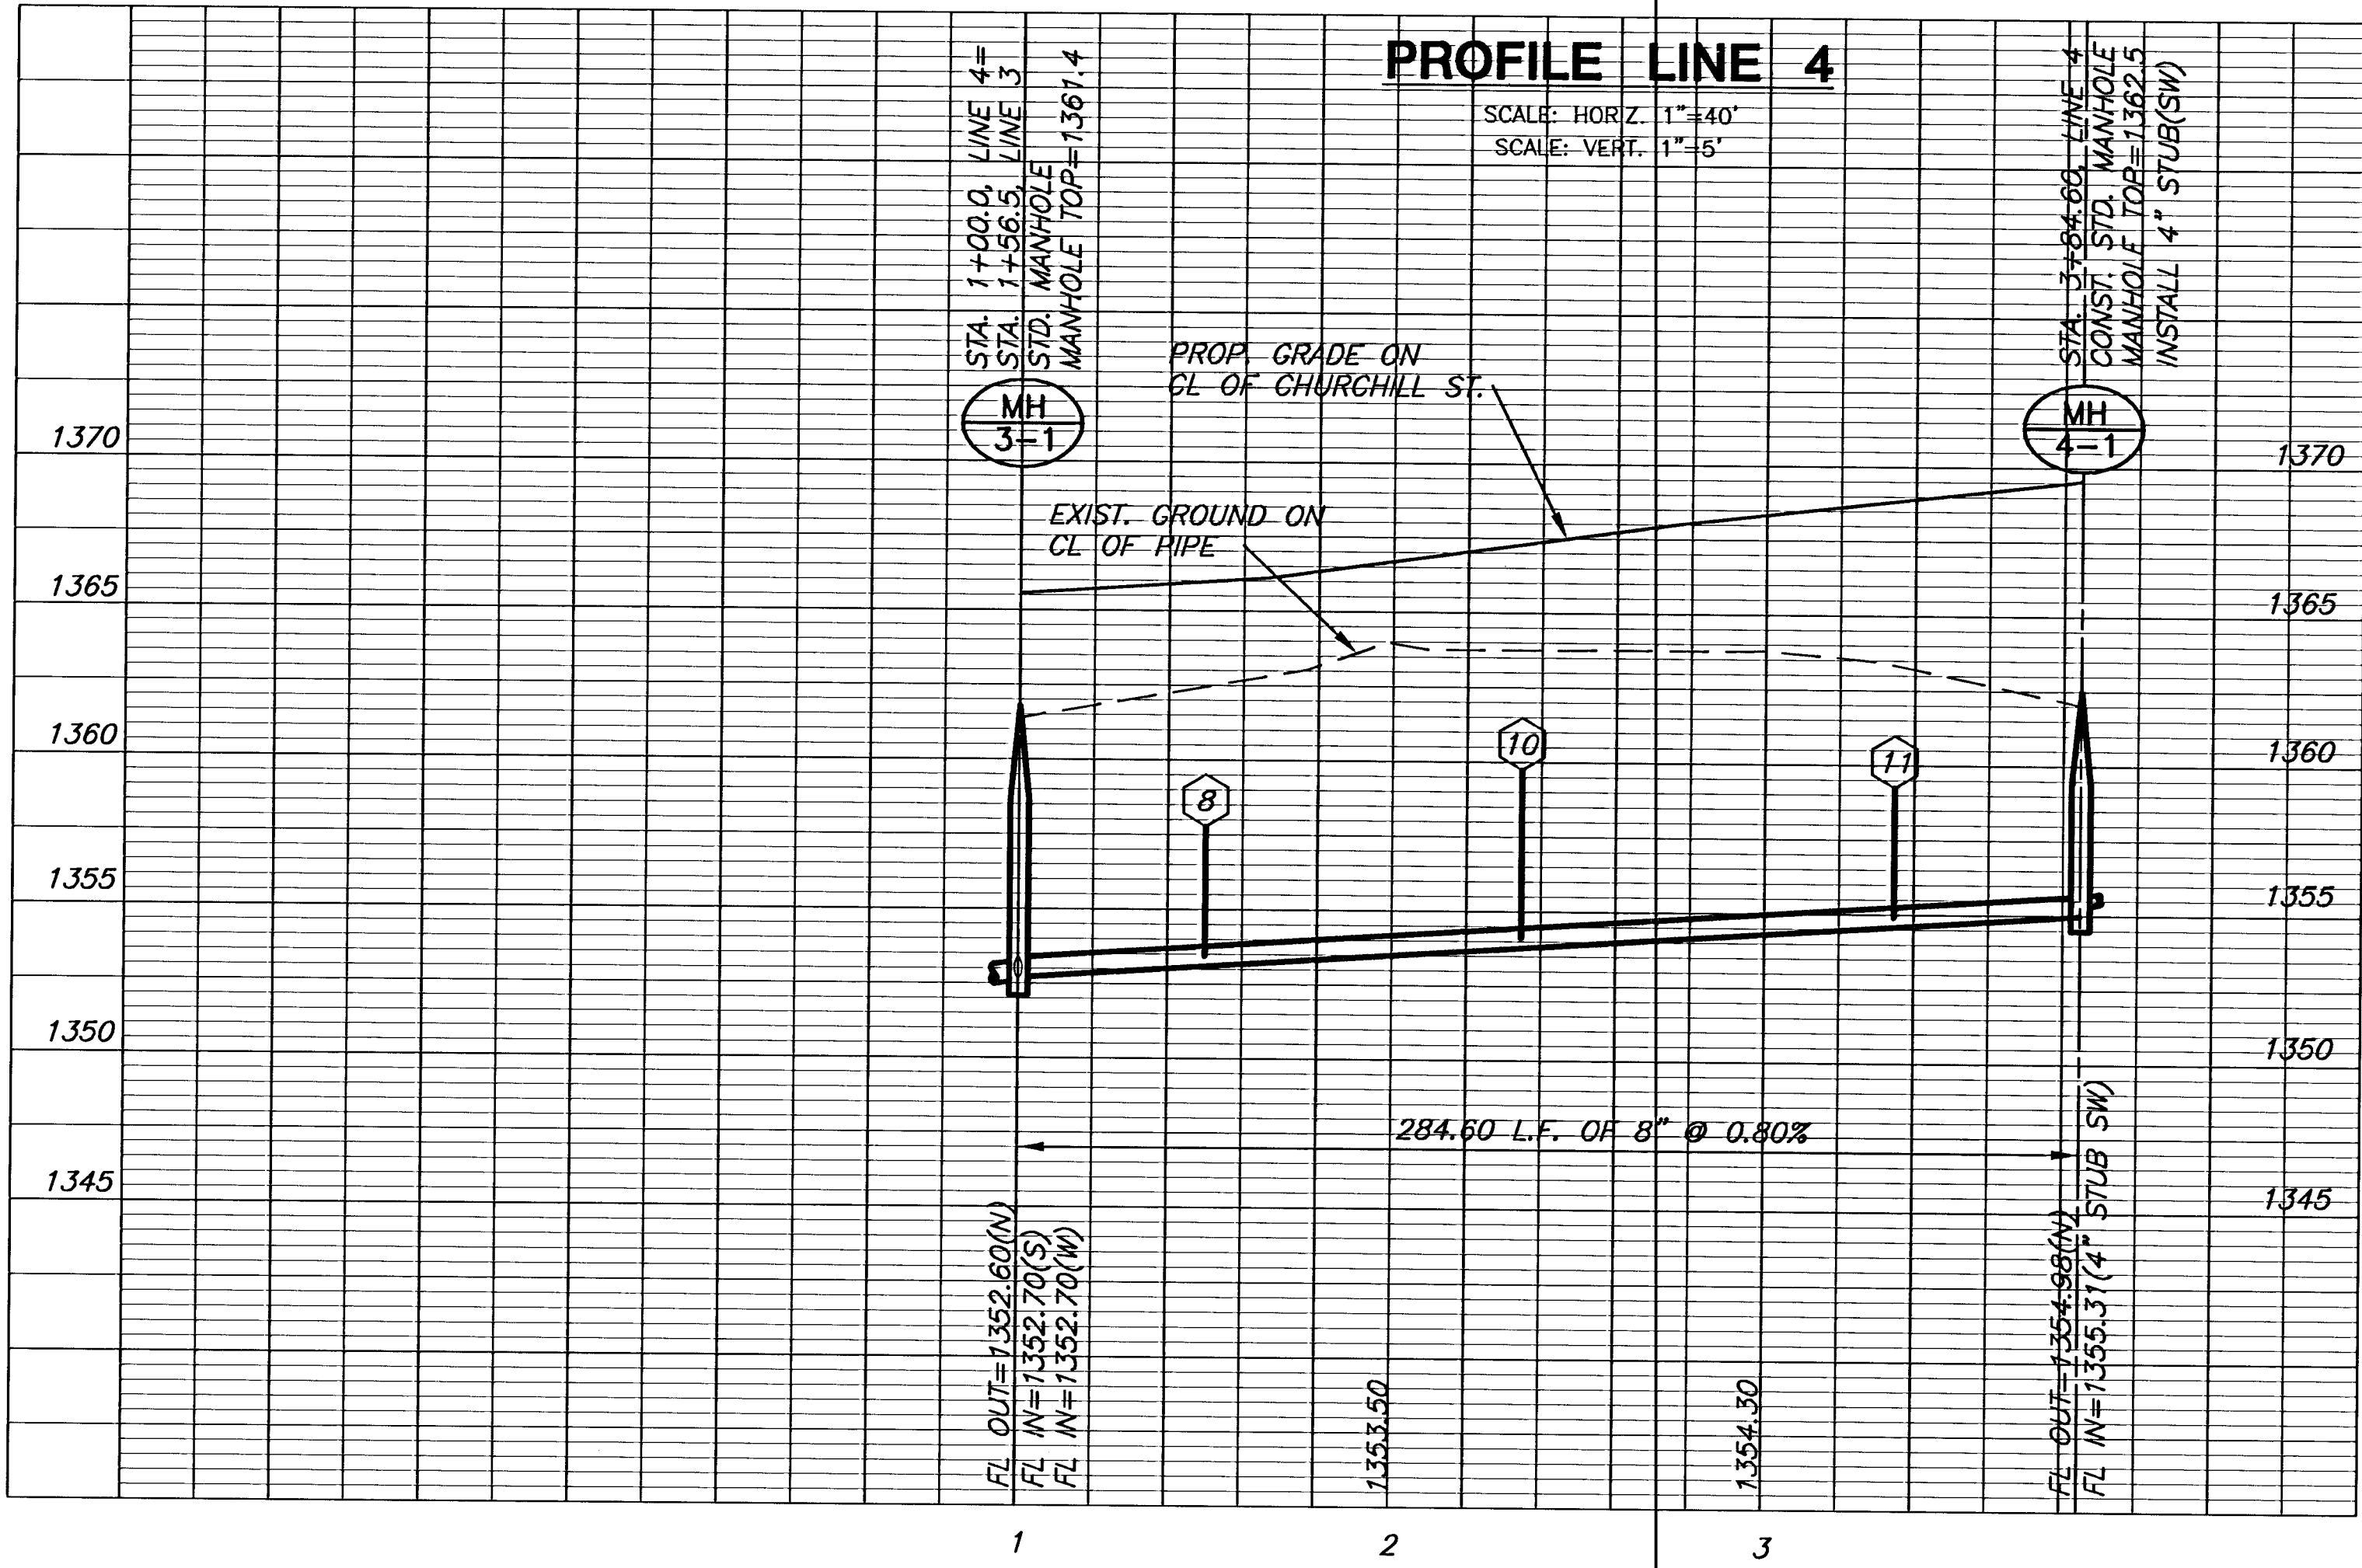

MKEC
ENGINEERING
CONSULTANTS, INC.
411 N. WEBB ROAD
WICHITA, KS. 67206
316-684-9600

SANITARY SEWER PLANS
REED'S COVE
FOURTH ADDITION

LINE 4

SHEET TITLE
448-00000
PROJECT NUMBER

DESIGN BY: SRS
DRAWN BY: DM/BFL
CHECKED BY: GJA

ISSUED: FEBRUARY 2006
REVISED:

SHEET NO.
6 of 11