
BENCHMARK:
BM #1: "□" Cut in middle of N headwall of RCBC on 21st St. North. 1004.3' W & 22.1' N of SE Cor., SE1/4, Sec. 2, T-27-S, R-2-E.
Elev. = 173.23 City Datum

BM #2: "□" Cut at the SE corner of the intersection of Castle Rock & Castle Rock Ct., Krug North Addition.
Elev. = 183.50 City Datum

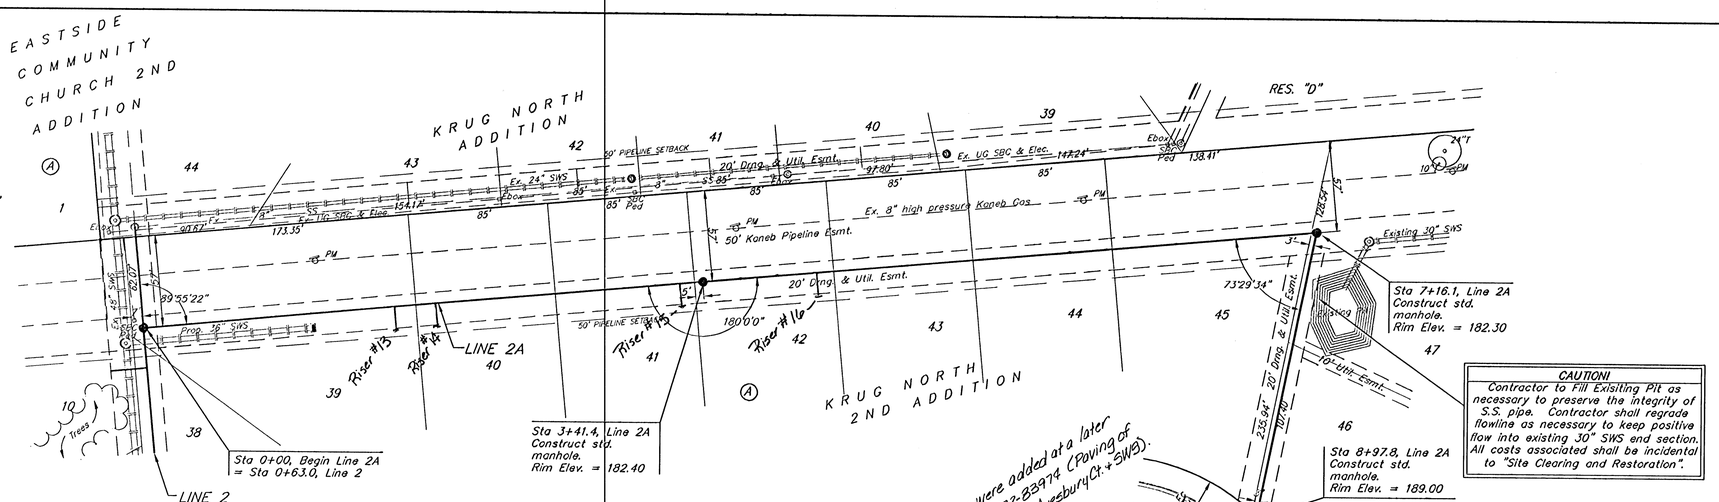


CAUTION!
Contractor to Fill Exisiting Pit as necessary to preserve the integrity of S.S. pipe. Contractor shall regrade flowline as necessary to keep positive flow into existing 30" SWS end section. All costs associated shall be incidental to "Site Clearing and Restoration".

SEWER SERVICE TABLE

NUMBER	TYPE	Location			Station \ Direction	DISTANCE FROM		
		Lot No.	Block No.	Line No.		Main to Riser	Upstream MH	Downstream MH
13	8" X 4" Tee	39	A	2A	1+66.4/Rt	14'	186.00'	155.9'
14	8" X 4" Tee	40	A	2A	1+87.5/Rt	13.8'	178.60'	176.2'
15	8" X 4" Tee	41	A	2A	3+38.2/Rt	13.6'	14.90'	336.9'
16	8" X 4" Tee	42	A	2A	4+03.2/Rt	14.8'	294.00'	70.30'

Note: These risers were added at a later date with project #472-83974 (Paving of Castle Rock, Burning Tree, Aylesbury Ct. & SWS).

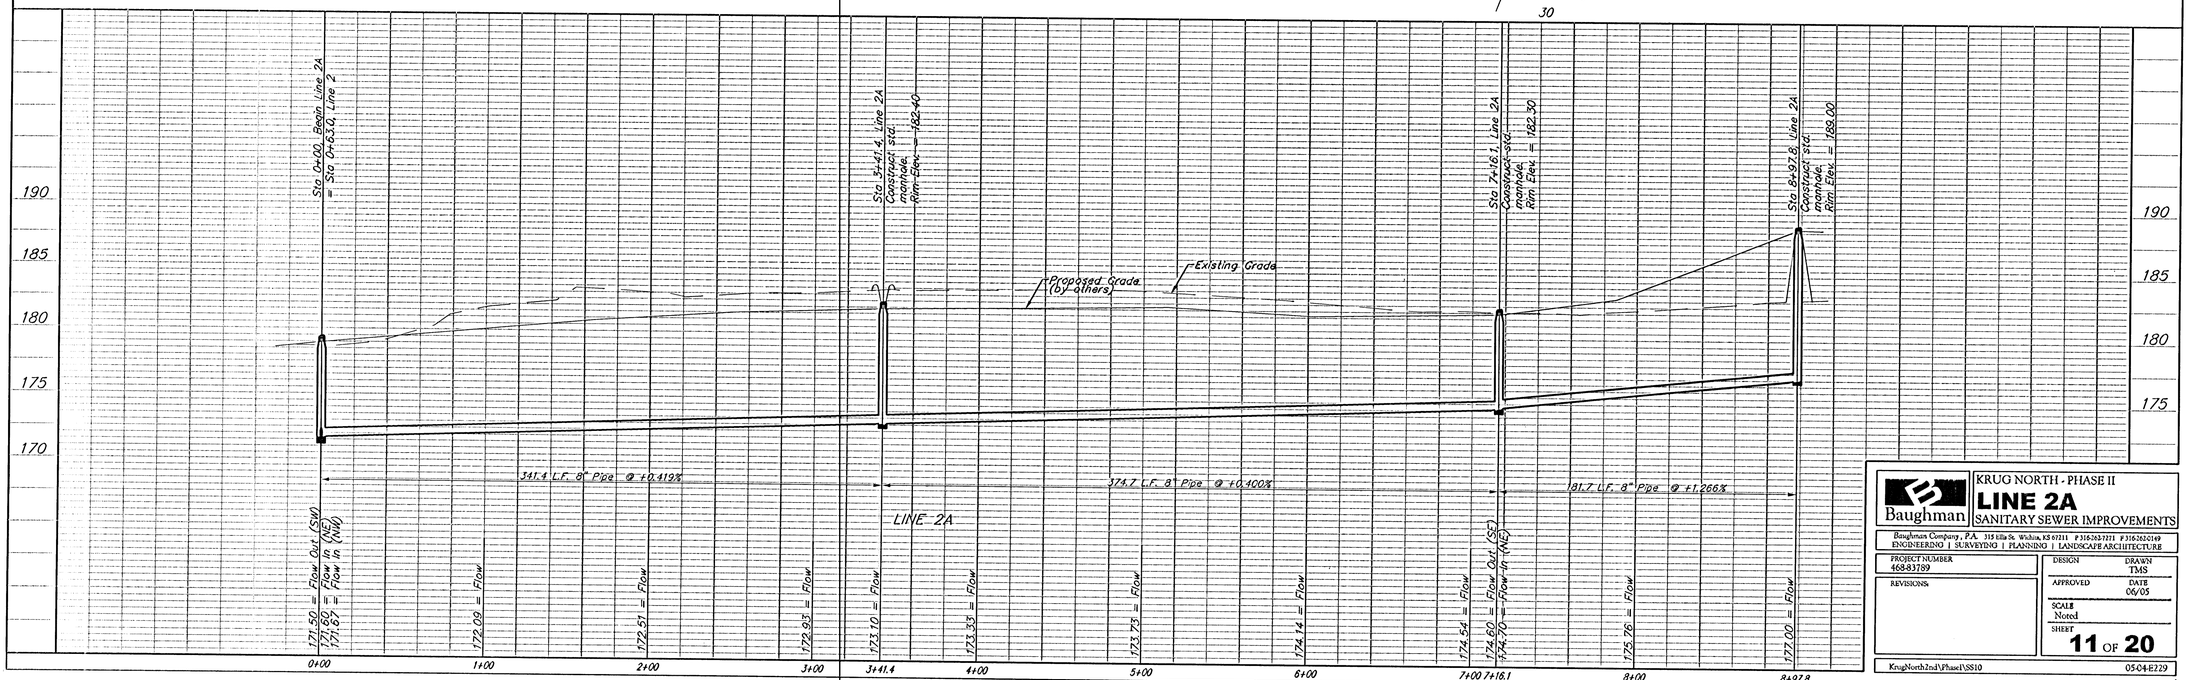

Baughman
Baughman Company, P.A. 315 Ellis St. Wichita, KS 67211 P 3162632771 F 3162632149
ENGINEERING | SURVEYING | PLANNING | LANDSCAPE ARCHITECTURE

KRUG NORTH - PHASE II
LINE 2A
SANITARY SEWER IMPROVEMENTS

PROJECT NUMBER 468-83789
DESIGN TMS
DRAWN TMS
APPROVED
DATE 06/05
REVISIONS
SCALE Noted
SHEET **11** OF **20**

KrugNorth2nd\Phase1\SS10 05-04-E229