
83803

MAIN 16
OF THE
FOUR MILE CREEK SEWER
IN
THE CITY OF WICHITA

OCA NO. 744115
CITY OF WICHITA PROJECT NO. 468-83803
JAMES L. ARMOUR, P.E. - CITY ENGINEER

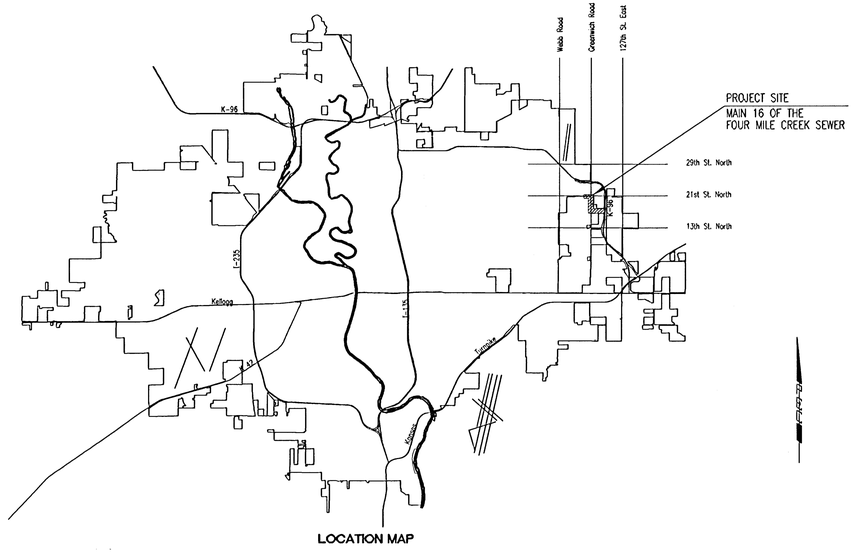

LOCATION MAP

INDEX OF SHEETS

SHEET NO. 1	TITLE SHEET
SHEET NO. 2	KEY MAP AND GENERAL NOTES
SHEET NO. 3	HORIZONTAL/VERTICAL CONTROL
SHEET NO. 4-13	PLAN/PROFILE
SHEET NO. 14	PUMP STATION DEMOLITION AND GRADING PLAN
SHEET NO. 15	PUMP STATION ABANDONMENT
SHEET NO. 16	FORCE MAIN ABANDONMENT AND MISCELLANEOUS DETAILS
SHEET NO. 17-19	PLATS
SHEET NO. 20	TYPE "P" MANHOLE DETAILS
SHEET NO. 21	FRAME & COVER DETAILS
SHEET NO. 22	RISER DETAILS
SHEET NO. 23-26	SOIL EROSION BMP DETAILS

Mies Construction, Inc. - Contractor
Strothman, City - Inspector
Released 12/5/05
As-Built
Stubs
.pdf by JDL 3/8/06

MAY 2005

PLANS PREPARED BY
PROFESSIONAL ENGINEERING CONSULTANTS, P.A.
ENGINEERS
WICHITA, KANSAS

MICHAEL D. KRUSE
13944
5/27/05
KANSAS
PROFESSIONAL ENGINEER

DSNR: MDK OPER: JAC SCALE: 1=1.00
Q:\2004\04219\002\SSTITLE 05-24-2005 03:09:33 pm