
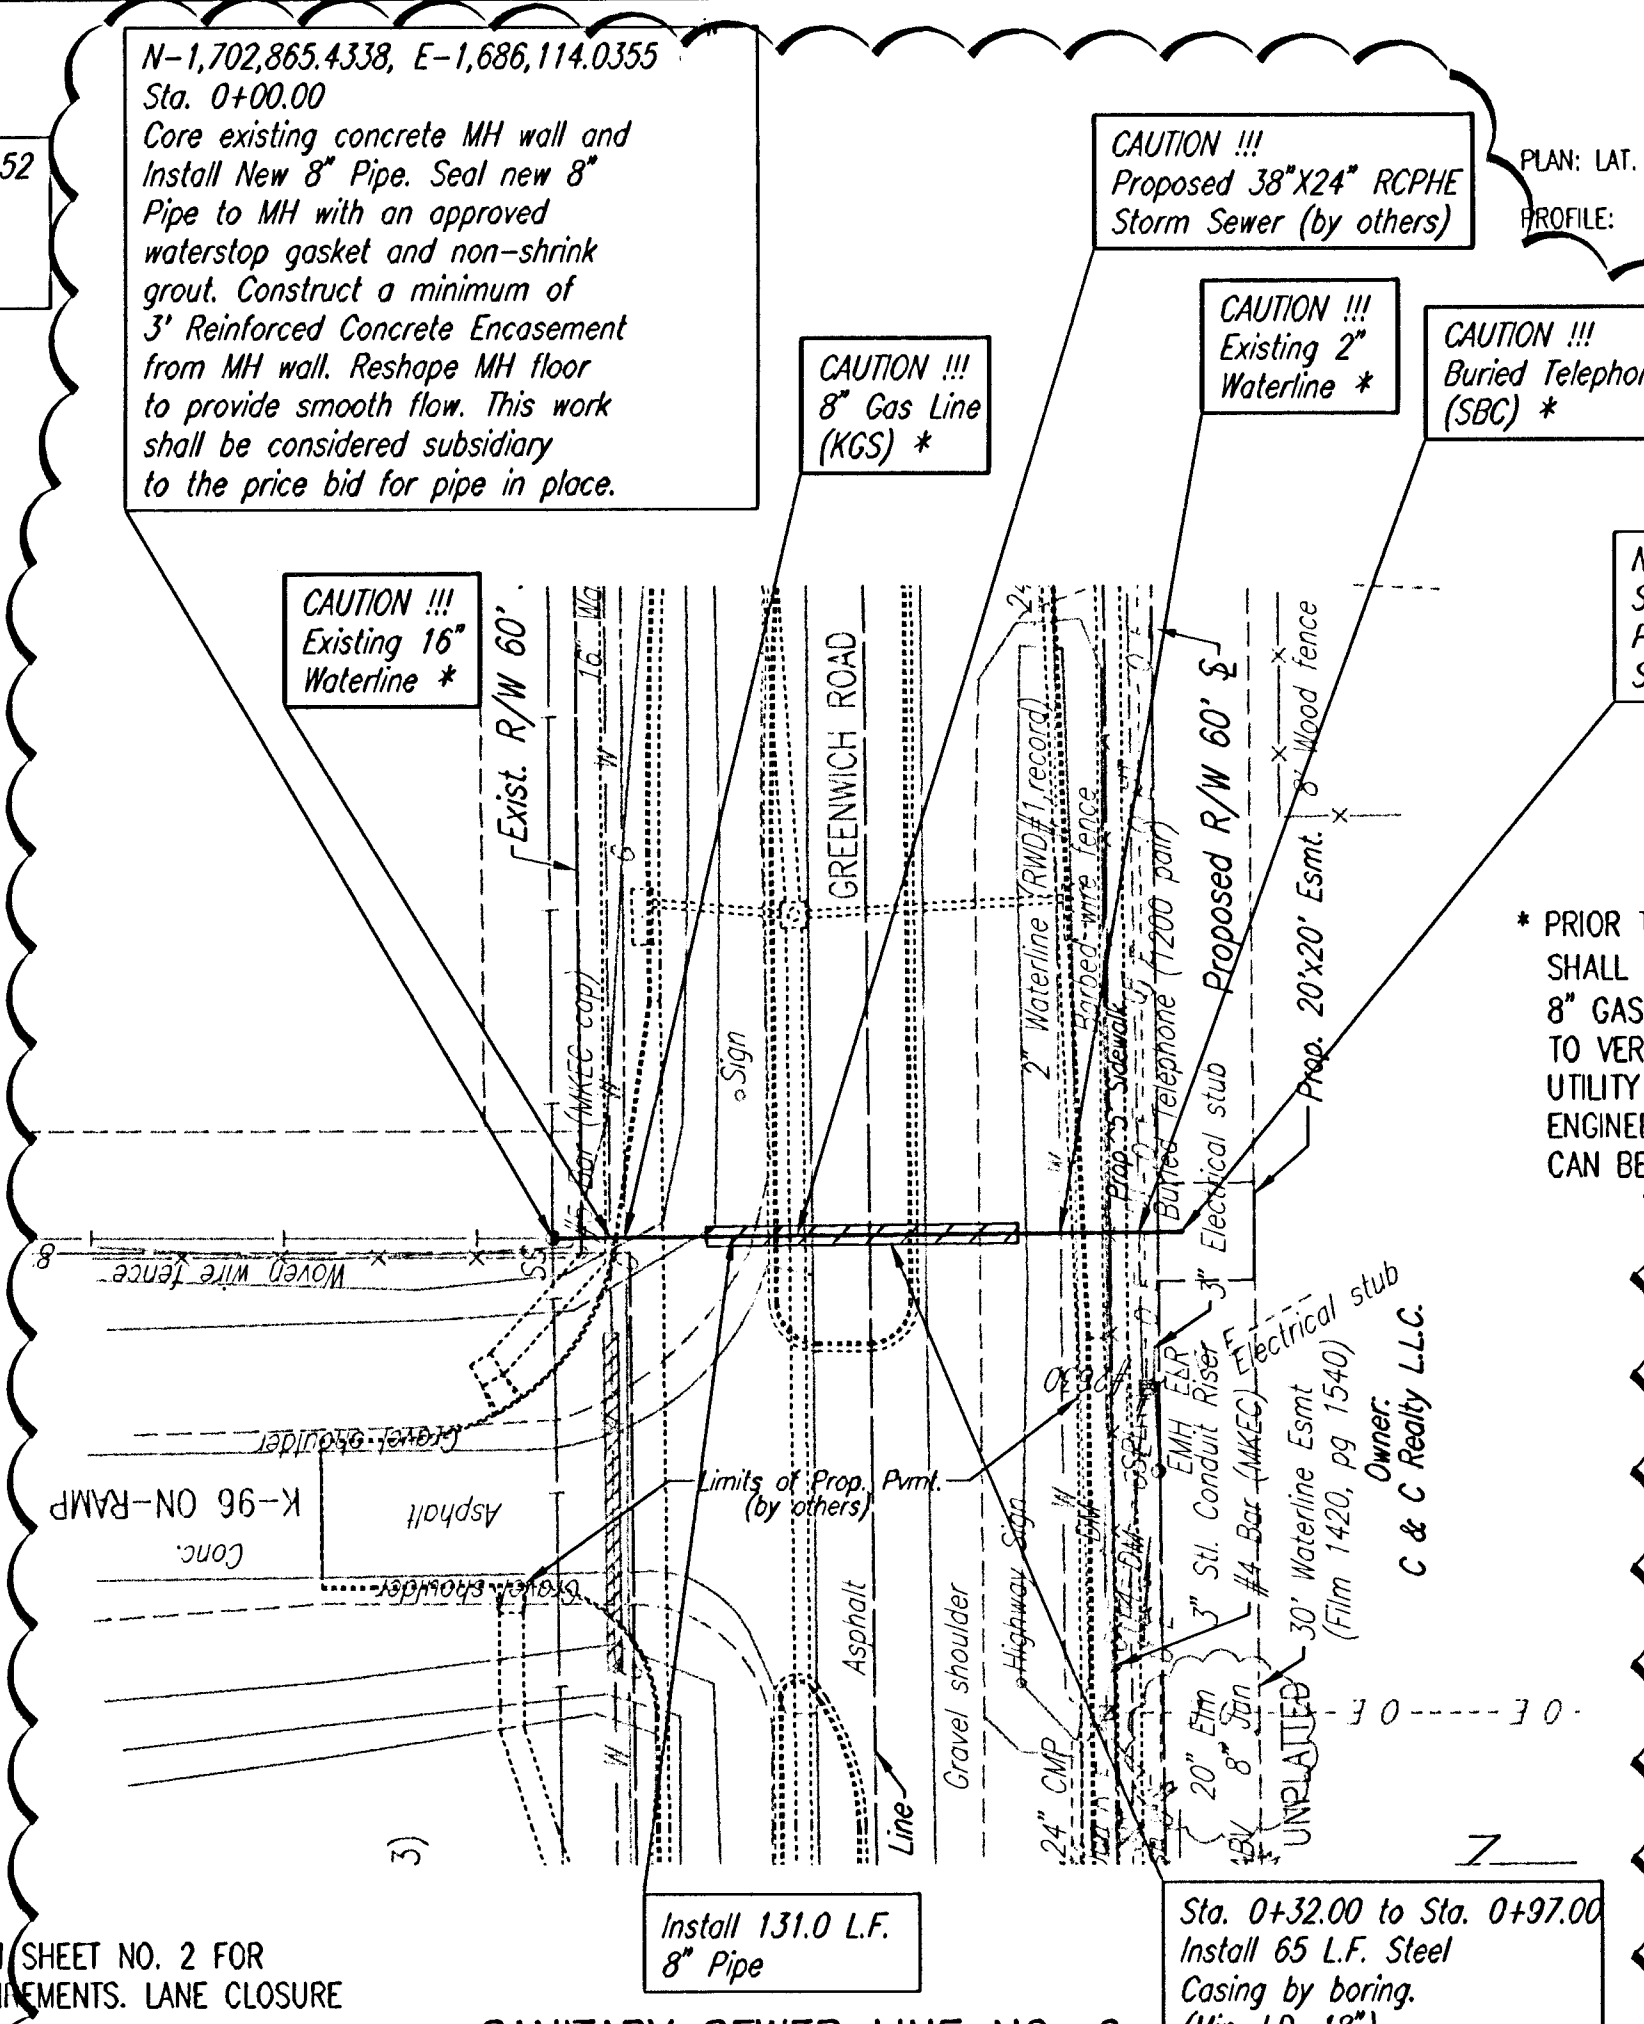
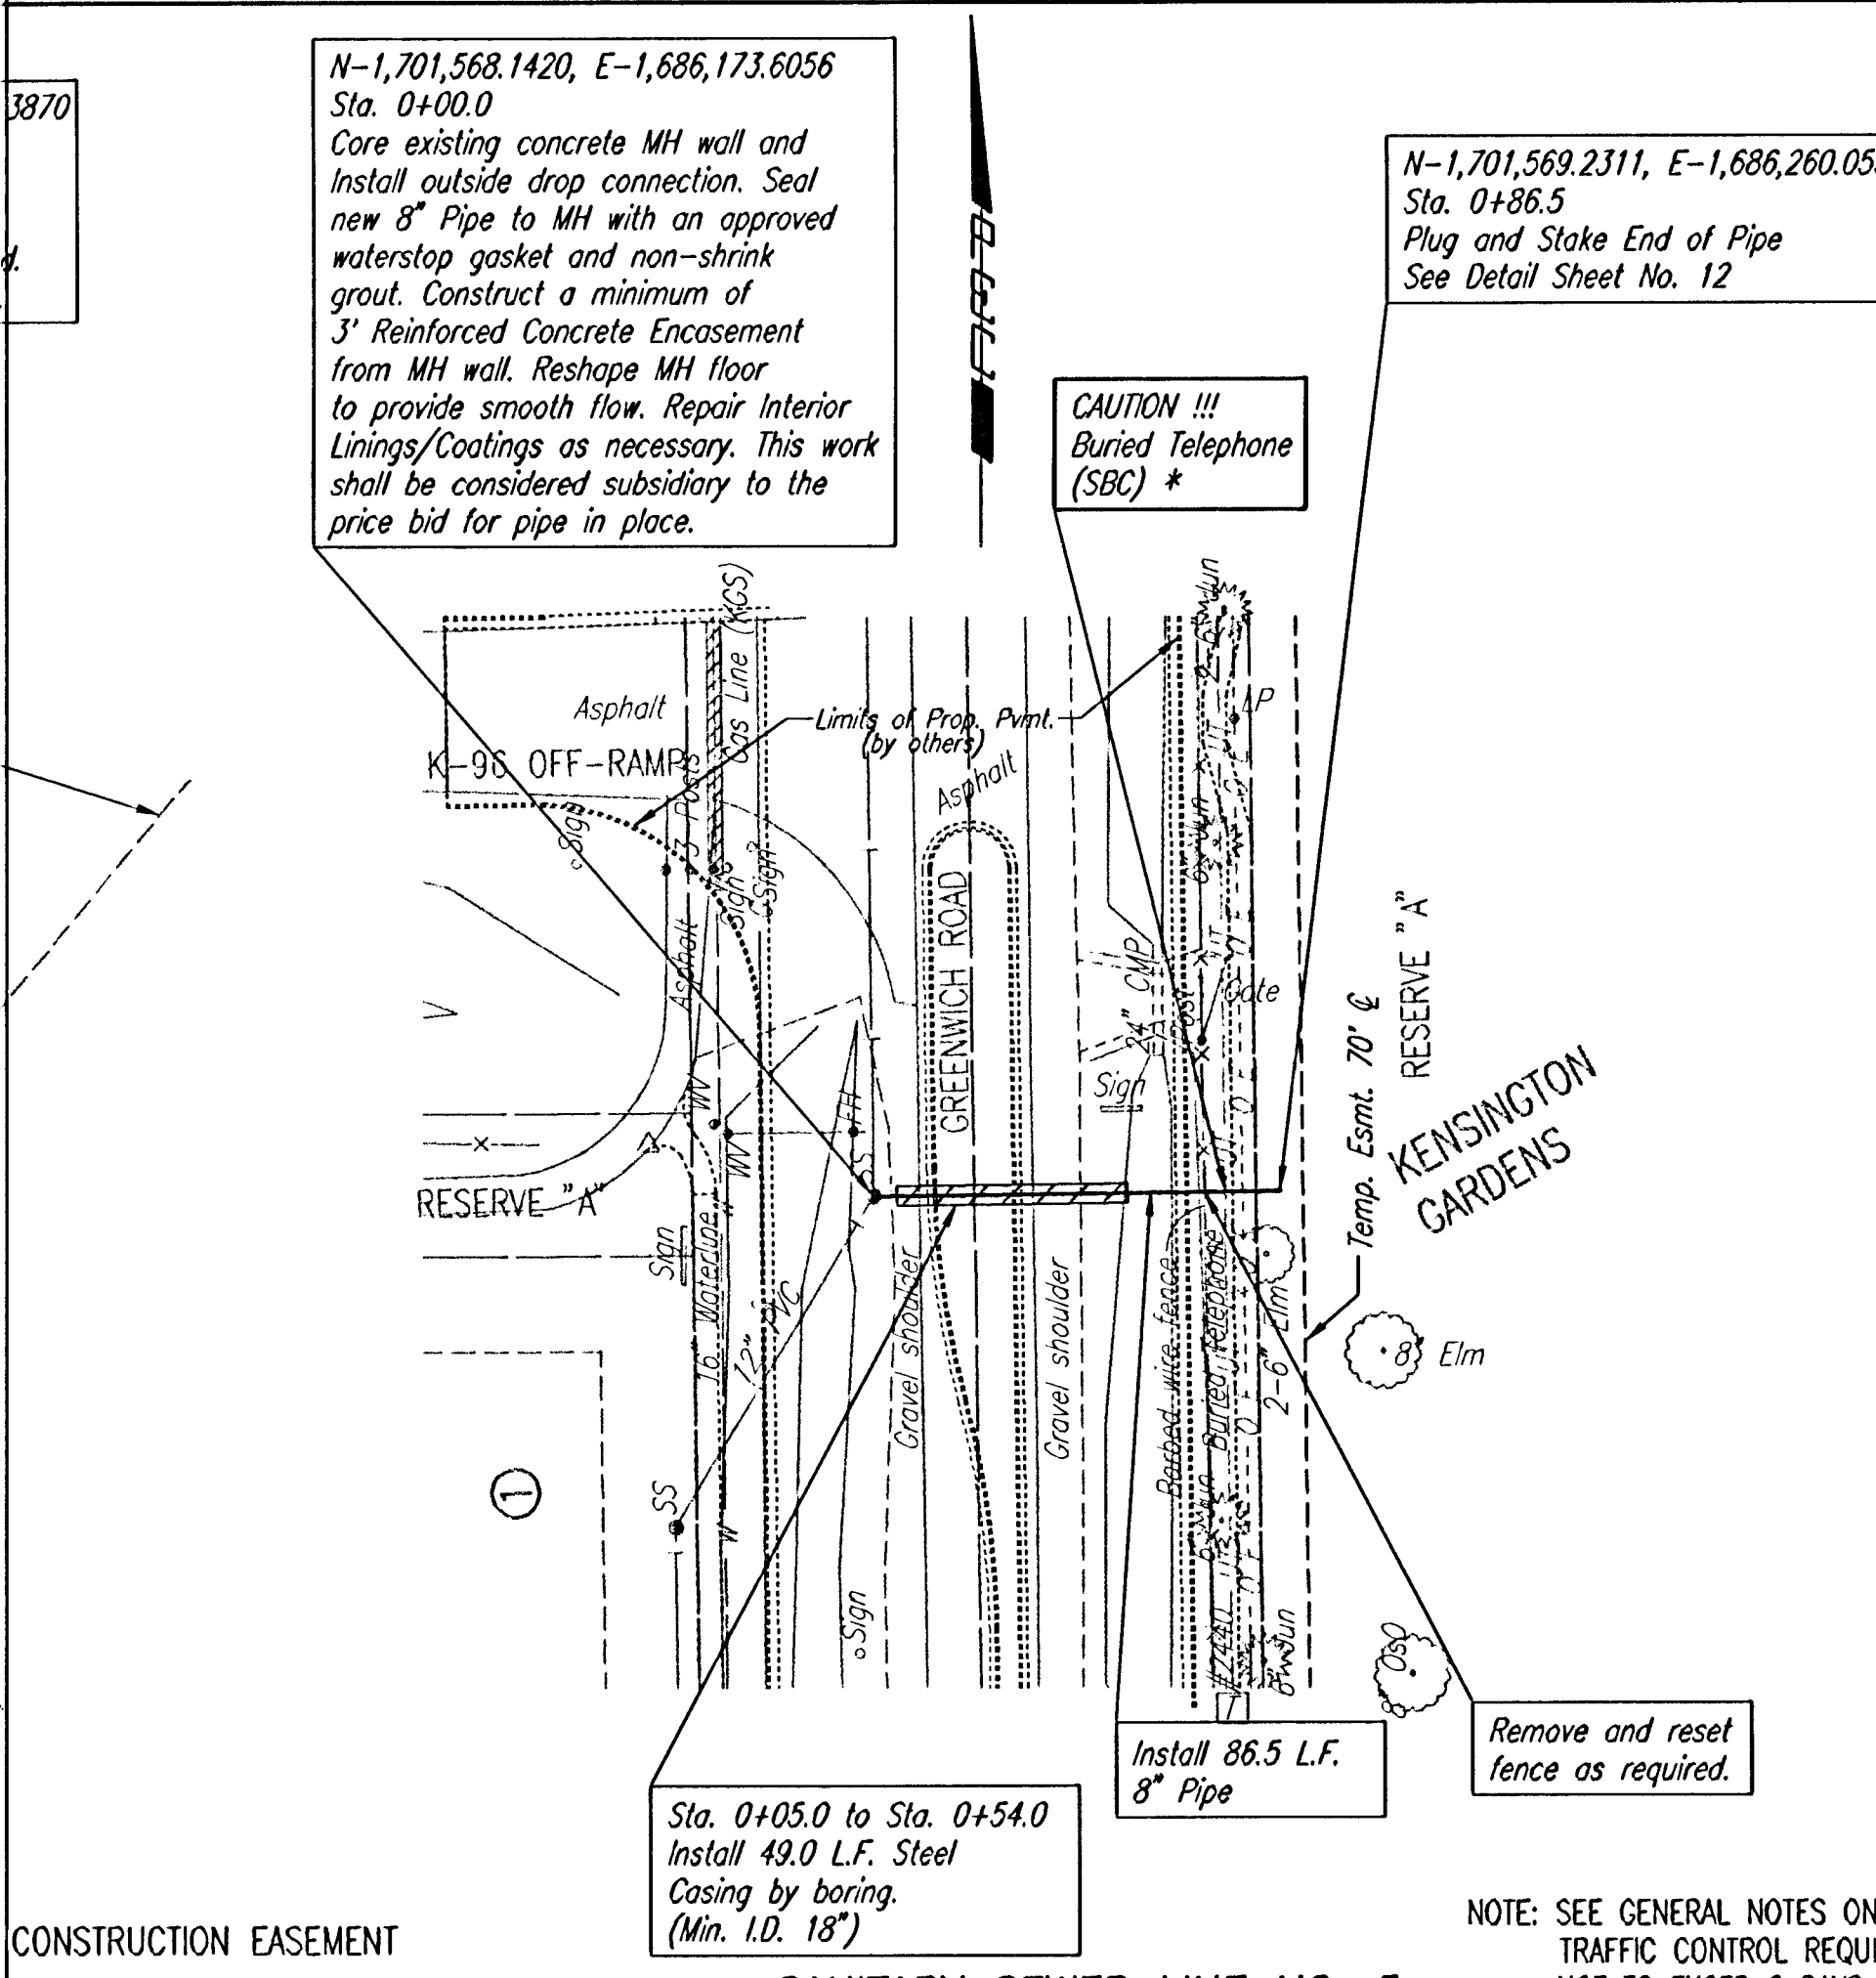


PLAN	CHECKED	DATE

PROFILE	CHECKED	DATE

DSNR, MDK OPER. CSI, SCALE: 1"=40.00
 C:\2004\0421\02\SSP10 ChangeOrder\09-19-2005 05:02:06 pm



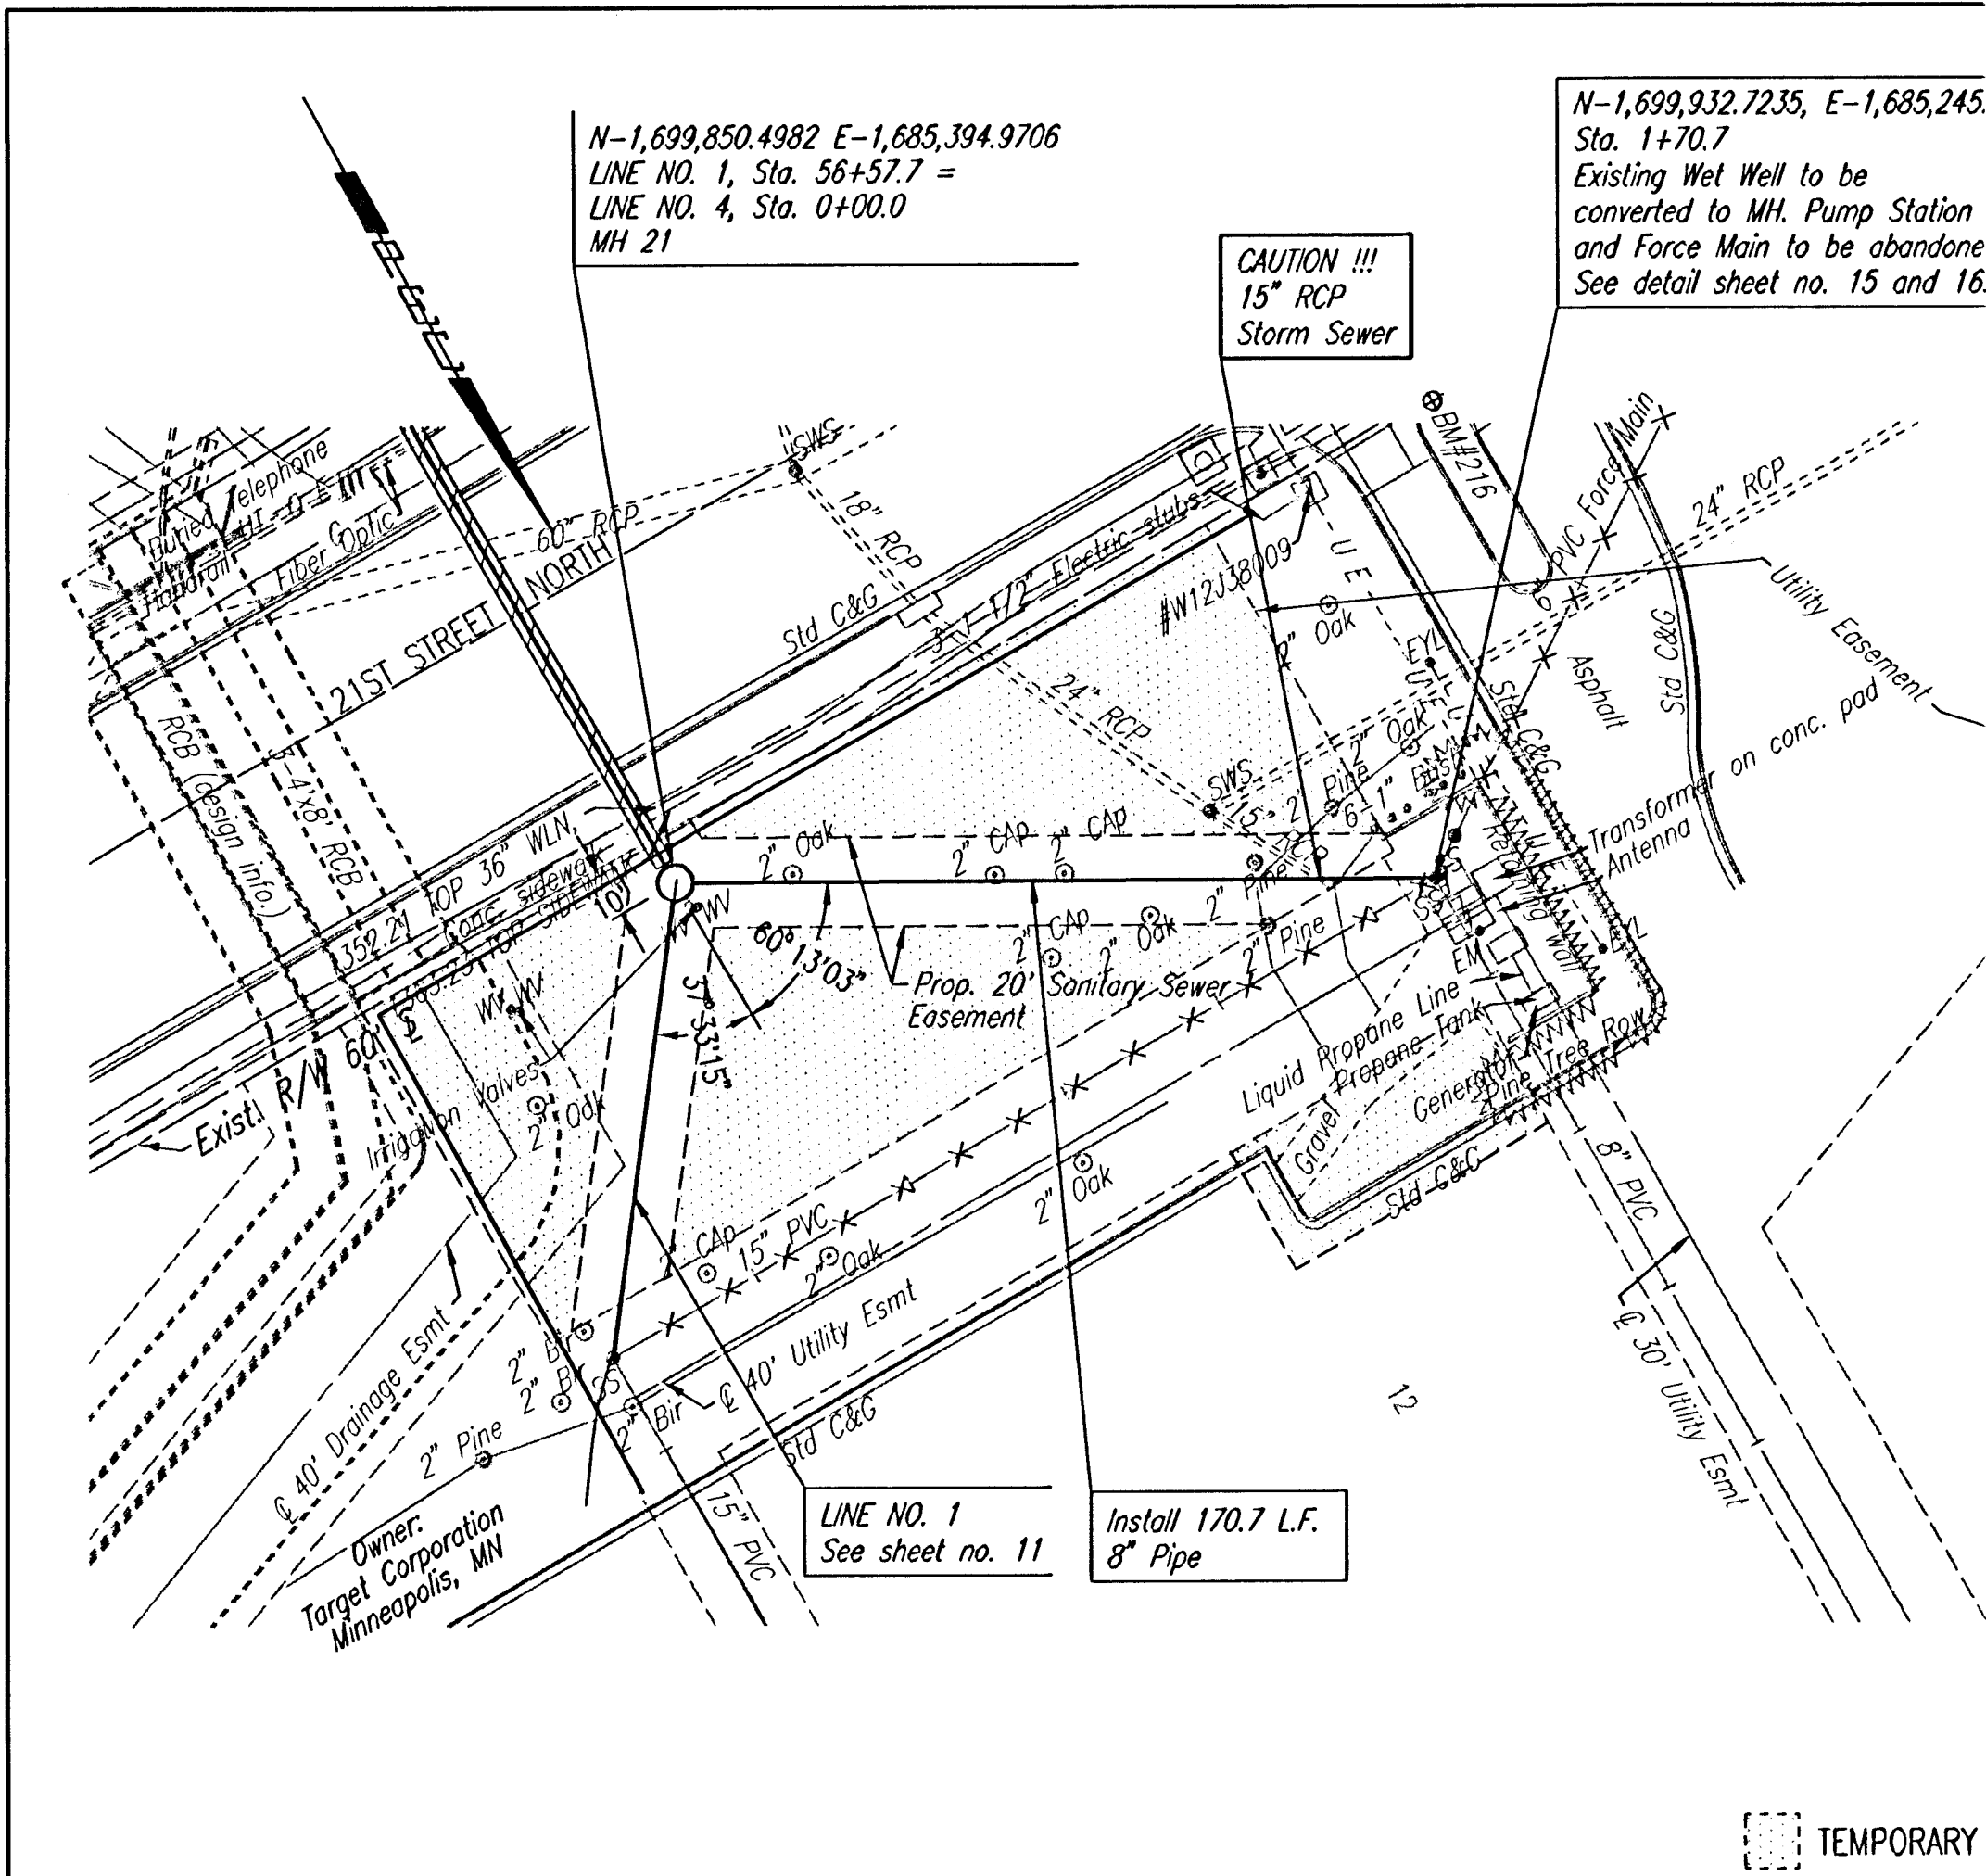


SCALE: 1"=40'

PLAN: LAT. & LONG. 0 40 80
 PROFILE: HORIZ. SAME AS ABOVE

* PRIOR TO BEGINNING CONSTRUCTION, THE CONTRACTOR SHALL EXCAVATE THE EXISTING 2" AND 16" WATERLINES, 8" GAS LINE, BURIED TELEPHONE AND BURIED ELECTRIC TO VERIFY ITS HORIZONTAL AND VERTICAL LOCATION. THE UTILITY LOCATIONS SHALL BE REPORTED TO THE ENGINEER SO THAT ANY NECESSARY PLAN MODIFICATIONS CAN BE MADE.

13944
 9/19/05
 KANSAS
 PROFESSIONAL ENGINEER

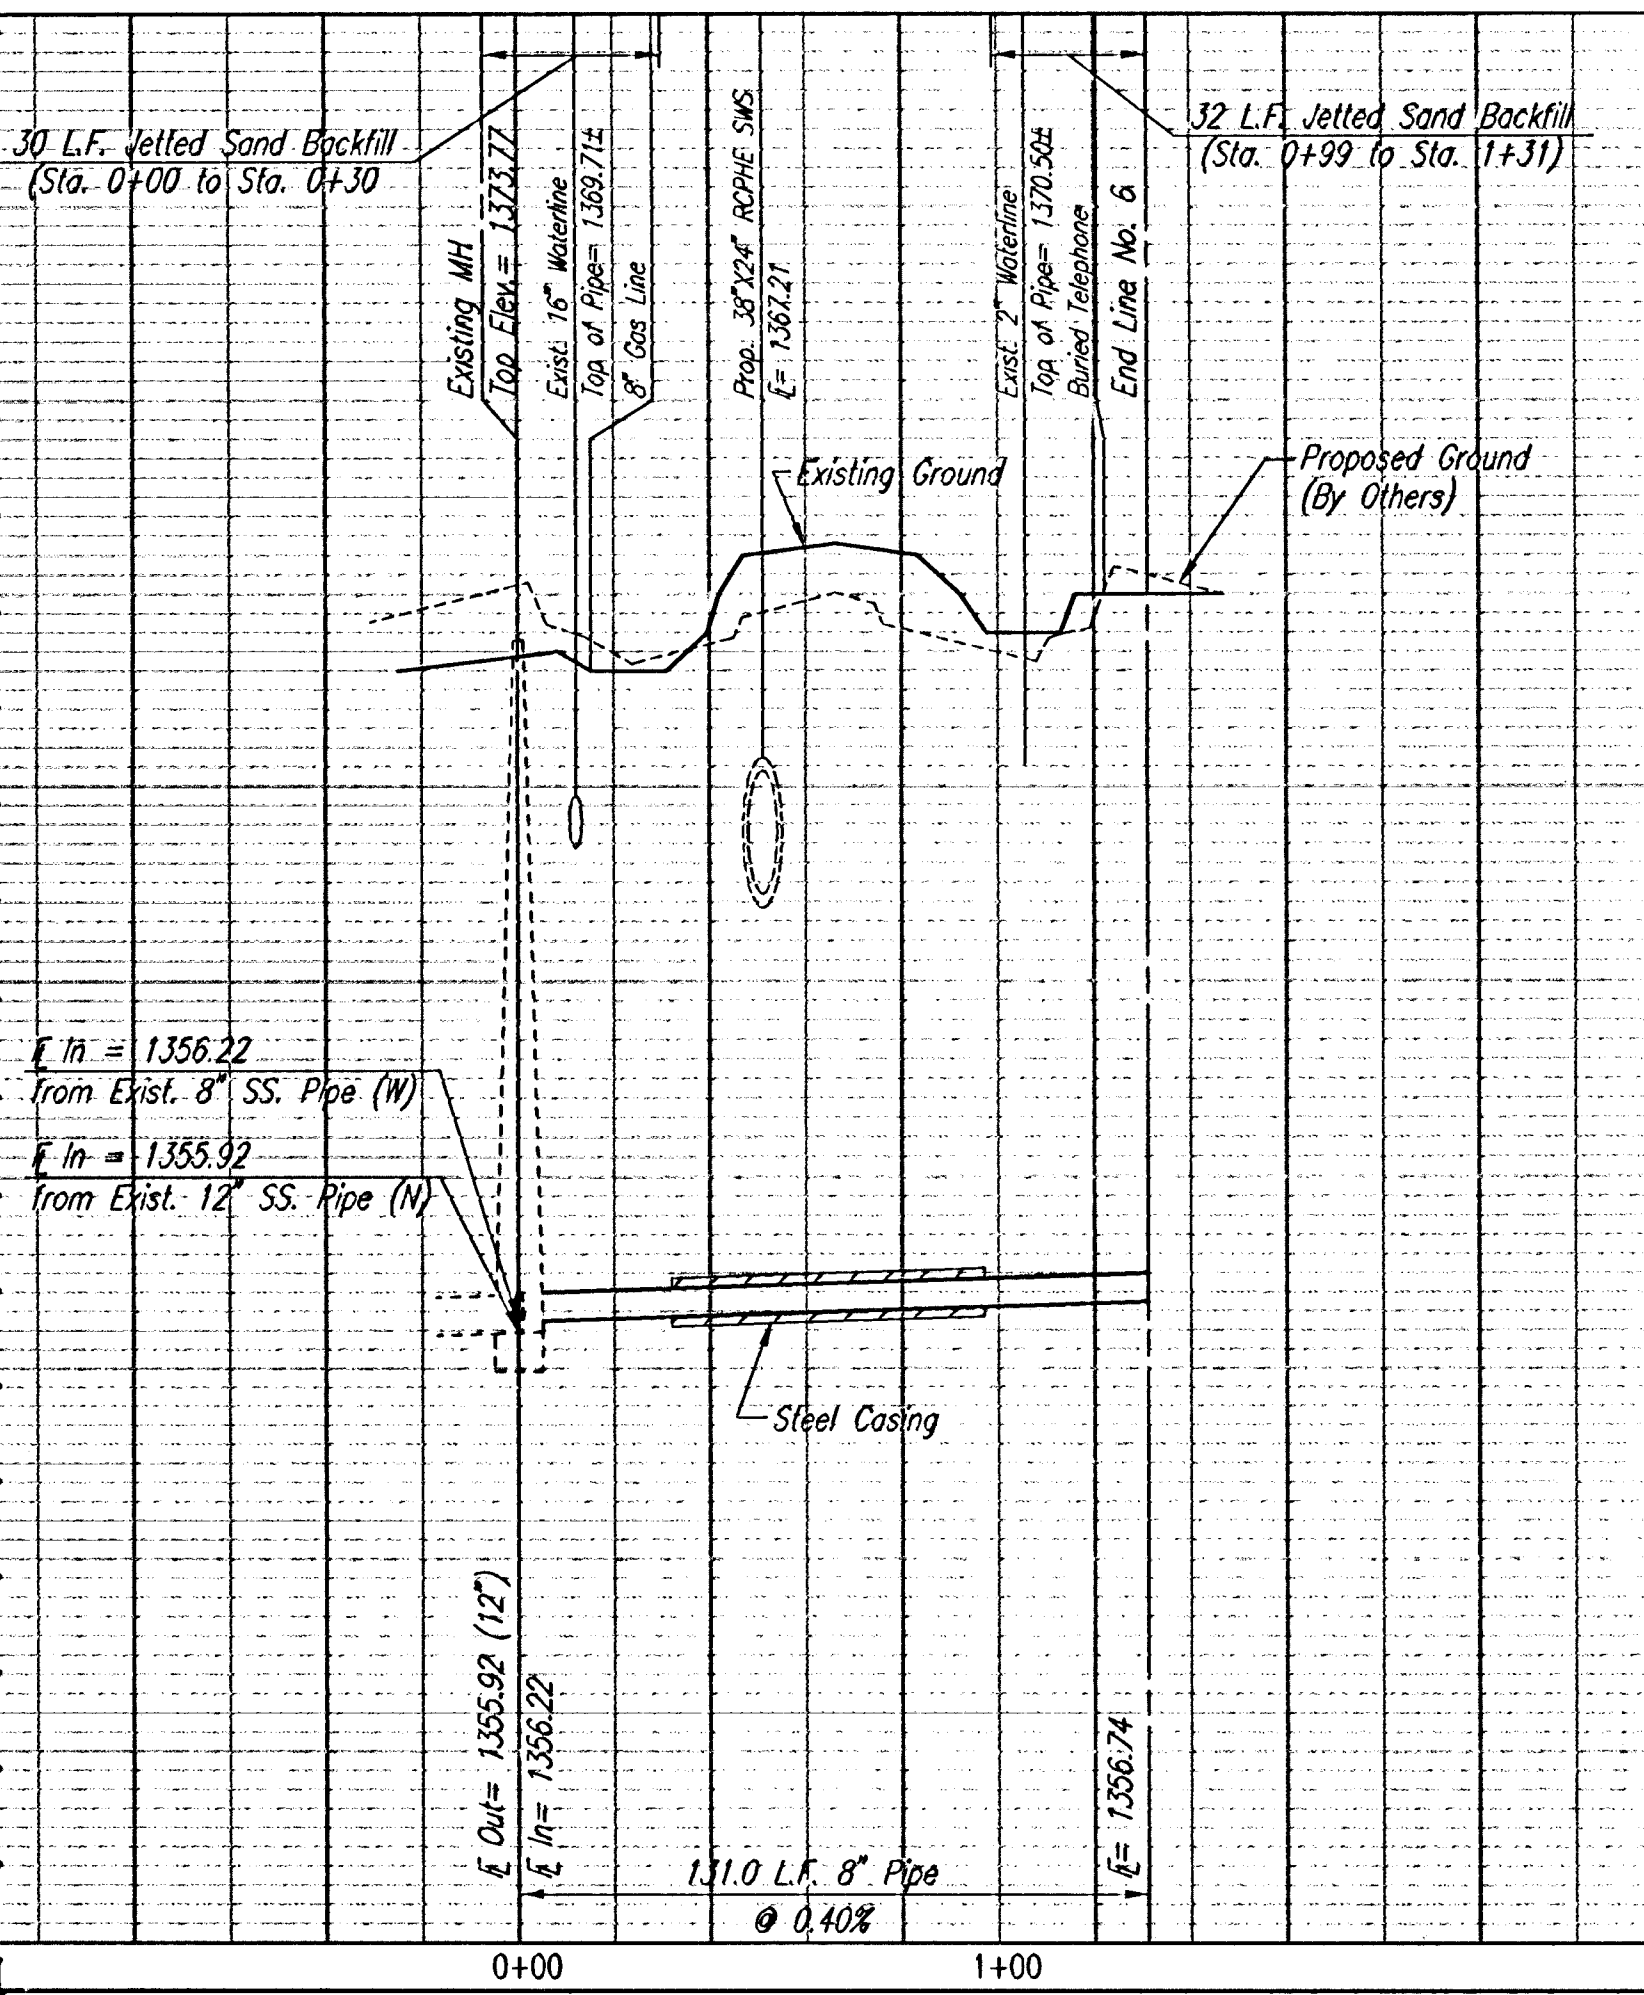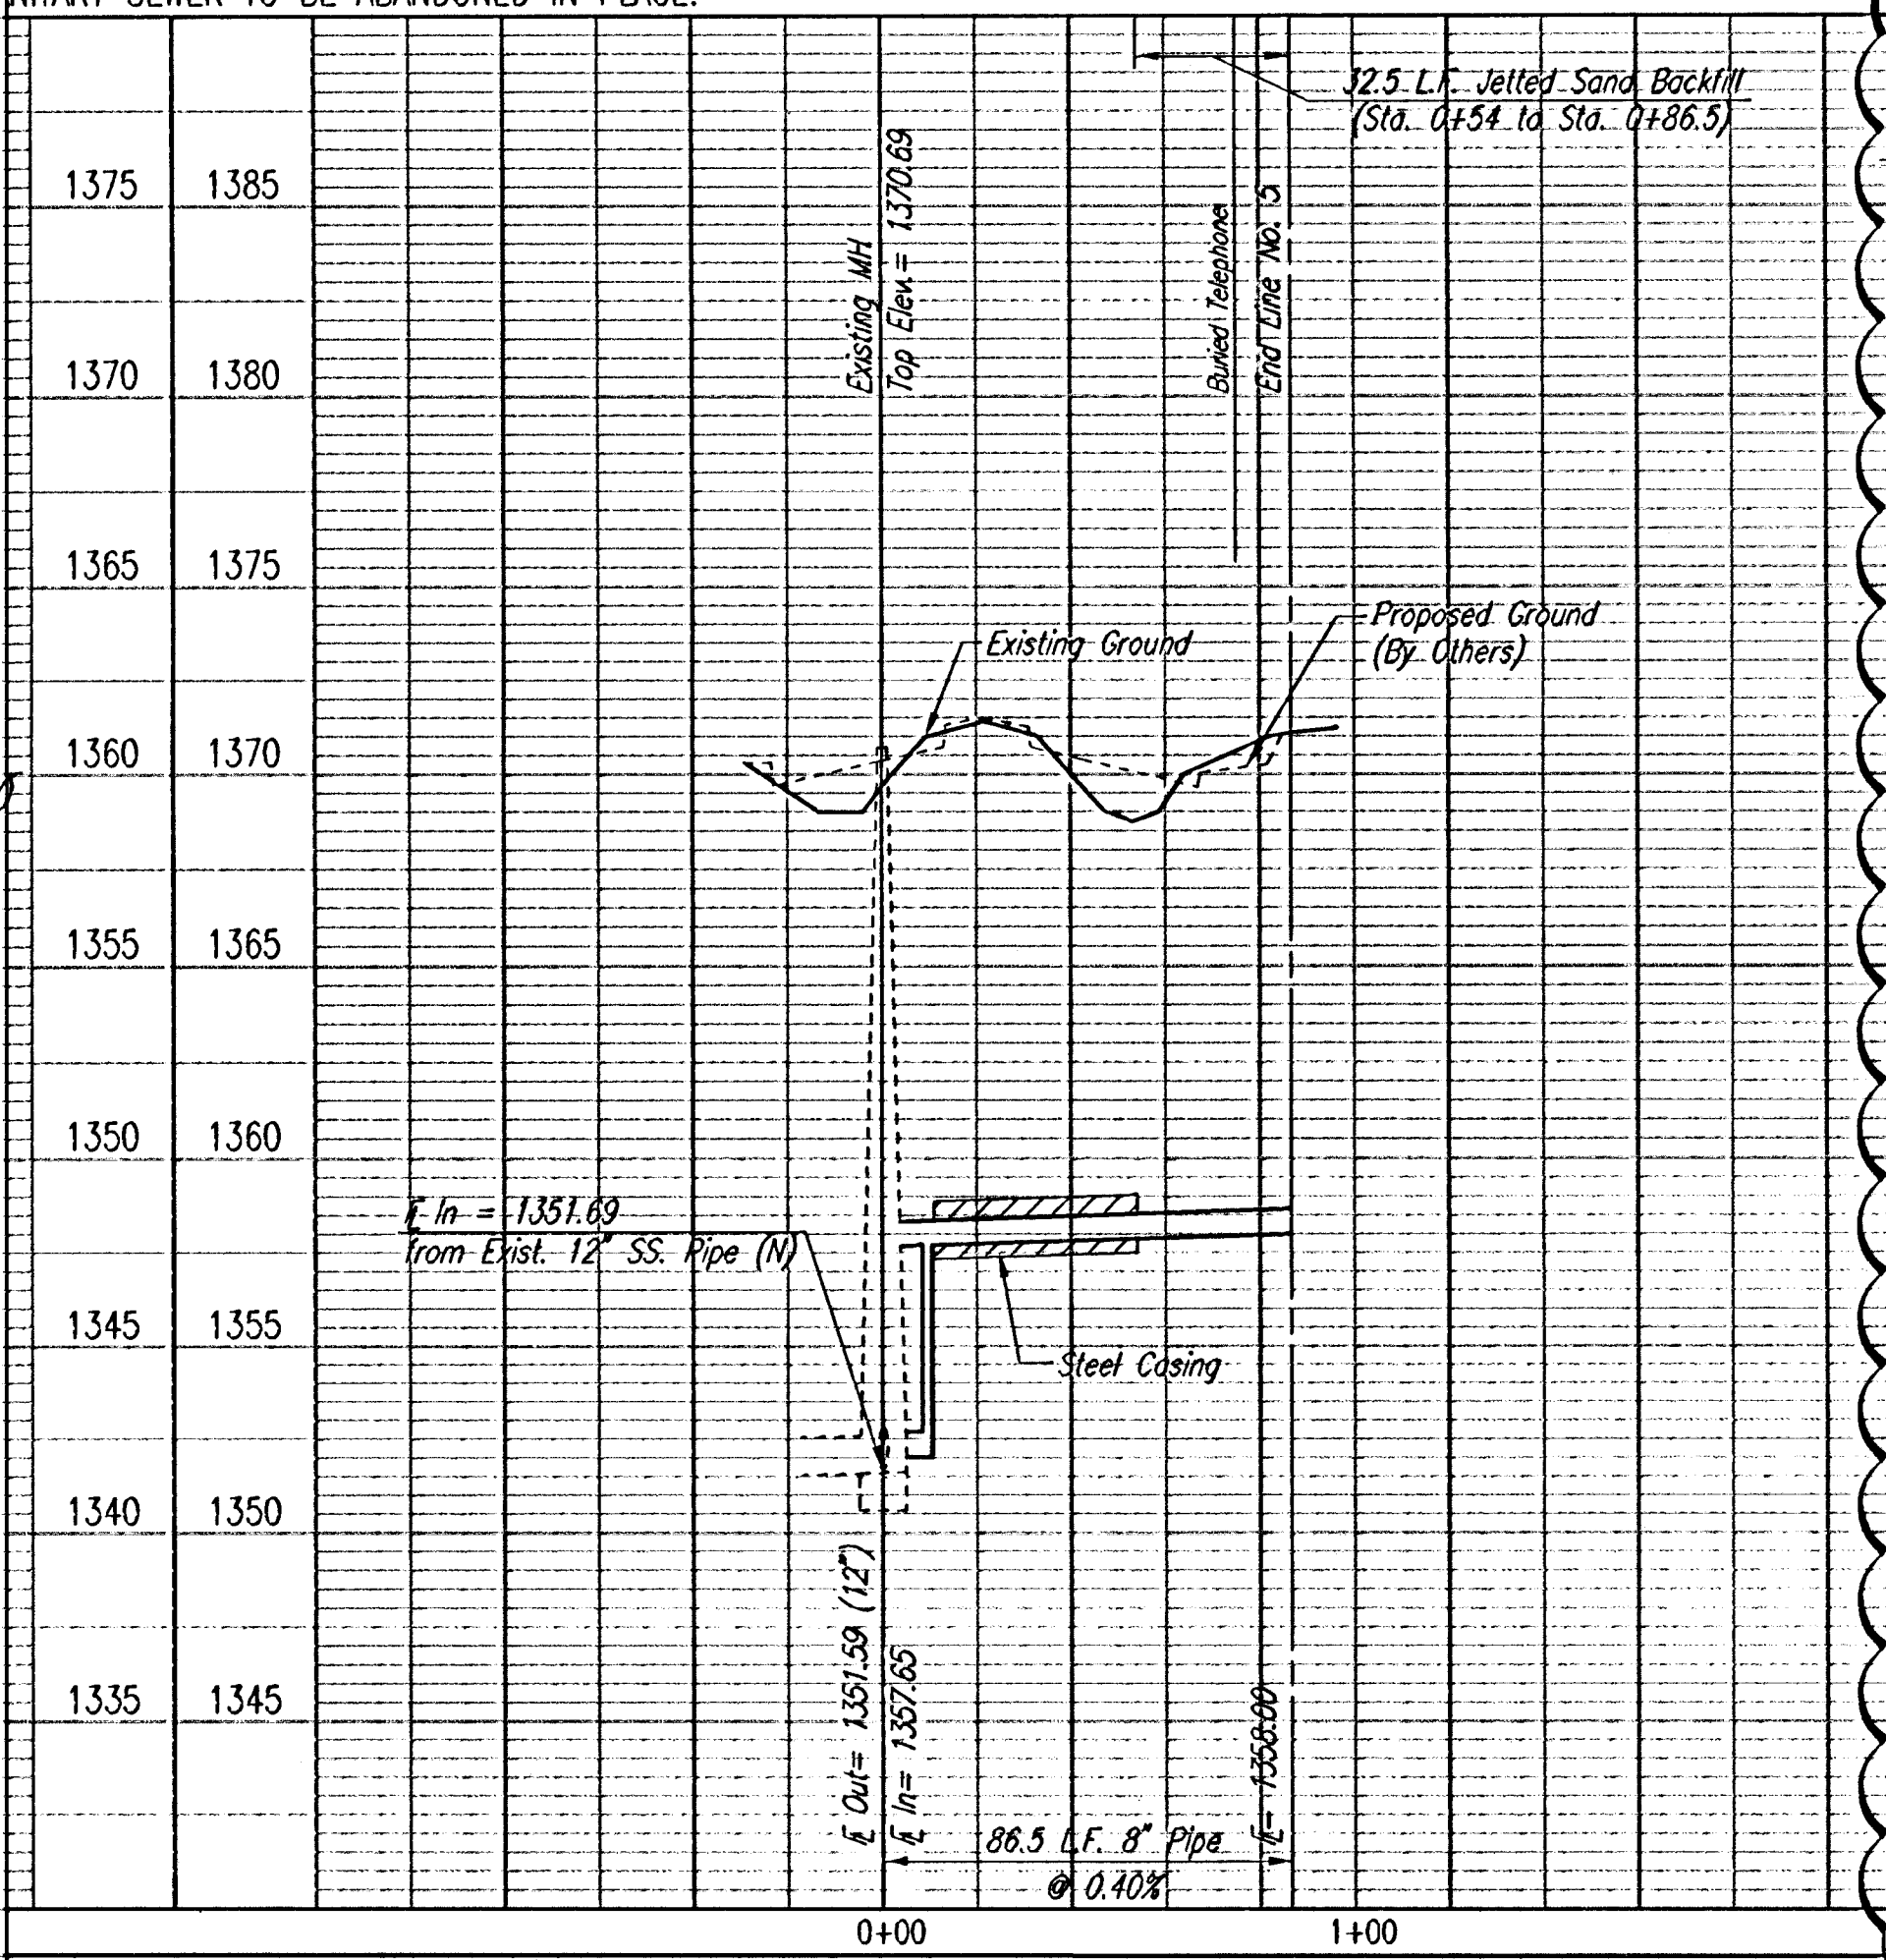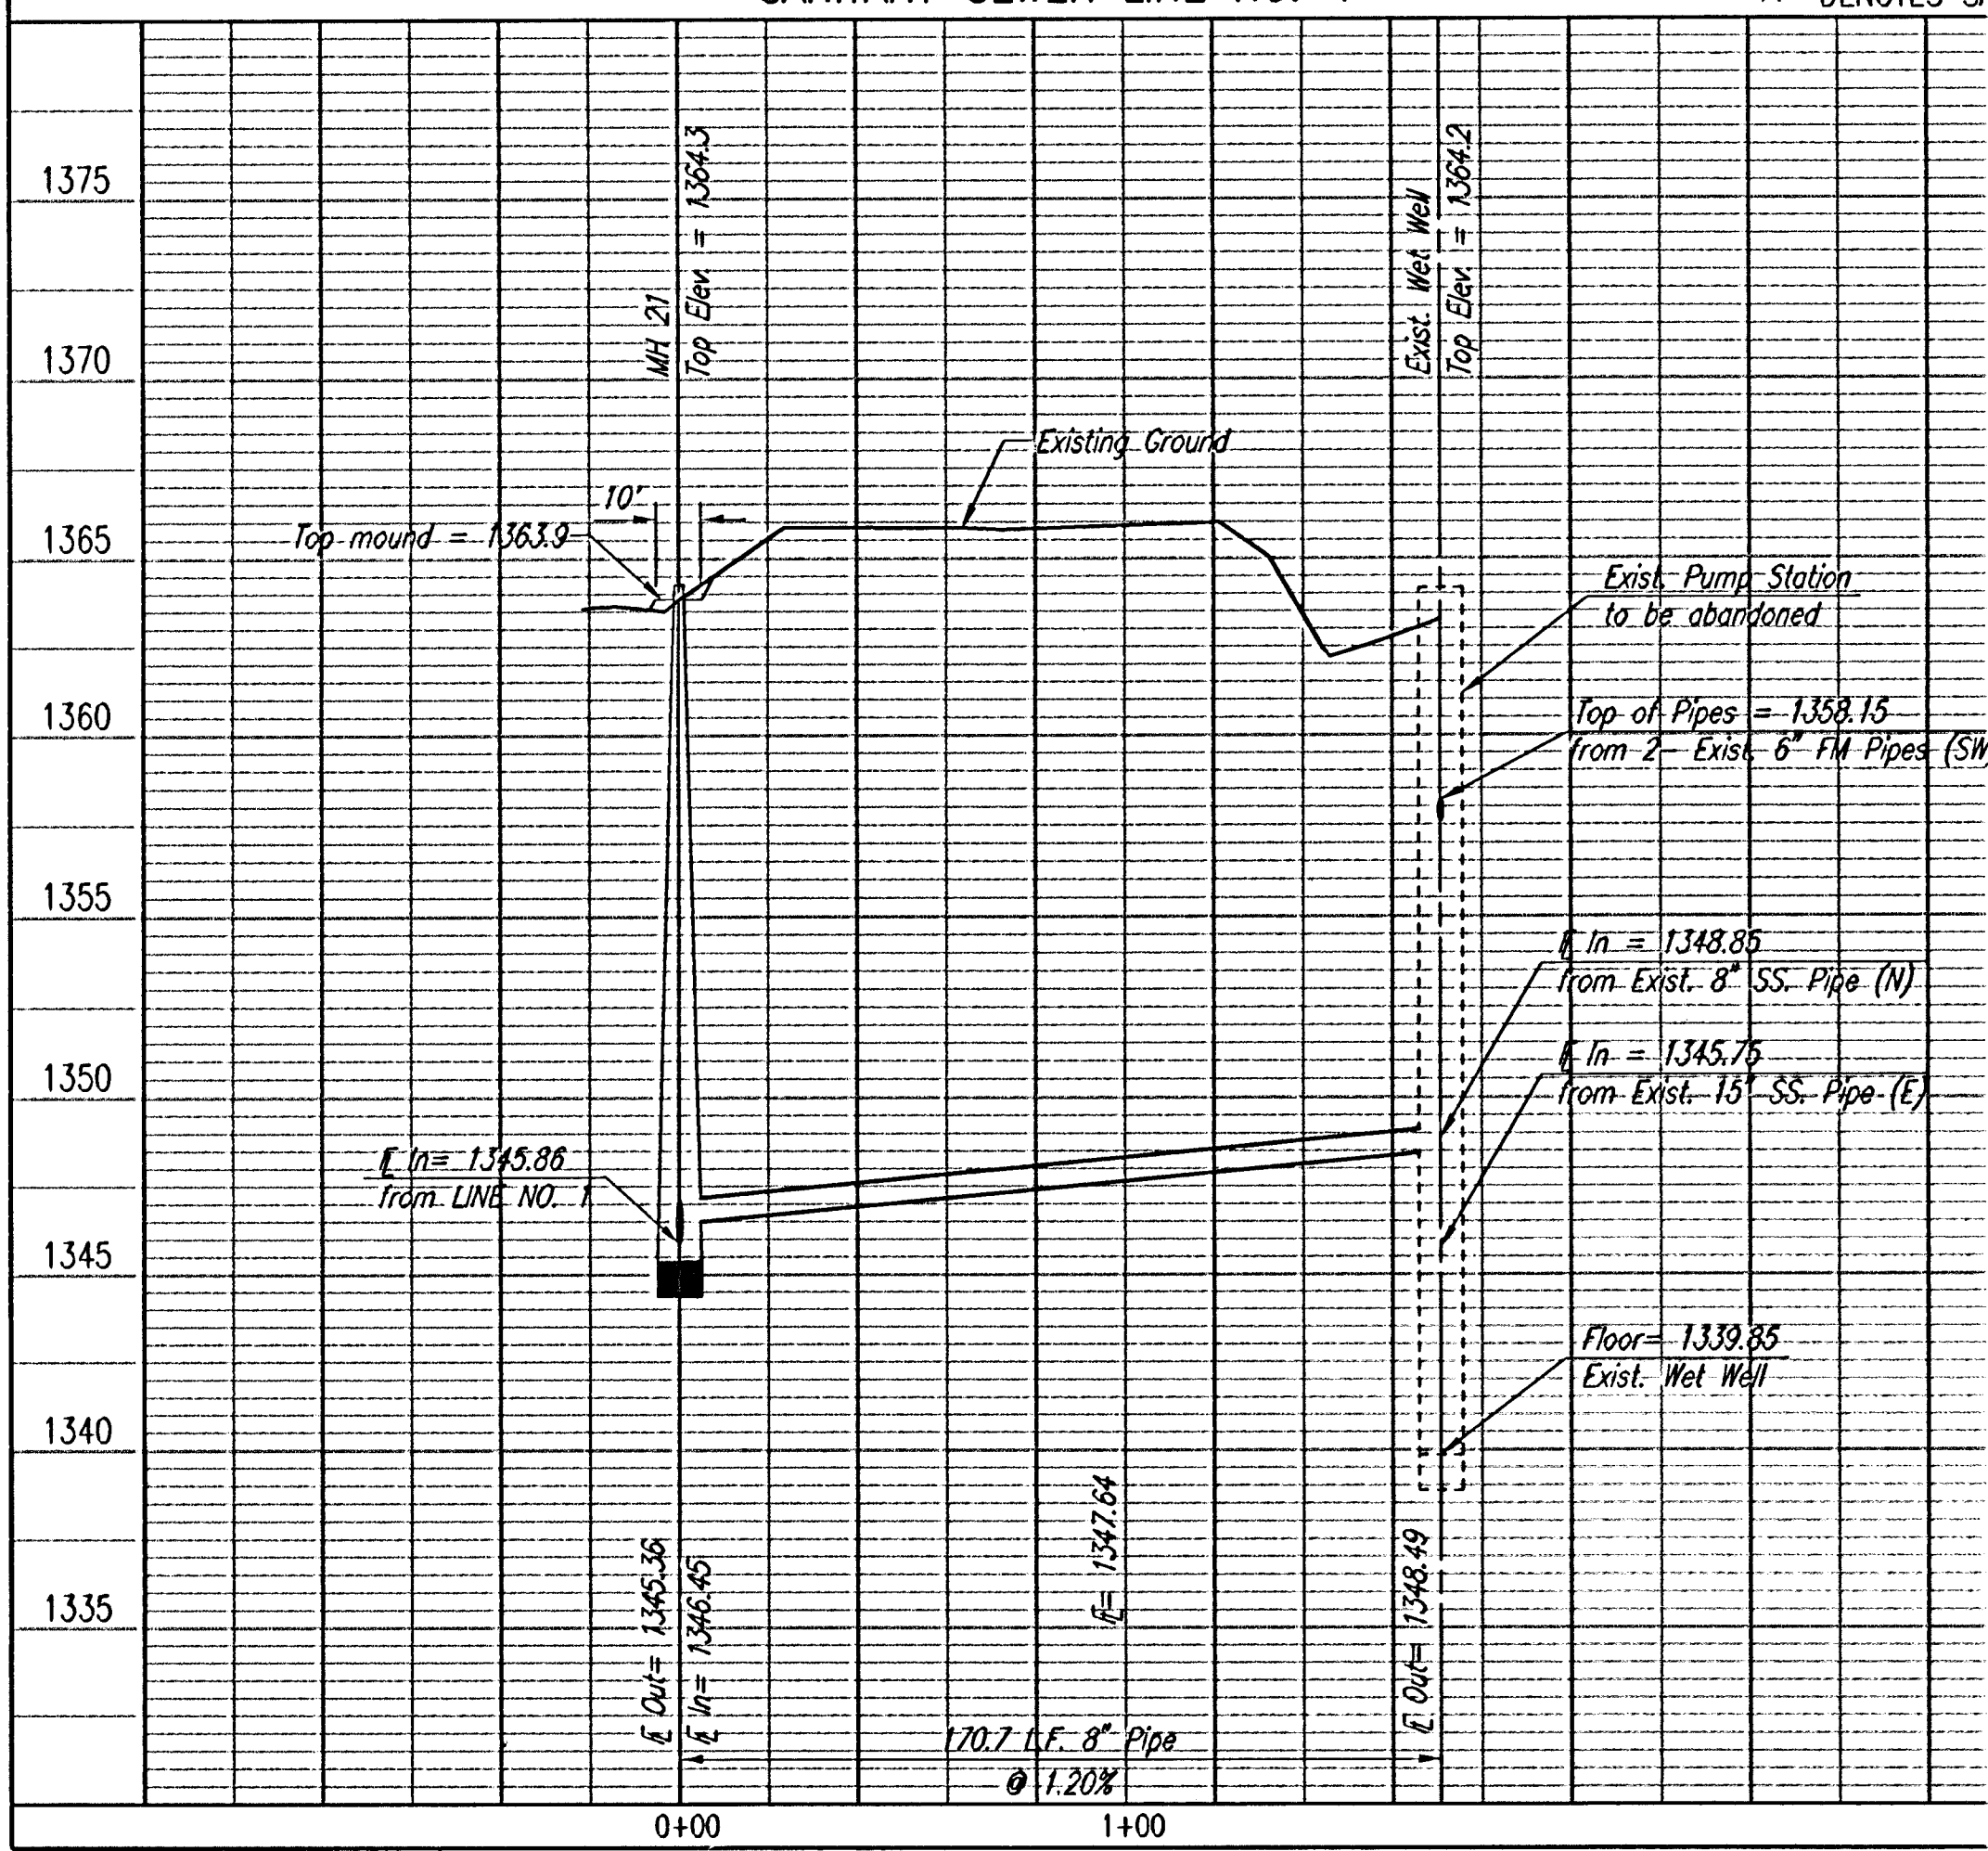

MAIN 16 OF THE
 FOUR MILE CREEK SEWER
**SANITARY SEWER LINE NO. 4,
 NO. 5, AND NO. 6**

JAMES L. ARMOUR, P.E. - CITY ENGINEER
 CITY OF WICHITA PROJECT NO. 405-35803

Professional Engineering Consultants, P.A.
 303 S. TOPICKA • WICHITA, KANSAS 67202
 316-262-2691 • FAX 316-262-3003

Designed By MDK Job No. 35-04219-002 Date MAY 2004
 Drawn By JCA, TRD

Sheet 13 of 26