

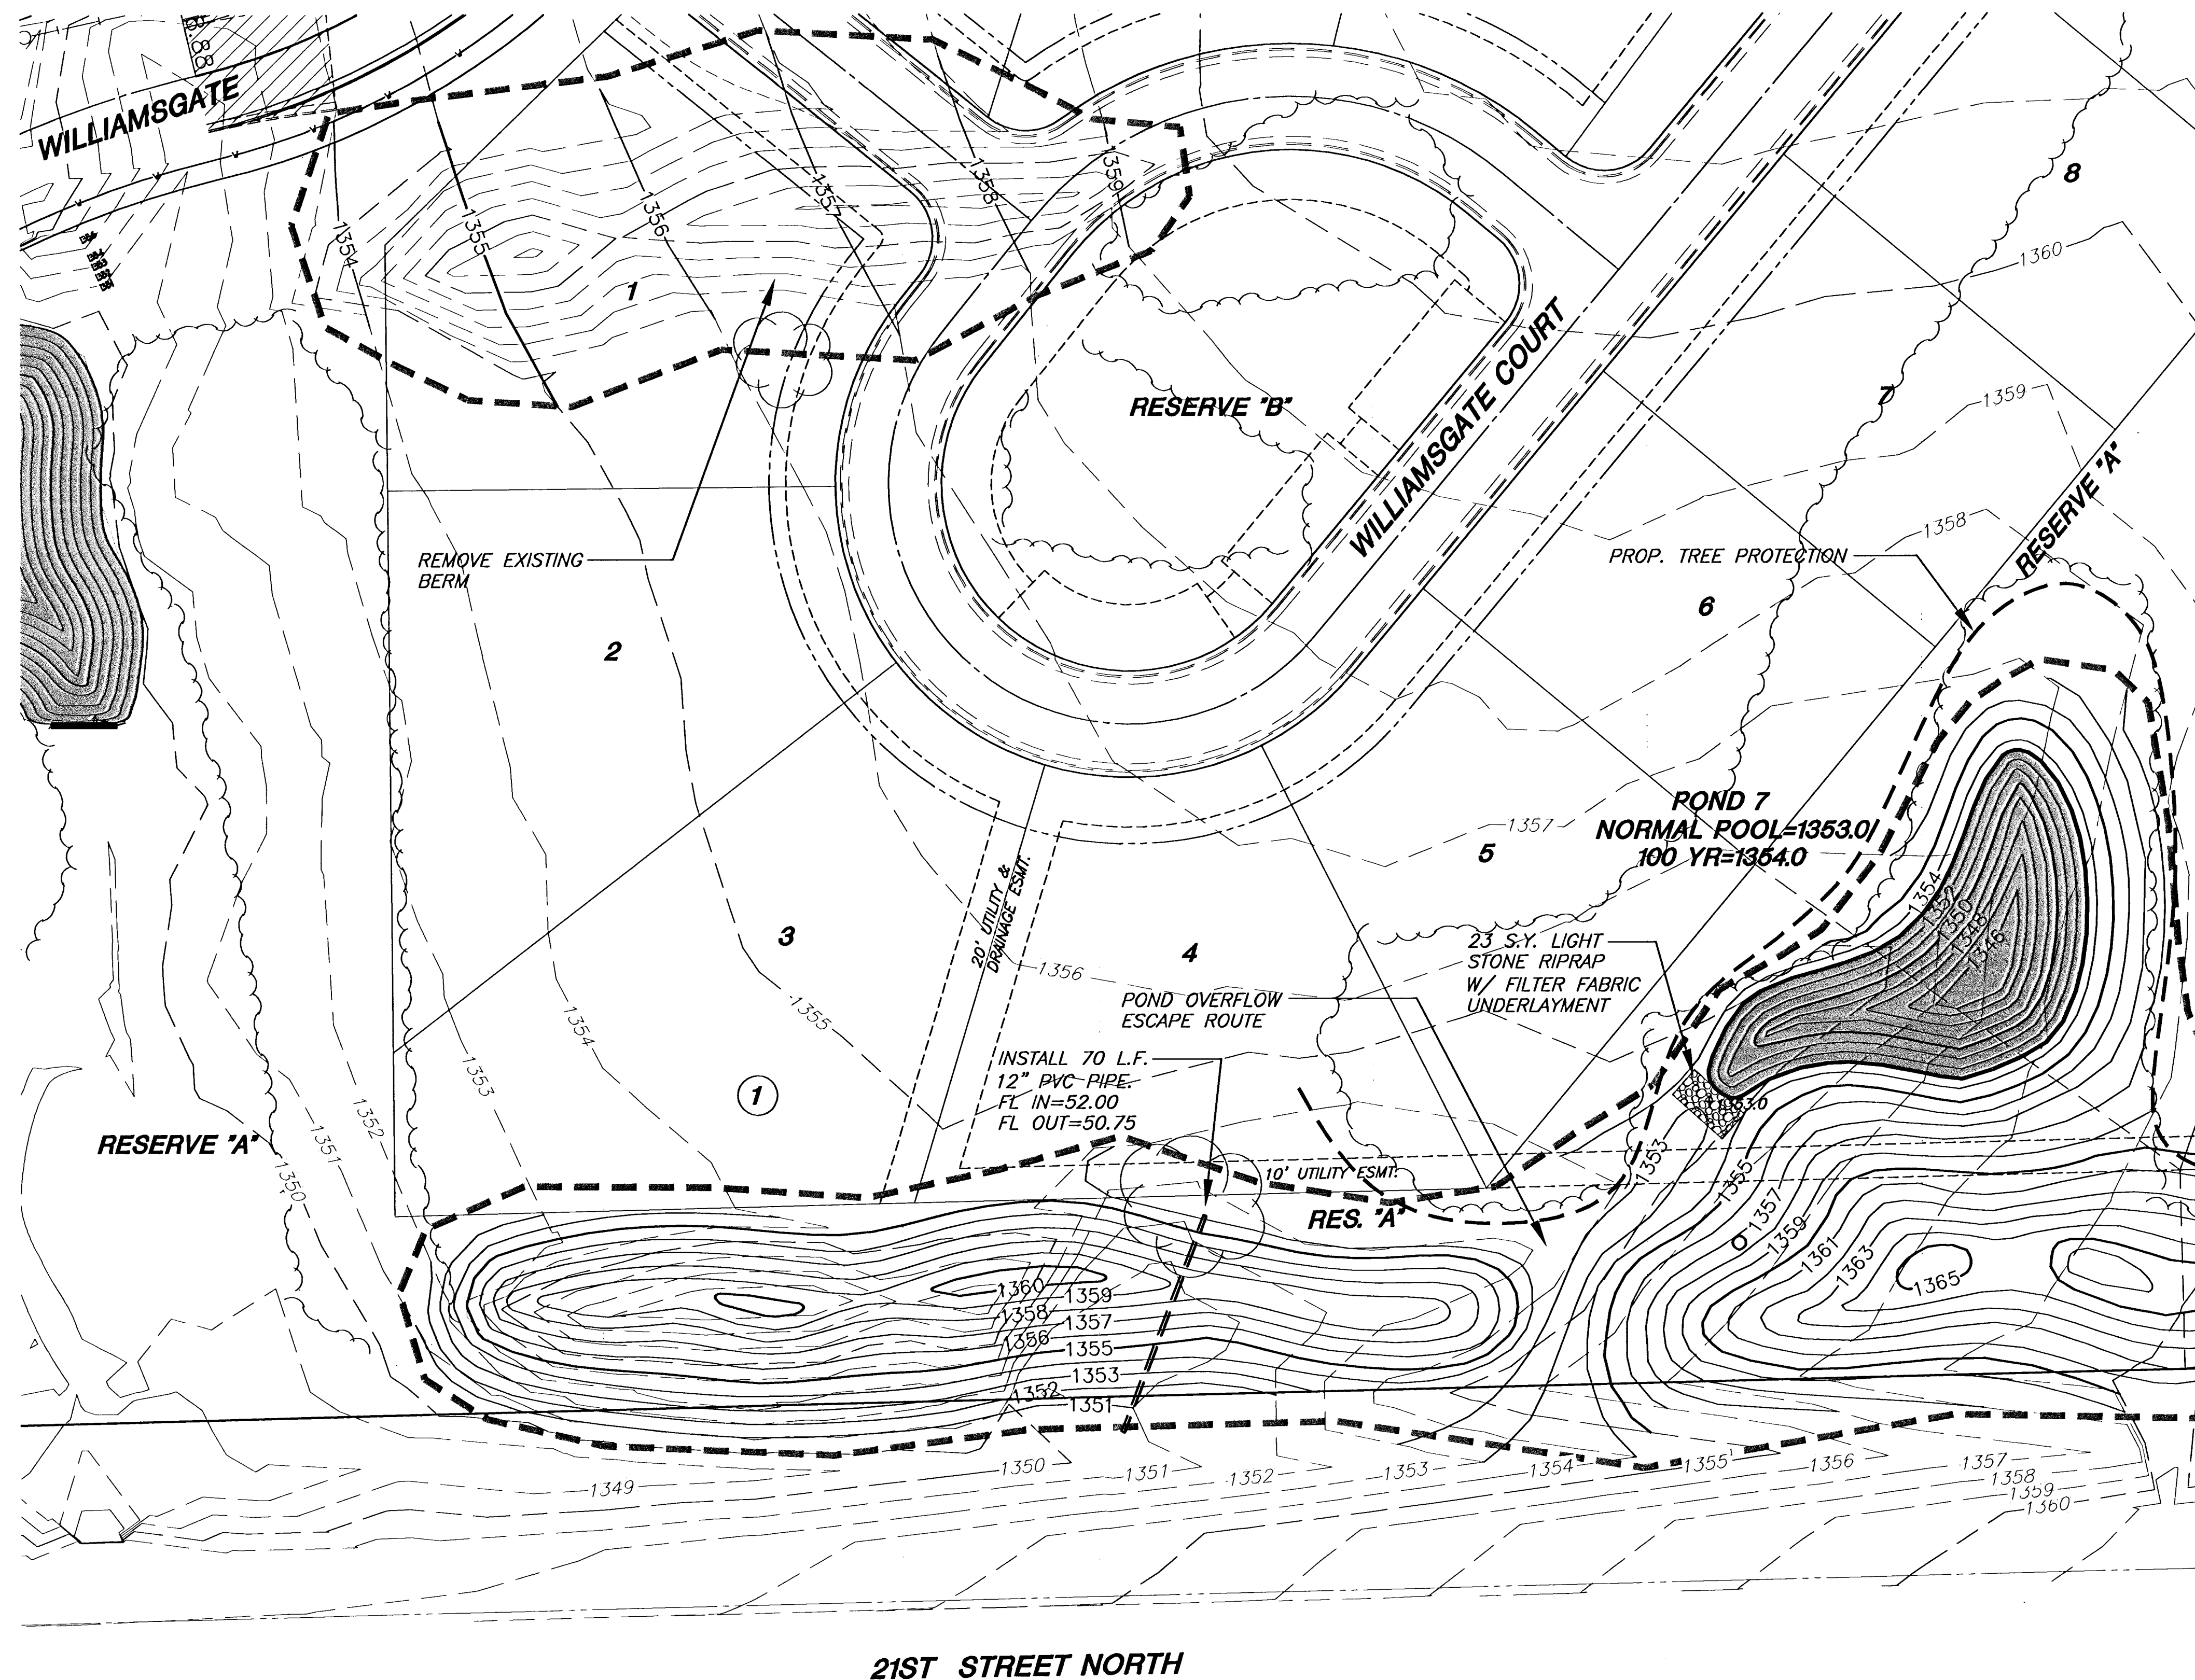
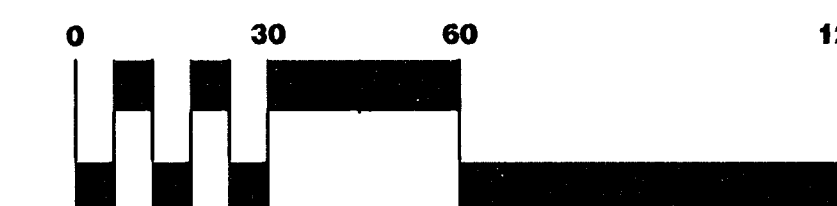


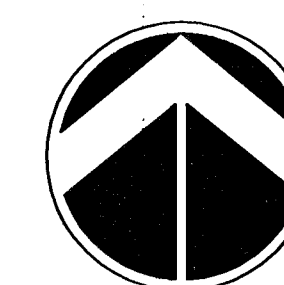

21ST STREET NORTH

LEGEND

- 1355 --- EXIST. CONTOURS
- 1355 — PROP. CONTOURS
- - - - - LIMITS OF GRADING
- - - - - PROP. TREE PROTECTION

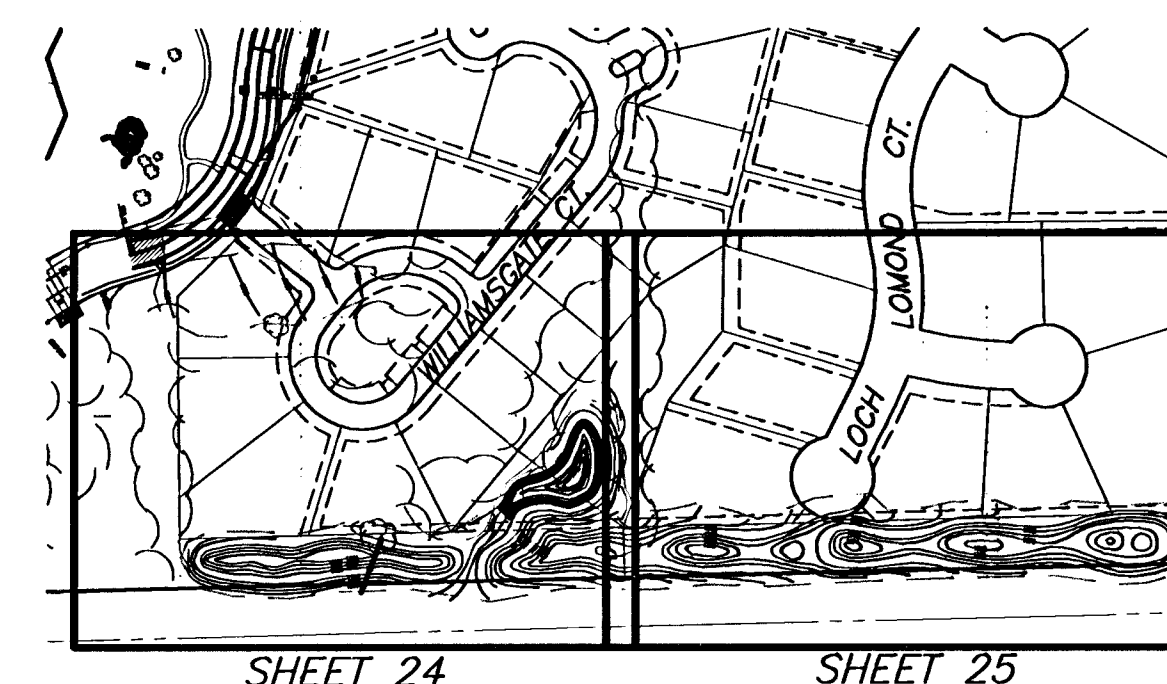

SCALE: 1" = 30'

POND 7 & BERM GRADING

CUT.....3,150 C.Y.
FILL.....10,450 C.Y.



MKEC
ENGINEERING
CONSULTANTS
411 N. WEBB ROAD
WICHITA, KS. 67206
316 - 684 - 9600

HAWTHORNE THIRD ADDITION
PROJECT NAME

POND 7 & BERM GRADING
SHEET TITLE

DESIGN BY:	DRAWN BY:	CHECKED BY:
BJH	BJH	JAG
OCTOBER 2004	02167	24 / 48
DATE	JOB NO.	SHEET/OF

H:\CIVIL\02167\DWG\GRAD\WILLIAMSGATE_3RD_ADD\02167GD13