

BM #1: Brass Plate on North
Hub Guard of R.C.B.C. 50' East of
NW Corner NE 1/2, Sec. 22, Twp.
26-S, R-1-E.
Elev. = 1371.83 (NGVD29)


BM #2: "□" cut on East Hub
Guard of R.C.B.C., 110' S. of the
SE Cor., SE 1/4, Sec. 22, Twp.
26-S, R-1-E.
Elev. = 1359.54 (NGVD29)

NUMBER	TYPE	LOCATION			STATION \ DIRECTION	FOR INFORMATION ONLY	
		LOT NO.	BLOCK NO.	LINE NO.		APPROXIMATE LENGTH 4" PIPE	
						VERTICAL	HORIZONTAL
1	10" x 4" Tee Saddle	1	A	1	1+83/Rt.	16.5'	10'
2	4" Riser w/ Stub	2	A	1	1+88.9/Rt.	16.5'	10'
3	10" x 4" Tee Saddle	3	A	1	2+71/Rt.	16.0'	10'
4	10" x 4" Tee Saddle	4	A	1	3+47/Rt.	14.5'	10'
5	10" x 4" Tee Saddle	5	A	1	4+22/Rt.	13.5'	10'
6	10" x 4" Tee Saddle	6	A	1	4+98/Rt.	12.0'	10'

NOTE: Vertical Riser Pipe shall be extended to 2' minimum above ground water elevation and 4' maximum below proposed ground elevation.

NUMBER	TYPE	LOCATION			STATION \ DIRECTION	FOR INFORMATION ONLY	
		LOT NO.	BLOCK NO.	LINE NO.		APPROXIMATE LENGTH 4" PIPE	
						VERTICAL	HORIZONTAL
7	10" x 4" Tee Saddle	7	A	1	5+74/Rt.	10.0'	10'
8	10" x 4" Tee Saddle	8	A	1	6+50/Rt.	9.0'	10'
9	10" x 4" Tee Saddle	9	A	1	8+01/Lt.	9.0'	10'
10	10" x 4" Tee Saddle	10	A	1	8+12/Rt.	9.0'	10'
11	10" x 4" Tee Saddle	11	A	1	8+88/Rt.	9.0'	10'
12	10" x 4" Tee Saddle	12	A	1	9+64/Lt.	9.0'	10'

NOTE: Vertical Riser Pipe shall be extended to 2' minimum above ground water elevation and 4' maximum below proposed ground elevation.

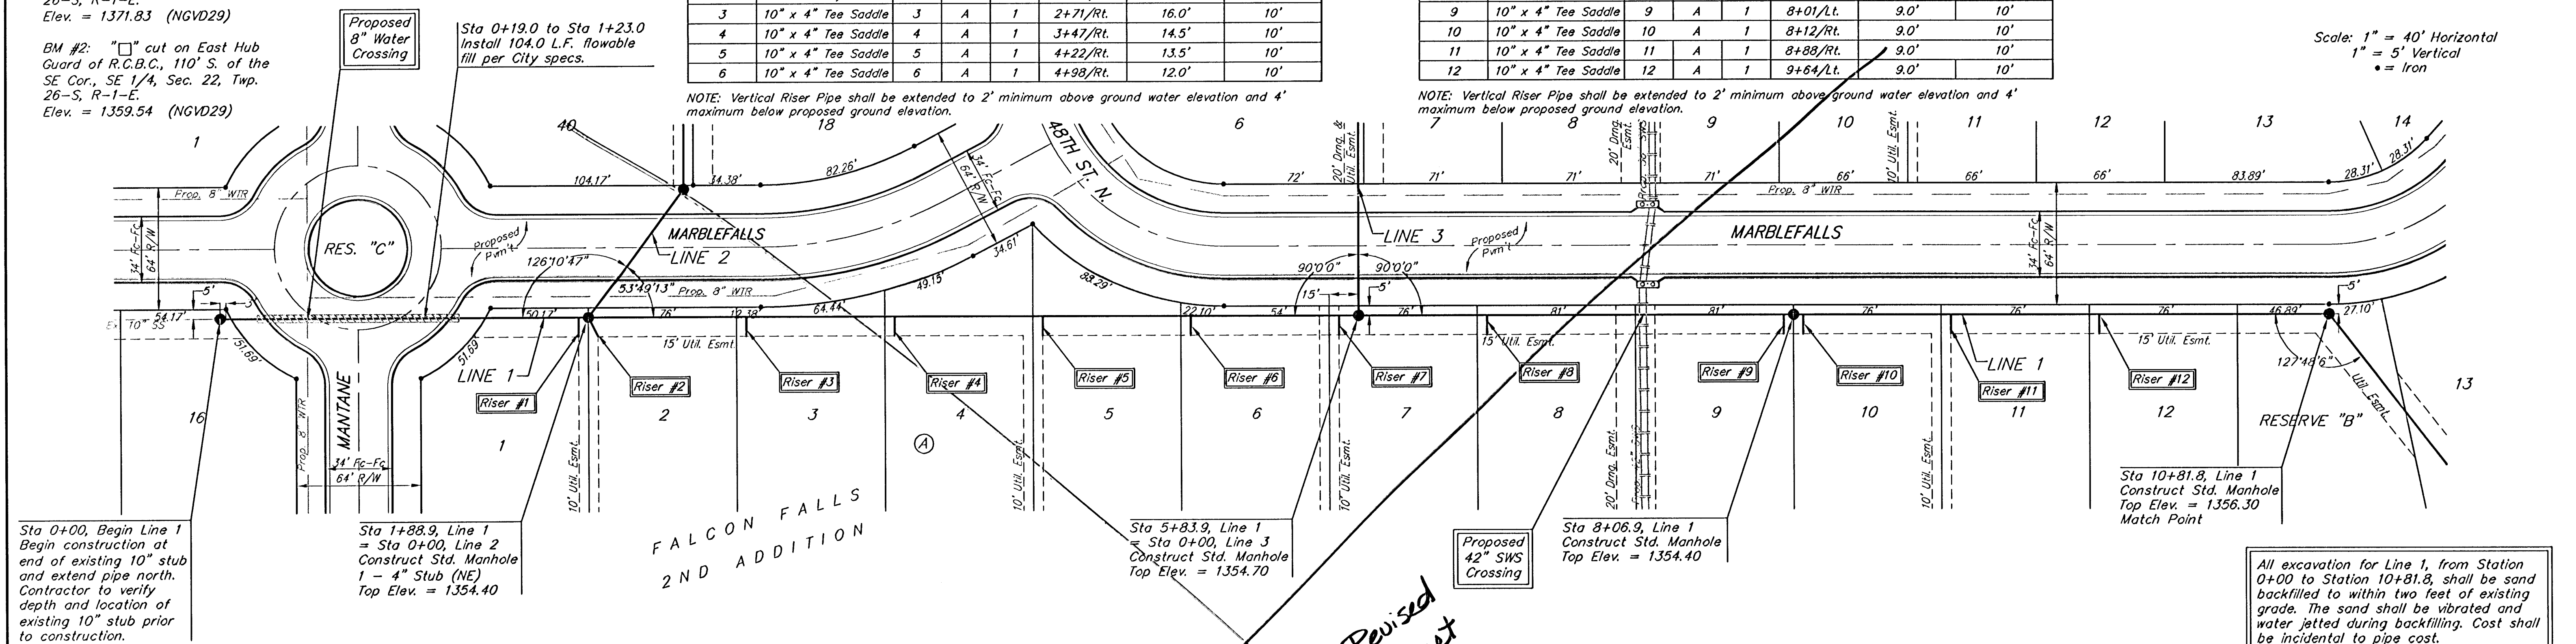

See Revised Sheet

