



BENCHMARKS

BM #1: Brass Plate on North
Hub Guard of R.C.B.C. 50' East of
NW Corner NE 1/2, Sec. 22, Twp.
26-S, R-1-E.
Elev. = 1371.83 (NGVD29)

BM #2: "X" cut on East Hub
Guard of R.C.B.C., 110' S. of the
SE Cor., SE 1/4, Sec. 22, Twp.
26-S, R-1-E.
Elev. = 1359.54 (NGVD29)



Scale: 1" = 40' Horizontal
1" = 5' Vertical
• = Iron

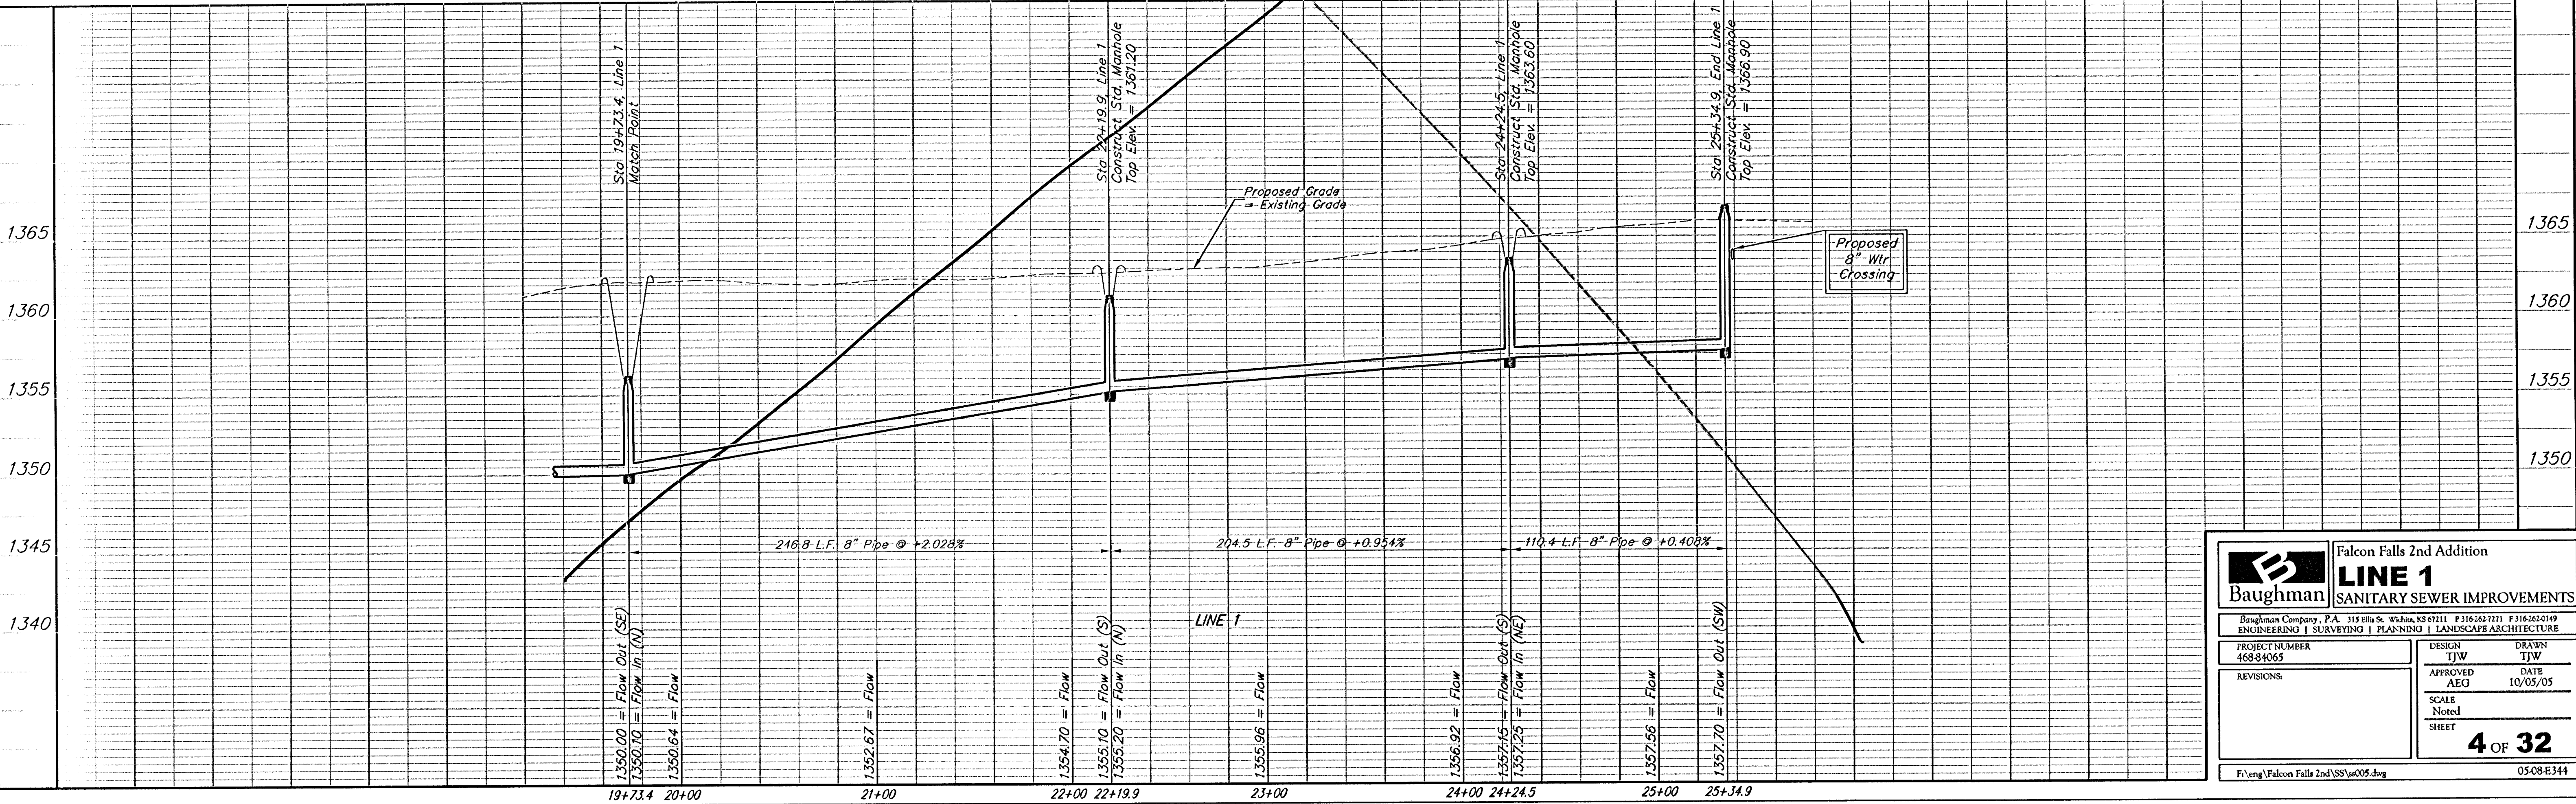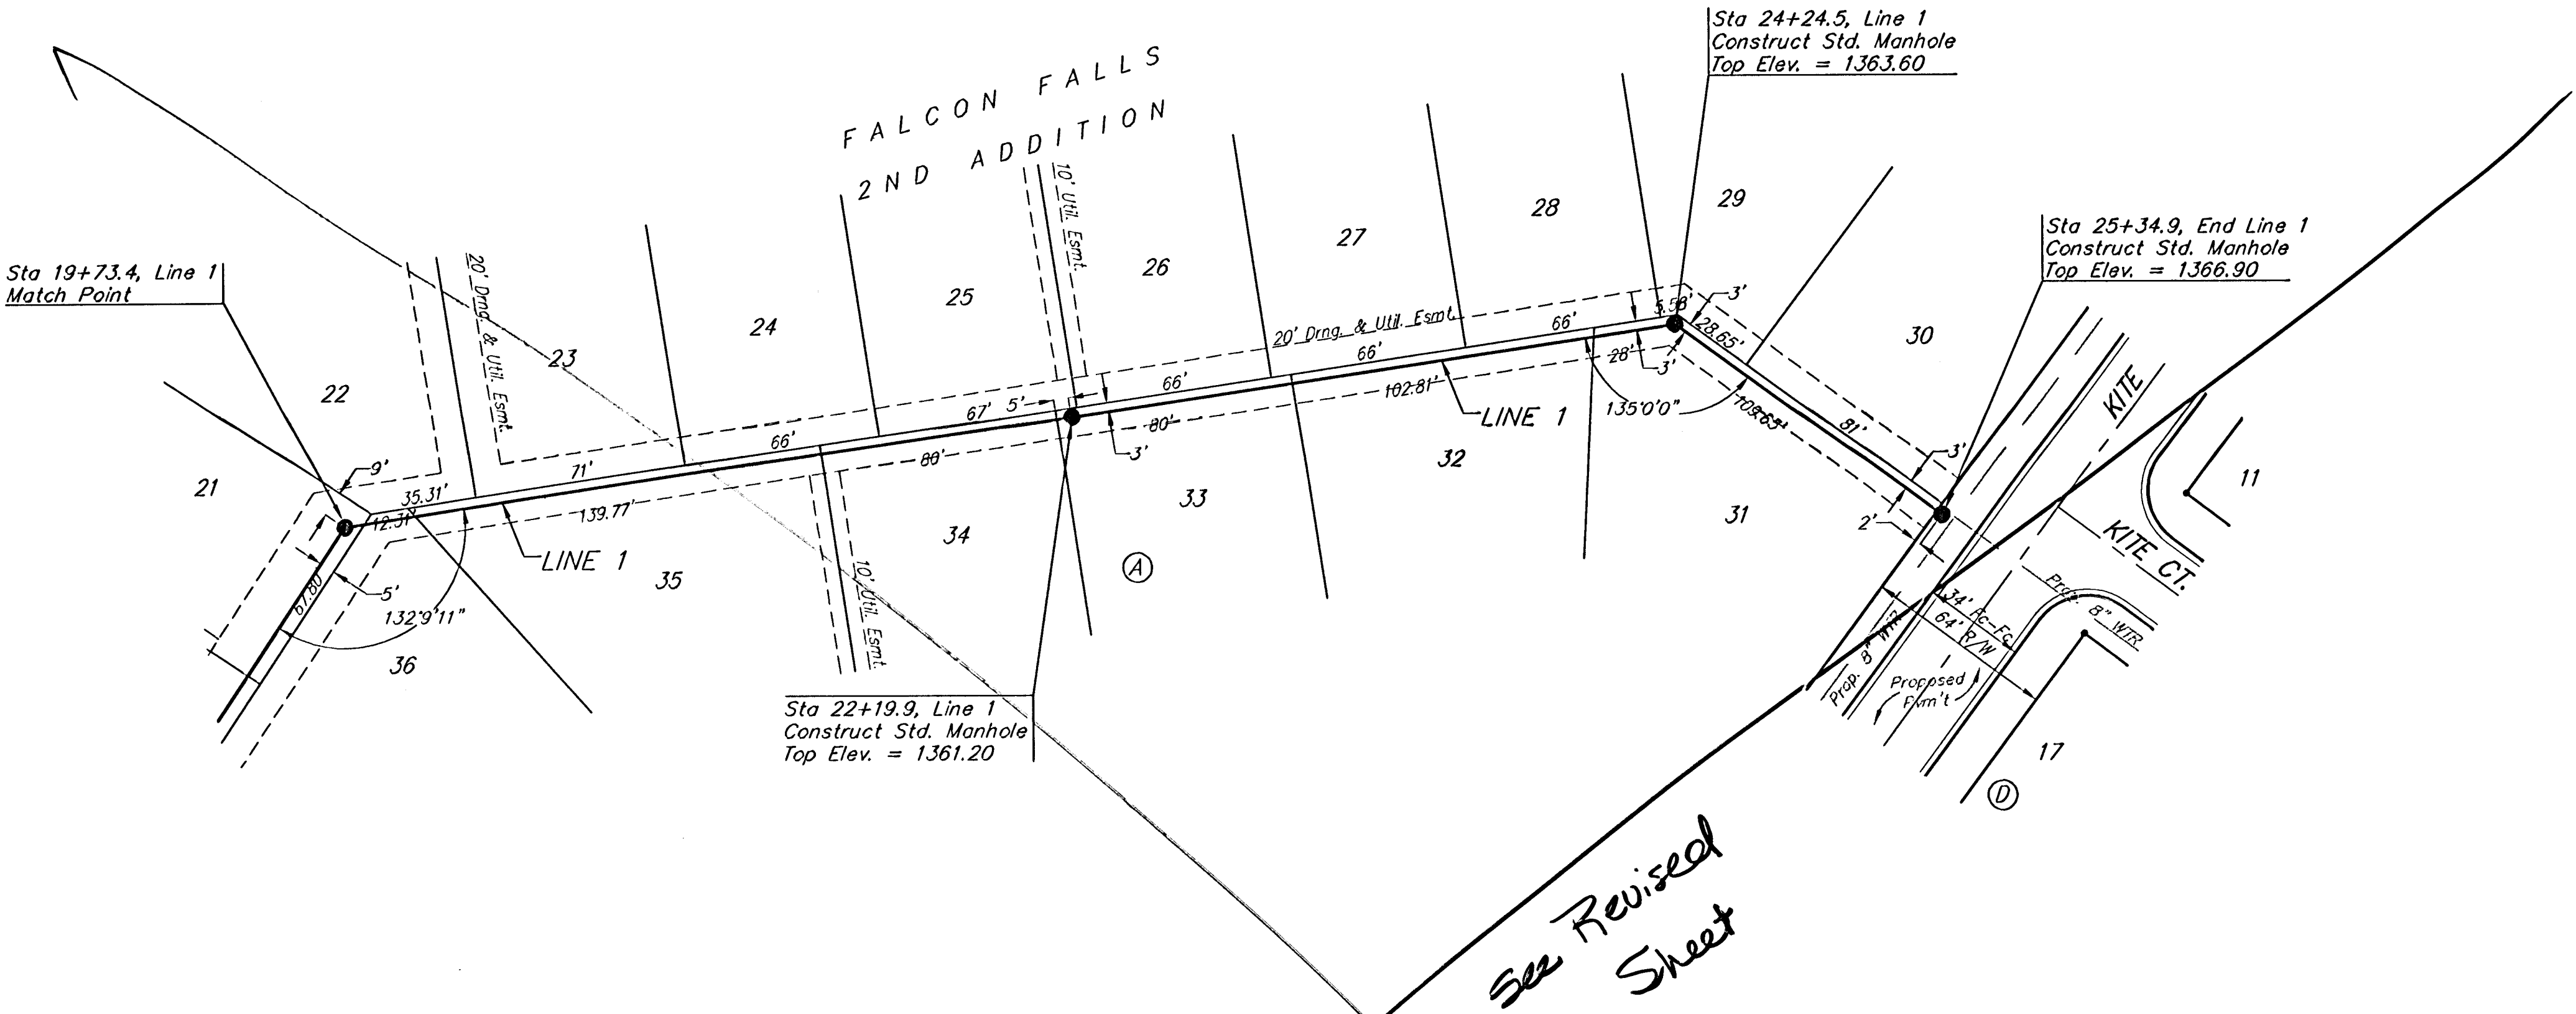



Falcon Falls 2nd Addition
LINE 1
SANITARY SEWER IMPROVEMENTS

PROJECT NUMBER
46884065

REVISIONS

DESIGN
TJW

APPROVED
AEG

DRAWN
TJW

DATE
10/05/05

SCALE
Noted

4 OF 32

F:\eng\Falcon Falls 2nd\SS\ss005.dwg

0508-E344