
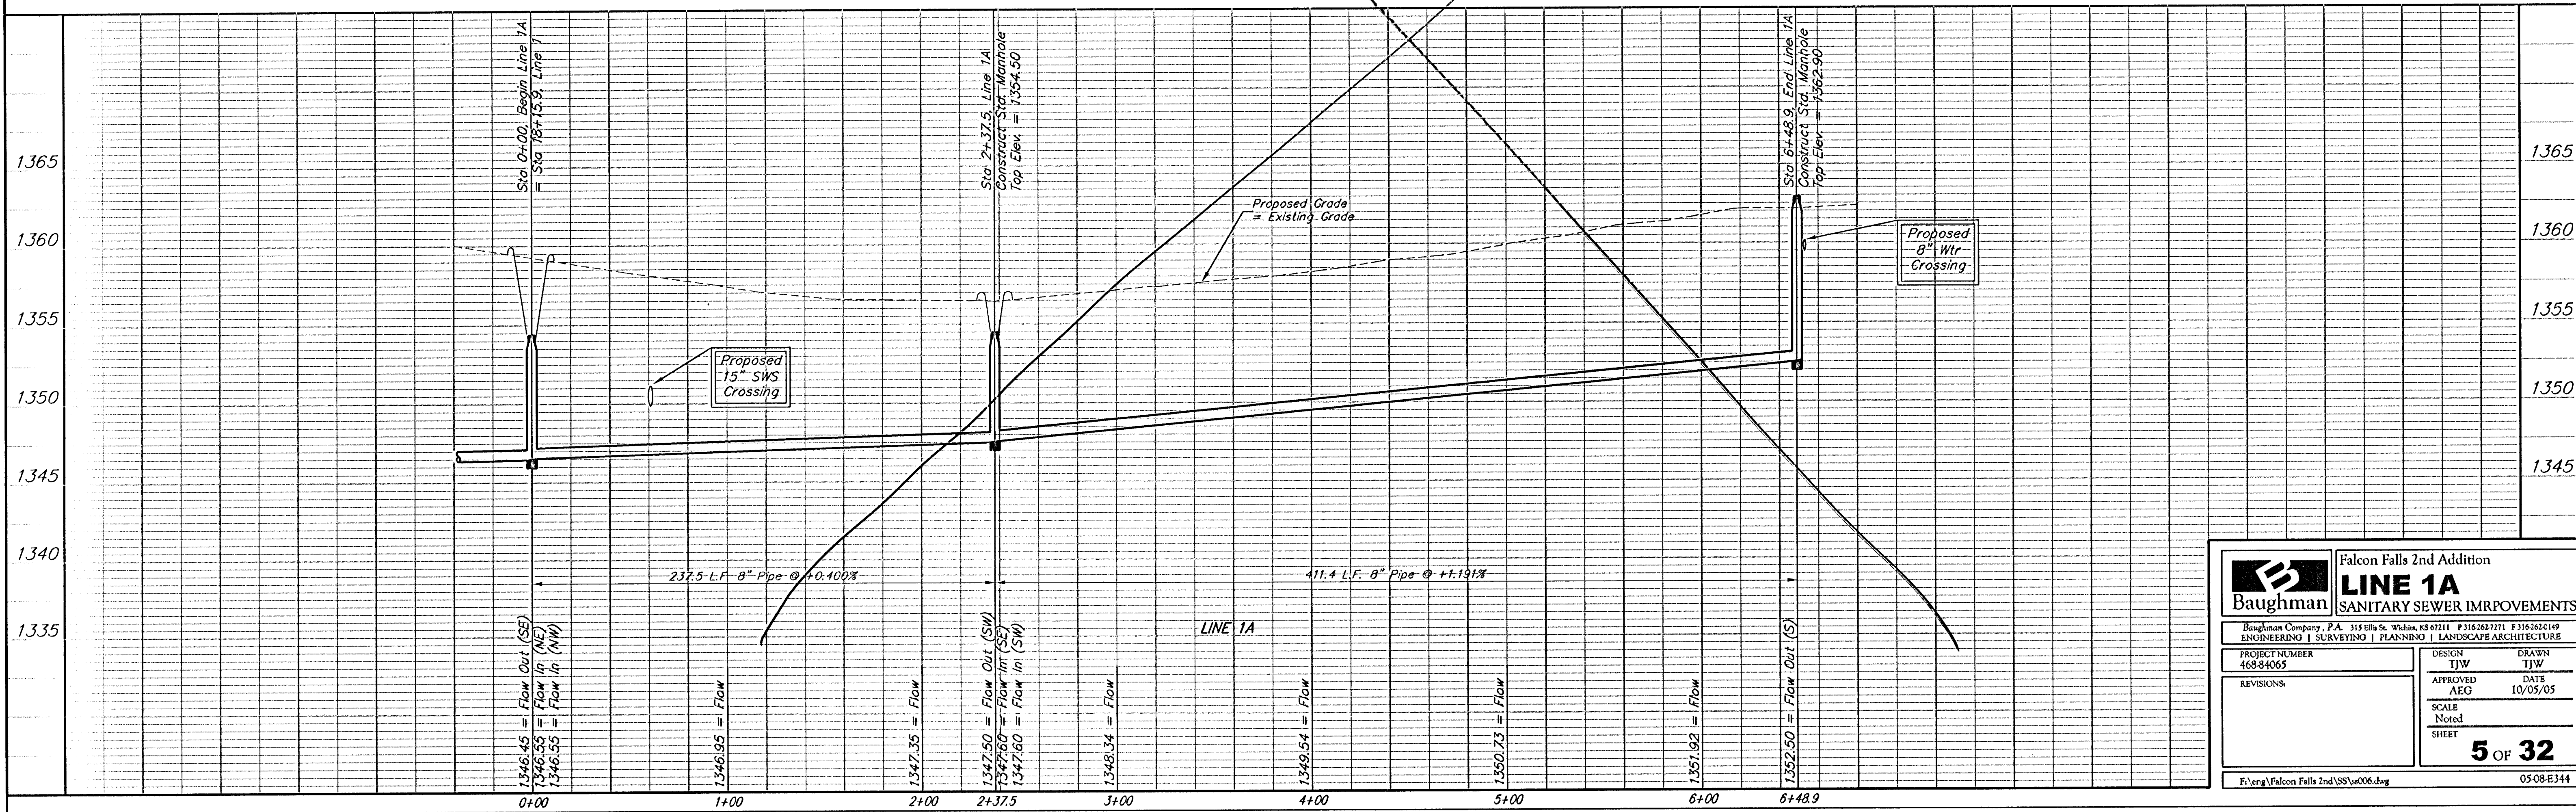
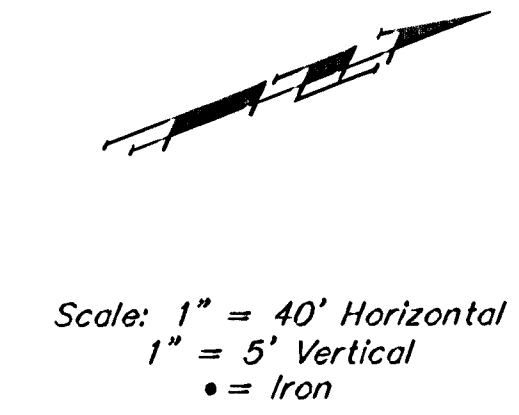


BENCHMARKS

BM #1: Brass Plate on North
Hub Guard of R.C.B.C. 50' East of
NW Corner NE 1/2, Sec. 22, Twp.
26-S, R-1-E.
Elev. = 1371.83 (NGVD29)

BM #2: "X" cut on East Hub
Guard of R.C.B.C. 110' S. of the
SE Cor., SE 1/4, Sec. 22, Twp.
26-S, R-1-E.
Elev. = 1359.54 (NGVD29)

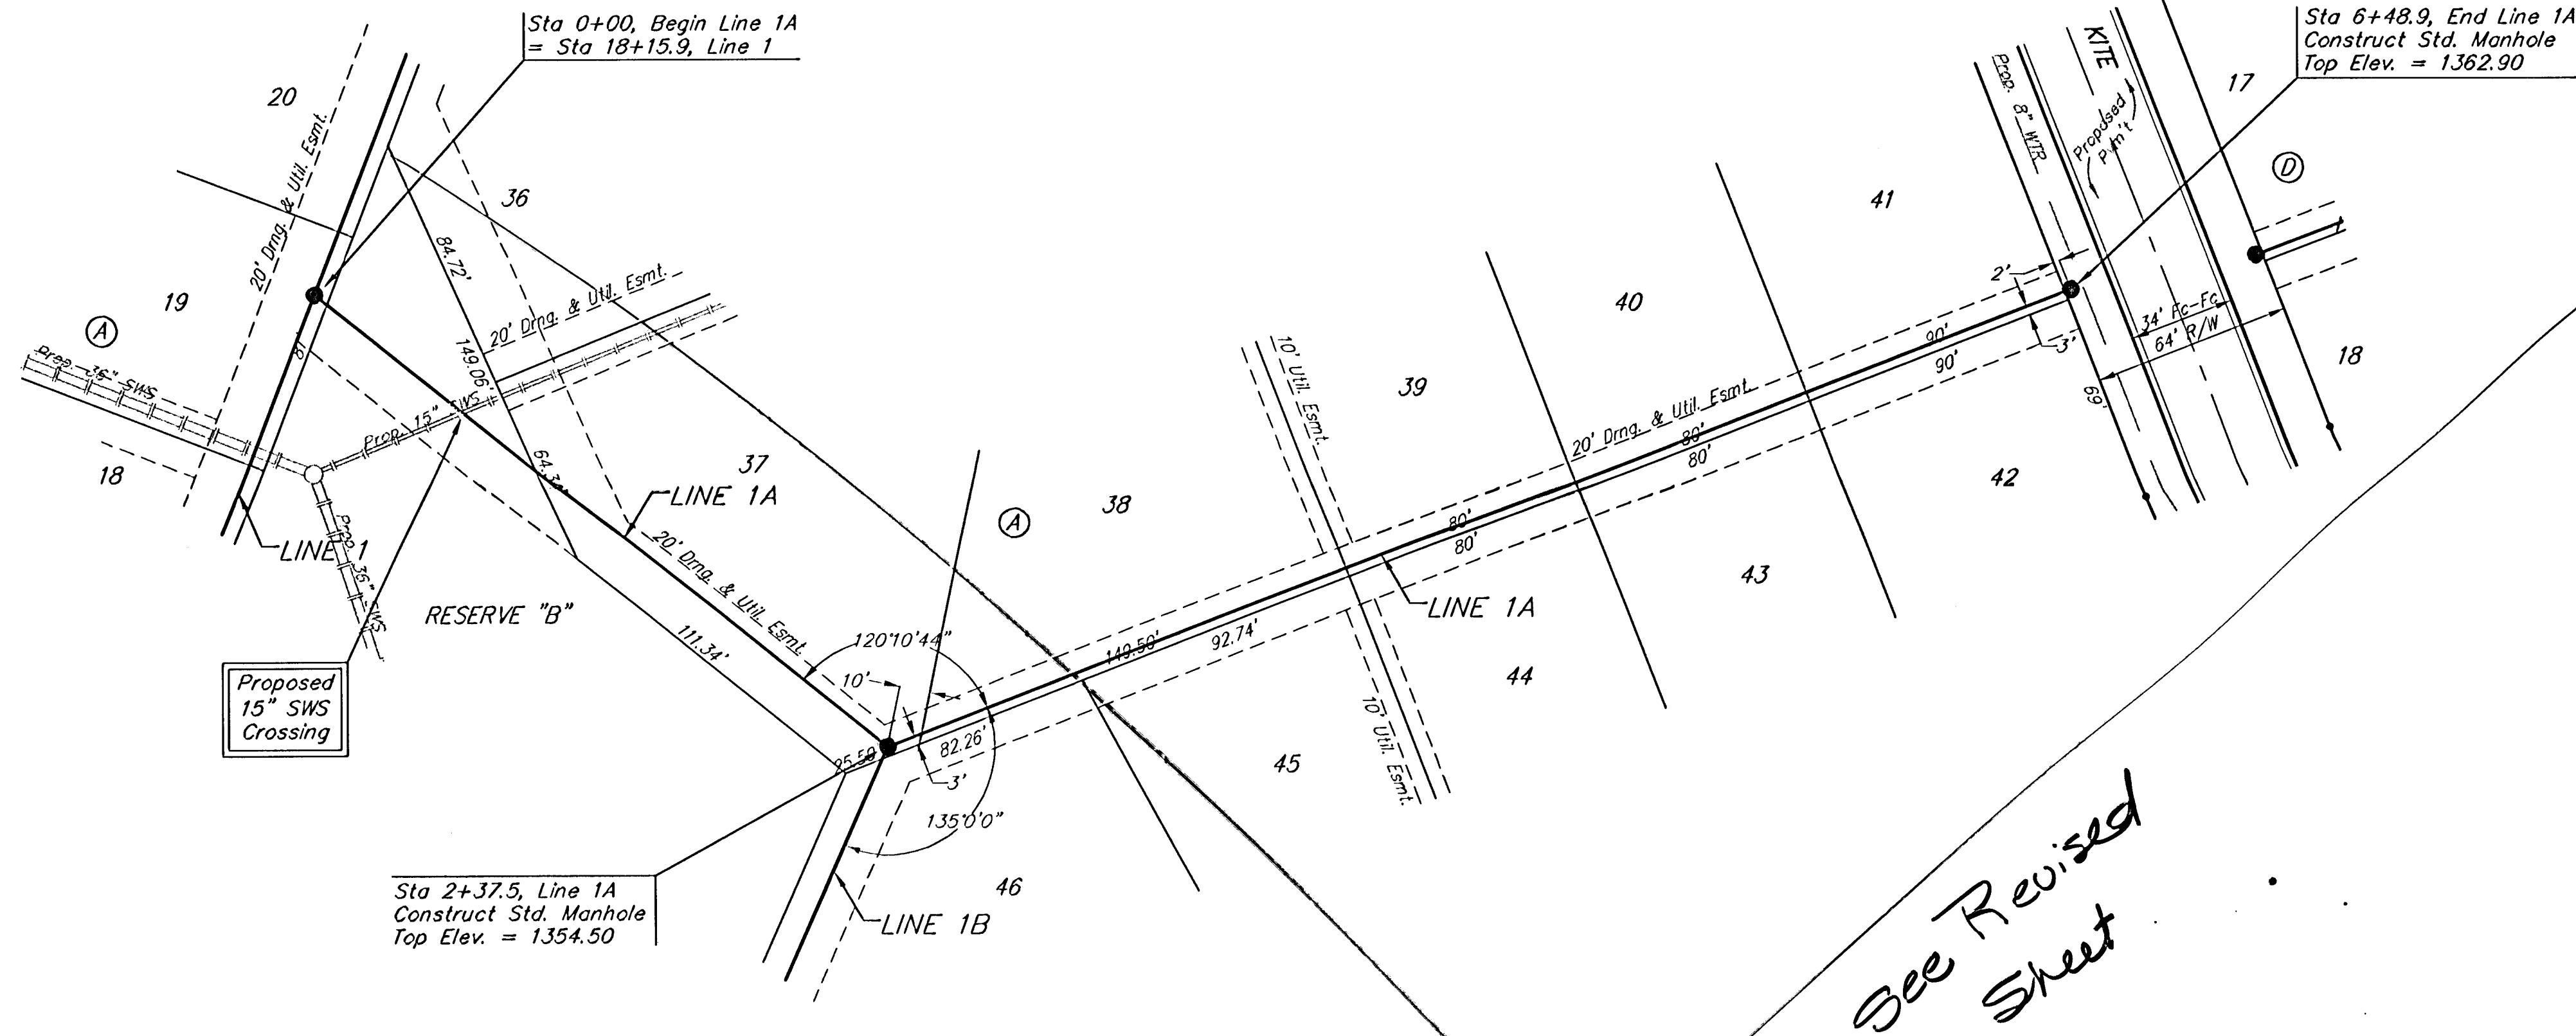

Baughman		Falcon Falls 2nd Addition	
LINE 1A		SANITARY SEWER IMPROVEMENTS	
PROJECT NUMBER 468-84065	DESIGN TJW	DRAWN TJW	
REVISIONS	APPROVED AEG	DATE 10/05/05	
SCALE Noted		SHEET 5 OF 32	
F:\eng\Falcon Falls 2nd\SS\ss006.dwg		05-08-E344	