
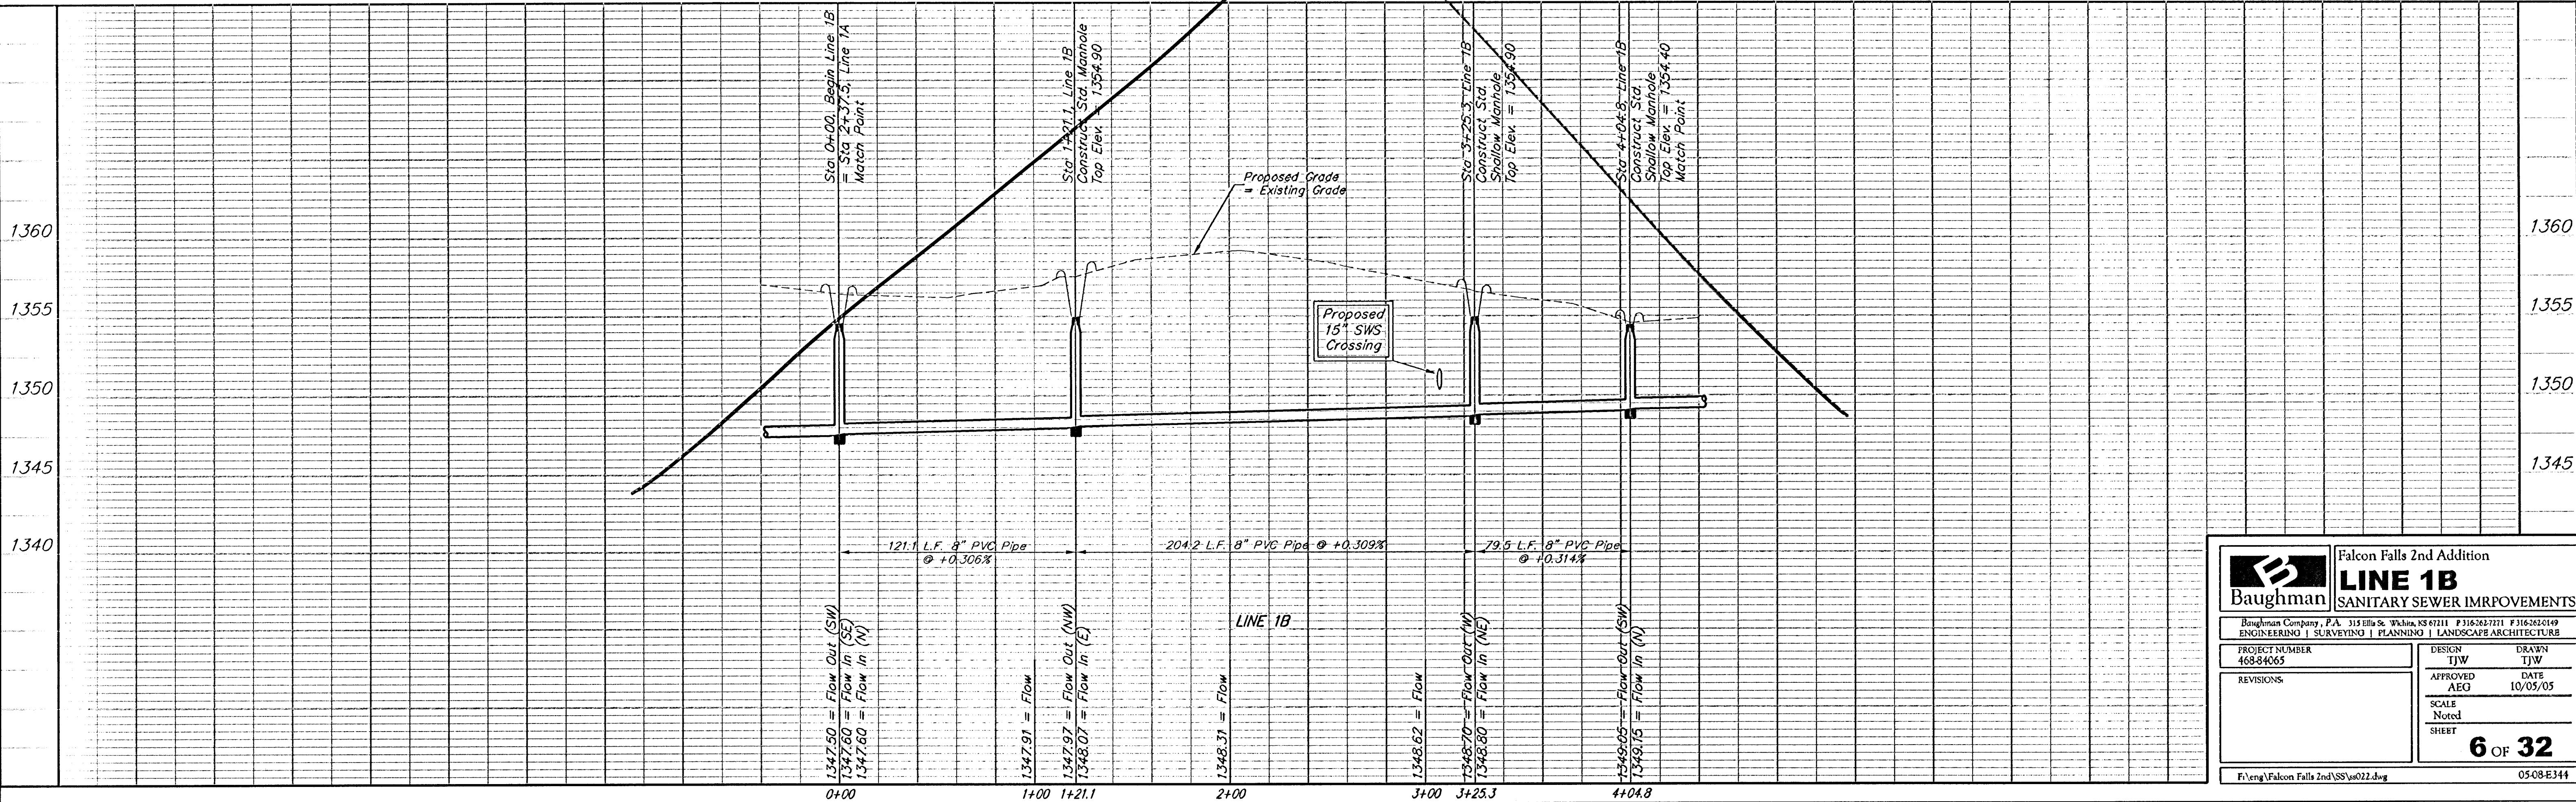
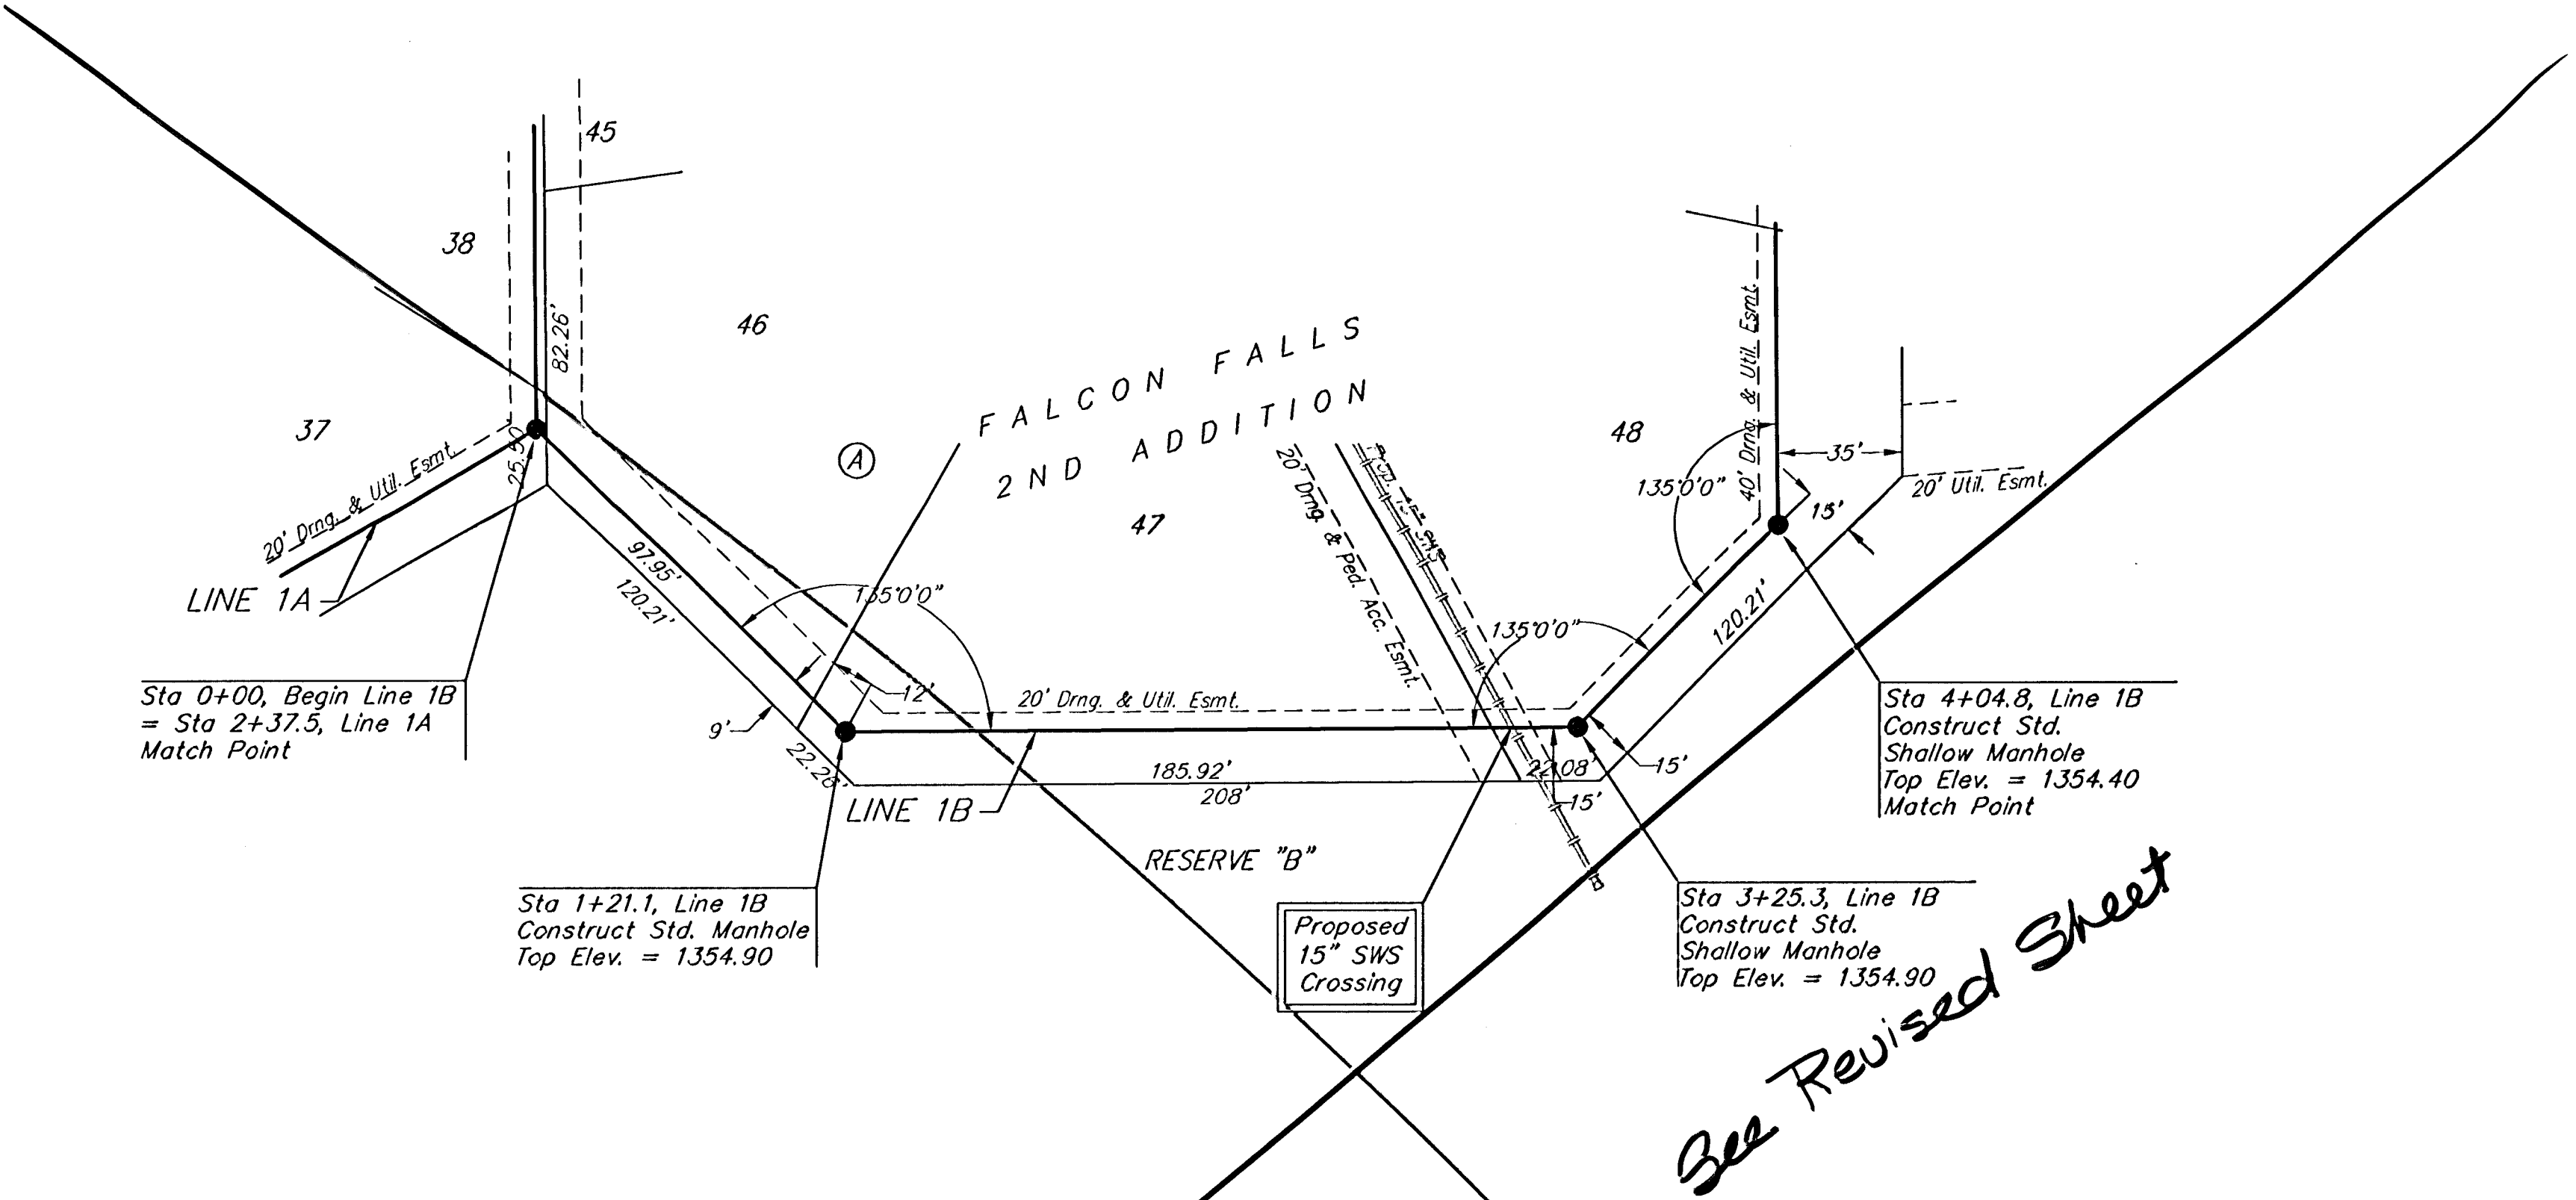


BENCHMARKS

BM #1: Brass Plate on North
Hub Guard of R.C.B.C. 50' East of
NW Corner NE 1/2, Sec. 22, Twp.
26-S, R-1-E.
Elev. = 1371.83 (NGVD29)

BM #2: "X" cut on East Hub
Guard of R.C.B.C., 110' S. of the
SE Cor., SE 1/4, Sec. 22, Twp.
26-S, R-1-E.
Elev. = 1359.54 (NGVD29)

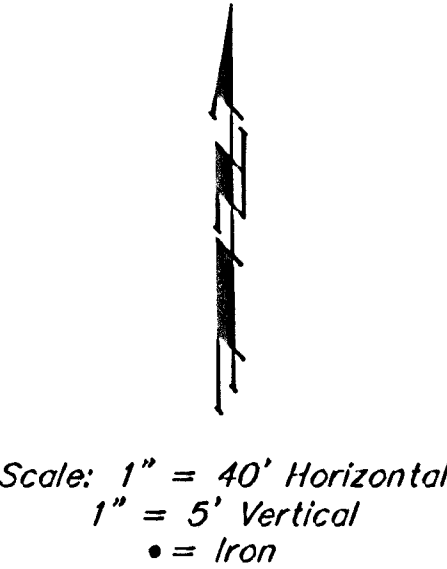

Falcon Falls 2nd Addition
LINE 1B
SANITARY SEWER IMPROVEMENTS

PROJECT NUMBER
4684065

DESIGN
TJW

APPROVED
AEG

DATE
10/05/05

REVISIONS

SCALE
Noted

6 OF 32

F:\eng\Falcon Falls 2nd\SS\ss022.dwg 05/08/EJ44