

BENCHMARKS

BM #1: Brass Plate on North Hub Guard of R.C.B.C. 50' East of NW Corner NE 1/2, Sec. 22, Twp. 26-S, R-1-E.
Elev. = 1371.83 (NGVD29)

BM #2: "□" cut on East Hub Guard of R.C.B.C., 110' S. of the SE Cor., SE 1/4, Sec. 22, Twp. 26-S, R-1-E.
Elev. = 1359.54 (NGVD29)

Scale: 1" = 40' Horizontal
1" = 5' Vertical
• = Iron

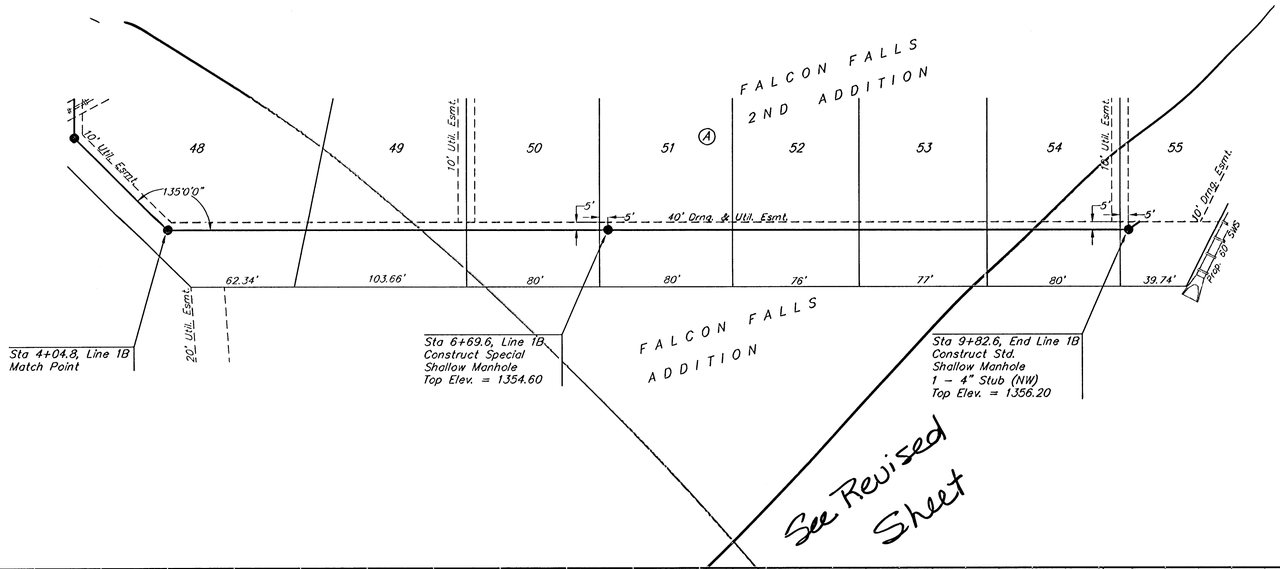

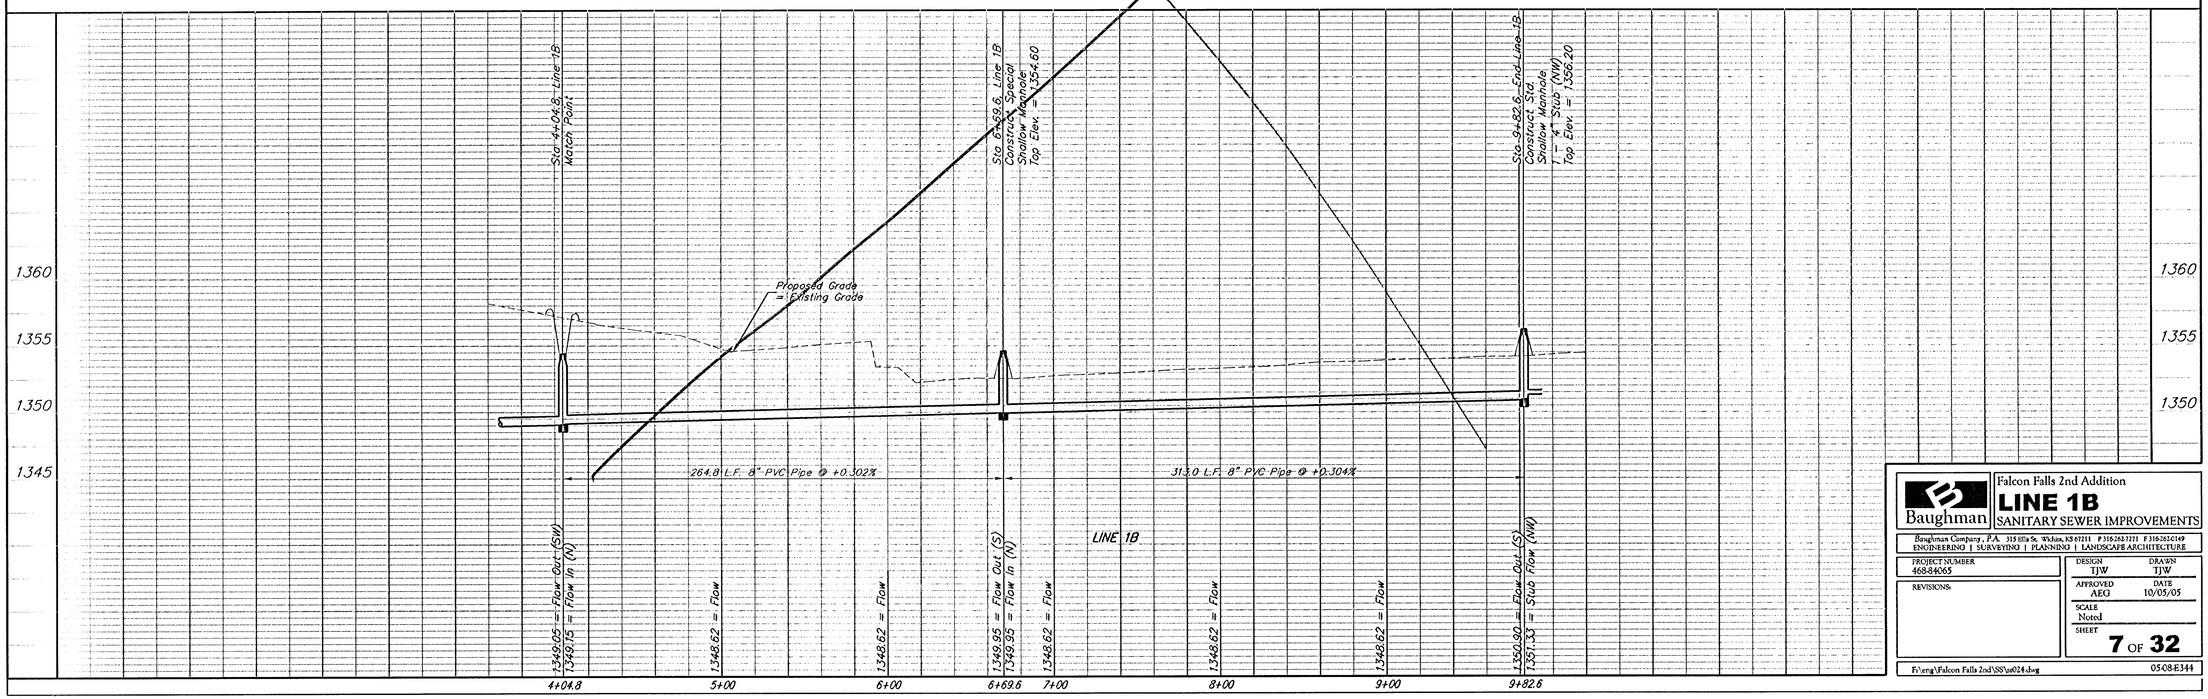

Baughman

Falcon Falls 2nd Addition
LINE 1B
SANITARY SEWER IMPROVEMENTS

Baughman Company, P.A. 315 W. 15th St. Wichita, KS 67203 P 316.262.7271 F 316.262.0149
ENGINEERING | SURVEYING | PLANNING | LANDSCAPE ARCHITECTURE

PROJECT NUMBER	DESIGN	DRAWN
468-84065	TJW	TJW
REVISIONS:	APPROVED AEG	DATE 10/05/05
	SCALE Noted	
	SHEET 7 OF 32	

F:\eng\Falcon Falls 2nd\SS\s024.dwg 05-08-E344