




BENCHMARKS

BM #1: Brass Plate on North
Hub Guard of R.C.B.C. 50' East of
NW Corner NE 1/2, Sec. 22, Twp.
26-S, R-1-E.
Elev. = 1371.83 (NGVD29)

BM #2: " " cut on East Hub
Guard of R.C.B.C., 110' S. of the
SE Cor., SE 1/4, Sec. 22, Twp.
26-S, R-1-E.
Elev. = 1359.54 (NGVD29)

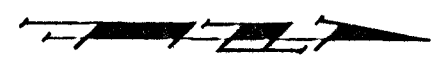

Scale: 1" = 40' Horizontal
1" = 5' Vertical
• = Iron

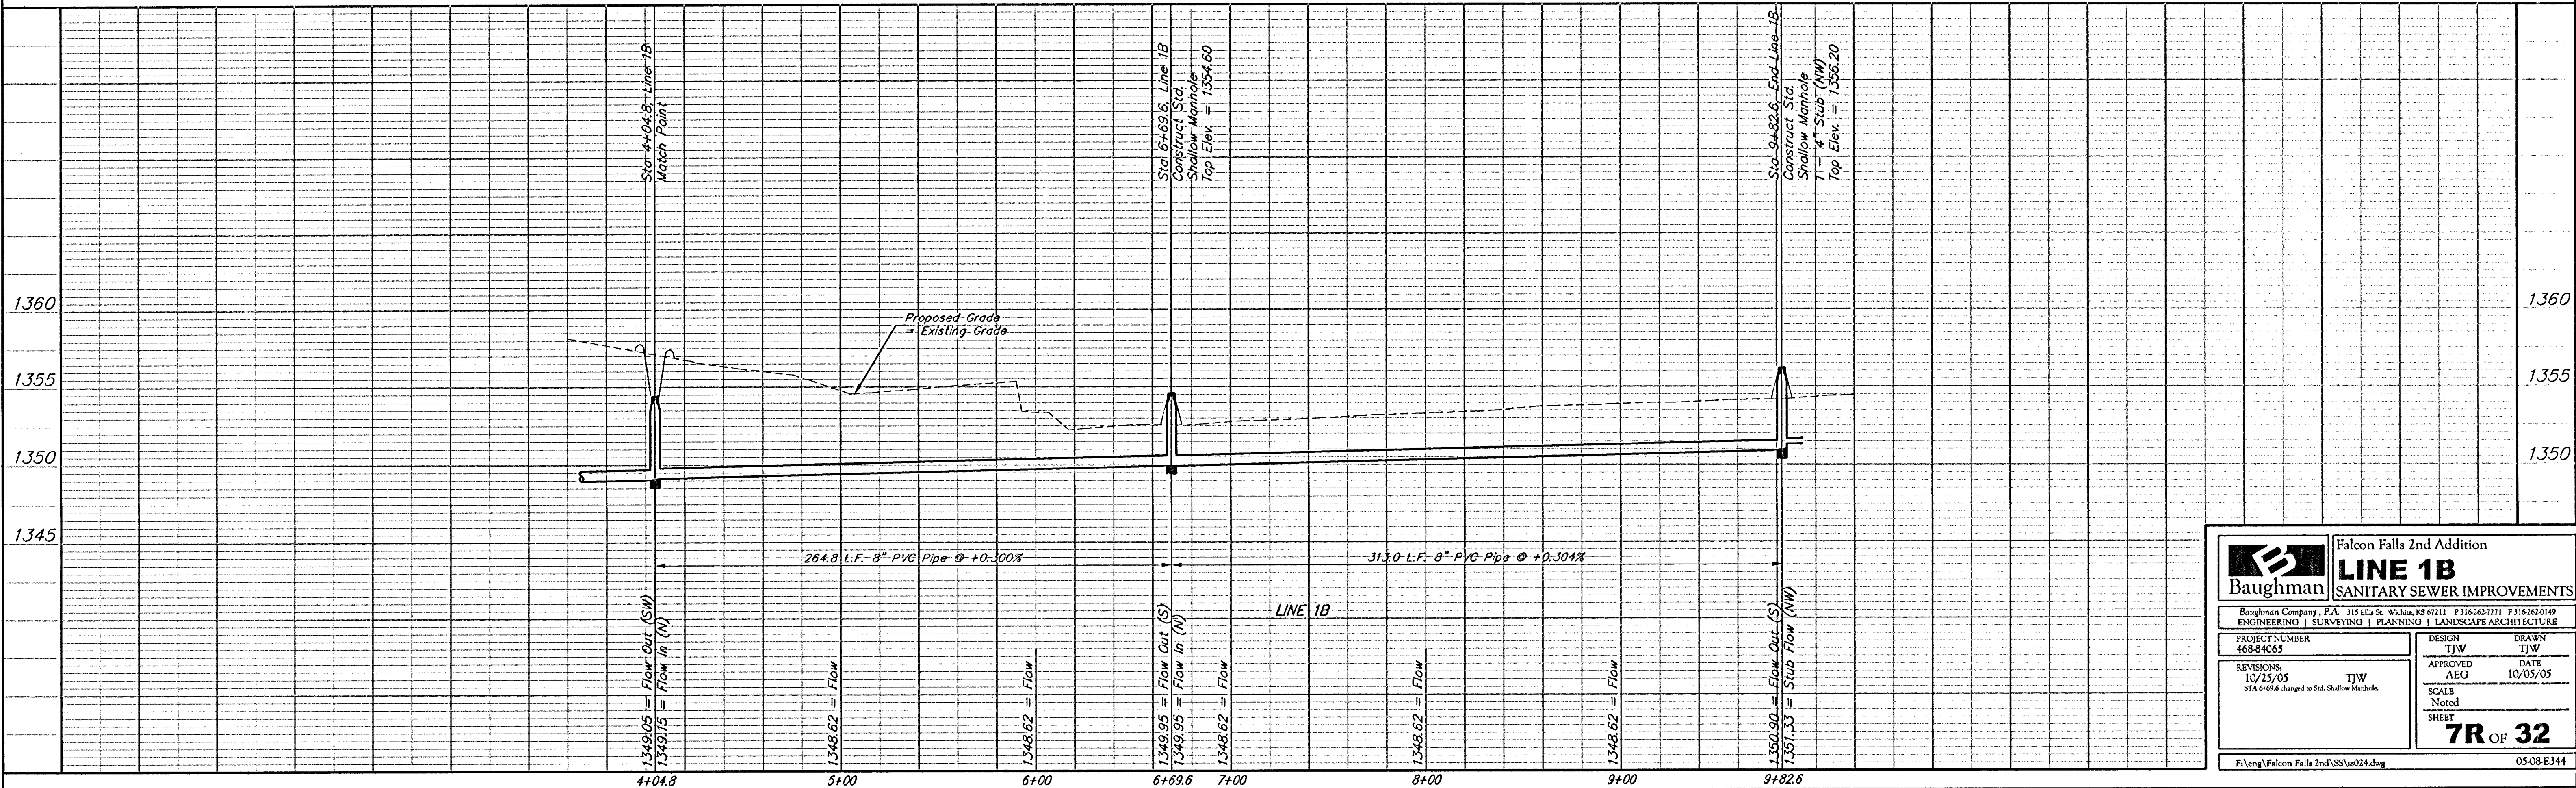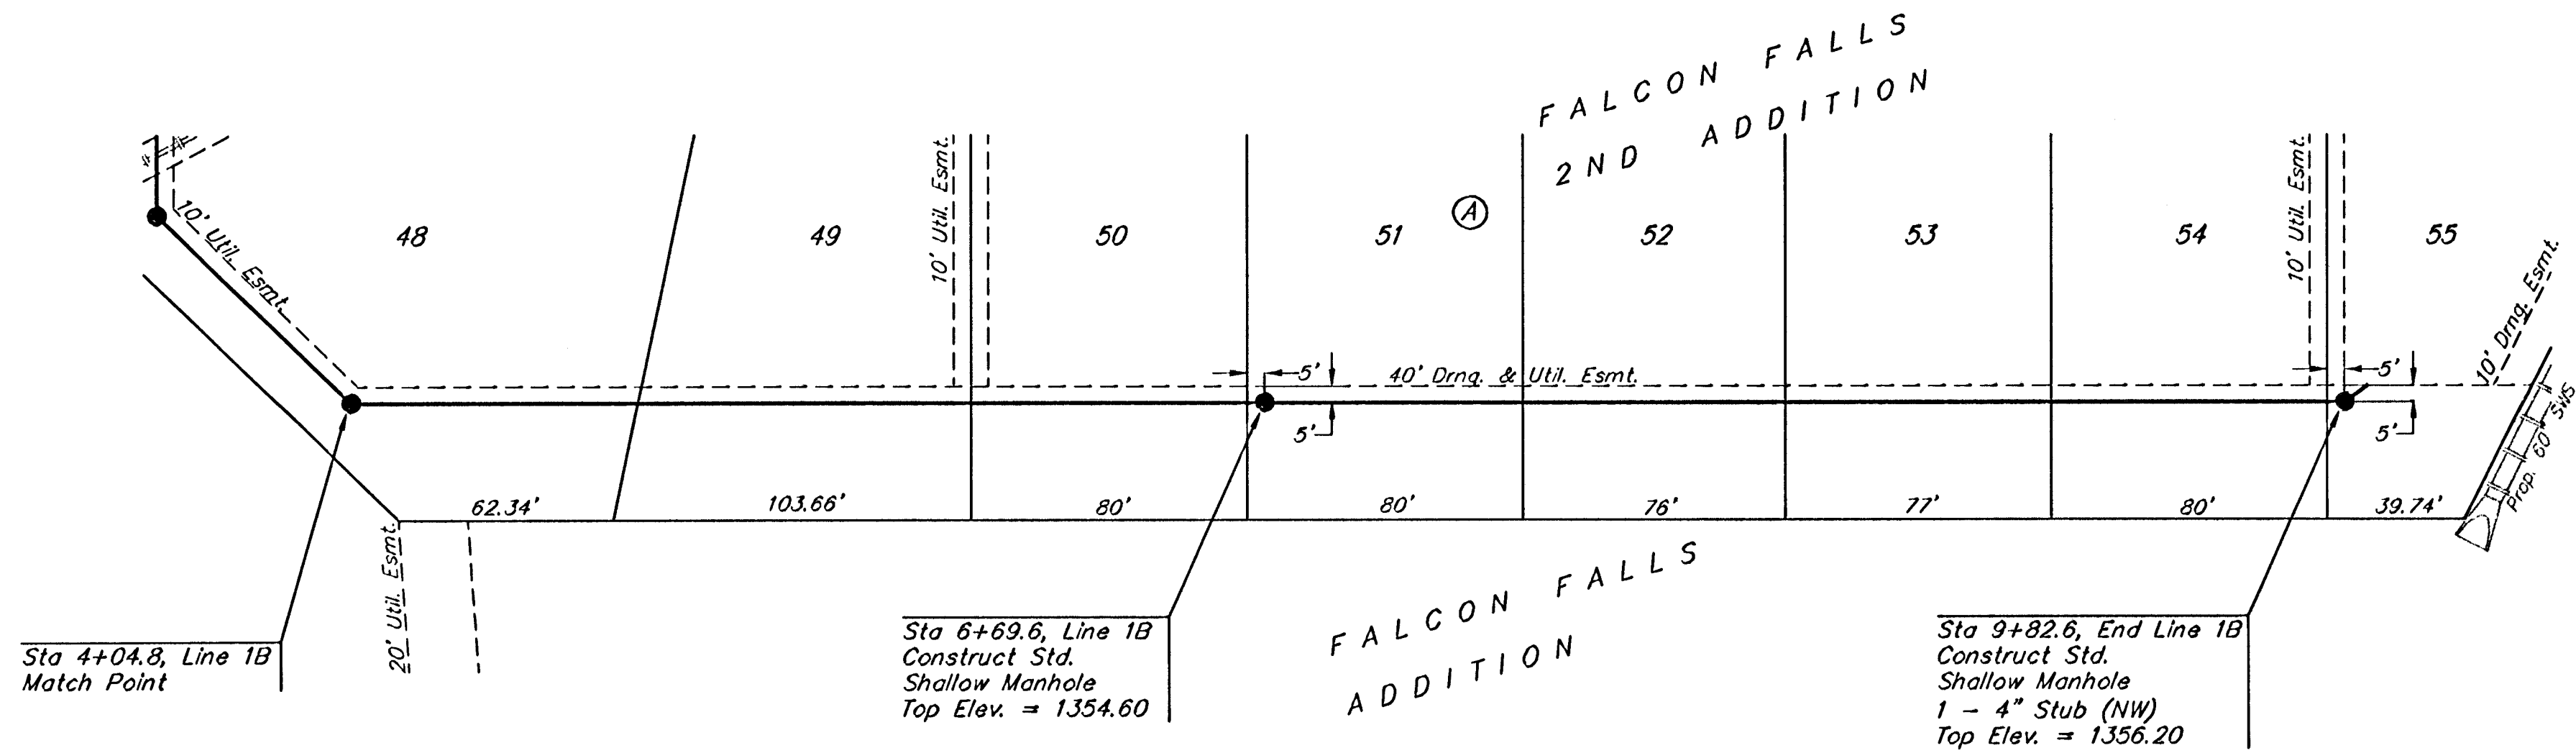

Baughman		Falcon Falls 2nd Addition	
LINE 1B		SANITARY SEWER IMPROVEMENTS	
Baughman Company, P.A. 315 E. 11th St., Wichita, KS 67211 P 316-262-7271 F 316-262-0149			
ENGINEERING SURVEYING PLANNING LANDSCAPE ARCHITECTURE			
PROJECT NUMBER 469-04065	DESIGN TJW	DRAWN TJW	
REVISIONS 10/15/05 STA 6+69.6 changed to Std. Shallow Manhole.	APPROVED AEG	DATE 10/05/05	
TJW	SCALE Noted	SHEET	
7R OF 32			
F:\eng\Falcon Falls 2nd\SS\ss024.dwg			0508-B344