


BENCHMARKS

BM #1: Brass Plate on North Hub Guard of R.C.B.C. 50' East of NW Corner NE 1/2, Sec. 22, Twp. 26-S, R-1-E.
Elev. = 1371.83 (NGVD29)

BM #2: "X" cut on East Hub Guard of R.C.B.C. 110' S. of the SE Cor., SE 1/4, Sec. 22, Twp. 26-S, R-1-E.
Elev. = 1359.54 (NGVD29)

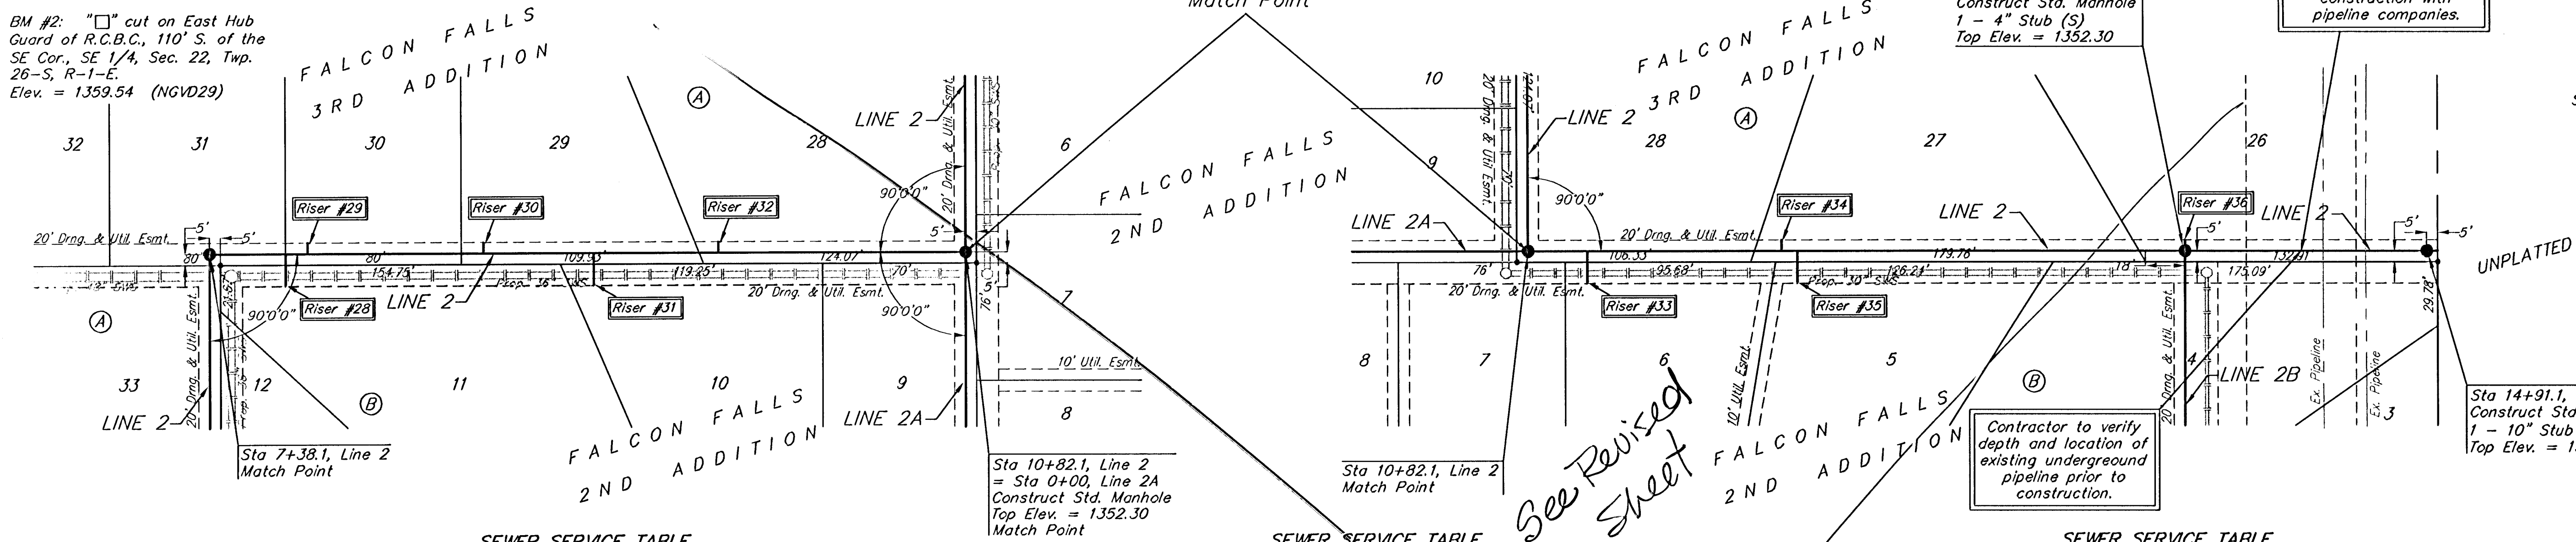

SEWER SERVICE TABLE

NUMBER	TYPE	LOCATION			FOR INFORMATION ONLY		
		LOT NO.	BLOCK NO.	LINE NO.	STATION\ DIRECTION	APPROXIMATE LENGTH 4" PIPE	
28	10" x 4" Tee Saddle	11	B	2	7+73/Rt.	10.5'	5'
29	10" x 4" Tee Saddle	30	A	2	7+83/Lt.	10.5'	5'
30	10" x 4" Tee Saddle	29	A	2	8+63/Lt.	11.0'	5'

NOTE: Vertical Riser Pipe shall be extended to 2' minimum above ground water elevation and 4' maximum below proposed ground elevation.

SEWER SERVICE TABLE


NUMBER	TYPE	LOCATION			FOR INFORMATION ONLY		
		LOT NO.	BLOCK NO.	LINE NO.	STATION\ DIRECTION	APPROXIMATE LENGTH 4" PIPE	
31	10" x 4" Tee Saddle	10	B	2	9+13/Rt.	11.5'	15'
32	10" x 4" Tee Saddle	28	A	2	9+70/Lt.	12.5'	5'
33	10" x 4" Tee Saddle	6	B	2	11+09/Rt.	13.0'	15'

NOTE: Vertical Riser Pipe shall be extended to 2' minimum above ground water elevation and 4' maximum below proposed ground elevation.

SEWER SERVICE TABLE

NUMBER	TYPE	LOCATION			FOR INFORMATION ONLY		
		LOT NO.	BLOCK NO.	LINE NO.	STATION\ DIRECTION	APPROXIMATE LENGTH 4" PIPE	
34	10" x 4" Tee Saddle	27	A	2	11+97/Lt.	12.5'	5'
35	10" x 4" Tee Saddle	5	B	2	12+05/Rt.	12.5'	15'
36	10" x 4" Tee Saddle	26	A	2	13+81/Lt.	13.0'	5'

NOTE: Vertical Riser Pipe shall be extended to 2' minimum above ground water elevation and 4' maximum below proposed ground elevation.

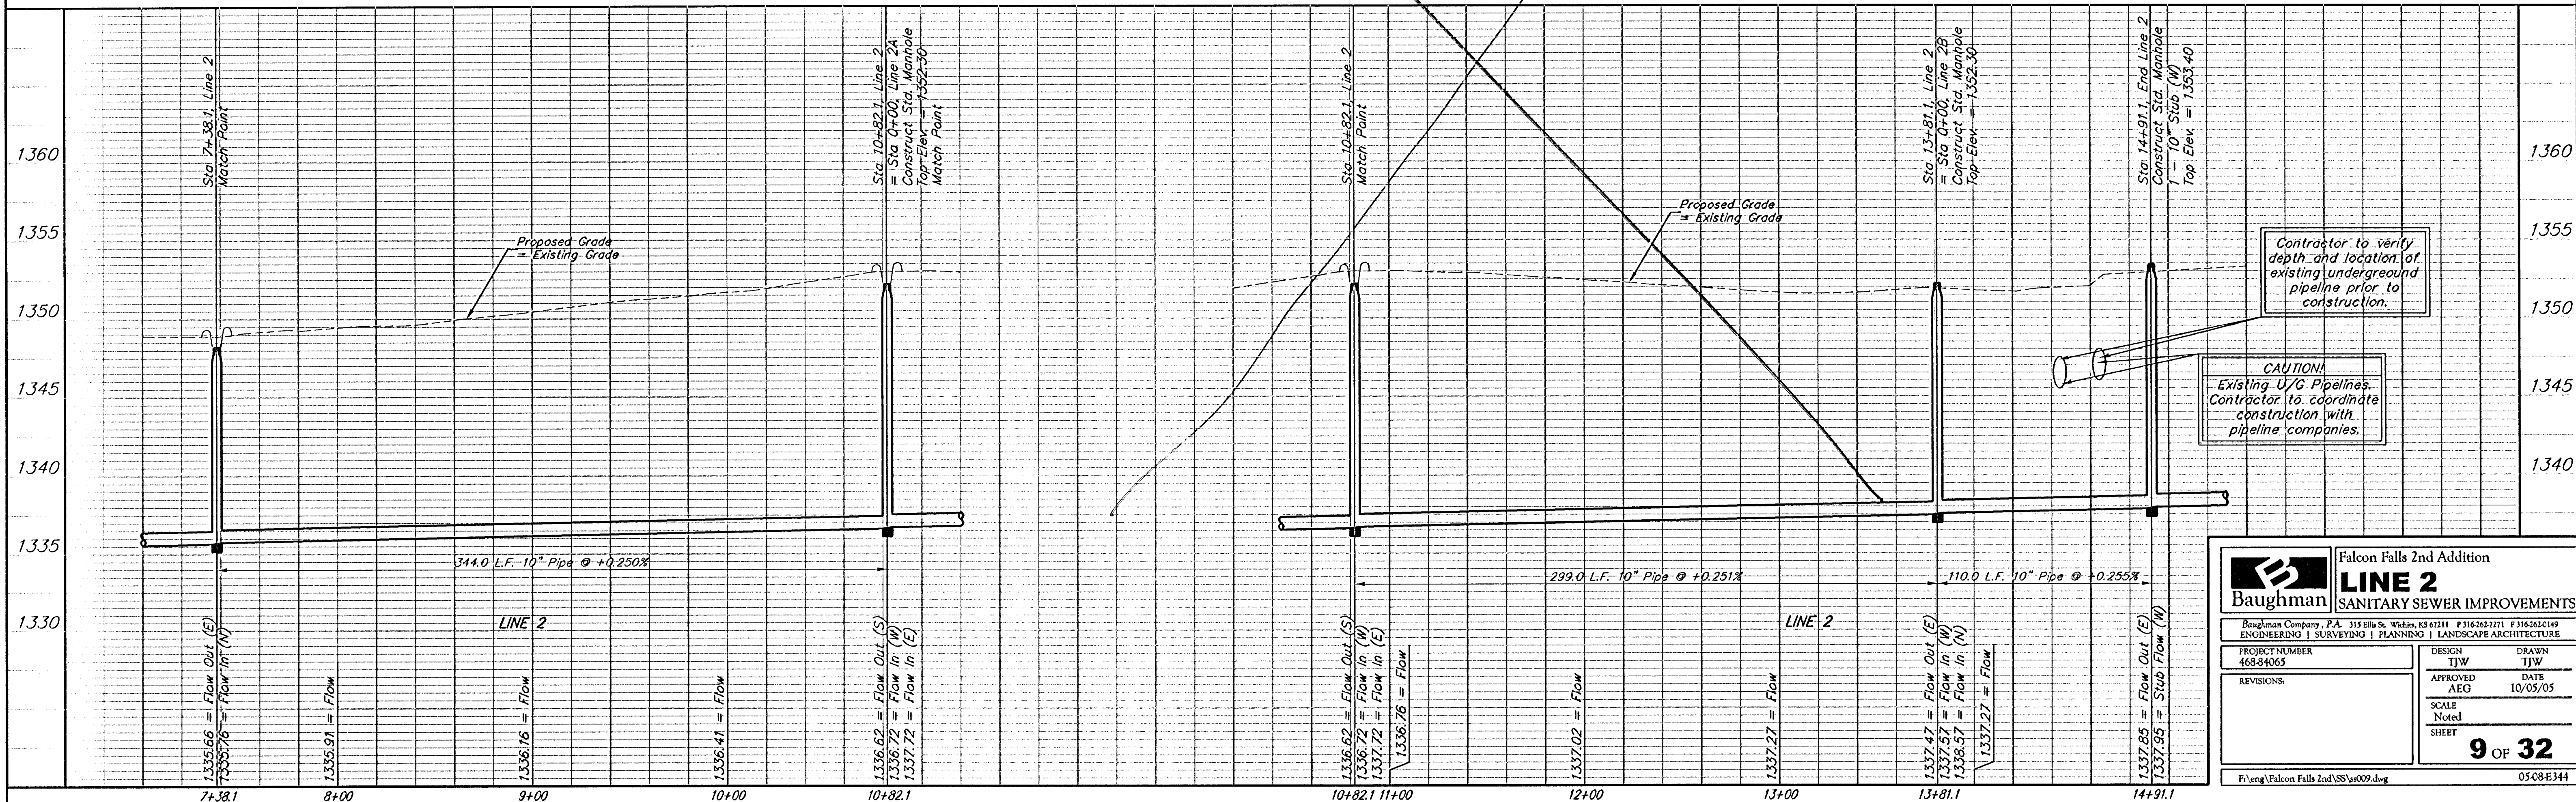

Baughman

Falcon Falls 2nd Addition

LINE 2

SANITARY SEWER IMPROVEMENTS

ENGINEERING | SURVEYING | PLANNING | LANDSCAPE ARCHITECTURE

PROJECT NUMBER: 468-84065

DESIGN: TJW

APPROVED: AEG

DATE: 10/05/05

SCALE: Noted

SHEET: 9 OF 32

Revisions:

1. 10/05/05: Initial Design

File: eng\Falcon Falls 2nd SSS\ss09.dwg

0508EJ44