

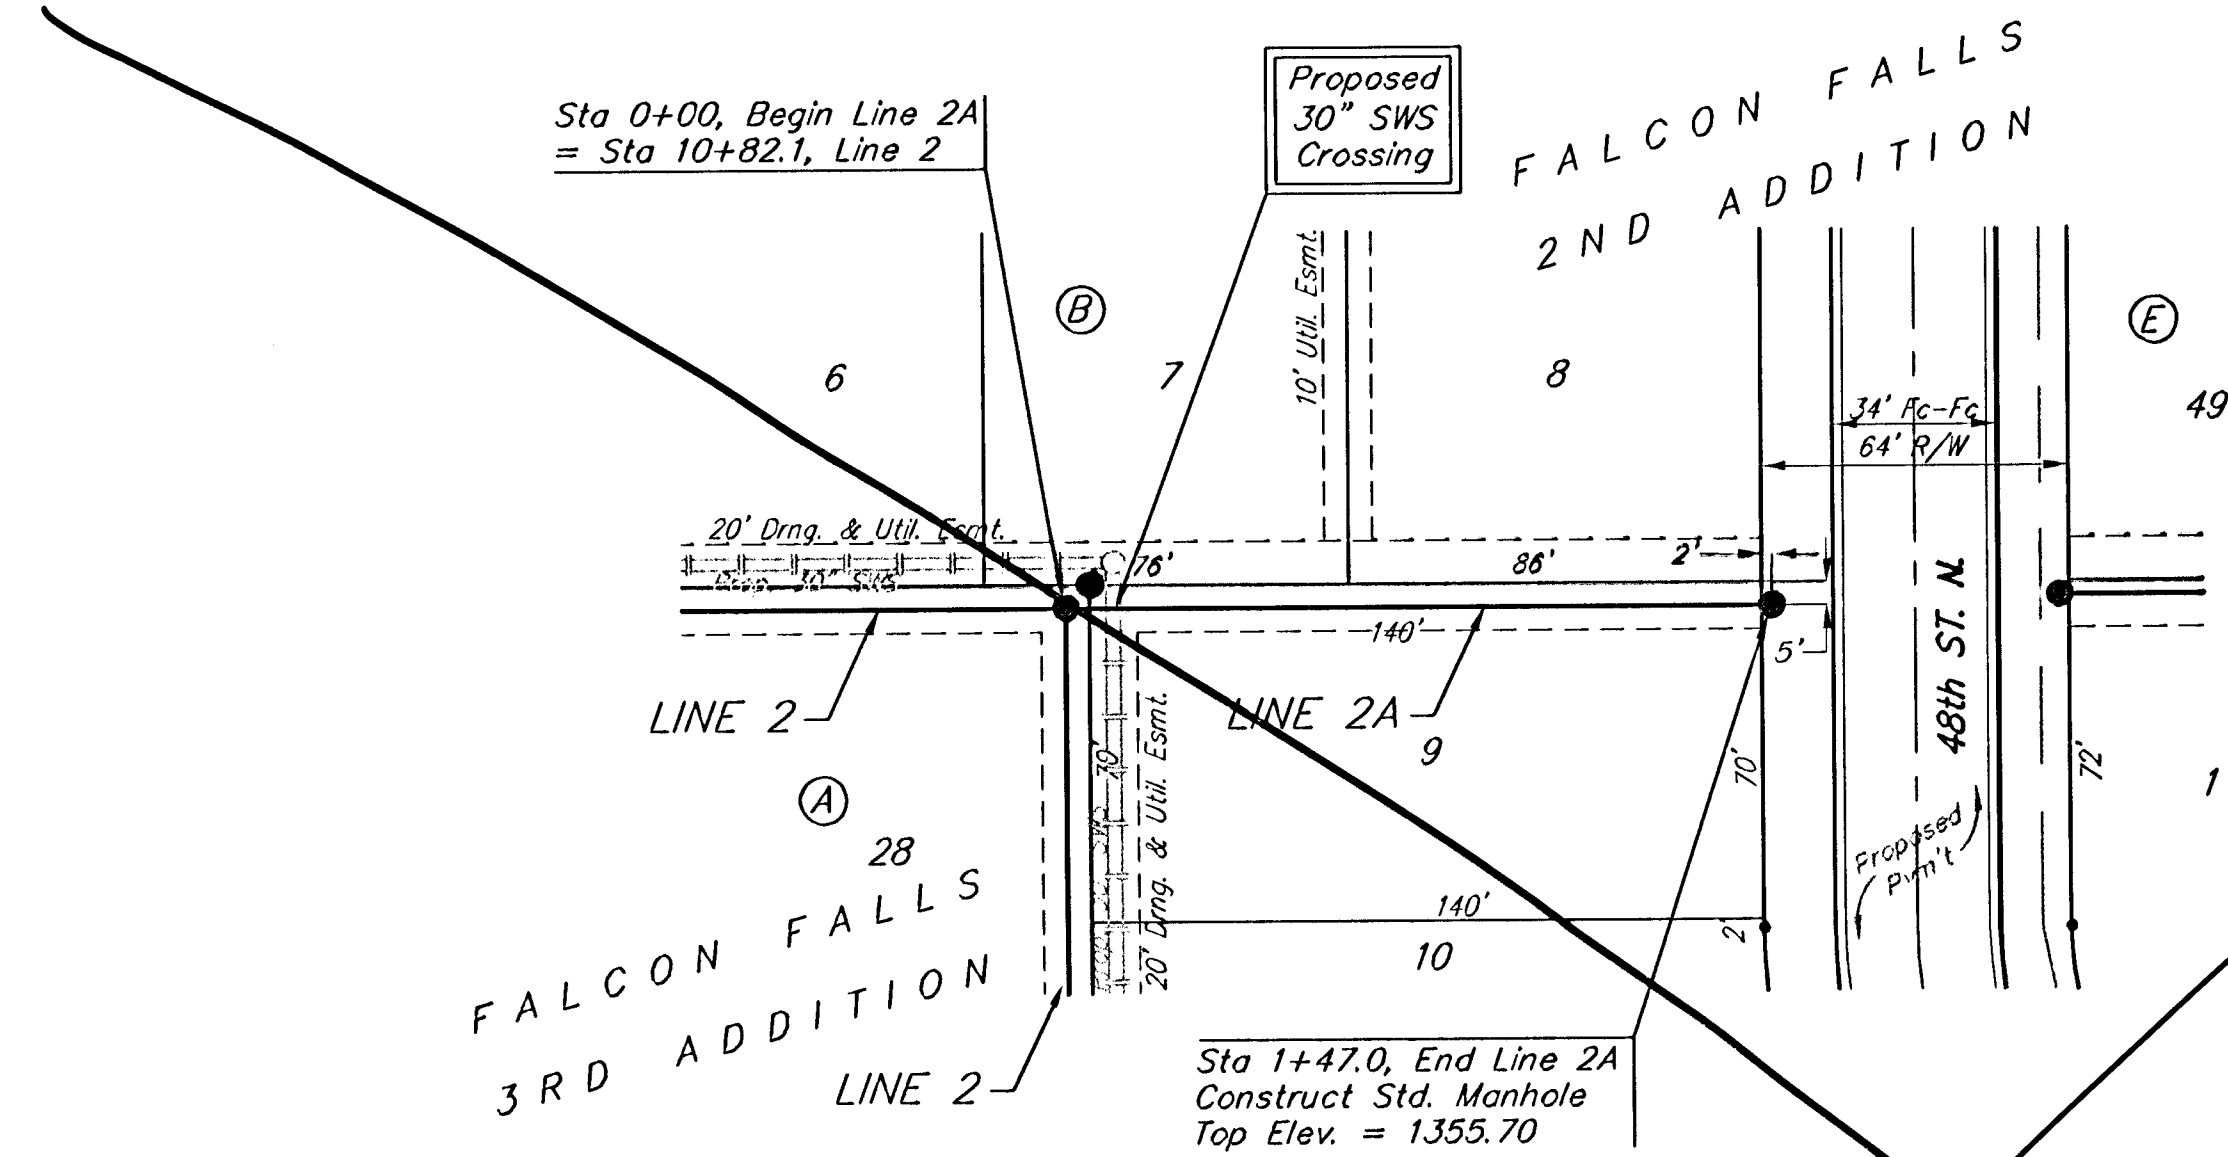


BM #1: Brass Plate on North
Hub Guard of R.C.B.C. 50' East of
NW Corner NE 1/2, Sec. 22, Twp.
26-S, R-1-E.
Elev. = 1371.83 (NGVD29)

BM #2: "□" cut on East Hub
Guard of R.C.B.C., 110' S. of the
SE Cor., SE 1/4, Sec. 22, Twp.
26-S, R-1-E.
Elev. = 1359.54 (NGVD29)

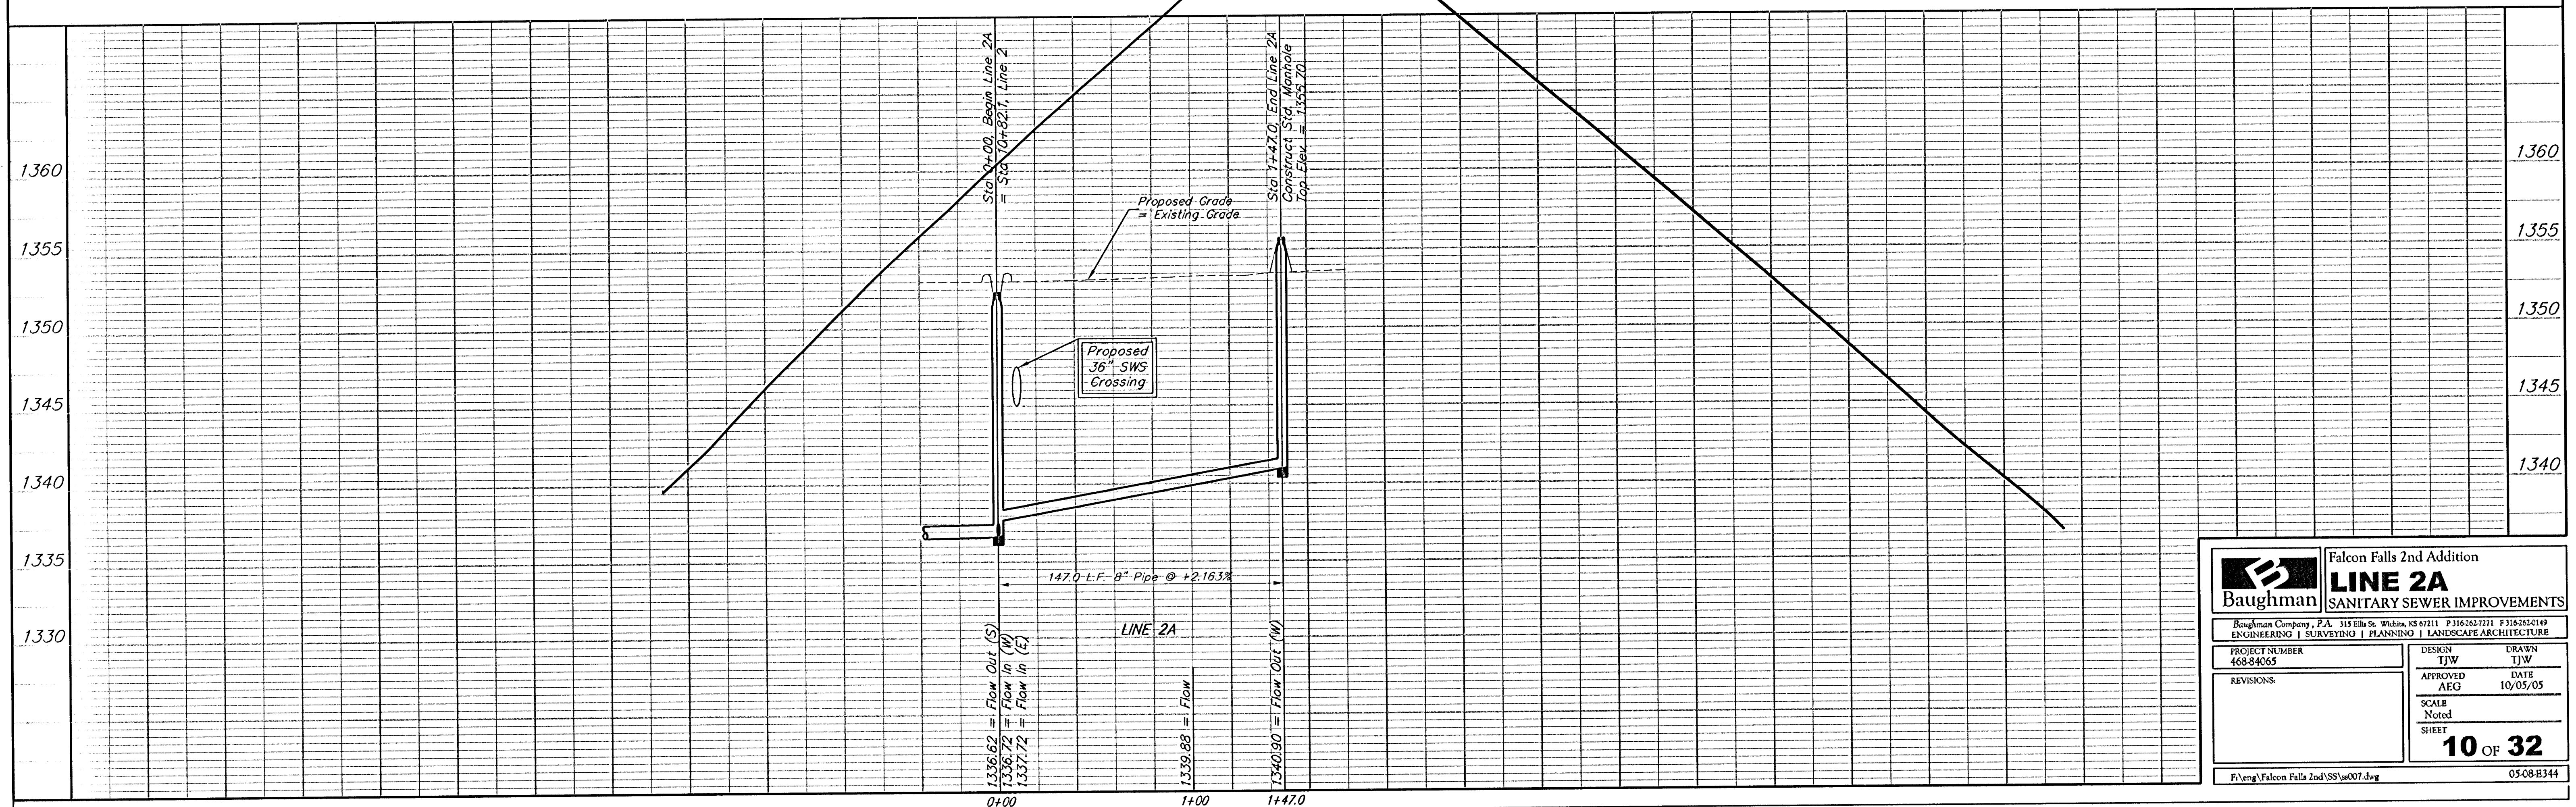

See Revised
Sheet

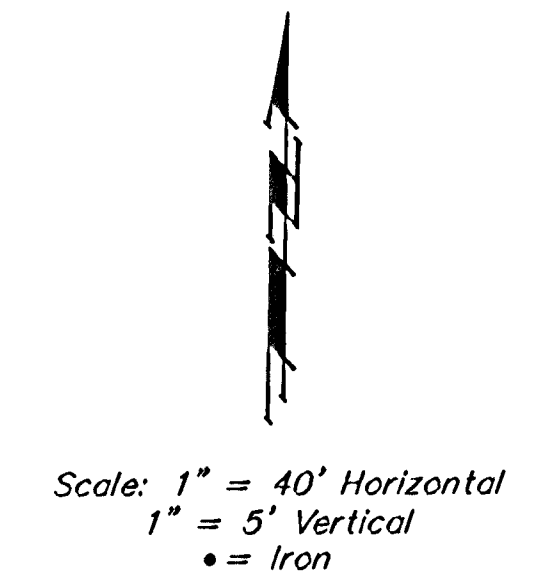

 Baughman	Falcon Falls 2nd Addition LINE 2A SANITARY SEWER IMPROVEMENTS
	Baughman Company, P.A. 315 Ella St. Wichita, KS 67111 P.316.2627171 F.316.2634109 ENGINEERING SURVEYING PLANNING LANDSCAPE ARCHITECTURE
PROJECT NUMBER 469-84355	DESIGN TJW
REVISIONS:	DRAWN TJW
	APPROVED AEG
	DATE 10/05/05
	SCALE Noted
	SHEET 10 OF 32
F:\eng\Falcon Falls 2nd SS\w007.dwg	
05-08-E344	