


BENCHMARKS

BM #1: Brass Plate on North
Hub Guard of R.C.B.C. 50' East of
NW Corner NE 1/2, Sec. 22, Twp.
26-S, R-1-E.
Elev. = 1371.83 (NGVD29)


BM #2: "X" cut on East Hub
Guard of R.C.B.C., 110' S. of the
SE Cor., SE 1/4, Sec. 22, Twp.
26-S, R-1-E.
Elev. = 1359.54 (NGVD29)

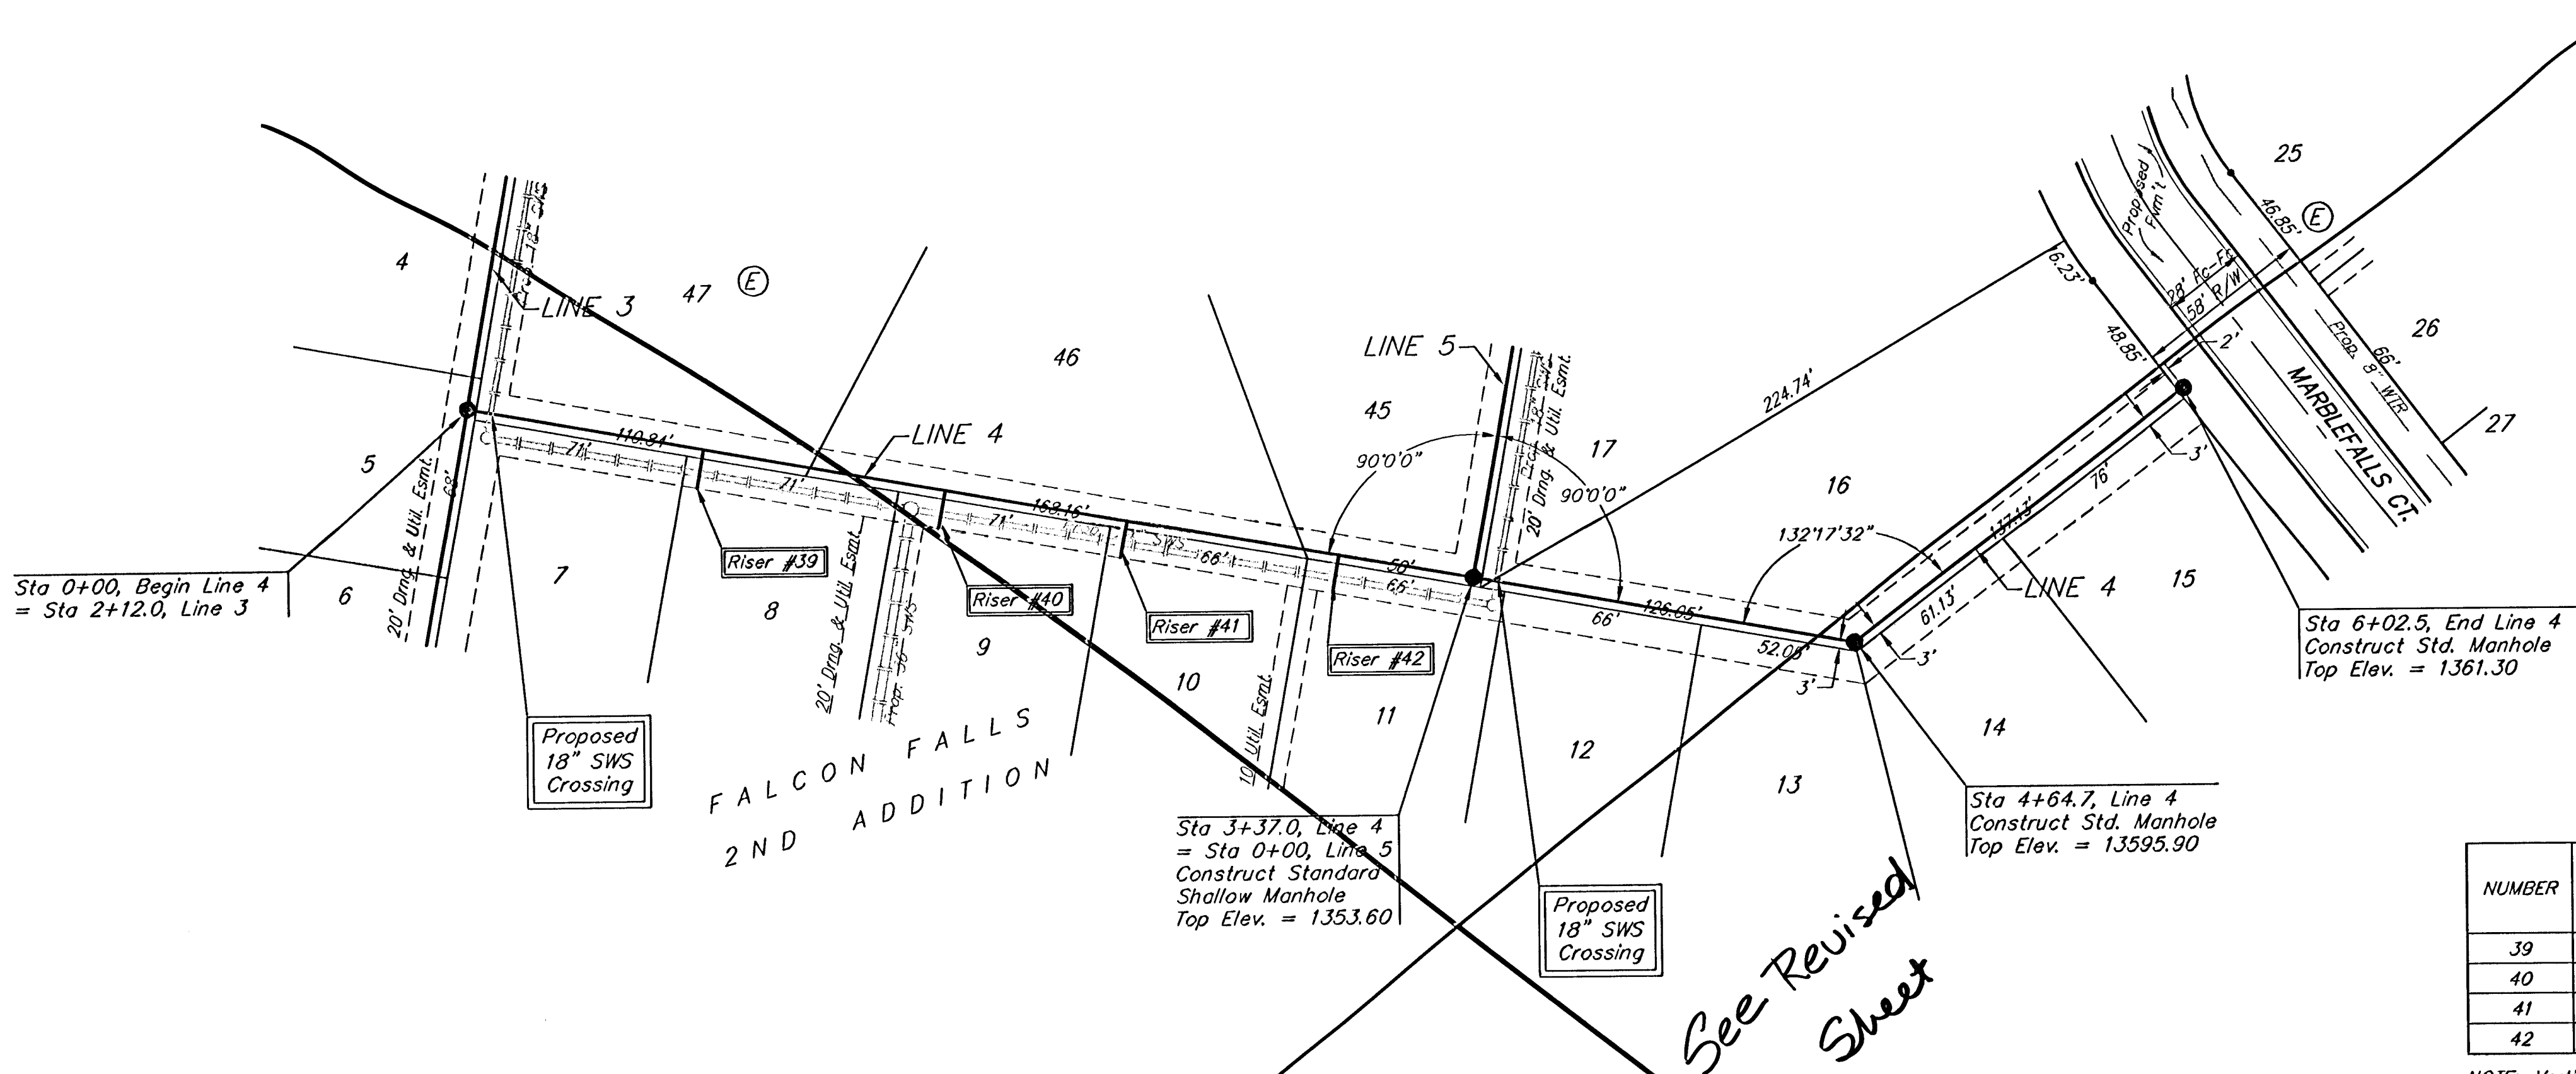

SEWER SERVICE TABLE

NUMBER	TYPE	LOCATION				FOR INFORMATION ONLY	
		LOT NO.	BLOCK NO.	LINE NO.	STATION DIRECTION	APPROXIMATE LENGTH 4" PIPE	
39	10" x 4" Tee Saddle	8	E	4	0+79/Rt.	5.0'	13'
40	10" x 4" Tee Saddle	9	E	4	1+60/Rt.	5.0'	13'
41	10" x 4" Tee Saddle	10	E	4	2+21/Rt.	5.0'	13'
42	10" x 4" Tee Saddle	11	E	4	2+92/Rt.	5.0'	13'

NOTE: Vertical Riser Pipe shall be extended to 2' minimum above ground water elevation and 4' maximum below proposed ground elevation.

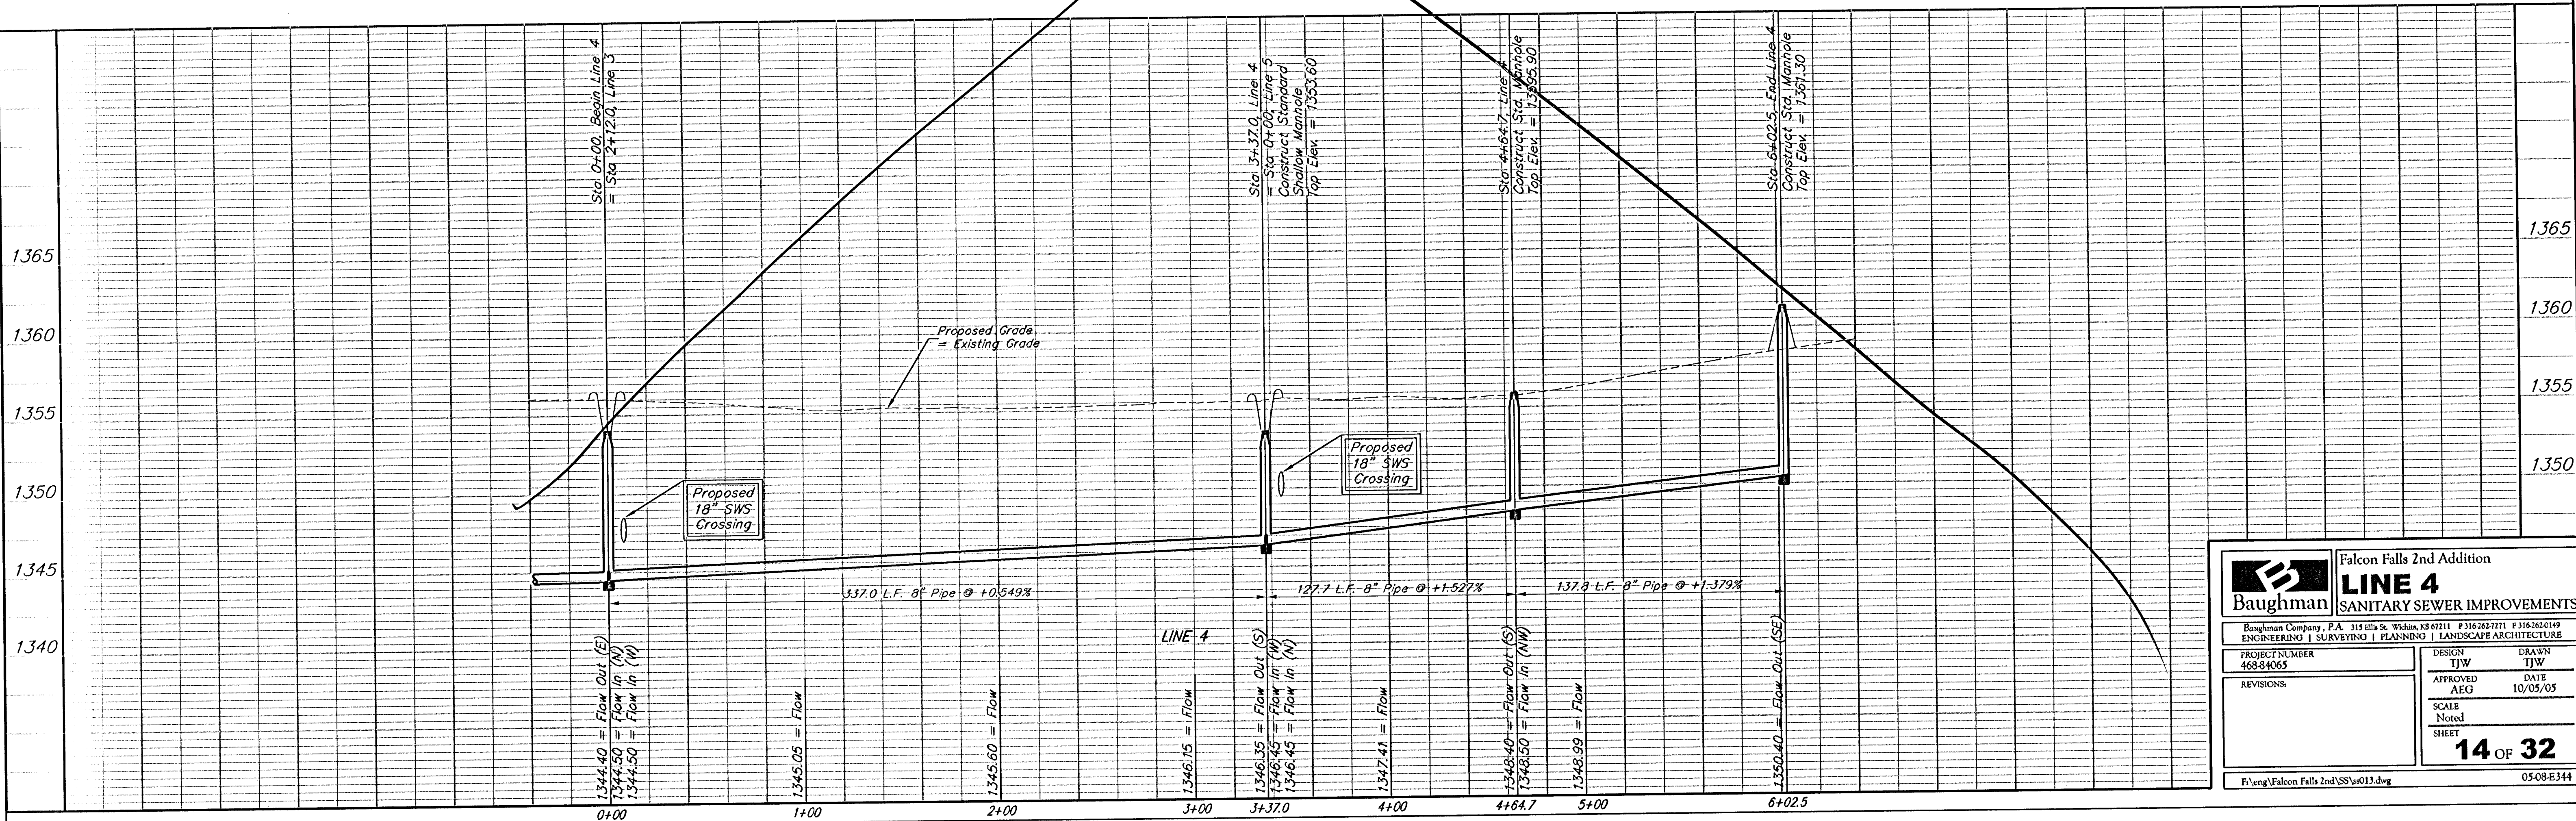

Falcon Falls 2nd Addition
LINE 4
SANITARY SEWER IMPROVEMENTS

PROJECT NUMBER
468-04065

DESIGN
TJW

APPROVED
AEG

DATE
10/05/05

REVISIONS:

SCALE
Noted

SHEET
14 OF 32

F:\eng\Falcon Falls 2nd SS\ss013.dwg

0508-E1344